


*El Paso*

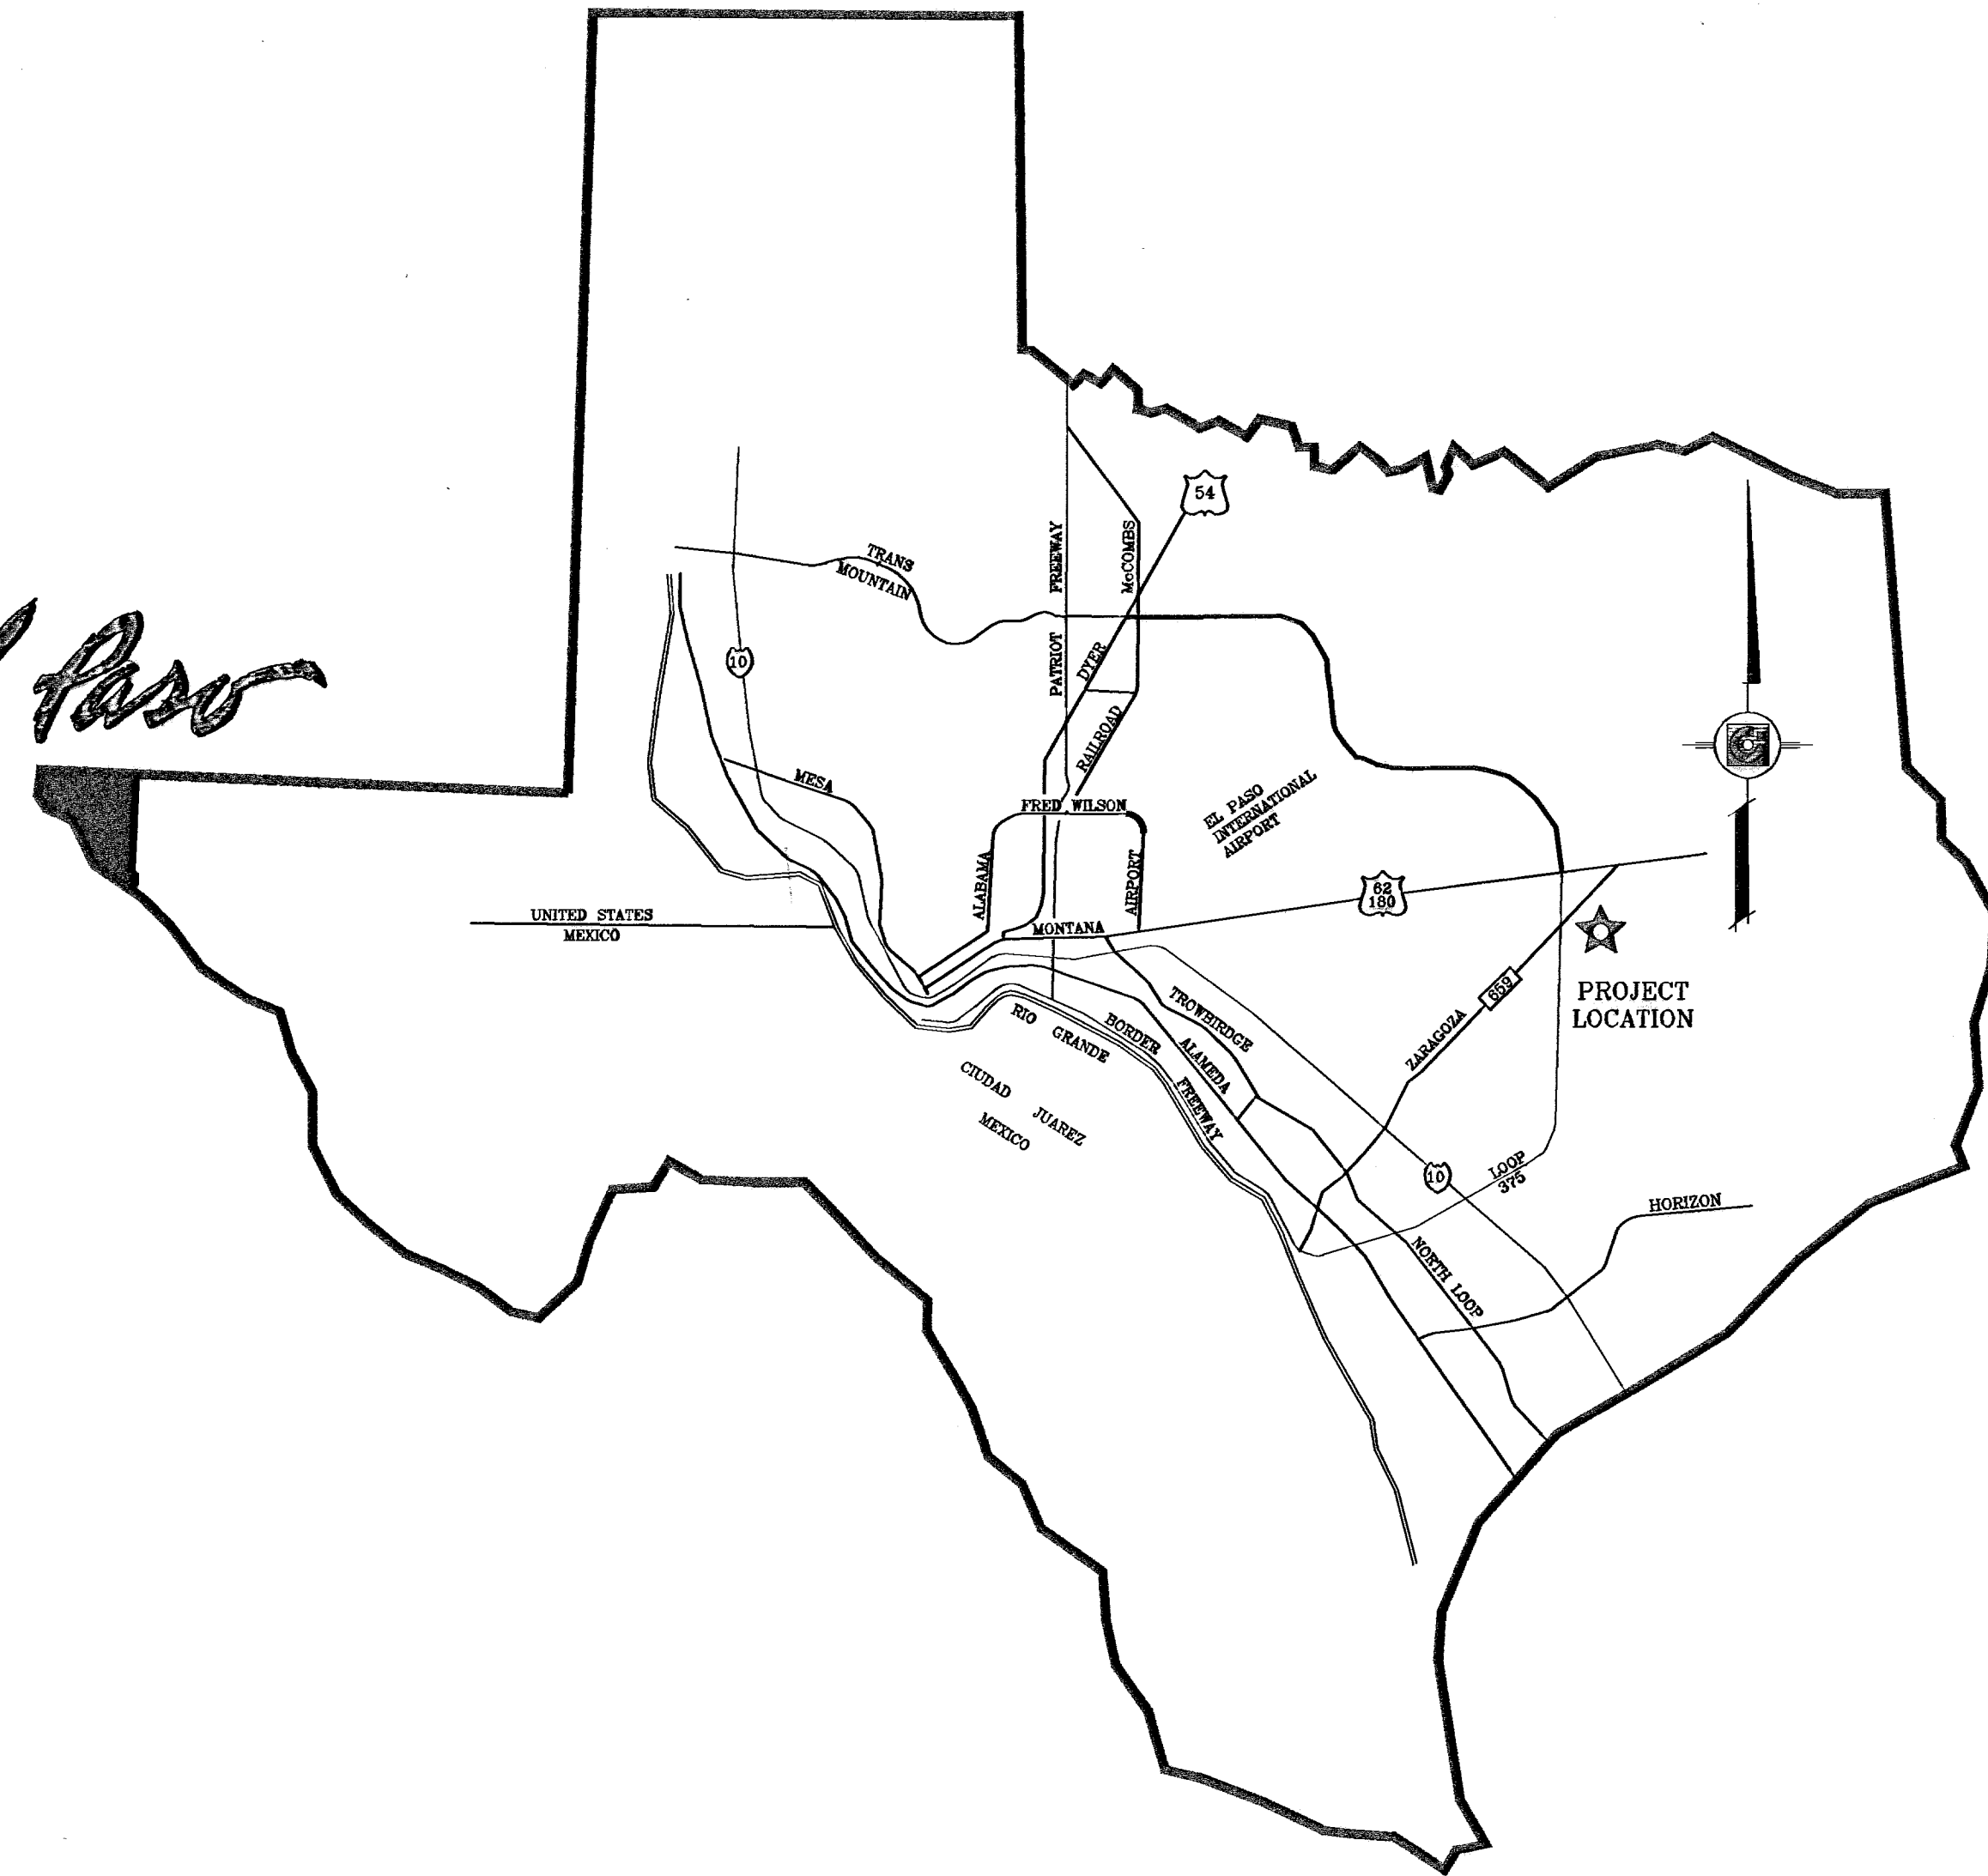


VICINITY MAP



TIERRA DEL ESTE  
UNIT FIFTY NINE  
PROJECT  
LOCATION

# STREET IMPROVEMENTS

LOCATION MAP SCALE: 1" = 1000'

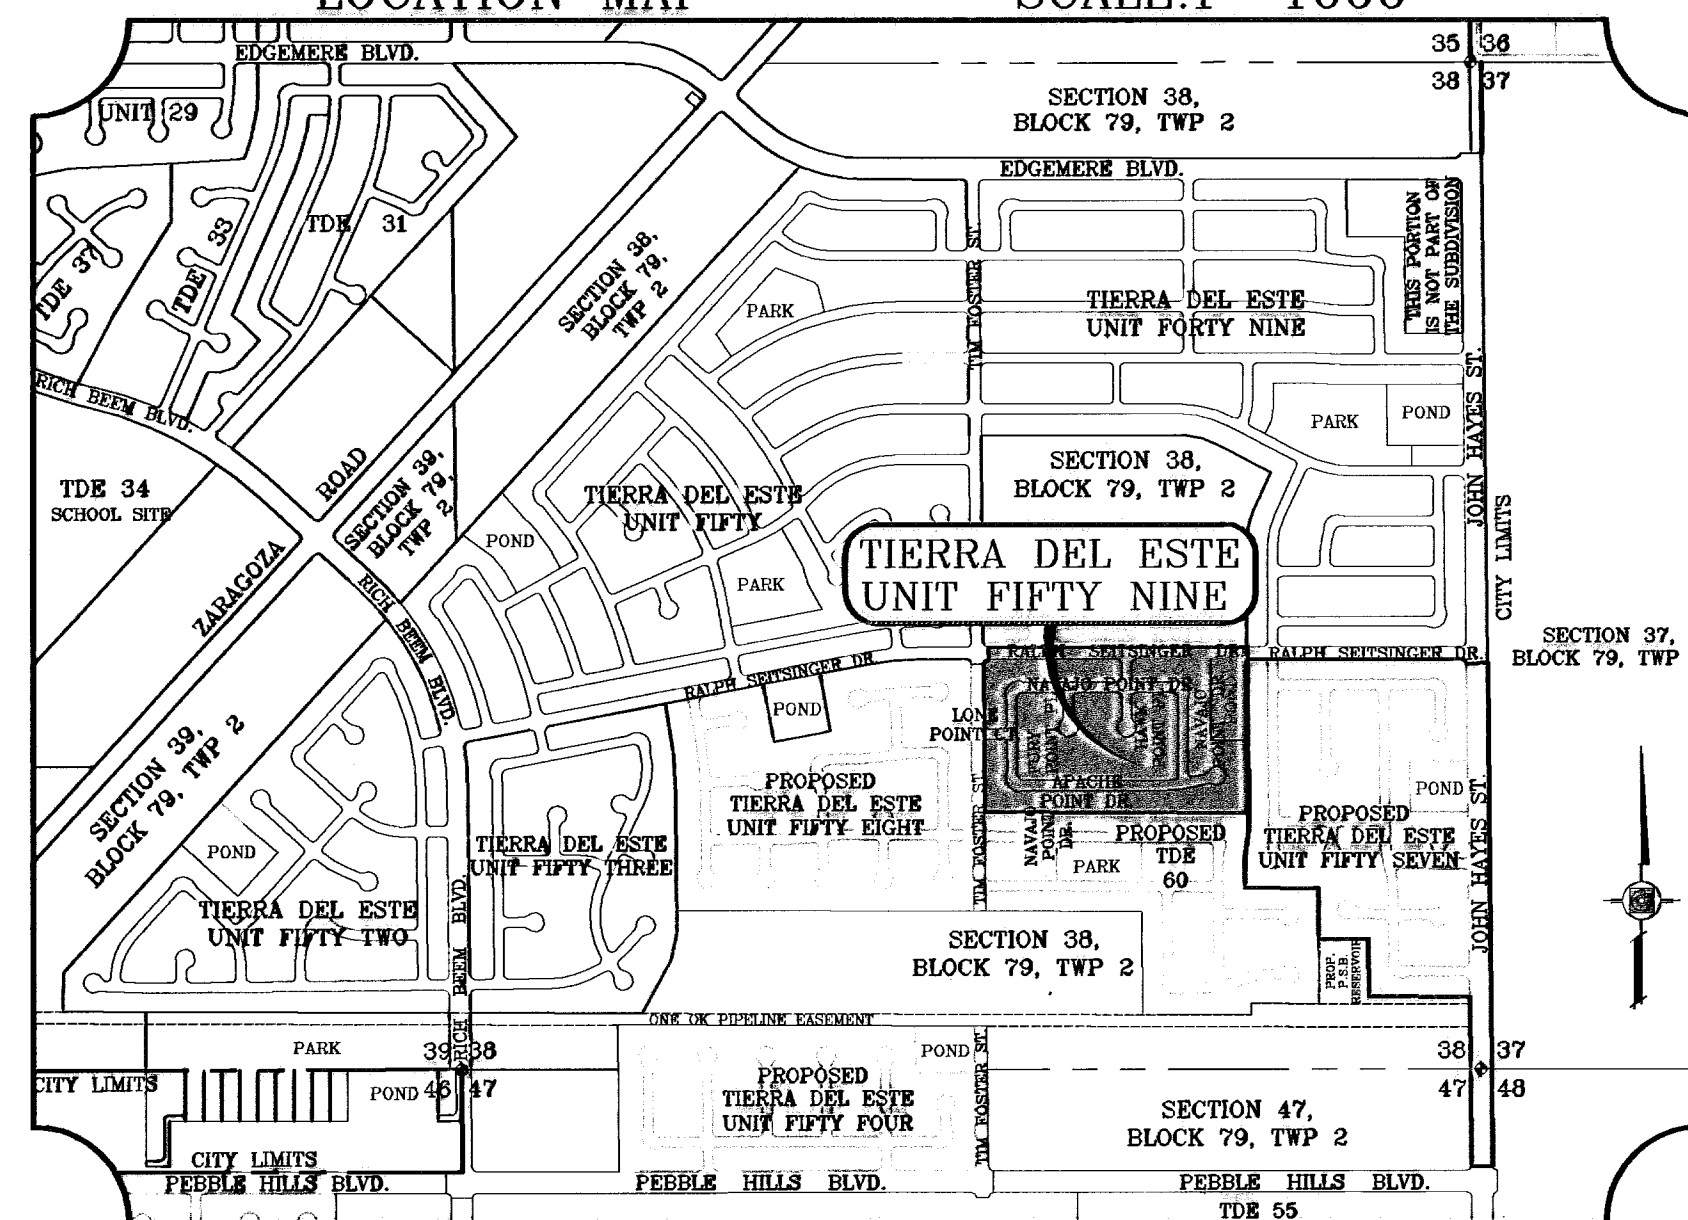

## I N D E X

TITLE	SHEET No.	TITLE	SHEET No.
COVER SHEET	1 OF 24	LONE POINT CT.	15 OF 24
PLAT	2 OF 24	FURY POINT PL.	15 OF 24
GRADING	3 OF 24	HAWK POINT PL.	16 OF 24
GRADING SECTIONS	4 OF 24	POND SECTIONS	17 OF 24
DRAINAGE	5 OF 24	DRAINAGE STRUCTURES	18-20 OF 24
S.W.P.P. AND STANDARD DETAILS	6&7 OF 24	STRUCTURE DETAILS	21 OF 24
RALPH SEITSINGER DR.	8&9 OF 24	STANDARD DETAILS	22&23 OF 24
NAVAJO POINT DR.	10-12 OF 24	ILLUMINATION AND TRAFFIC CONTROL PLAN	24 OF 24
APACHE POINT DR.	13&14 OF 24		




CONDE INC.  
ENGINEERING / PLANNING  
SURVEYING / GPS  
1790 LEE TREVINO STE 400  
EL PASO, TEXAS 79906




# TIERRA DEL ESTE UNIT FIFTY NINE

BEING A PORTION OF SECTION 38, BLOCK 79, TOWNSHIP 2,  
TEXAS AND PACIFIC RAILWAY COMPANY SURVEYS,  
CITY OF EL PASO, EL PASO COUNTY, TEXAS.  
CONTAINING 28.969 ACRES

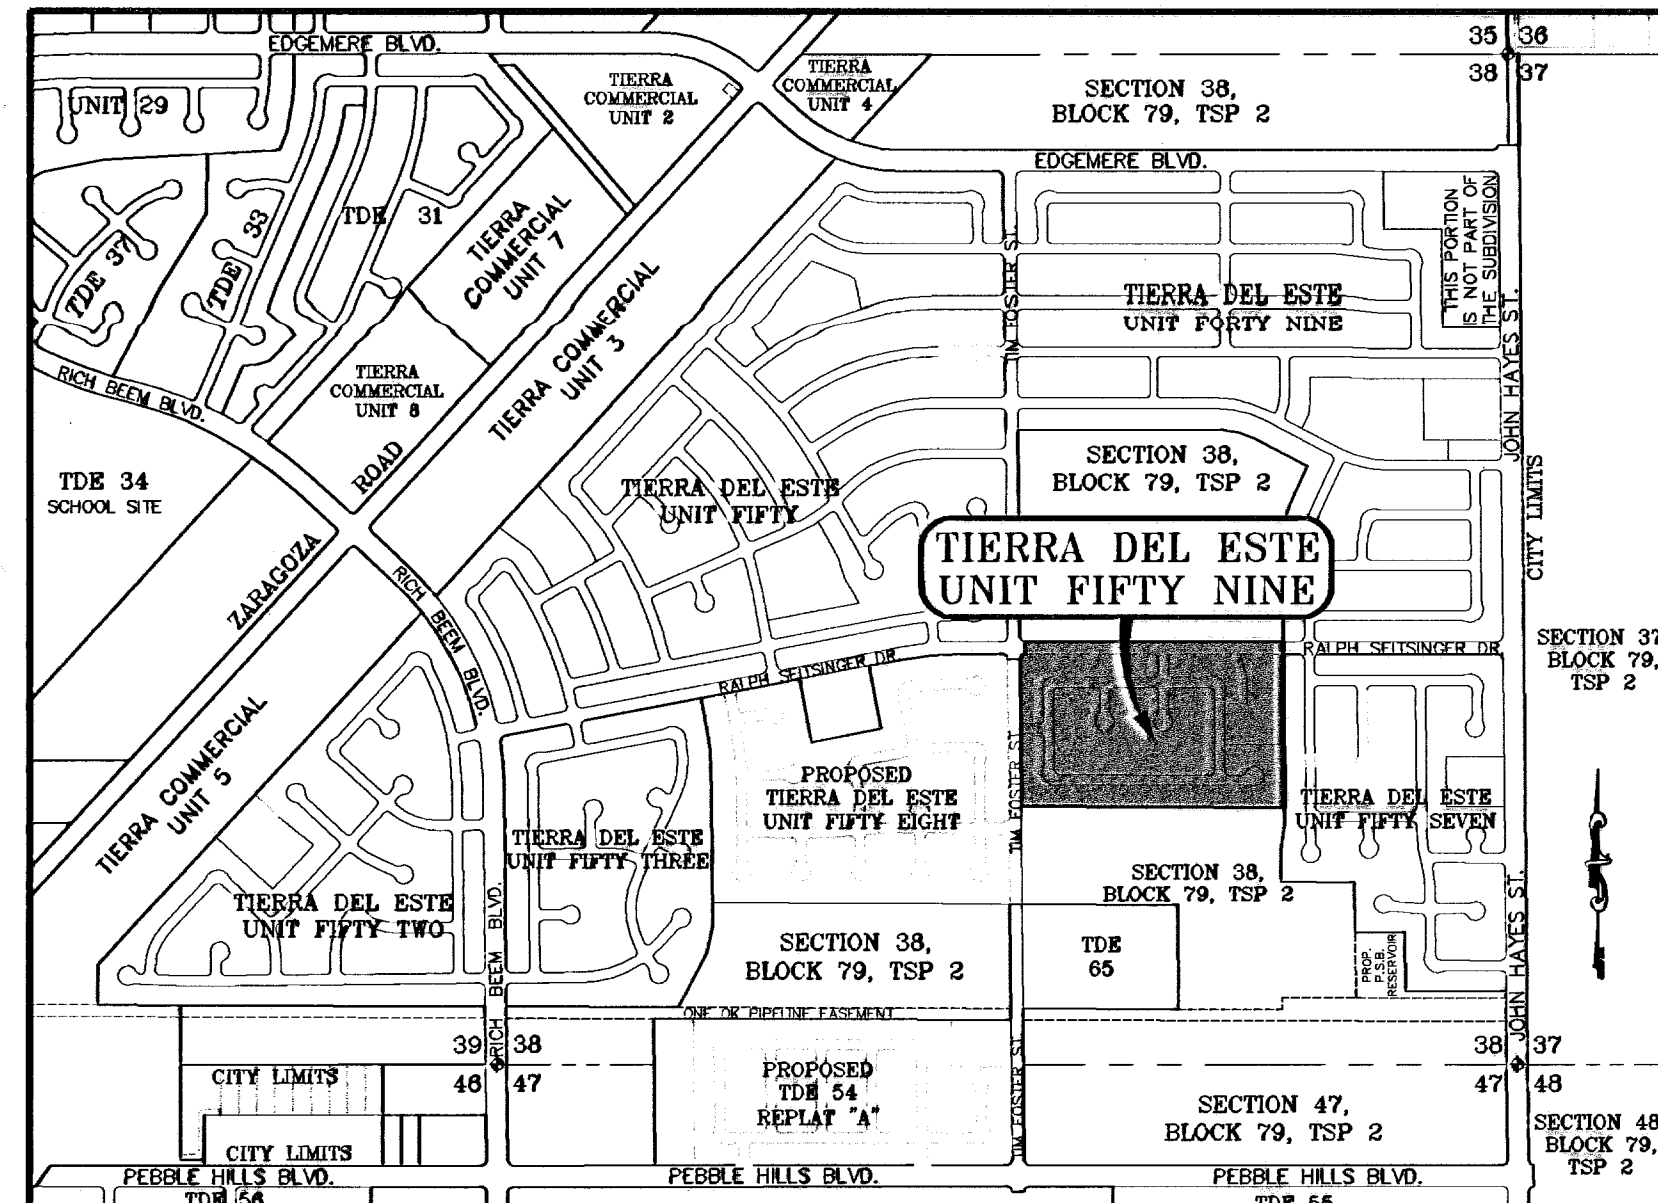

LOCATION MAP SCALE: 1" = 1000'

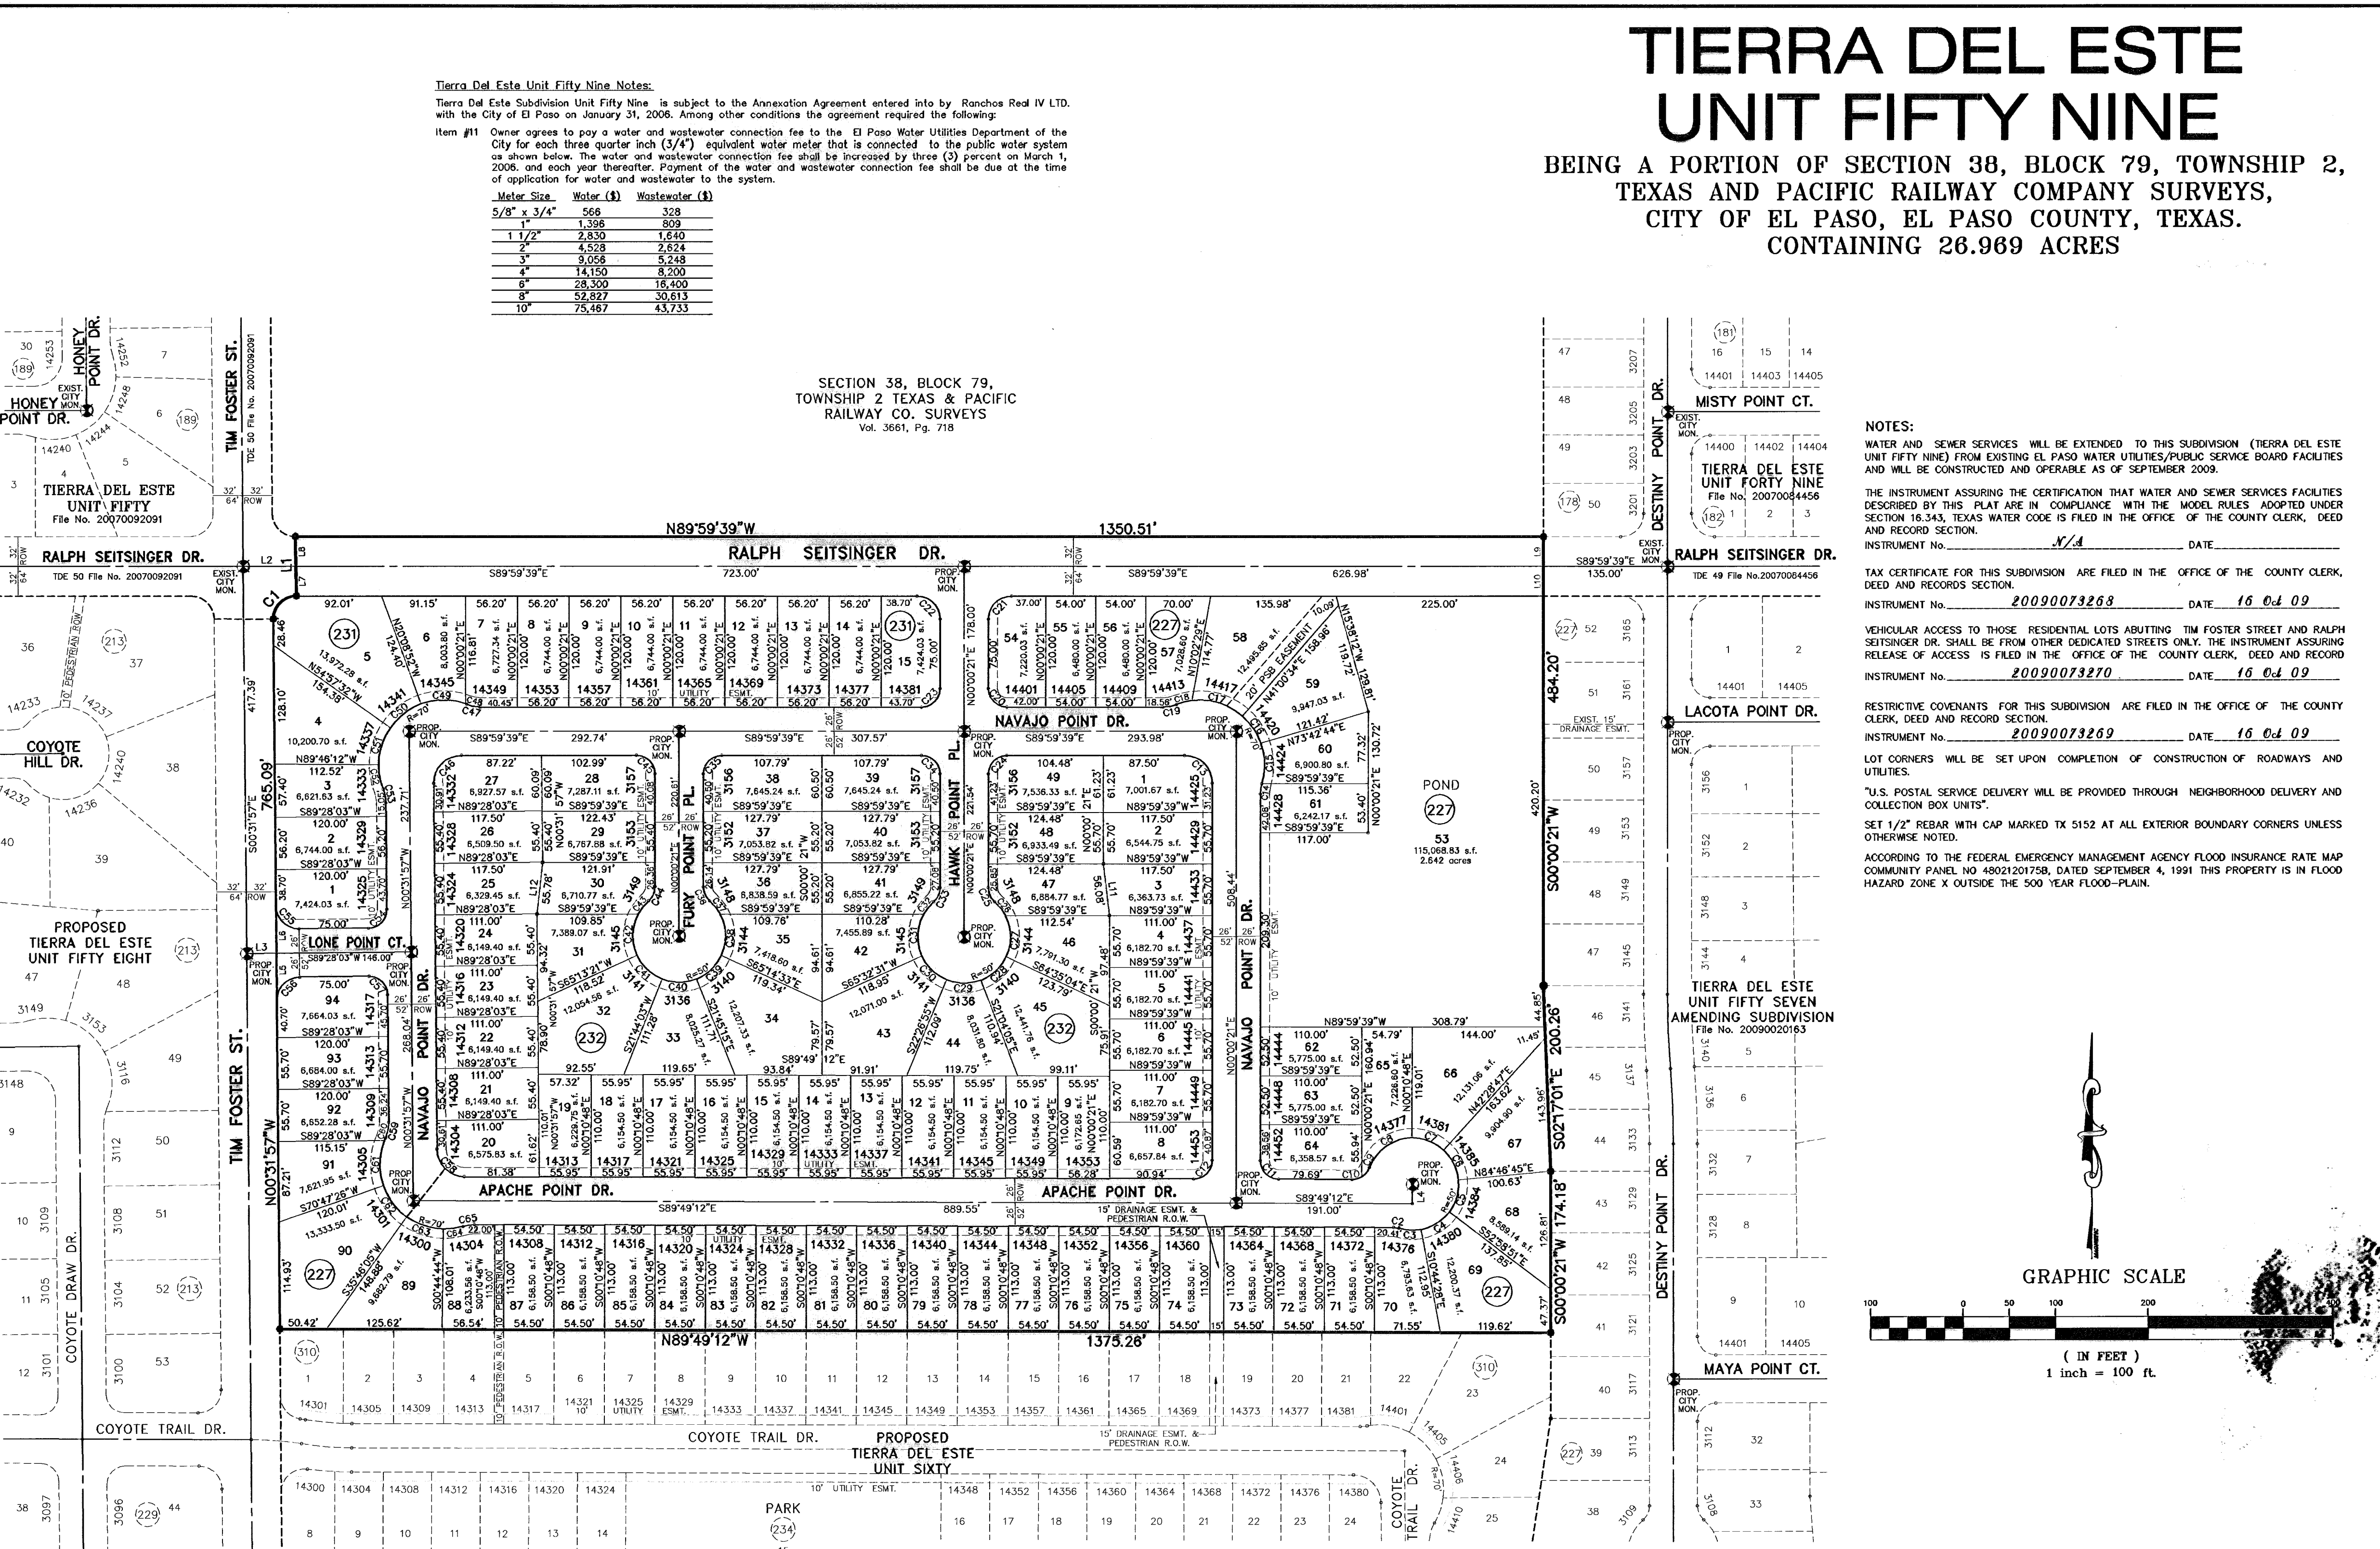

**Tierra Del Este Unit Fifty Nine Notes:**  
 Tierra Del Este Subdivision Unit Fifty Nine is subject to the Association Agreement entered into by Ranchos Real IV, L.P. with the City of El Paso on January 31, 2006. Among other conditions the agreement required the following:  
 Item #11 Owner agrees to pay a water and wastewater connection fee to the El Paso Water Utilities Department of the City for each three quarter inch (3/4") equivalent water meter that is connected to the public water system as shown below. The water and wastewater connection fee shall be increased by three (3) percent on March 1, 2008, and each year thereafter. Payment of the water and wastewater connection fee shall be due at the time of application for water and wastewater to the system.

Meter Size	Water (\$)	Wastewater (\$)
5/8" x 3/4"	1,396	809
1 1/2"	2,330	1,640
2"	4,528	2,624
3"	14,150	8,200
4"	28,300	16,400
6"	52,927	30,613
10"	75,467	43,733

CURVE	RADIUS	LENGTH	TANGENT	CHORD	BEARING	DELTA
C1	25.00	39.50	25.24	35.52	N44°44'12"E	90°32'18"
C2	20.00	5.88	2.96	5.86	N81°24'09"W	16°50'08"
C3	50.00	24.22	12.35	23.99	S86°51'47"E	27°45'22"
C4	50.00	36.86	19.31	36.03	S58°08'20"E	42°14'23"
C5	50.00	36.86	19.31	36.03	N15°53'57"E	42°14'23"
C6	50.00	39.91	19.34	39.08	N26°22'14"W	42°17'59"
C7	50.00	37.63	19.78	36.79	N63°04'58"W	43°07'39"
C8	50.00	59.56	33.88	58.10	S55°13'47"W	58°15'00"
C9	20.00	13.22	6.86	12.98	N40°02'36"E	37°52'37"
C10	20.00	10.89	5.58	10.76	N74°34'51"E	31°11'53"
C11	20.00	31.36	19.94	28.24	S44°54'28"E	89°49'32"
C12	20.00	31.48	20.08	28.33	N45°05'34"E	90°10'28"
C13	20.00	47.12	30.00	42.43	N44°59'39"W	90°00'00"
C14	40.00	11.48	5.78	11.44	S08°13'42"W	18°28'43"
C15	70.00	43.99	22.75	43.27	N01°33'07"W	36°00'20"
C16	70.00	35.96	18.39	35.57	N34°16'22"W	29°28'09"
C17	70.00	58.60	31.14	56.90	N72°58'18"W	47°57'40"
C18	70.00	17.50	8.79	17.45	S75°53'13"W	14°19'21"
C19	40.00	14.86	7.51	14.77	N79°21'57"E	21°18'48"
C20	20.00	31.42	20.00	28.28	S44°59'39"W	90°00'00"
C21	50.00	39.27	25.00	35.78	N63°04'58"W	43°07'39"
C22	25.00	39.27	25.00	35.78	N44°59'39"W	90°00'00"
C23	20.00	31.42	20.00	28.28	N45°00'21"W	90°00'00"
C24	20.00	31.42	20.00	28.28	S45°00'21"W	90°00'00"
C25	20.00	17.08	9.10	16.56	S24°27'11"E	48°55'04"
C26	50.00	18.89	9.56	18.79	N38°05'23"W	21°38'40"
C27	50.00	45.97	24.76	44.37	N00°53'54"W	52°40'59"
C28	50.00	37.98	19.96	37.07	N47°10'25"E	43°21'00"
C29	50.00	37.98	19.96	37.07	S89°18'35"E	43°31'00"
C30	50.00	37.61	19.74	36.73	S46°00'17"E	43°05'36"
C31	50.00	47.12	25.47	45.39	S02°32'20"W	53°59'38"
C32	50.00	16.92	8.54	16.84	S39°13'47"W	19°23'15"
C33	20.00	17.08	9.10	16.56	N24°27'52"E	48°55'04"
C34	20.00	31.42	20.00	28.28	N44°59'39"W	90°00'00"
C35	20.00	31.42	20.00	28.28	S45°00'21"W	90°00'00"
C36	20.00	17.08	9.10	16.56	S24°27'11"E	48°55'04"
C37	50.00	17.99	9.09	17.89	N38°36'21"W	20°36'45"
C38	50.00	46.30	24.96	44.66	N01°48'15"W	53°03'25"
C39	50.00	37.95	19.94	37.05	N46°30'08"E	43°29'18"
C40	50.00	37.95	19.94	37.05	S89°59'24"E	43°29'18"
C41	50.00	37.95	19.94	37.05	S48°31'8"E	43°29'18"
C42	50.00	46.28	24.95	44.65	S01°44'27"W	53°02'12"
C43	50.00	18.03	9.12	17.94	S38°35'29"W	20°39'51"
C44	20.00	17.08	9.10	16.56	N24°27'52"E	48°55'04"
C45	20.00	31.42	20.00	28.28	N44°59'39"W	90°00'00"
C46	30.00	47.41	30.28	42.63	S44°14'12"W	90°32'18"
C47	40.00	14.86	7.51	14.77	S79°21'18"E	21°18'48"
C48	70.00	1.32	0.66	1.32	N69°15'12"W	1°24'11"
C49	70.00	49.30	25.72	48.29	N89°58'12"W	40°21'20"
C50	70.00	42.53	21.94	41.88	S52°28'48"W	34°48'40"
C51	70.00	42.53	21.94	41.88	S17°38'08"W	34°48'40"
C52	70.00	28.93	13.63	26.76	S10°47'29"E	22°02'34"
C53	40.00	14.86	7.51	14.77	N11°02'21"W	21°18'48"
C54	20.00	31.42	20.00	28.28	N44°59'39"W	90°00'00"
C55	25.00	39.27	25.00	35.78	S45°13'57"E	90°00'00"
C56	25.00	39.27	25.00	35.78	S44°28'03"W	90°00'00"
C57	20.00	31.42	20.00	28.28	N45°31'57"W	90°00'00"
C58	30.00	46.75	29.63	42.16	S45°10'35"E	89°17'14"
C59	40.00	17.19	8.73	17.06	N11°46'38"E	24°37'12"
C60	70.00	3.05	1.53	3.05	S22°50'21"W	22°94'47"
C61	70.00	49.85	26.03	48.90	S01°11'27"W	40°49'40"
C62	70.00	42.79	22.09	42.13	S36°43'15"E	35°01'21"
C63	70.00	42.79	22.09	42.13	S71°44'36"E	35°01'21"
C64	70.00	21.88	11.03	21.79	N81°47'31"E	17°54'25"
C65	40.00	12.11	6.10	12.06	S81°30'33"W	17°20'29"


LINE	LENGTH	BEARING
L1	64.01	N00°57'11"W
L2	57.00	S89°59'39"E
L3	32.00	S89°28'03"W
L4	21.00	N00°00'21"E
L5	51.00	N00°31'57"W
L6	51.00	N00°31'57"W
L7	32.00	N00°57'11"W
L8	32.00	N00°57'11"W
L9	32.00	N00°00'21"E
L10	32.00	N00°00'21"E
L11	56.08	S08°39'02"E
L12	55.78	N06°09'33"E

DATE OF PREPARATION: MAY 18, 2008

**DEDICATION**  
 RANCHOS REAL XII, LTD., property owner of this land hereby present this plat and dedicate to the use of the public, the streets, drives, pond, pedestrian R.O.W., P.S.B. easement, drainage easement, and utility easements as hereon laid out and designated, including easements for overhead of service wires for pole type utilities, and buried service wires, conduits and pipes for underground utilities, and the right to ingress and egress for service and construction and the right to trim interfering trees and shrubs.  
 Witness our signature this 24th day of September, 2009.  
 By: /s/ Douglas A. Schwartz  
 Douglas A. Schwartz, VICE-PRESIDENT

**ACKNOWLEDGEMENT**  
 STATE OF TEXAS  
 COUNTY OF EL PASO  
 Before me, the undersigned authority, on this day personally appeared Douglas A. Schwartz, Vice-President of RANCHOS REAL XII, LTD., GENERAL PARTNER OF RANCHOS REAL XII, A TEXAS LIMITED PARTNERSHIP, ON BEHALF OF SAID LIMITED PARTNERSHIP, known to me to be the person whose name is subscribed to the foregoing instrument and acknowledged to me that he executed the same as the act and deed of said corporation for the purpose and considerations herein expressed.  
 Given under my hand and seal of office this 24th day of September, 2009.  
 By: /s/ Jason McMillan  
 Notary Public in and for El Paso County My Commission Expires 3-16-13

**CITY PLAN COMMISSION**  
 This subdivision is hereby approved as to the platting and as to the condition of the dedication in accordance with Chapter 212 of the Local Government Code of Texas this 12 day of October, 2009.  
 Approved for filing this 7 day of October, 2009.  
**FILING**  
 Filed and recorded in the office of the County Clerk of El Paso County, Texas, this 16 day of October, 2009, A.D. in File No. 20090073267  
 Prepared by and under the supervision of: /s/ Yvonne Conde Curry  
 Yvonne Conde Curry, P.E. Registered Professional Engineer Registration No. 64648  
 This plat represents a survey made on the ground by me or under my supervision and complies with the current Texas Board of Professional Land Survey Technical Standards.  
/s/ Ron R. Conde  
 Ron R. Conde, Registered Professional Land Surveyor Texas License No. 5152

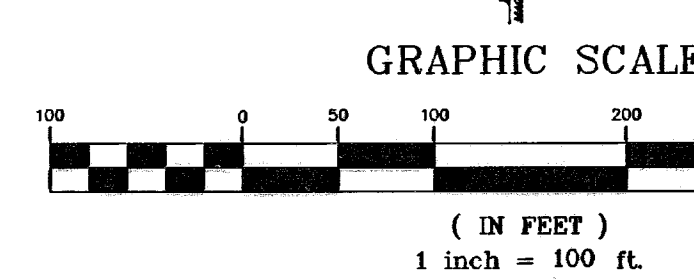

**NOTES:**  
 WATER AND SEWER SERVICES WILL BE EXTENDED TO THIS SUBDIVISION (TIERRA DEL ESTE UNIT FIFTY NINE) FROM EXISTING EL PASO WATER UTILITIES/PUBLIC SERVICE BOARD FACILITIES AND WILL BE CONSTRUCTED AND OPERABLE AS OF SEPTEMBER 2009.  
 THE INSTRUMENT ASSURING THAT WATER AND SEWER SERVICES FACILITIES DESCRIBED BY THIS PLAT ARE IN COMPLIANCE WITH THE MODEL RULES ADOPTED UNDER SECTION 16.343, TEXAS WATER CODE IS FILED IN THE OFFICE OF THE COUNTY CLERK, DEED AND RECORD SECTION.  
 INSTRUMENT NO. 20090073267 DATE 16 Oct 09  
 TAX CERTIFICATE FOR THIS SUBDIVISION ARE FILED IN THE OFFICE OF THE COUNTY CLERK, DEED AND RECORDS SECTION.  
 INSTRUMENT NO. 20090073268 DATE 16 Oct 09  
 VEHICULAR ACCESS TO THOSE RESIDENTIAL LOTS ABUTTING TIM FOSTER STREET AND RALPH SEITSINGER DR. SHALL BE FROM OTHER DEDICATED STREETS ONLY. THE INSTRUMENT ASSURING RELEASE OF ACCESS IS FILED IN THE OFFICE OF THE COUNTY CLERK, DEED AND RECORD SECTION.  
 INSTRUMENT NO. 20090073270 DATE 16 Oct 09  
 RESTRICTIVE COVENANTS FOR THIS SUBDIVISION ARE FILED IN THE OFFICE OF THE COUNTY CLERK, DEED AND RECORD SECTION.  
 INSTRUMENT NO. 20090073269 DATE 16 Oct 09  
 LOT CORNERS WILL BE SET UPON COMPLETION OF CONSTRUCTION OF ROADWAYS AND UTILITIES.  
 "U.S. POSTAL SERVICE DELIVERY WILL BE PROVIDED THROUGH NEIGHBORHOOD DELIVERY AND COLLECTION BOX UNITS".  
 SET 1/2" REBAR WITH CAP MARKED TX 5152 AT ALL EXTERIOR BOUNDARY CORNERS UNLESS OTHERWISE NOTED.  
 ACCORDING TO THE FEDERAL EMERGENCY MANAGEMENT AGENCY FLOOD INSURANCE RATE MAP COMMUNITY PANEL NO. 4802120758, DATED SEPTEMBER 4, 1991 THIS PROPERTY IS IN FLOOD HAZARD ZONE X OUTSIDE THE 500 YEAR FLOOD-PLAIN.

**GENERAL NOTES:**

- IMPROVEMENT WITHIN CITY R.O.W. SHALL COMPLY WITH TITLE 19- SUBDIVISION ORDINANCE - "SUBDIVISION IMPROVEMENT DESIGN STANDARDS".
- CONTRACTOR SHALL PROVIDE TEMPORARY MEASURES FOR THE MANAGEMENT OF STORM WATER RUNOFF ENTERING, EXITING AND ON SITE DURING THE COURSE OF THE CONSTRUCTION. TEMPORARY BERMS, DESILTING BASIN, CHECK DAMS, PIPING ETC. SHALL BE PROVIDED AS NECESSARY.
- THE CONTRACTOR SHALL BE RESPONSIBLE FOR COORDINATION AND NOTIFICATION WITH ALL APPURTENANT UTILITY COMPANIES WHOSE LINES ARE WITHIN THE CONSTRUCTION CONTRACT AREA. THE CONTRACTOR SHALL NOTIFY UTILITY COMPANIES 48 HOURS PRIOR TO ANY CONSTRUCTION ON SITE. THE CONTRACTOR WILL BE RESPONSIBLE PHYSICALLY AND FINANCIALLY FOR ANY DISRUPTION TO SERVICE EITHER ON SITE OR OFF SITE DUE TO BREAKAGE OF UTILITY LINES.
- THE CONTRACTOR SHALL BE RESPONSIBLE FOR VERIFYING ALL DATA SHOWN ON THE PLANS. IF DISCREPANCIES ARE FOUND THE CONTRACTOR SHALL NOTIFY THE OWNER OR ENGINEER IMMEDIATELY SO THAT PROPER CORRECTIONS CAN BE MADE.
- EQUIPMENT OF A CONDITION AND DESIGN SUFFICIENT TO ENSURE A THOROUGH AND WORKMANLIKE PROSECUTION OF THE PROJECT SHALL BE USED AT ALL TIMES.
- ALL ELEVATIONS ARE TO CITY DATUM UNLESS OTHERWISE NOTED.
- ALL WASTE MATERIALS INCLUDING EXCAVATION, CURBING, PAVEMENT, ETC. SHALL BE DISPOSED OF AS DESIGNATED BY THE OWNER OR HIS REPRESENTATIVE.
- THE CONTRACTOR SHALL NOTIFY THE OWNER, OR HIS REPRESENTATIVE, IN SUFFICIENT TIME IN ADVANCE OF DELIVERY OF MATERIALS TO BE SUPPLIED BY HIM UNDER THIS PROJECT, IN ORDER THAT THE OWNER MAY ARRANGE, IF DESIRED, INSPECTION AND TESTING FOR SAME.
- SAFE AND REASONABLE ACCESS FOR THIS SITE MUST BE MAINTAINED AT ALL TIMES DURING THE LIFE OF THE PROJECT.
- ANY CAVITY REMAINING OPEN DURING NONWORKING HOURS MUST BE GUARDED BY FLASHER TYPE BARRICADES WITH STRINGERS PLACED BETWEEN THE TOPS OF THE BARRICADES.
- DEVELOPER SHALL COMPLY WITH SECTION 13.08.170 "EXCESSIVE PAVING CUTS" AS PER EL PASO MUNICIPAL CODE.

**GENERAL EARTHWORK NOTES:**


- ALL GRADING SHALL CONFORM TO THE CITY OF EL PASO GRADING ORDINANCE SECTION 18.44.
- THE CONTRACTOR SHALL CARRY ON HIS WORK WITH SPECIAL CARE AT ALL TIMES TO MAINTAIN THE NATURAL SURROUNDINGS AND EXISTING STRUCTURES IN AN UNDAMAGED CONDITION.
- NATURAL SUBGRADES TO SUPPORT STRUCTURAL FILL OR PAVEMENTS SHOULD BE STRIPPED OF ALL VEGETATION OR ORGANIC TOPSOIL. THE EXPOSED SUBGRADE SHOULD BE SCARIFIED JUST PRIOR TO FILL PLACEMENT TO A MINIMUM DEPTH OF 8 INCHES AND RECOMPACTED TO A MINIMUM OF 95% OF MAXIMUM DENSITY AS PER ASTM D-1557. ALL BACKFILL MATERIAL TO BE PLACED IN HORIZONTAL LAYERS NOT TO EXCEED EIGHT (8) INCH LIFTS AND COMPACTED AS BEFORE.
- TEMPORARY DUST AND EROSION CONTROL MEASURES SHALL BE PROVIDED FOR AT ALL TIMES. SEE SHEET 8 OF 24.
- ANY EROSION OF THE GRADED SITE DURING THE COURSE OF THE PROJECT SHALL BE CORRECTED PRIOR TO FINALIZATION OF THE PROJECT AT NO COST TO THE OWNER.
- ALL SLOPES AND SWALES WITHIN LOTS SHALL BE MAINTAINED BY LOT OWNER.

**CONSTRUCTION NOTES:**


- ALL CONCRETE FOR STRUCTURES SHALL BE 3000 PSI. UNLESS OTHERWISE NOTED.
- MINIMUM COVER FOR REINFORCING STEEL SHALL BE 2" UNLESS OTHERWISE NOTED.
- 95% COMPACTION REQUIRED FOR STRUCTURES AS PER ASTM D1557.
- REINFORCING SHALL CONFORM TO THE REQUIREMENTS OF ASTM A615 GRADE 60.
- RETAINING WALLS WILL BE REQUIRED WHERE THERE IS A GRADE DIFFERENCE OF 2 OR MORE FEET BETWEEN LOTS AND STREET. RETAINING WALL DESIGN AT TIME OF BUILDING PERMIT.

**ROCKWALL NOTES:**

- STONE FOR ROCKWALLS SHALL BE AS NEARLY UNIFORM IN SECTIONS AS IS PRACTICABLE. THE STONE SHALL BE DENSE AND RESISTANT OF AIR AND WATER.
- MORTAR MUST BE TYPE "S" 1800 P.S.I. AS PER ASTM C270.
- MASONRY WALLS OVER SIX (6) FEET IN HEIGHT AND THOSE USED FOR EARTH RETENTION OVER TWO (2) FEET MUST BE DESIGNED AS STRUCTURAL WALLS.
- WALLS ADJACENT TO PONDING AREAS OR DRAINAGE DITCHES MAY BE CONSTRUCTED OF BRICK, CINDER BLOCK, STONE OR CINDER BLOCK AND SHALL NOT BE LESS THAN SIX (6) FEET HIGH.
- ROCKWALL MORTAR JOINTS MUST NOT EXCEED TWO (2) INCHES.
- PROVIDE ONE (1) INCH EXPANSION JOINTS AT EVERY 100 FEET.
- ALL STONE SHALL BE THOROUGHLY SOAKED BEFORE BEING PLACED.
- NO RIVER ROCK SHALL BE ALLOWED.

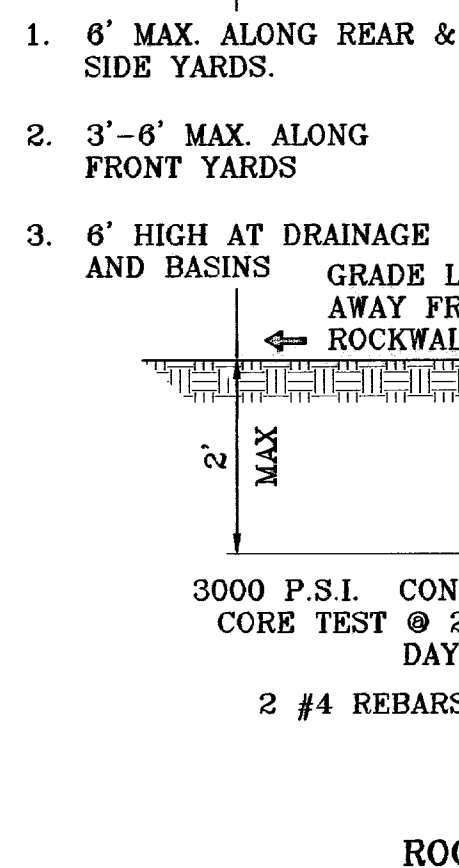


**ROCKWALL DETAIL**  
SCALE: 1"=2'

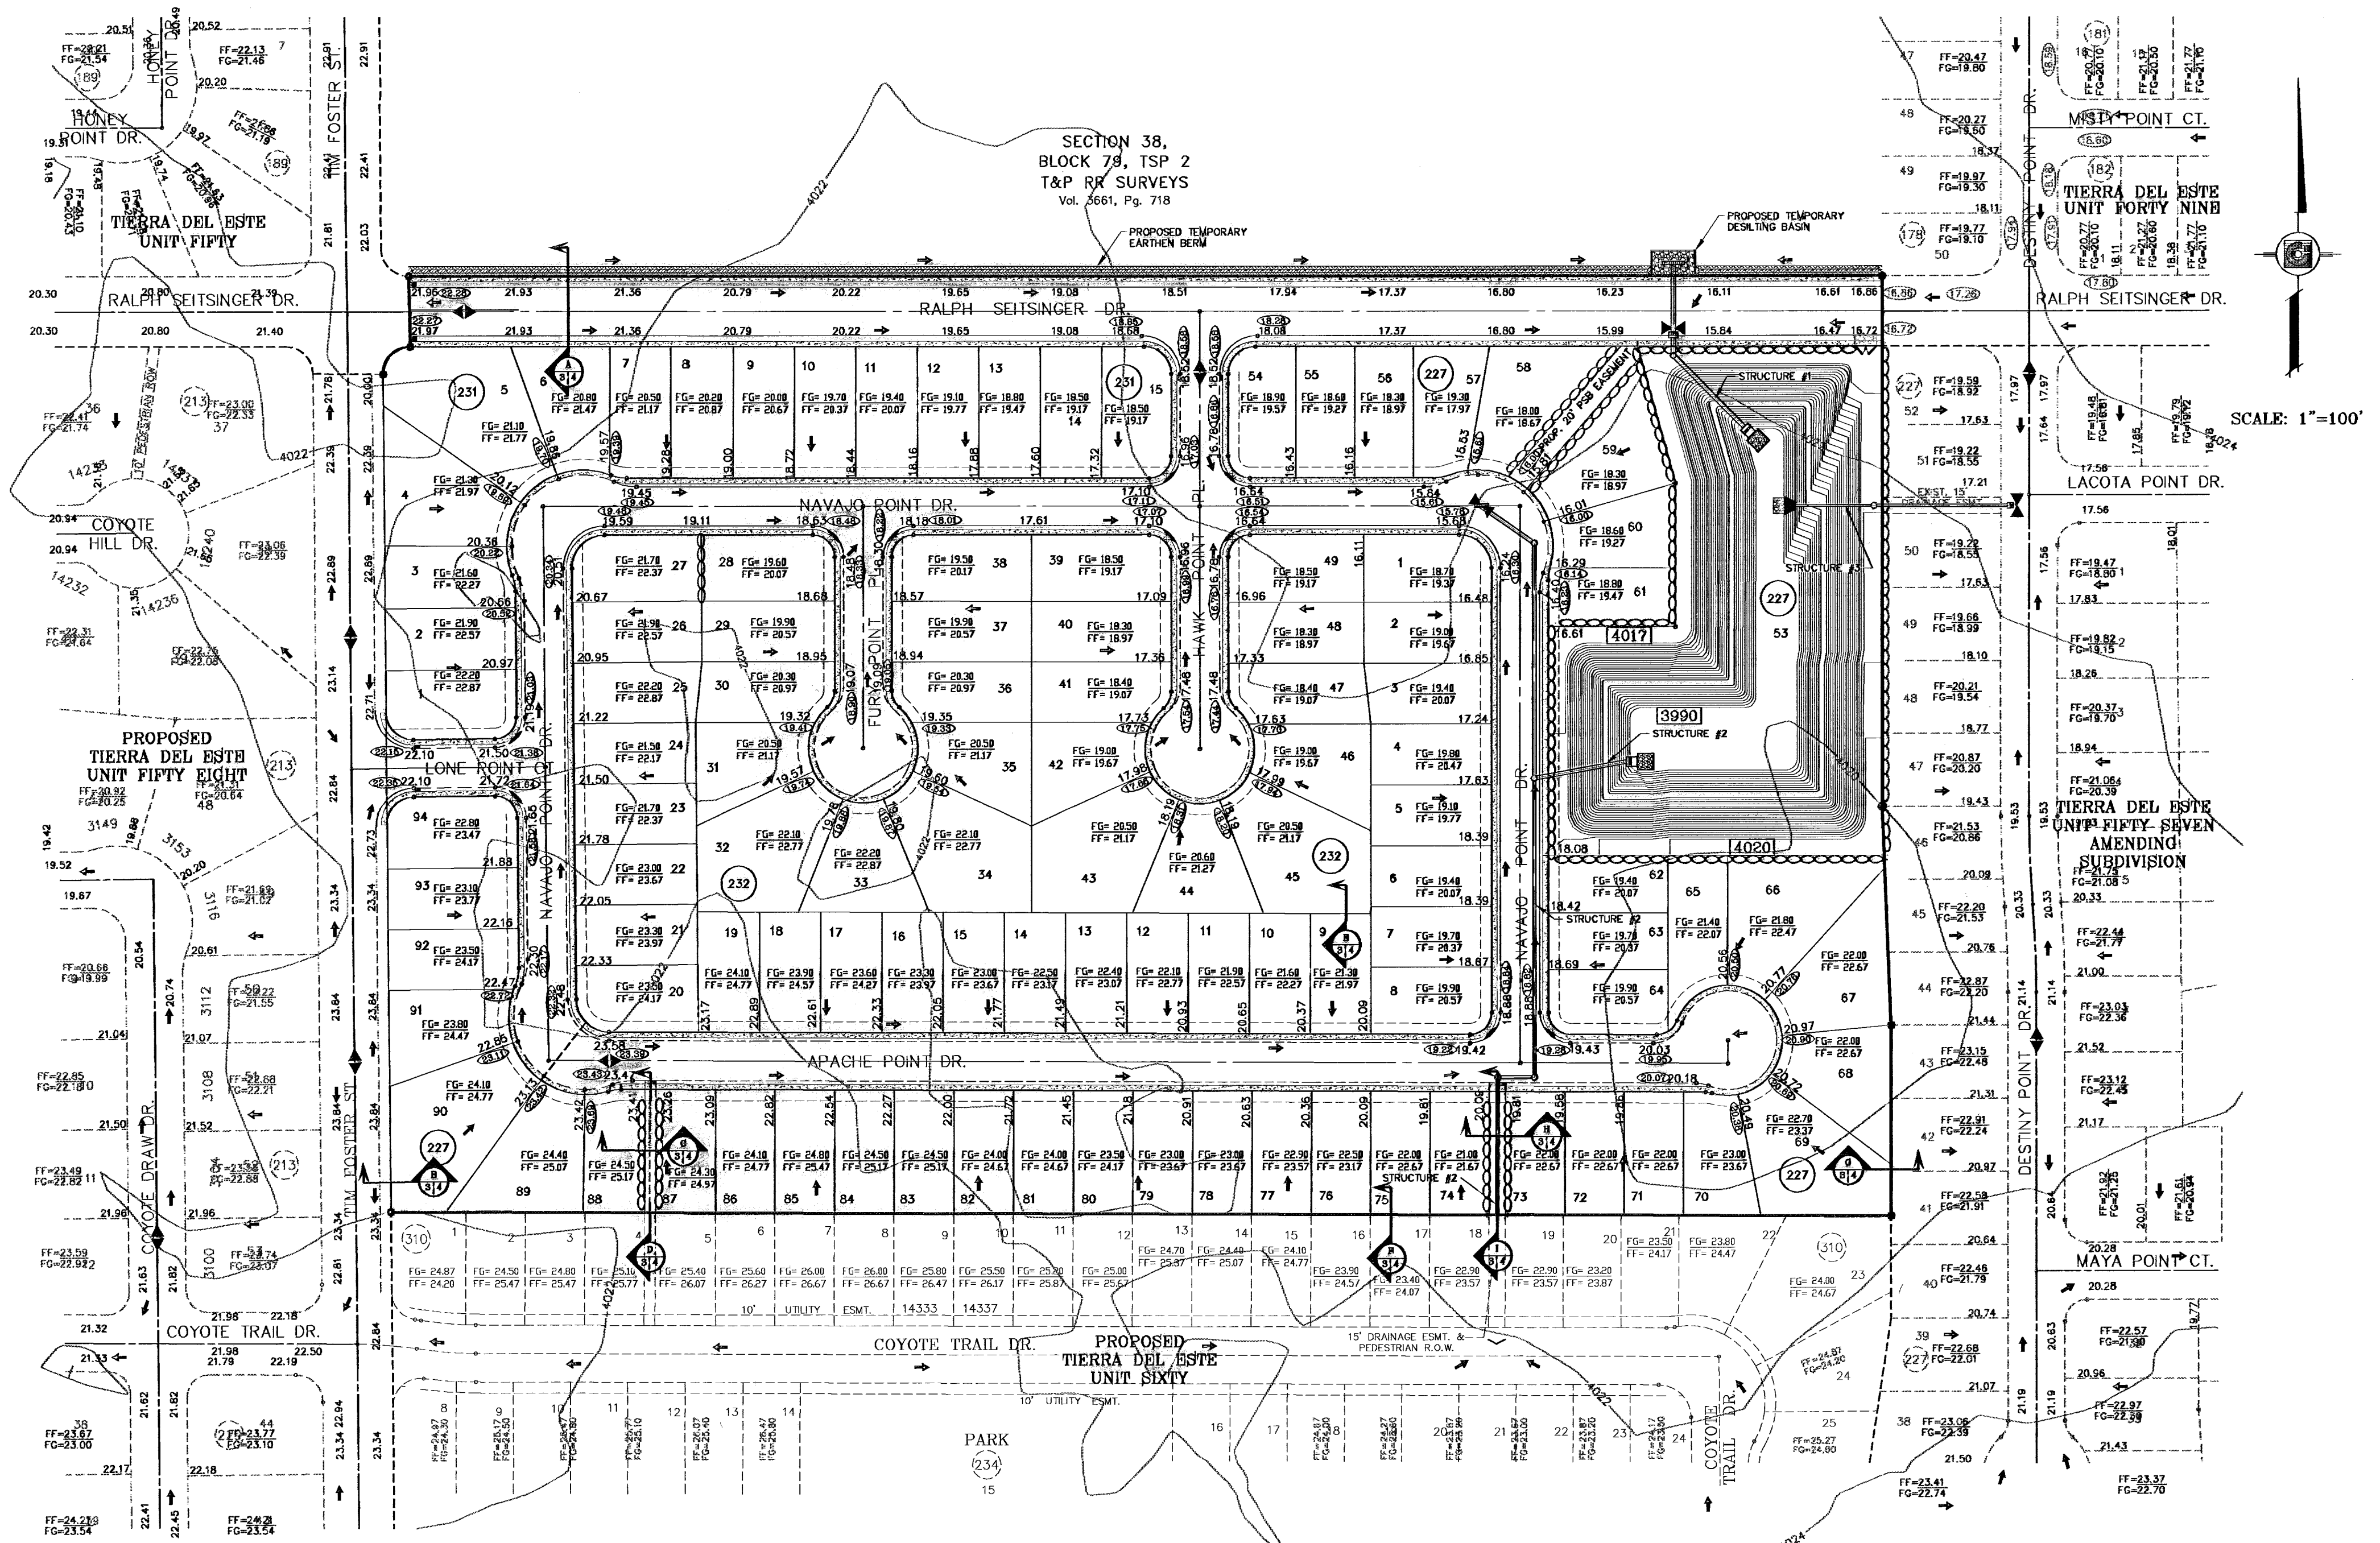

○ DENOTES AS BUILT CONDITION ONLY

NOTE:  
ALL HANDICAP RAMPS TO BE INSTALLED BY DEVELOPER

ALL UTILITIES SHALL BE PLACED IN PARKWAY. NO UTILITIES SHALL BE PLACED ON SIDEWALKS (i.e., NCDUB'S, FIRE HYDRANTS, LIGHT POLES, SIGNS, POWER POLES, etc....)

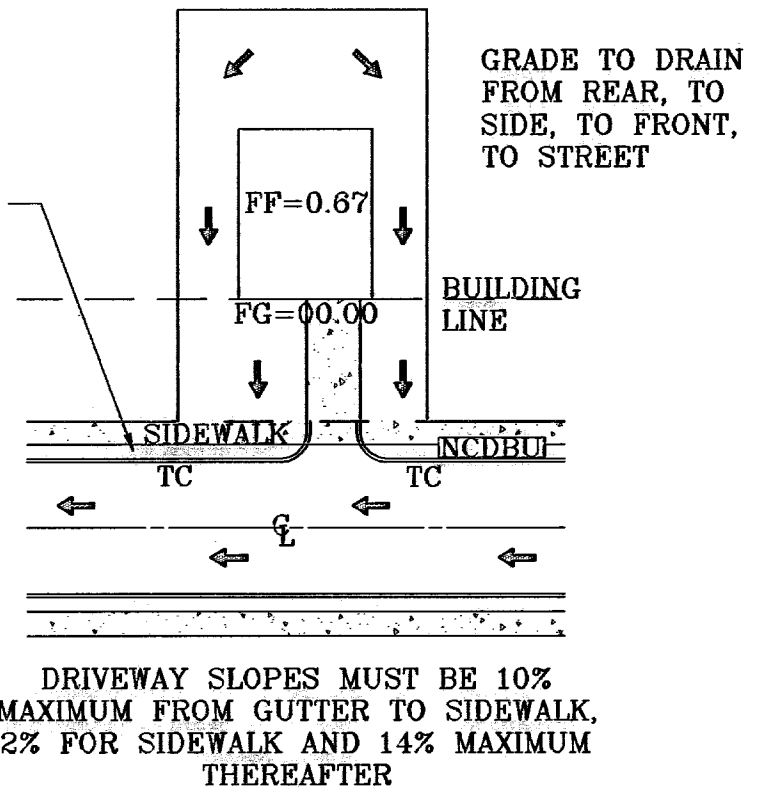

**TYPICAL LOT GRADING**  
SCALE: 1"=40'

**NOTE:**  
HEREON DESCRIBED TRACT LIES IN ZONE X, COMMUNITY PANEL NO. 480212 0175B. DATED SEPTEMBER 4, 1991.

SEE SHEET 18 AND 19 OF 24 FOR DRAINAGE STRUCTURES #1, #2 & #3

**LEGEND**



FF=00.00	PROPOSED FINISH FLOOR
FG=00.87	PROPOSED FINISH GROUND
00.00	PROPOSED SPOT ELEVATION
▲	HIGH POINT
▼	LOW POINT
— 4000	EXISTING CONTOUR
— 4000	EXISTING SPOT ELEVATION
— 4000	PROPOSED CONTOUR
—	PROPOSED ROCK WALL
—	PROPOSED RETAINING WALL

**REVISIONS**



DATE	REVISIONS	BY
12/04/08	CITY REDLINES AS PER 11/26/08 COMMENTS	E.F.C.
12/16/08	CITY REDLINES AS PER 12/16/08 COMMENTS	E.F.C.
02/27/09	REVISION TO POND	R.R.
06/09/09	LOT REVISIONS	R.R.

**TIERRA DEL ESTE UNIT FIFTY NINE**  
BEING A PORTION OF SECTION 38, BLOCK 79, TOWNSHIP 2, TEXAS AND PACIFIC RAILROAD COMPANY SURVEYS, CITY OF EL PASO, EL PASO COUNTY, TEXAS, CONTAINING 26.969 ACRES.

**CONDE INC.**  
ENGINEERING / PLANNING SURVEYING / GPS  
1790 LEE TREVINO STE. 400  
EL PASO, TEXAS 79936




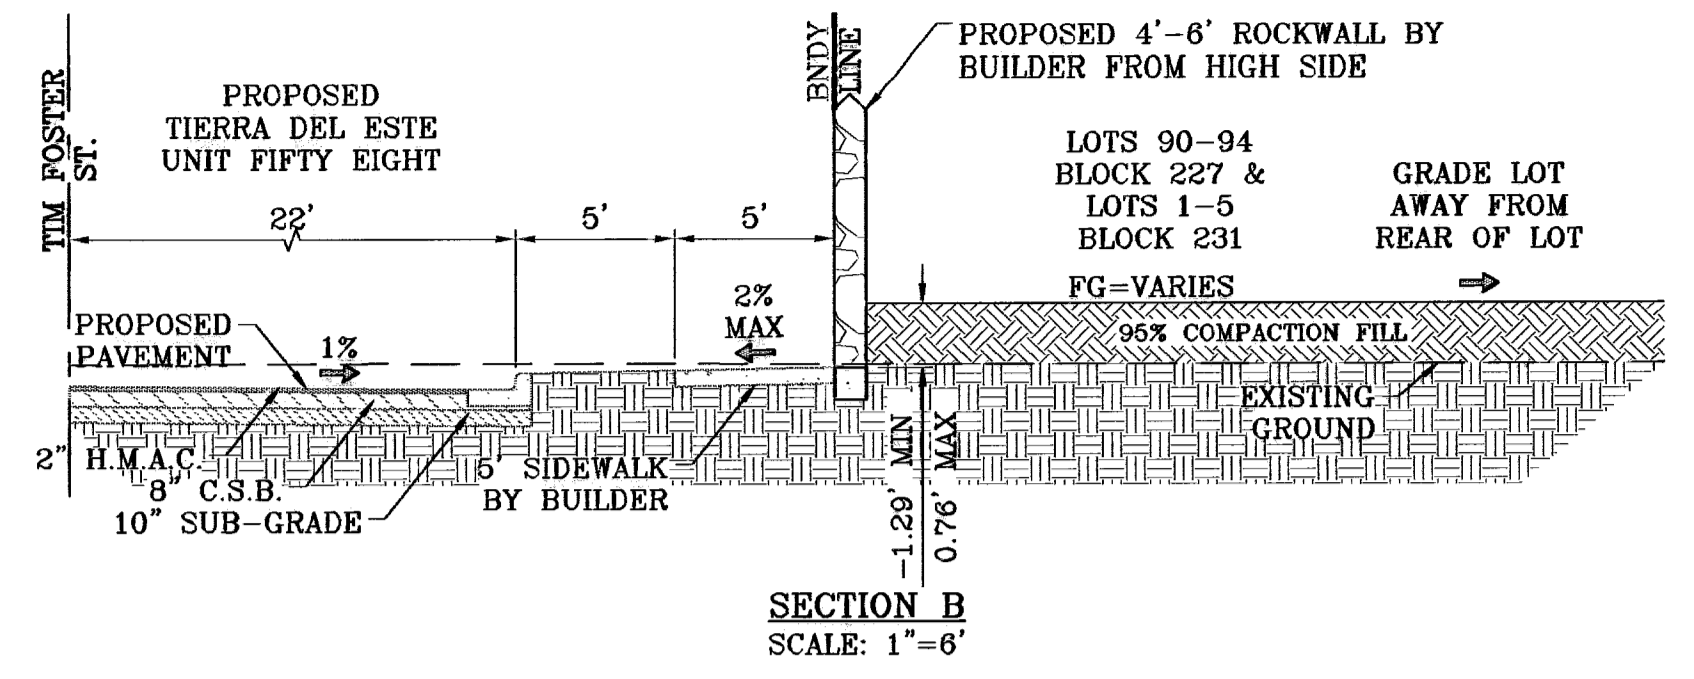
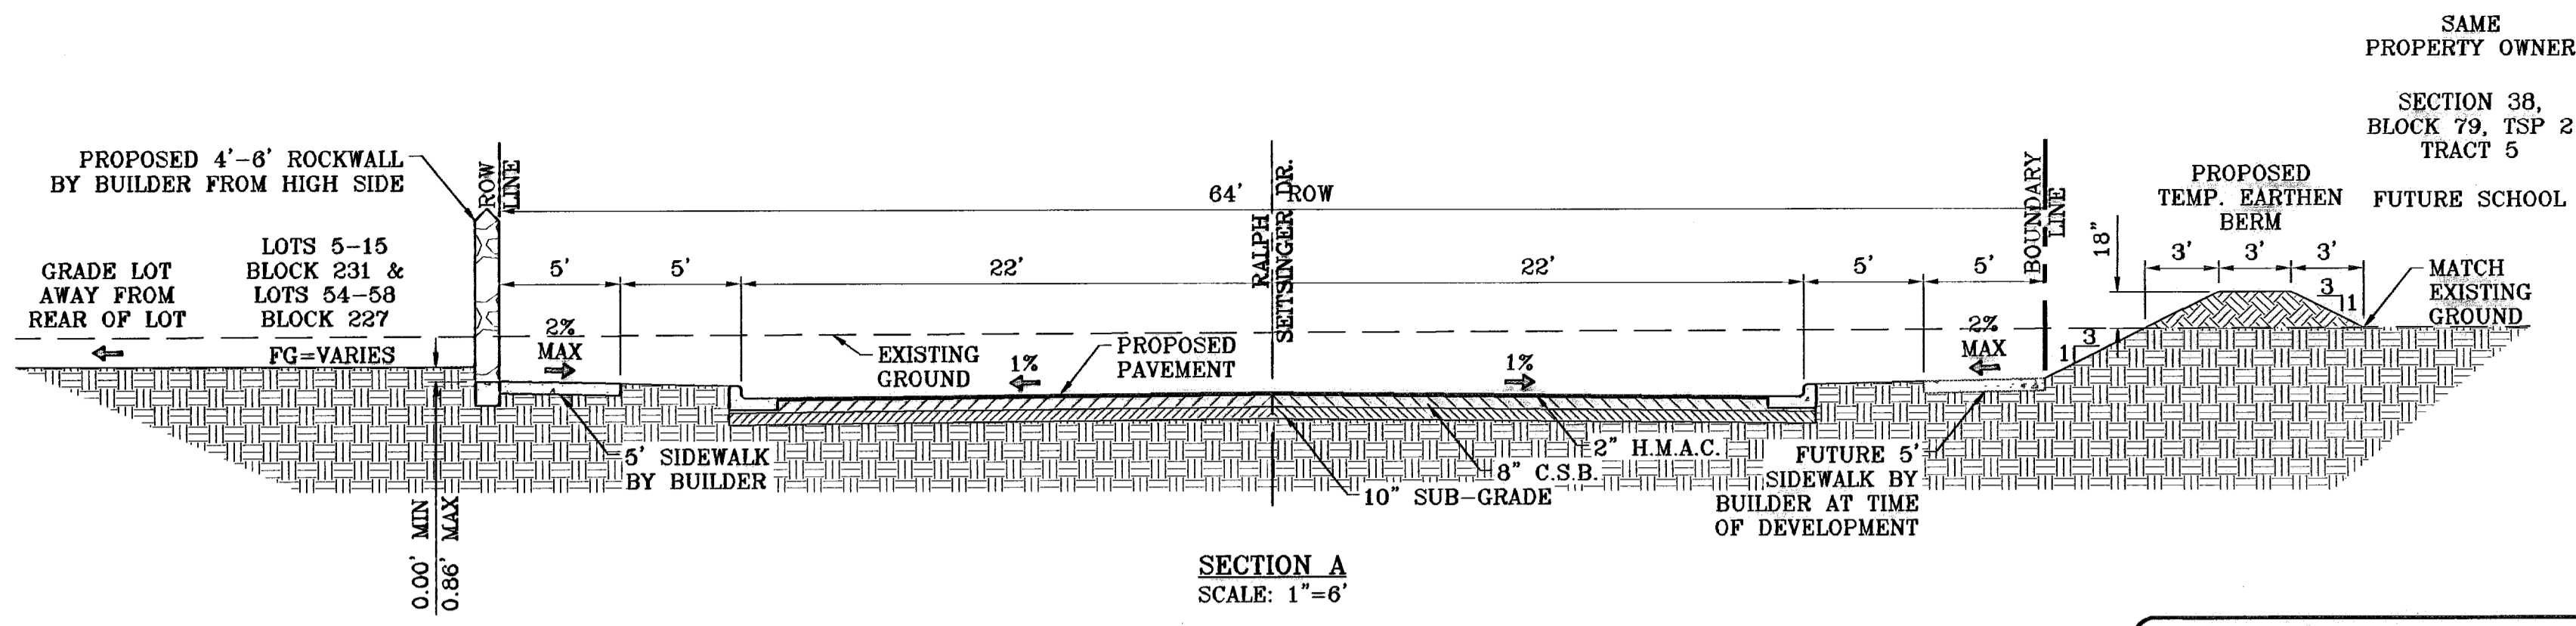


SEE SHEET 23 FOR PAVEMENT DETAILS

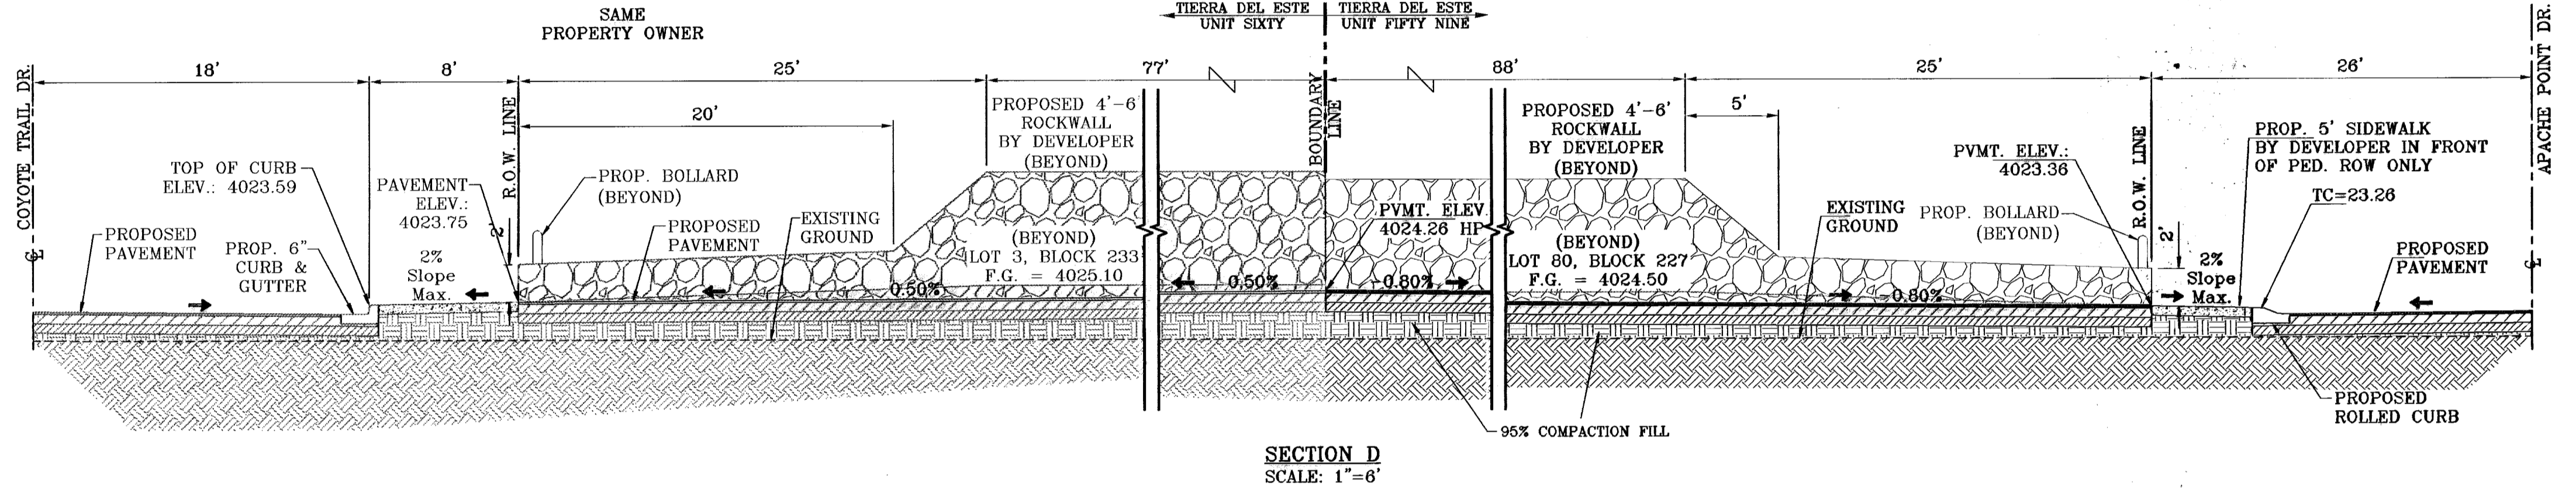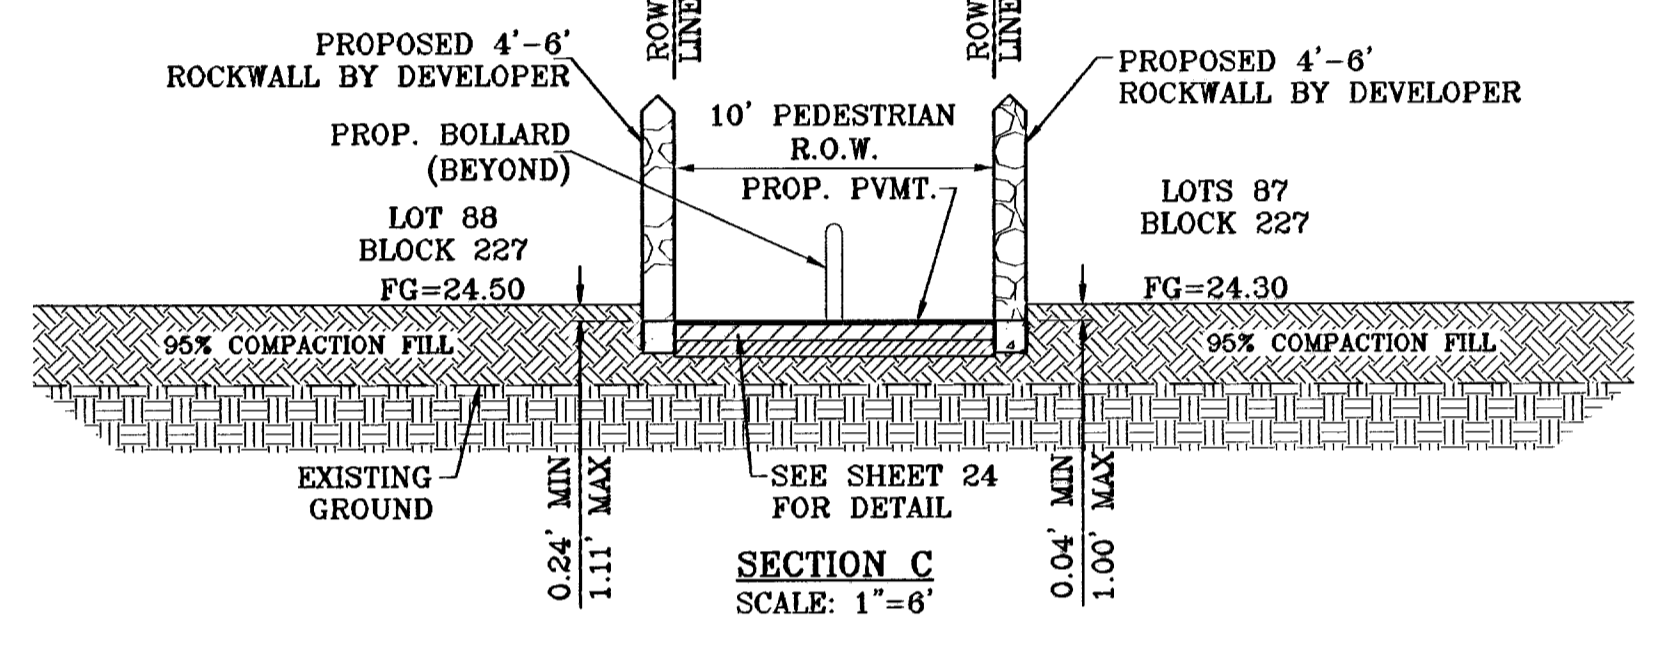

SEE SHEET 23 FOR PAVEMENT DETAILS

SEE SHEET 23 FOR PAVEMENT DETAILS

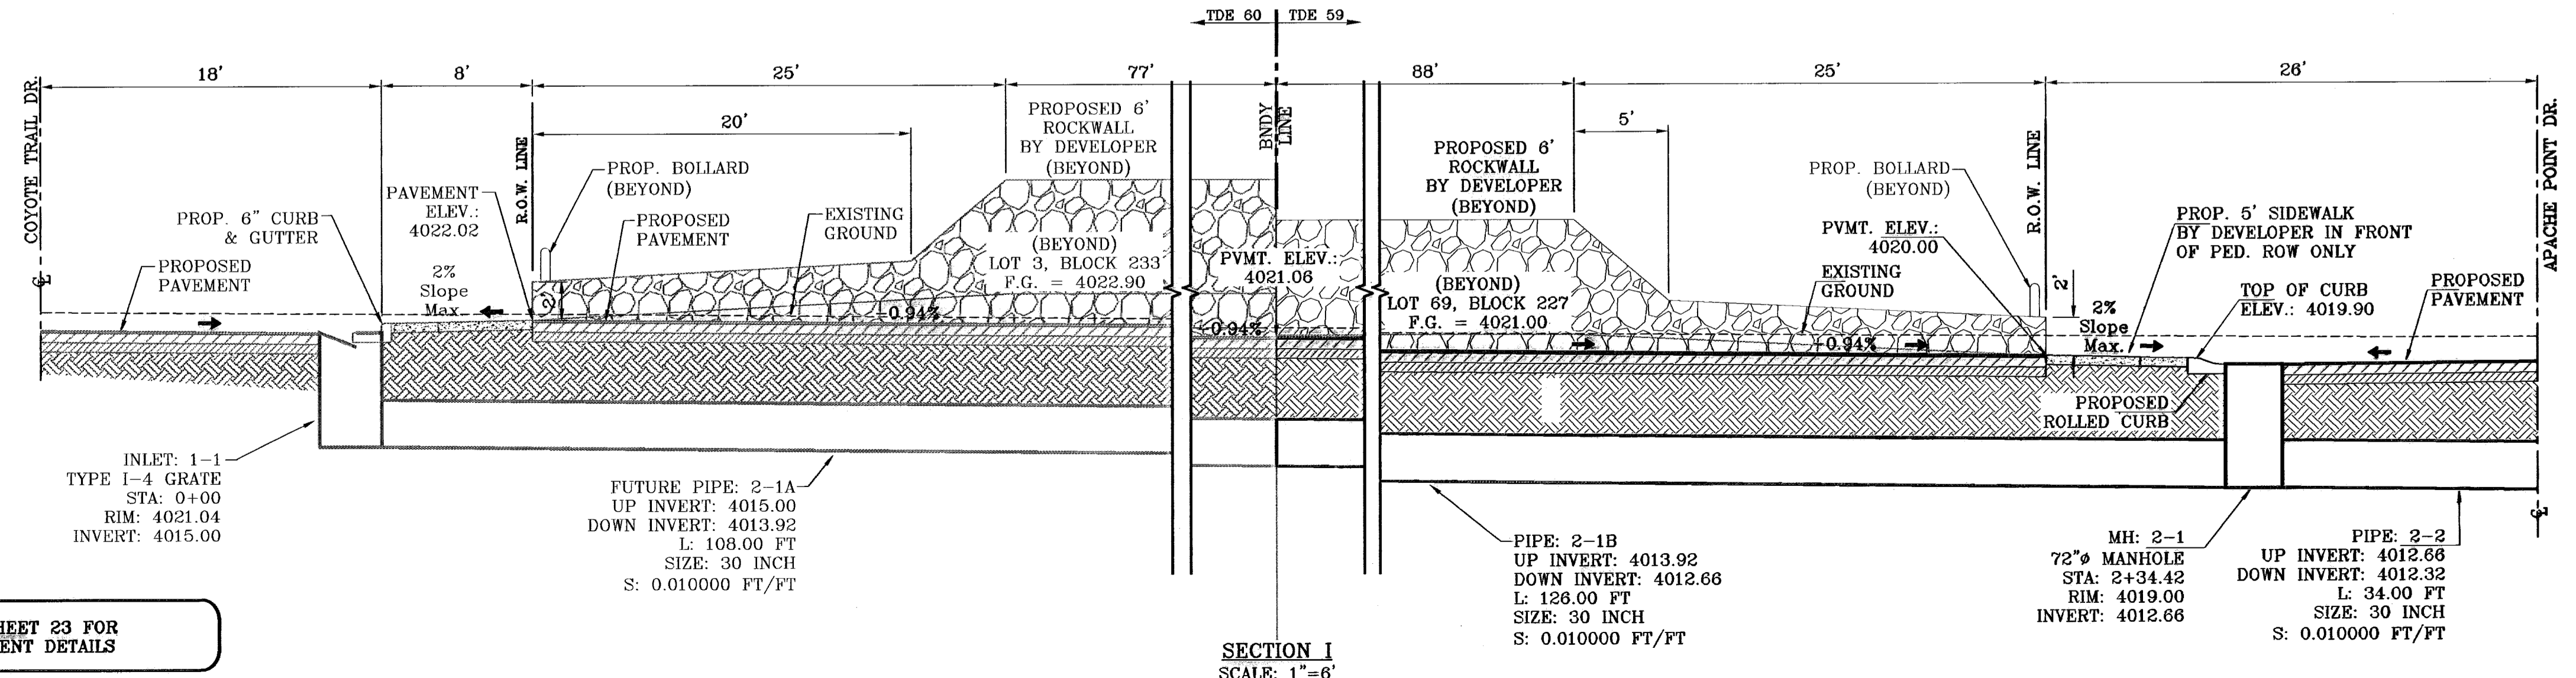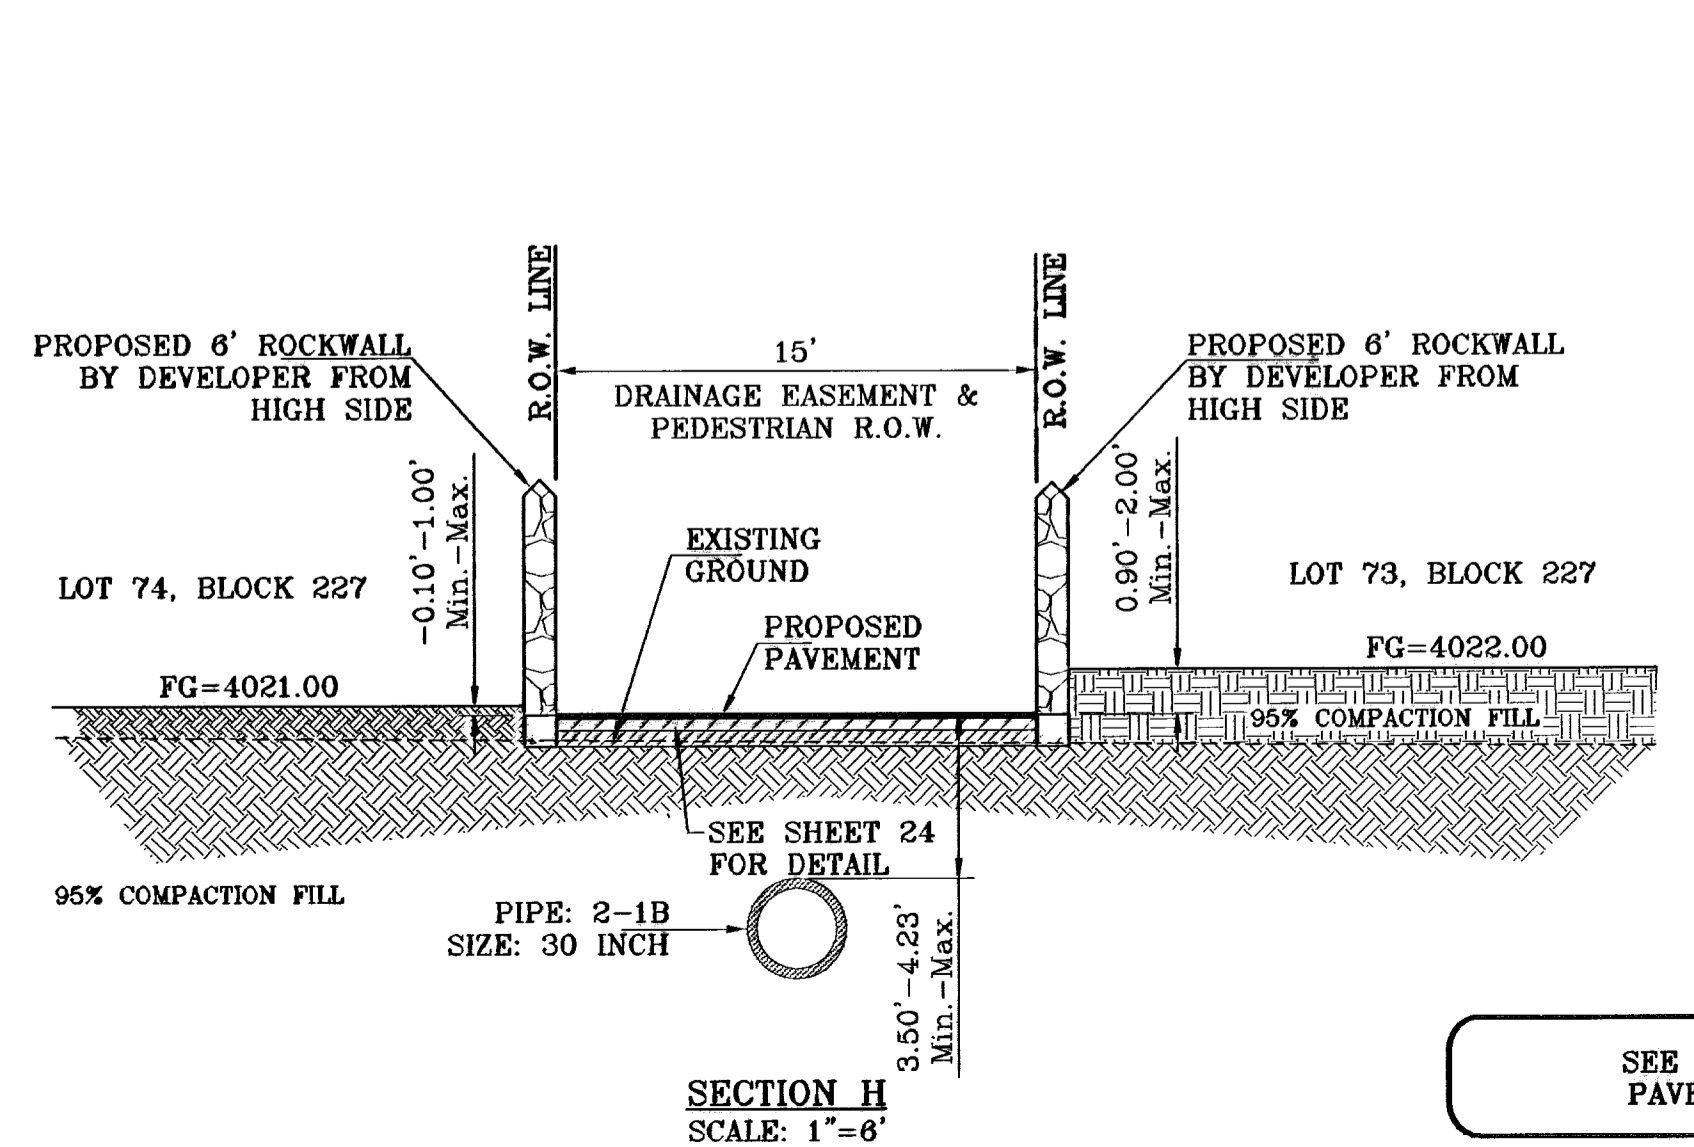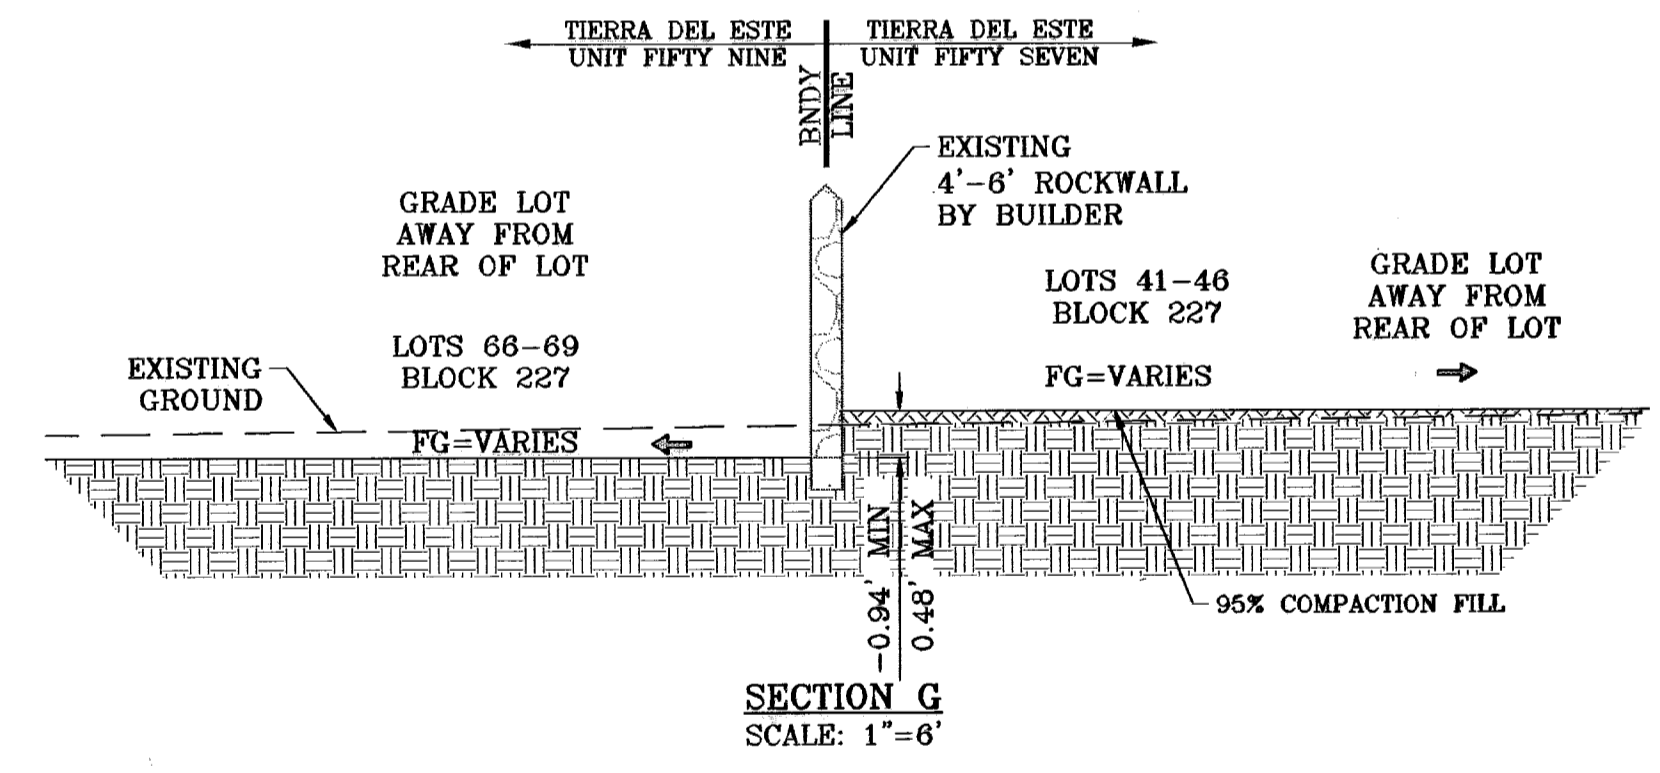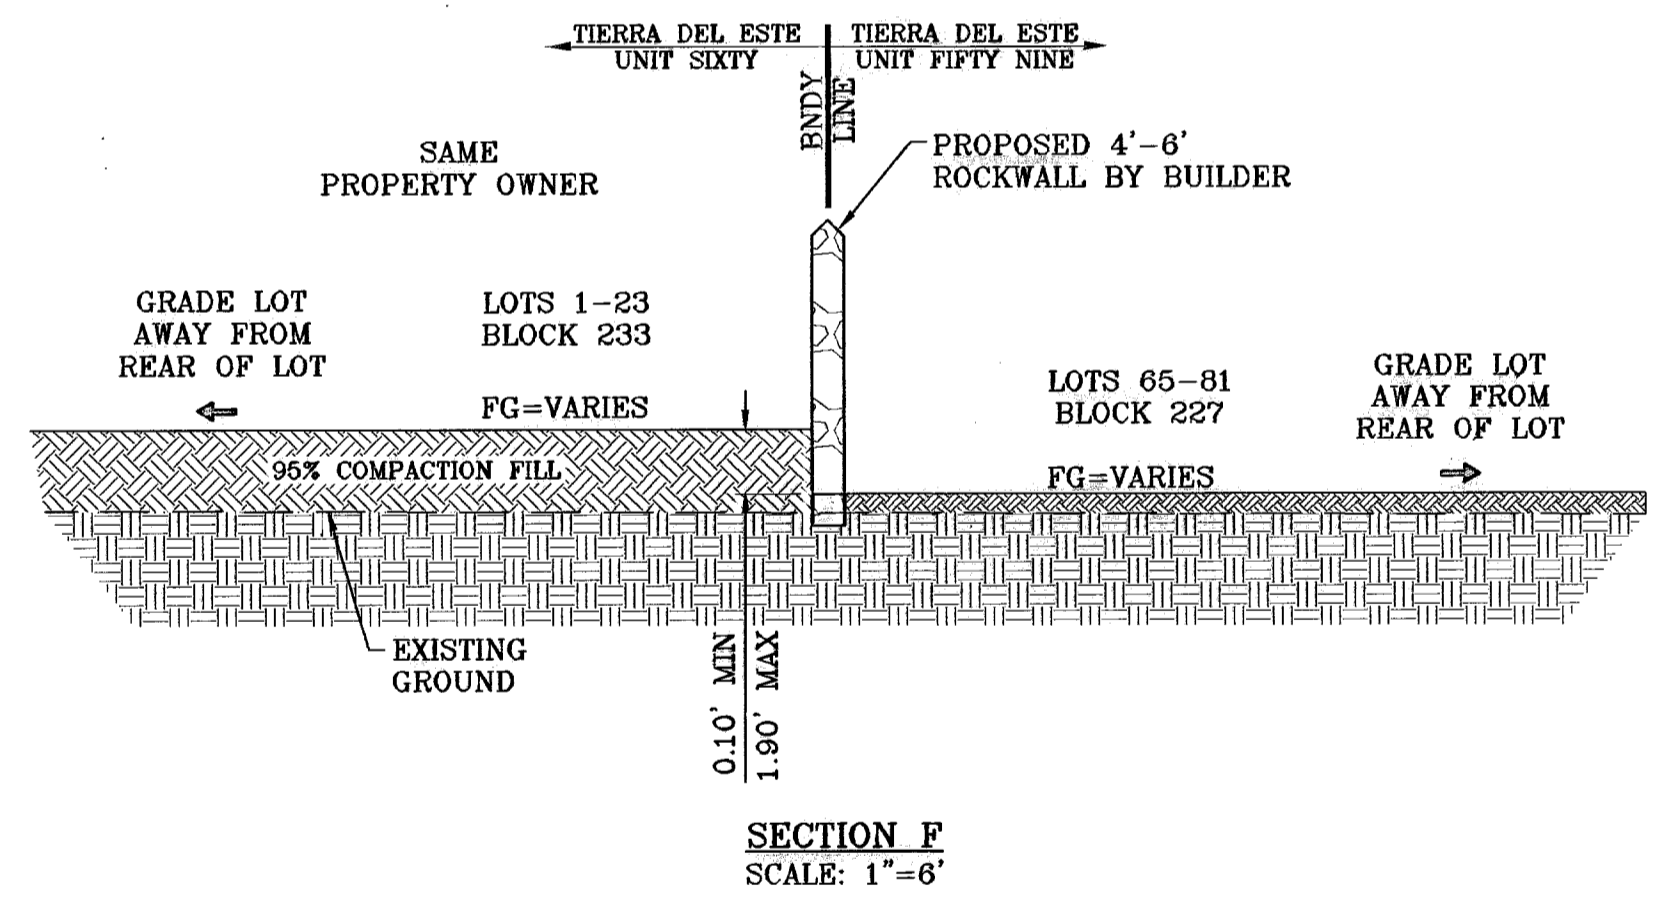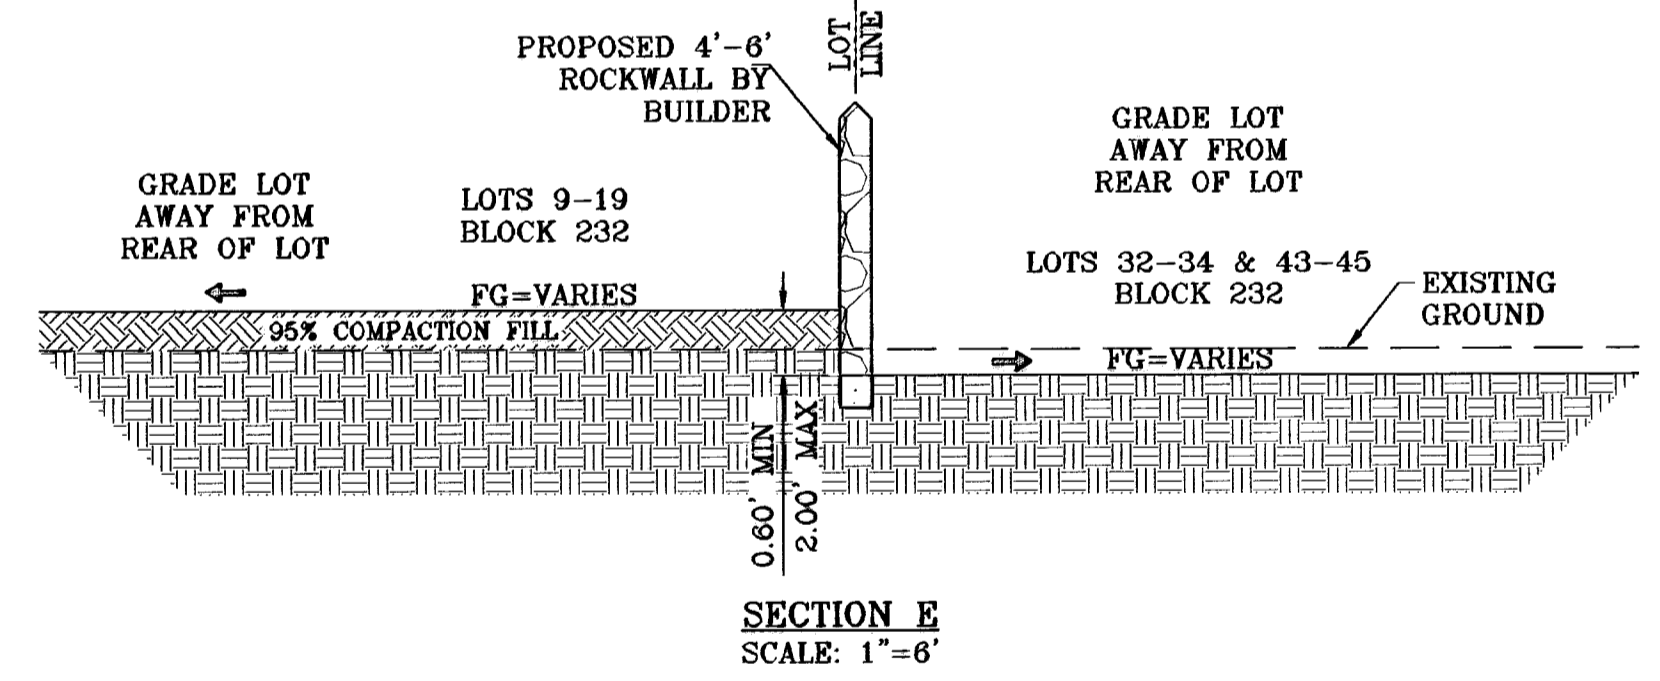

SEE SHEET 23 FOR PAVEMENT DETAILS

DATE	REVISIONS	BY
12/04/08	CITY REDLINES AS PER 11/29/08 COMMENTS	E.F.G.
12/18/08	CITY REDLINES AS PER 12/18/08 COMMENTS	E.F.G.
06/09/09	LOT REVISIONS	R.R.
09/28/09	CITY RED LINES	R.R.

PROJECT NAME  
**TERRA DEL ESTE UNIT FIFTY NINE**


BEING A PORTION OF SECTION 38, BLOCK 79, TOWNSHIP 2, TEXAS AND PACIFIC RAILROAD COMPANY SURVEYS, CITY OF EL PASO, EL PASO COUNTY, TEXAS, CONTAINING 26.969 ACRES

SCALE  
HORIZ: 1"=6'  
VERT: ---

DATE: MAY 2008  
DESIGN BY: Y.C.  
INITIATED BY: O.M.  
CHECKED BY: Y.C.  
JOB NO.: 608-23


CONDE INC.  
ENGINEERING / PLANNING  
SURVEYING / GPS

1760 LEE TREVINO STE 400  
EL PASO, TEXAS 79936

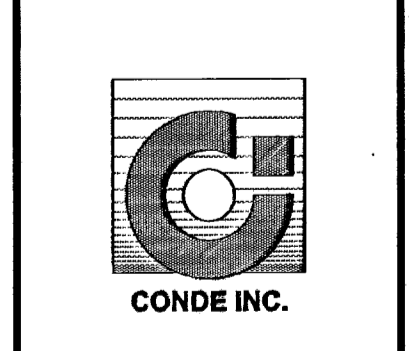

SHEET TITLE  
**GRADING SECTIONS**

SHT 4 OF 24

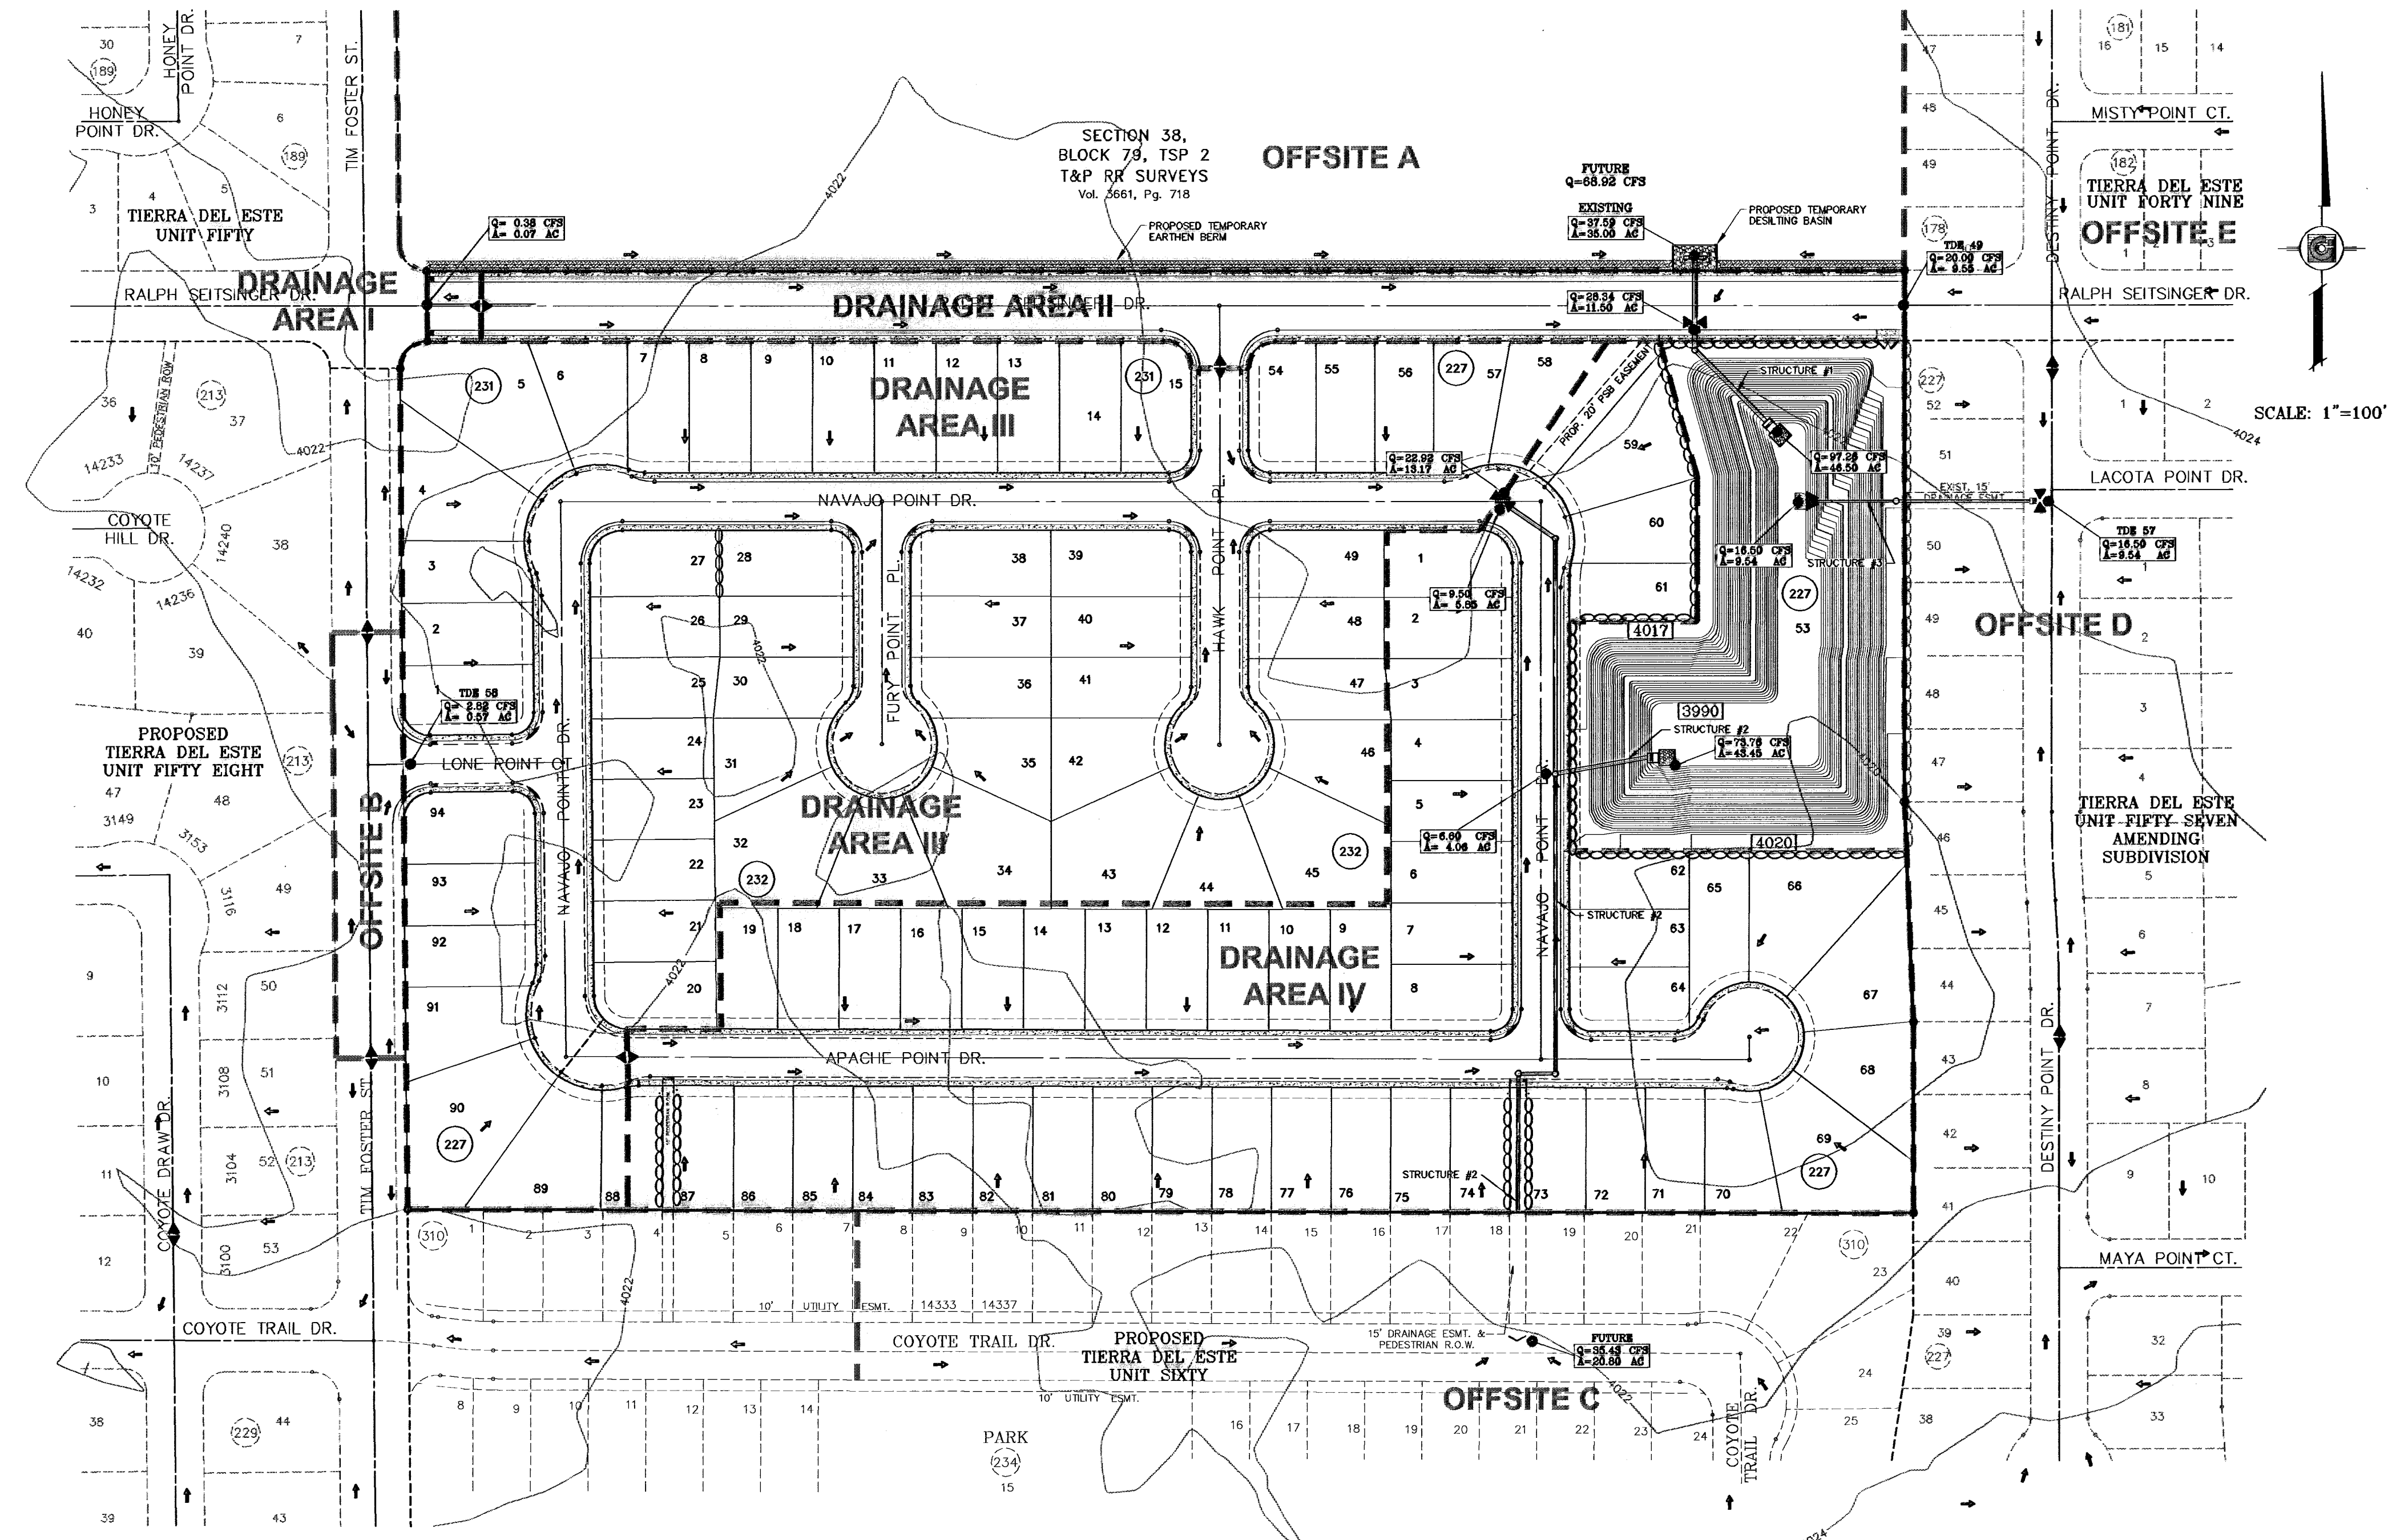

SCALE: 1"=100'

DRAINAGE AREA	AREA (acres)	tc min.	c	i <sub>50</sub> in/hr	Q <sub>50</sub> cfs
I	0.07	5.0	0.90	6.00	0.38
II	1.95	12.0	0.90	4.75	8.34
III	12.60	29.0	0.50	3.19	20.10
IV	9.91	28.0	0.50	3.25	16.10
OFFSITE A	35.00	24.0	0.55	3.58	68.92
OFFSITE B	0.57	8.0	0.90	5.50	2.82
OFFSITE C	20.80	28.0	0.50	3.41	35.43
OFFSITE D	9.54	25.5	0.50	3.48	16.50
OFFSITE E	9.55	25.0	0.60	3.49	20.00
POND	2.44	SEE POND CHART FOR CALCULATIONS			

**LEGEND**

- Q RUN-OFF QUANTITY (CUBIC Ft/Sec)
- A WATERSHED AREA (ACRES)
- ▲ HIGH POINT
- ▼ LOW POINT
- DRAINAGE FLOW
- - - - PROPOSED DRAINAGE AREA

SEE SHEET 18 AND 19 OF 24 FOR DRAINAGE STRUCTURES #1, #2 & #3

**NOTE:**  
HEREON DESCRIBED TRACT LIES IN ZONE X, COMMUNITY PANEL NO. 480212 0175B, DATED SEPTEMBER 4, 1991.

BENCHMARK  
NGS MARKER COPPER-CLAD STEEL ROD  
DESIGNATED X 1116 PID "C0341"  
ELEVATION : 3667.12


DATE	REVISIONS	BY
12/4/08	CITY REDLINES AS PER 11/26/08 COMMENTS	E.F.G.
12/16/08	CITY REDLINES AS PER 12/16/08 COMMENTS	E.F.G.
02/27/09	REVISION TO POND	R.R.
06/09/09	LOT REVISIONS	R.R.

PROJECT NAME  
**TERRA DEL ESTE UNIT FIFTY NINE**


BEING A PORTION OF SECTION 38, BLOCK 79, TOWNSHIP 2, TEXAS AND PACIFIC RAILROAD COMPANY SURVEYS, CITY OF EL PASO, EL PASO COUNTY, TEXAS, CONTAINING 26.969 ACRES

SCALE  
HORIZ. 1"=100'  
VERT. ---

DATE: MAY 2008  
DESIGN BY: Y.C.  
INITIATED BY: O.M.  
CHECKED BY: Y.C.  
JOB NO.: 608-23

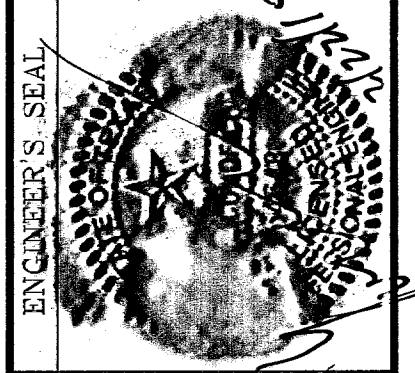



**CONDE INC.**  
ENGINEERING / PLANNING  
SURVEYING / GPS  
1700 LEE TREVINO STE. 400  
EL PASO, TEXAS 79936

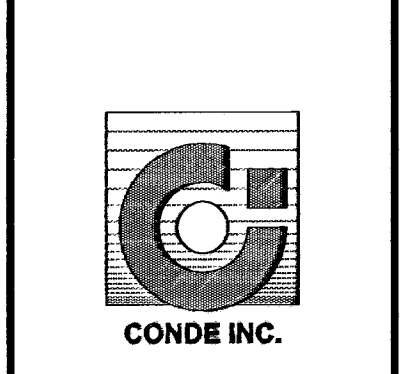

SHEET TITLE







**DRAINAGE PLAN**

- NOTES:**
1. T.P.D.E.S. PERMIT- AS REQUIRED BY CONTRACTOR
  2. STORM WATER AS PER N.P.D.E.S. PERMIT

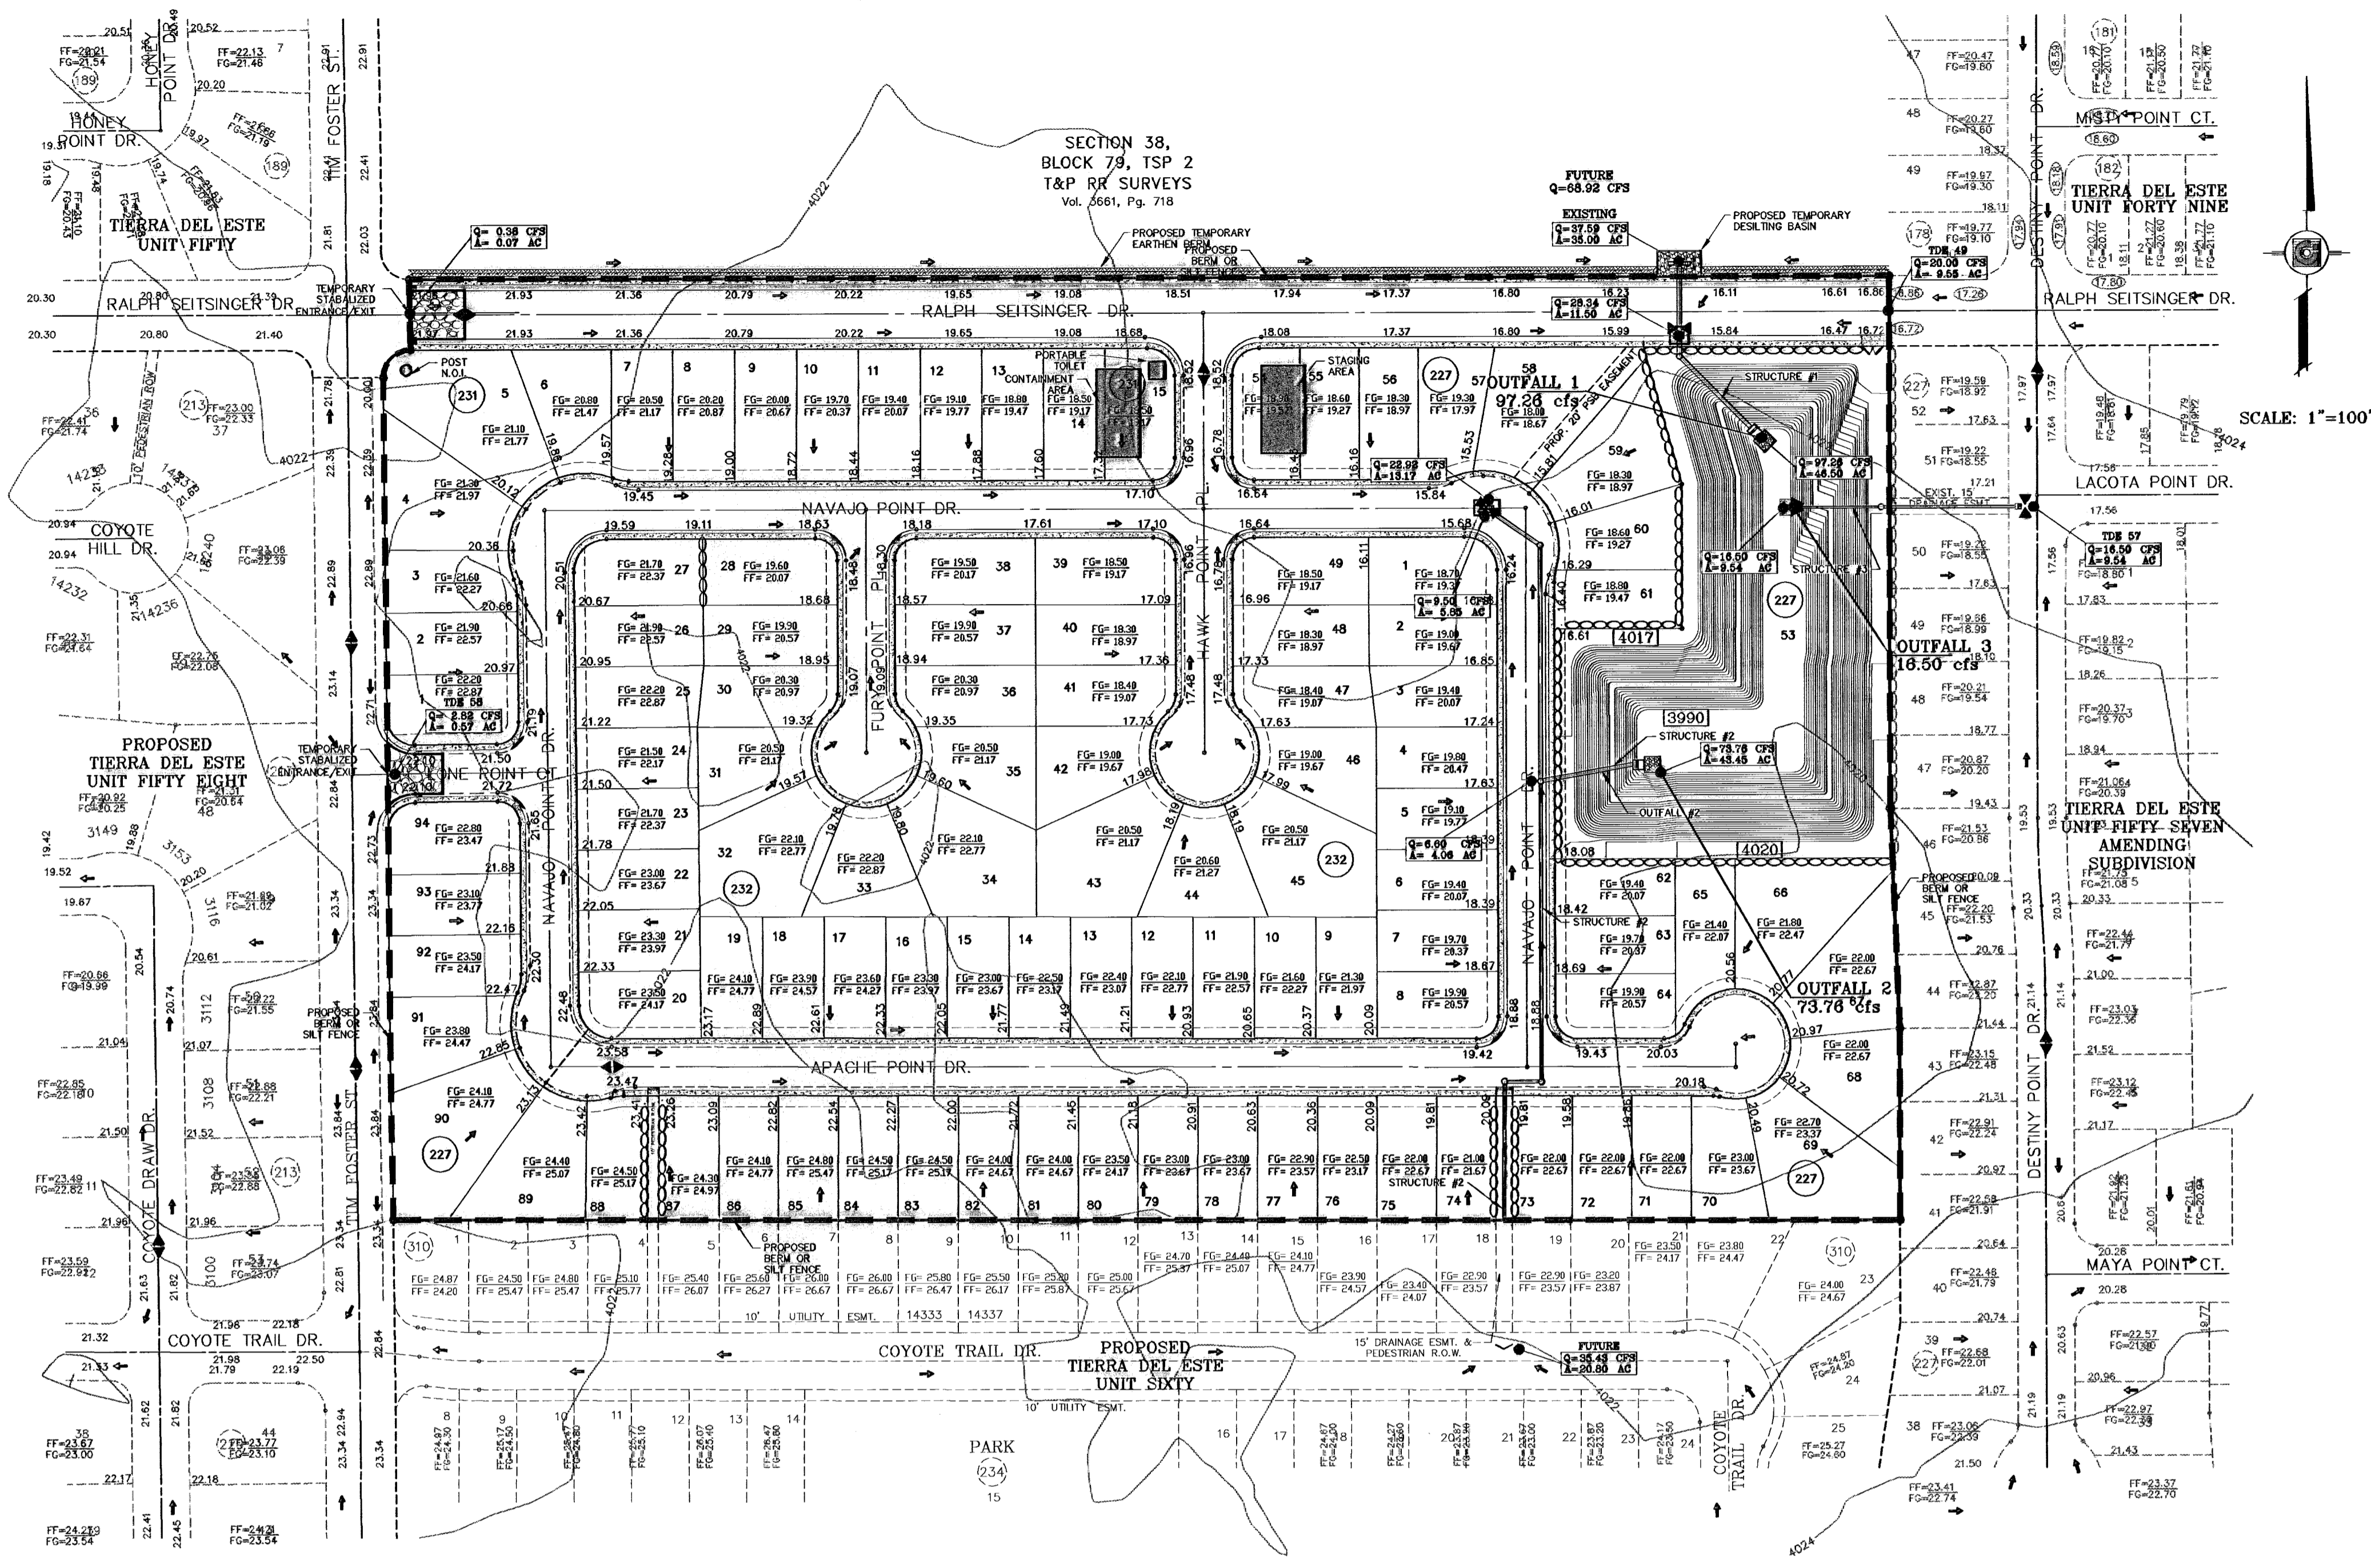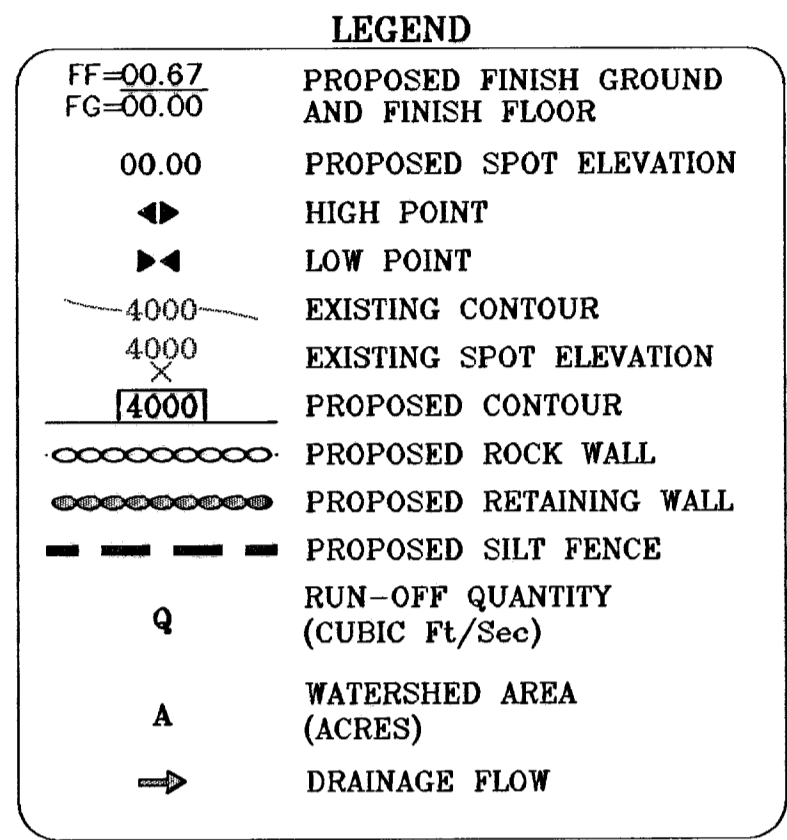

**STABILIZED ENTRANCE  
EROSION CONTROL NOTES**

1. SILT FENCING OR TEMPORARY BERMS SHALL BE INSTALLED AT TIME OF CONSTRUCTION.
2. TEMPORARY SWALES AND DESILTING BASINS WILL BE PLACED WHERE NECESSARY IN ORDER TO CONVEY STORM WATER RUN-OFF.
3. A STABILIZED CONSTRUCTION ENTRANCE WILL BE PROVIDED TO HELP REDUCE VEHICLE TRACKING OF SEDIMENTS. THE PAVED STREET ADJACENT TO THE SITE ENTRANCE WILL BE SWEEP WEEKLY TO REMOVE ANY EXCESS MUD, DIRT OR ROCK TRACKED FROM THE SITE.
4. THE OWNER SHALL BE RESPONSIBLE FOR INSURING THAT ALL EROSION CONTROL METHODS ARE INSPECTED ON A MONTHLY BASIS OR AFTER EVERY ERODIBLE RAINFALL (1/2" OR MORE). ANY NECESSARY REPAIRS OR CLEANUP TO MAINTAIN THE EFFECTIVENESS OF THE EROSION CONTROL SHALL BE MADE AT THE TIME.
5. A TEMPORARY BERM SHALL BE PROVIDED AT THE TOE OF SLOPE AND LOT LINE AT TIME OF GRADING PRIOR TO ROCKWALL CONSTRUCTION.

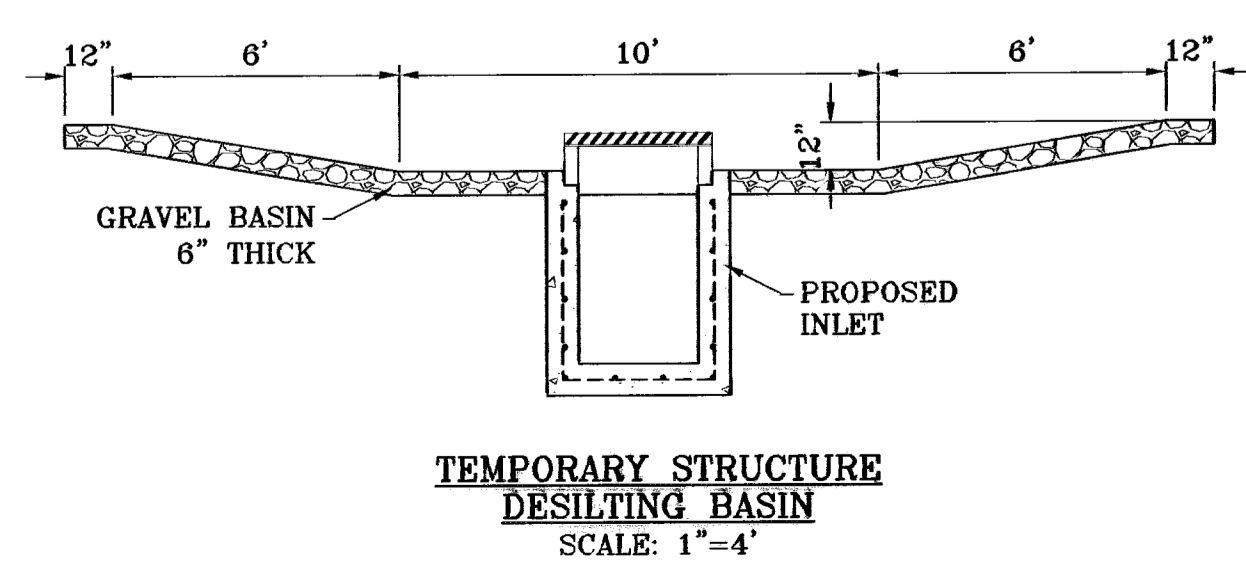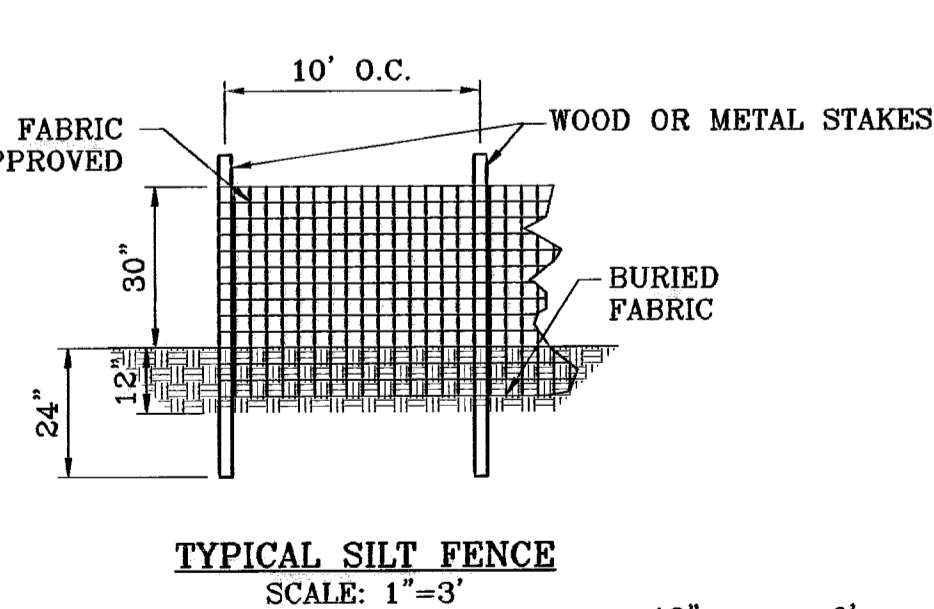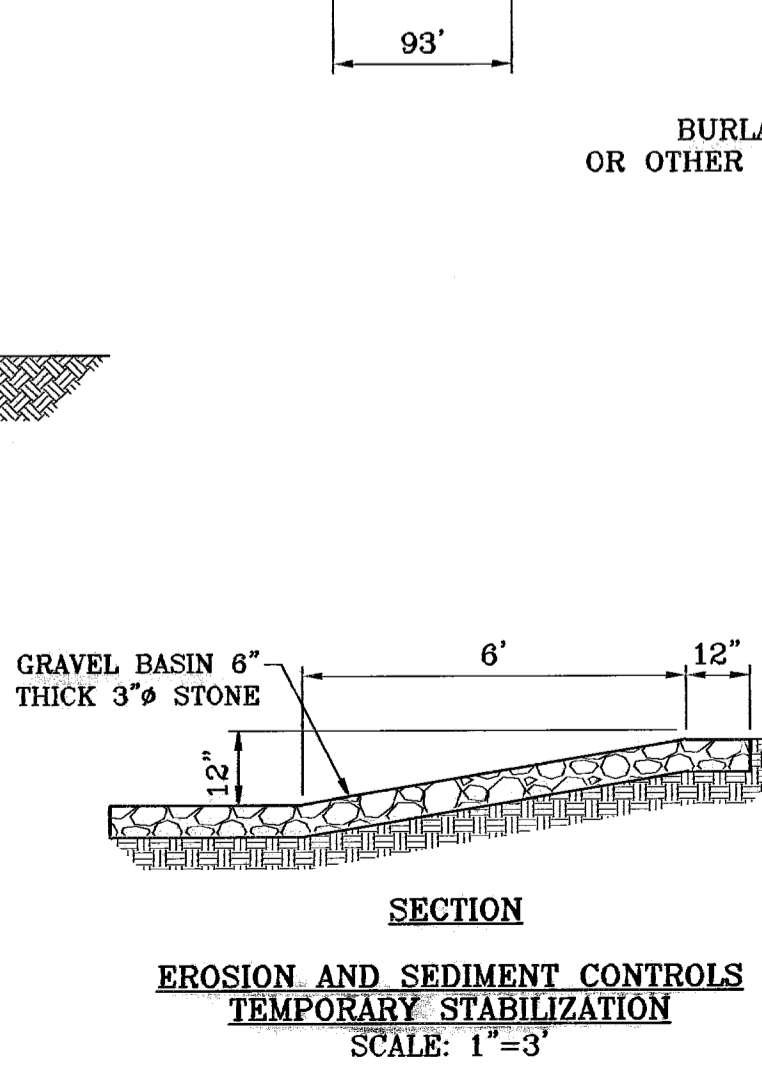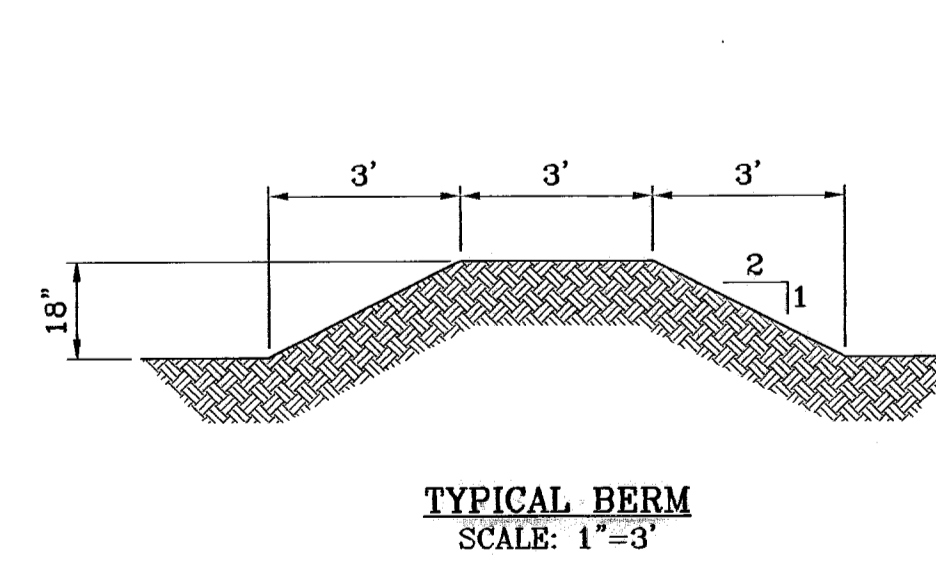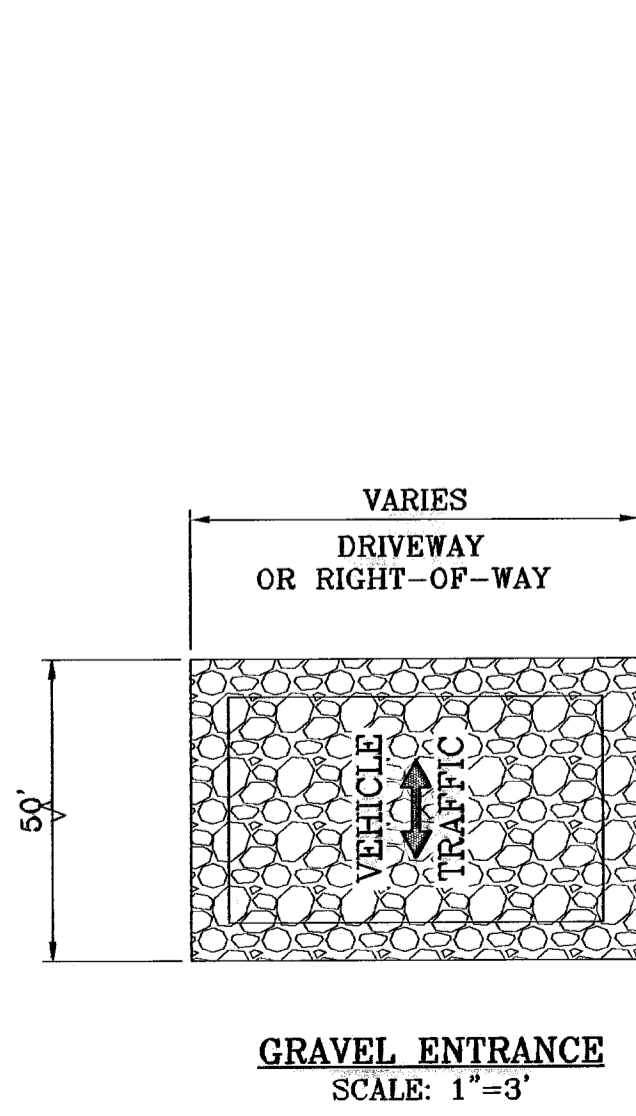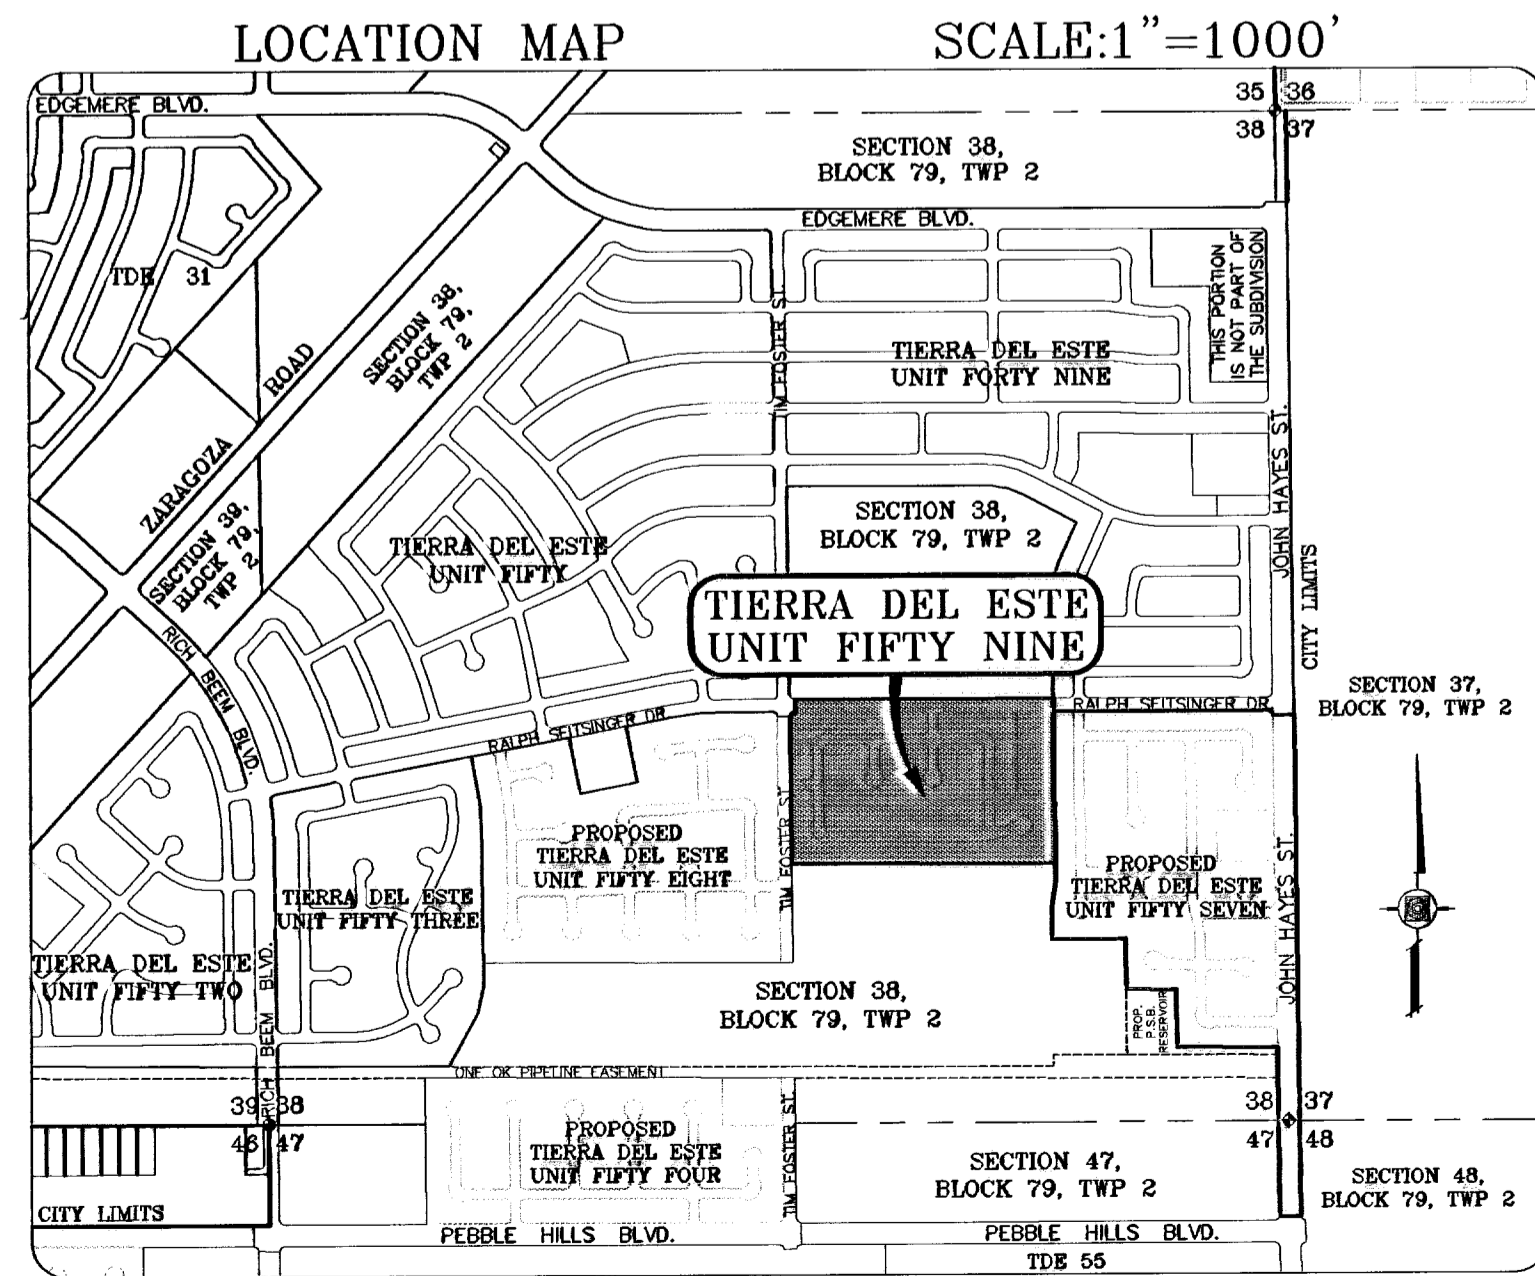

**ENGINEER'S SEAL**

**CONDE INC.**  
ENGINEERING / PLANNING  
SURVEYING / GPS  
1790 LEE TREVINO STE 400  
EL PASO, TEXAS 79936

**PROJECT NAME**  
TIERRA DEL ESTE  
UNIT FIFTY NINE

**SCALE**  
HORIZ: 1"=100'  
VERT: 1"=4'

**DATE:** MAY 2008  
**DESIGN BY:** Y.C.  
**INITIATED BY:** O.M.  
**CHECKED BY:** Y.C.  
**JOB NO.:** 608-25

**REVISIONS**

DATE	REVISIONS	BY
12/1/08	CITY REDLINES AS PER 11/26/08 COMMENTS	E.F.G.
12/19/08	CITY REDLINES AS PER 12/16/08 COMMENTS	E.F.G.
02/27/09	REVISION TO POND	R.R.
06/09/09	LOT REVISIONS	R.R.

**BENCHMARK**  
NGS MARKER: COPPER-CLAD STEEL ROD  
DESIGNATED X 1118 PID "C0141"  
ELEVATION: 3987.12


**SHEET TITLE**  
STORM  
WATER  
POLLUTION  
PREVENTION  
PLAN

**SHT 6 OF 24**



○ DENOTES AS BUILT CONDITION ONLY



SCALE: 1"=30'

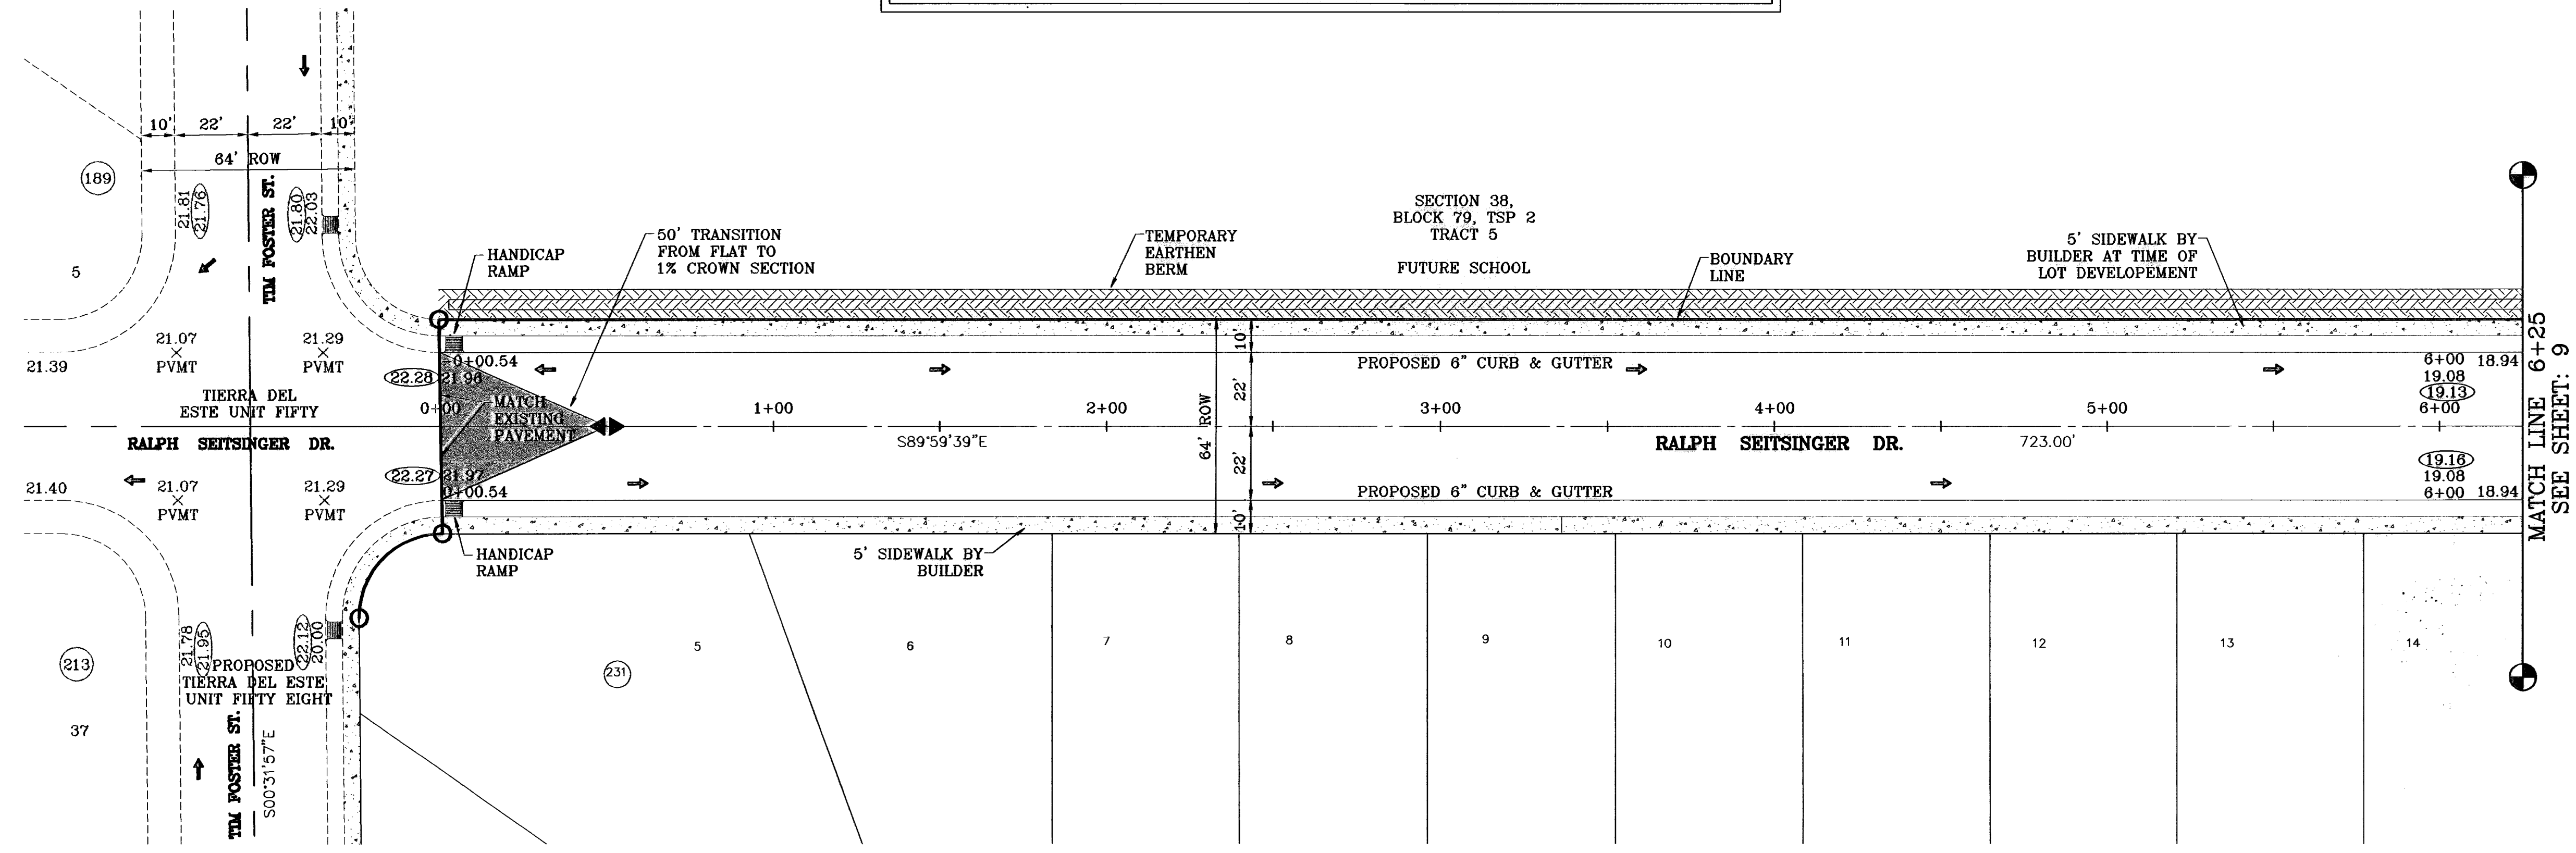


BENCHMARK	
NGS MARKER, COPPER-CLAD STEEL ROD DESIGNATED X 1116" PID "CD0141" ELEVATION : 3887.12	
DATE	REVISIONS
12/05/08	CITY REDLINES AS PER 11/28/08 COMMENTS
06/09/09	LOT REVISIONS
09/25/09	CITY RED LINES
12/30/09	AS BUILT
BY	E.F.C.
	R.R.
	F.R.

**TIERRA DEL ESTE UNIT FIFTY NINE**  
 BEING A PORTION OF SECTION 38, BLOCK 79, TOWNSHIP 2,  
 TEXAS AND PACIFIC RAILROAD COMPANY SURVEYS,  
 CITY OF EL PASO, EL PASO COUNTY, TEXAS,  
 CONTAINING 26.969 ACRES

PROJECT NAME	
TIERRA DEL ESTE UNIT FIFTY NINE	
SCALE	
HORIZ: 1"=30' VERT: 1"=10'	
DATE: MAY 2008	
DESIGN BY: Y.C.	
INITIATED BY: O.M.	
CHECKED BY: Y.C.	
JOB NO.: 608-23	

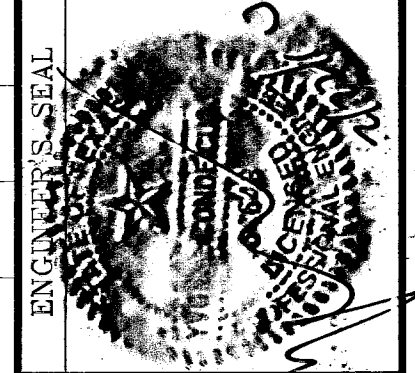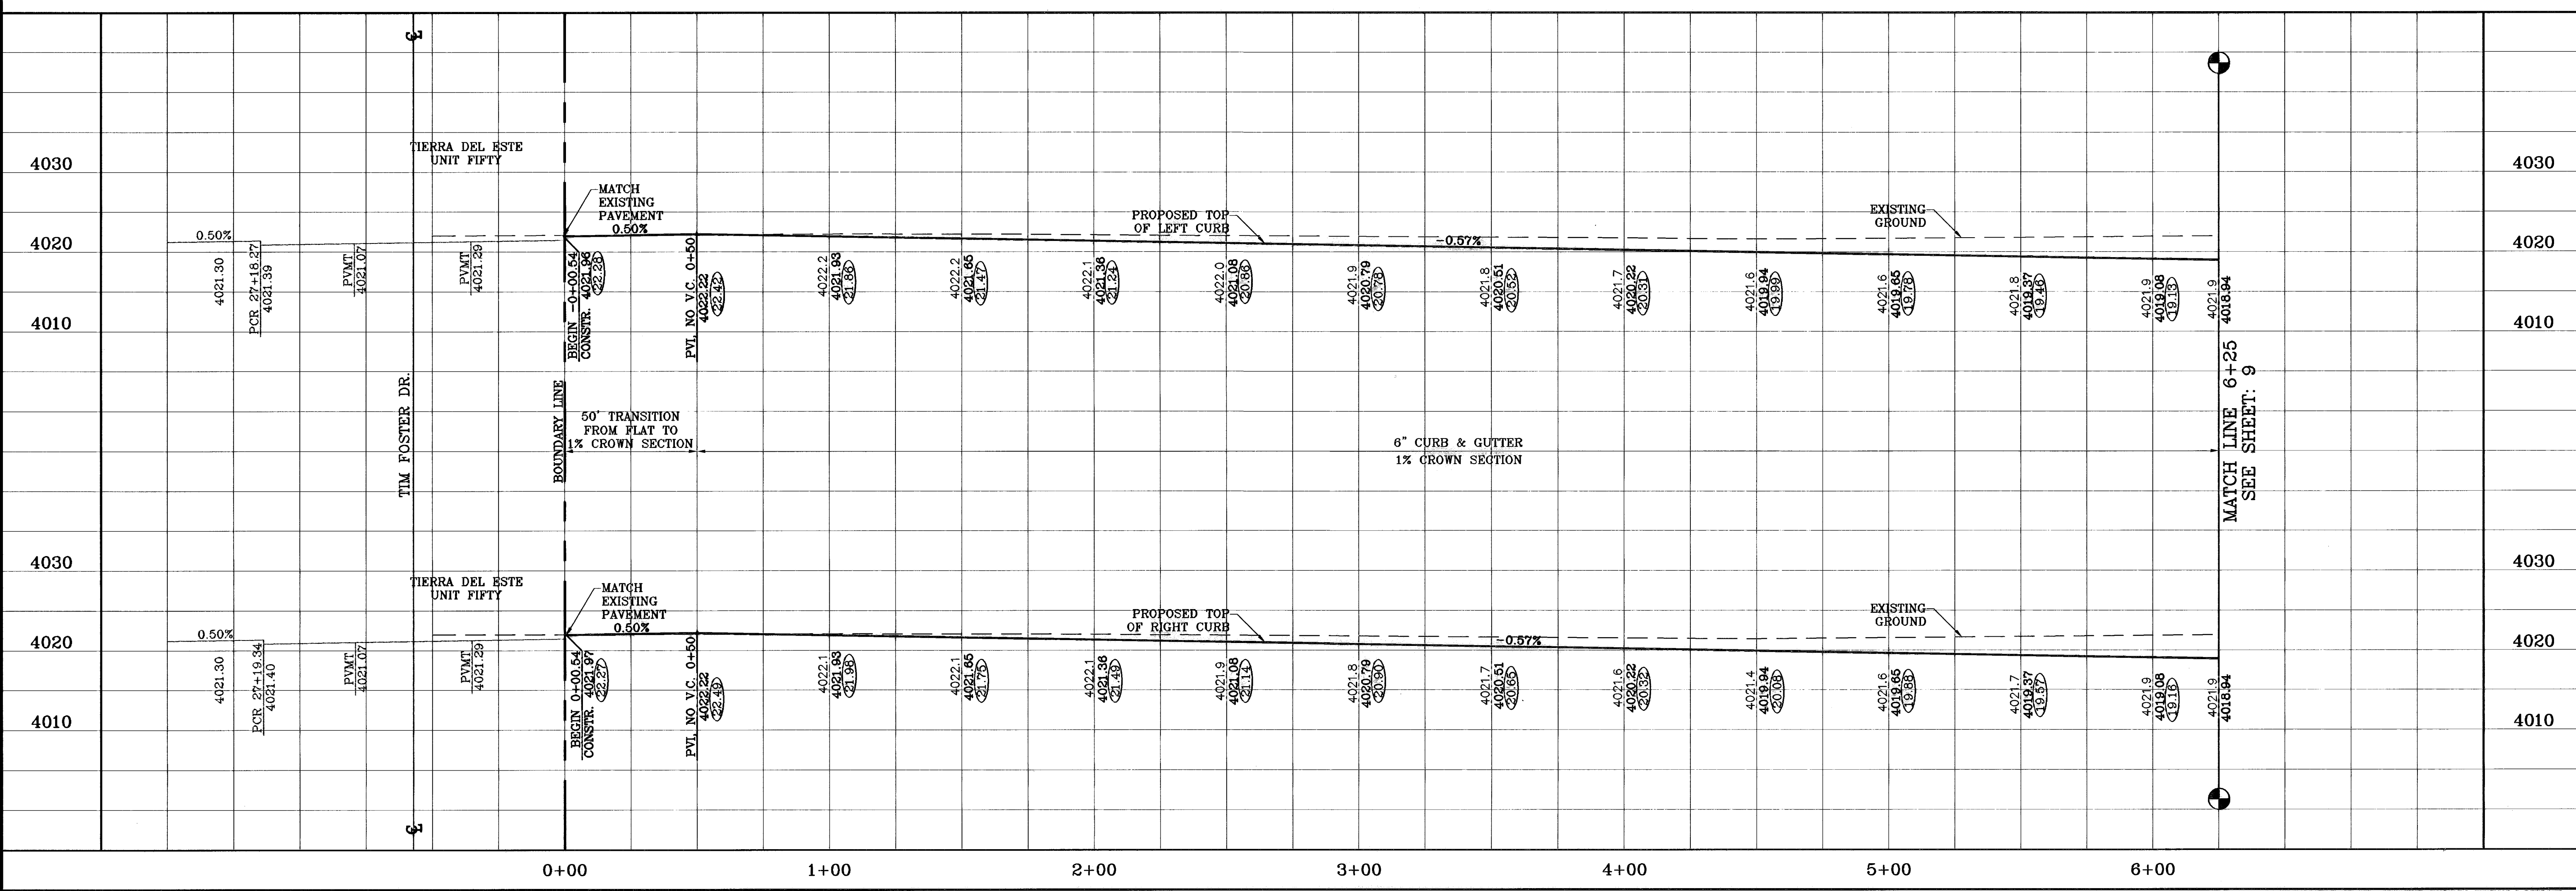

**CONDE INC.**  
 ENGINEERING / PLANNING  
 SURVEYING / GPS  
 1790 LEE TREWING STE 400  
 EL PASO, TEXAS 79936

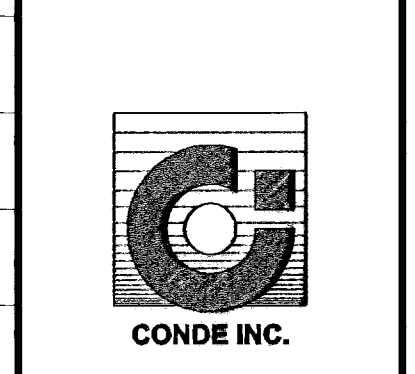

SHEET TITLE  
**STREET PLAN-PROFILE**  
**RALPH SEITSINGER DR.**  
 STA: 0+00  
 TO  
 STA 6+25



○ DENOTES AS BUILT CONDITION ONLY


SECTION 38,  
BLOCK 79, TSP 2  
TRACT 5  
FUTURE SCHOOL

SEE SHEET 6 FOR TEMPORARY  
DESILTING BASIN DETAILS

SEE SHEET 22 FOR  
COMMERCIAL DRIVEWAY DETAILS

SEE SHEET 23 FOR  
WROUGHT IRON GATE DETAILS

SCALE: 1"=30'

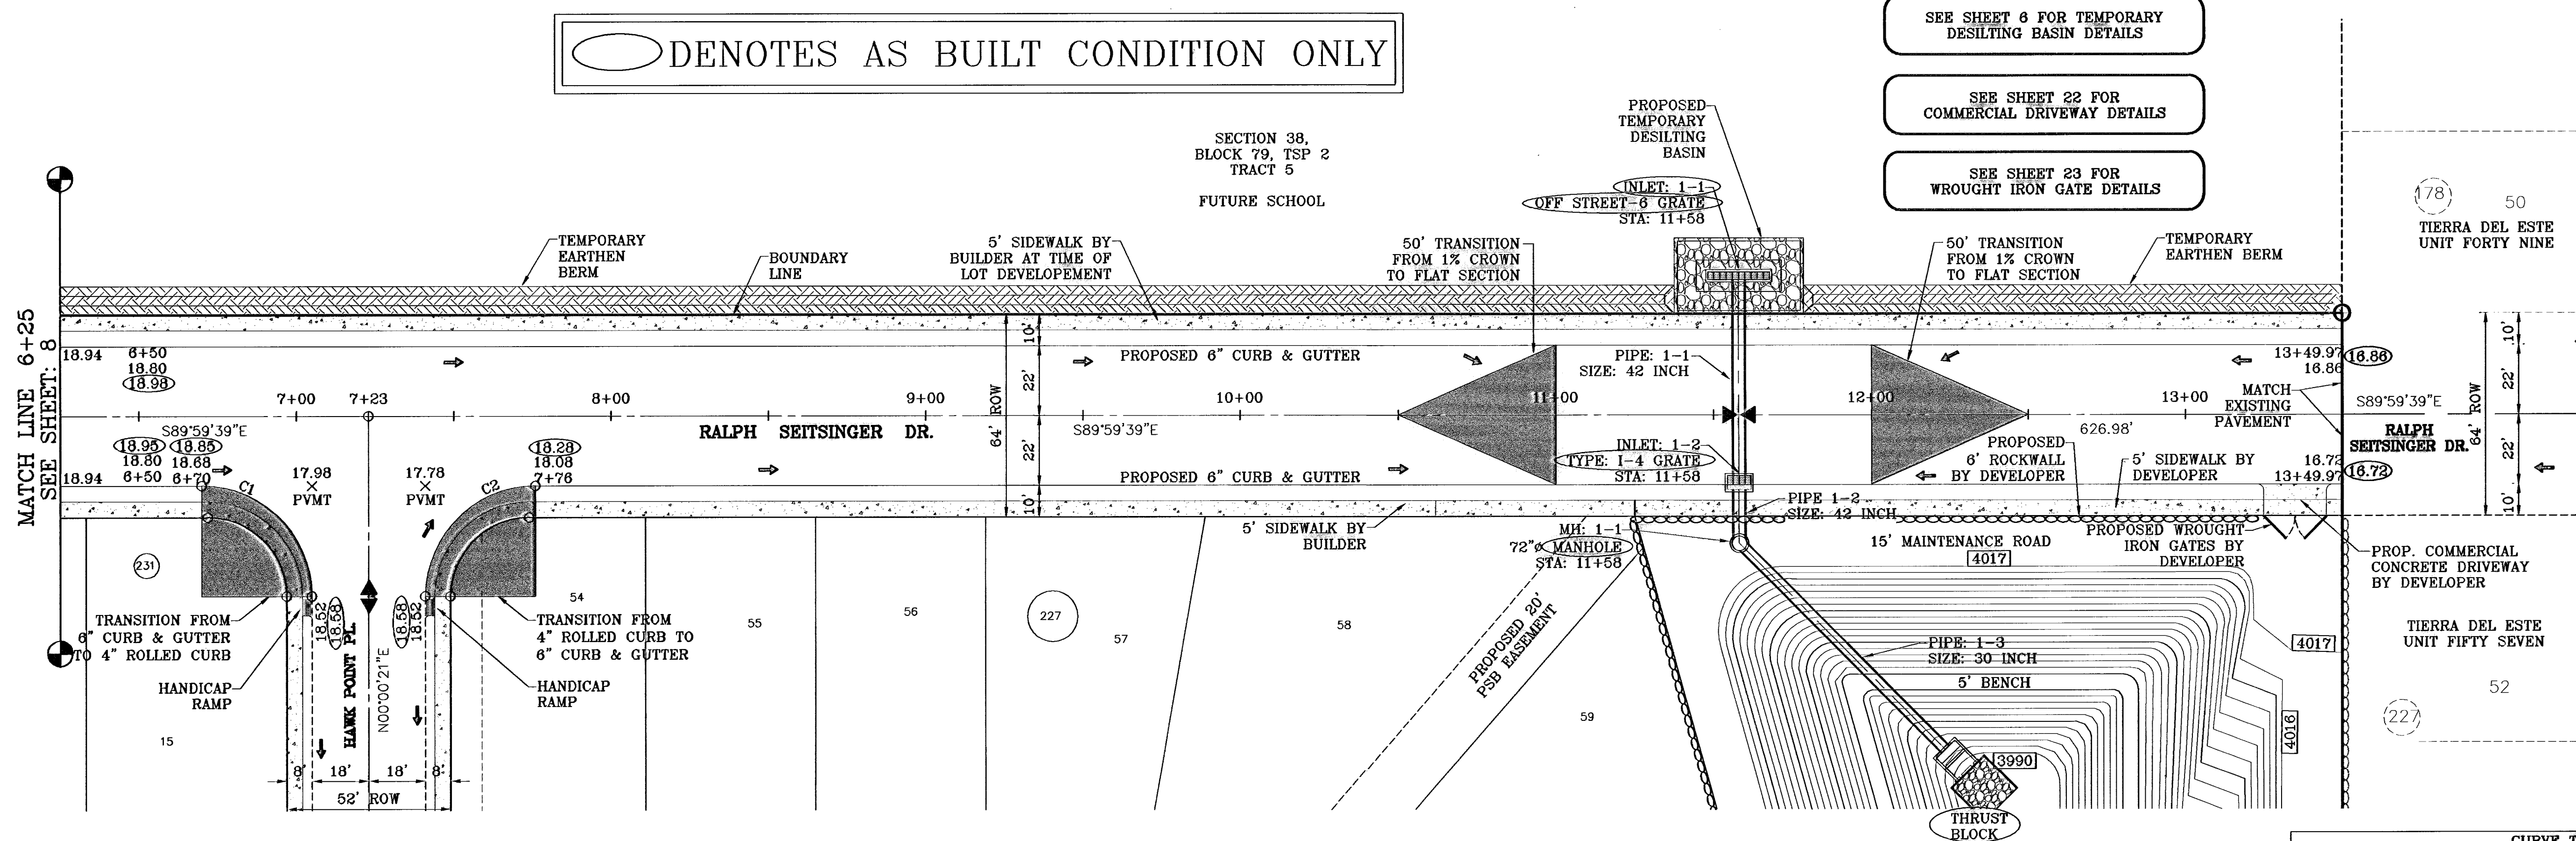

CURVE TABLE						
CURVE	RADIUS	LENGTH	TANGENT	CHORD	BEARING	DELTA
C1	35.00	54.98	35.00	49.50	N44°59'39"W	90°00'00"
C2	35.00	54.98	35.00	49.50	S45°00'21"W	90°00'00"

BENCHMARK  
NCS MARKER: COPPER-CLAD STEEL ROD  
DESIGNATED X 1118' PID "C0141"  
ELEVATION: 3967.12

REVISIONS

DATE	BY	REVISIONS
12/05/08	E.F.G.	CITY REDLINES AS PER 11/28/08 COMMENTS
02/27/09	R.R.	REVISION TO POND & EASEMENT ADDITION
06/09/09	R.R.	LOT REVISIONS
12/30/09	R.R.	AS BUILT

PROJECT NAME  
**TERRA DEL ESTE  
UNIT FIFTY NINE**

BEING A PORTION OF SECTION 38, BLOCK 79, TOWNSHIP 2,  
TEXAS AND PACIFIC RAILROAD COMPANY SURVEYS,  
CITY OF EL PASO, EL PASO COUNTY, TEXAS,  
CONTAINING 26.969 ACRES

SCALE  
HORIZ: 1"=30'  
VERT: 1"=10'


DATE: MAY 2008

DESIGN BY: Y.C.


INITIATED BY: O.M.

CHECKED BY: Y.C.

JOB NO.: 608-23

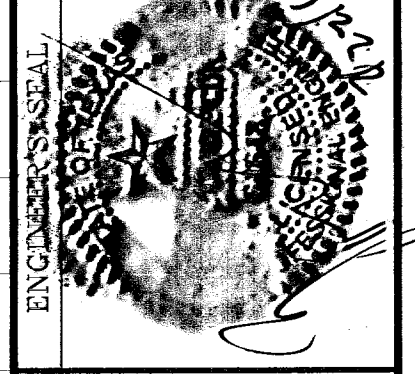


**CONDE INC.**  
ENGINEERING / PLANNING  
SURVEYING / GPS  
1790 LEE TRAVINO SITE 400  
EL PASO, TEXAS 79966


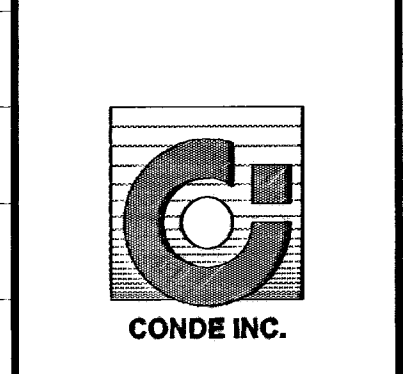


SHEET TITLE  
**STREET  
PLAN-PROFILE**

**RALPH  
SEITSINGER DR.**  
STA: 6+25  
TO  
STA 13+49.97

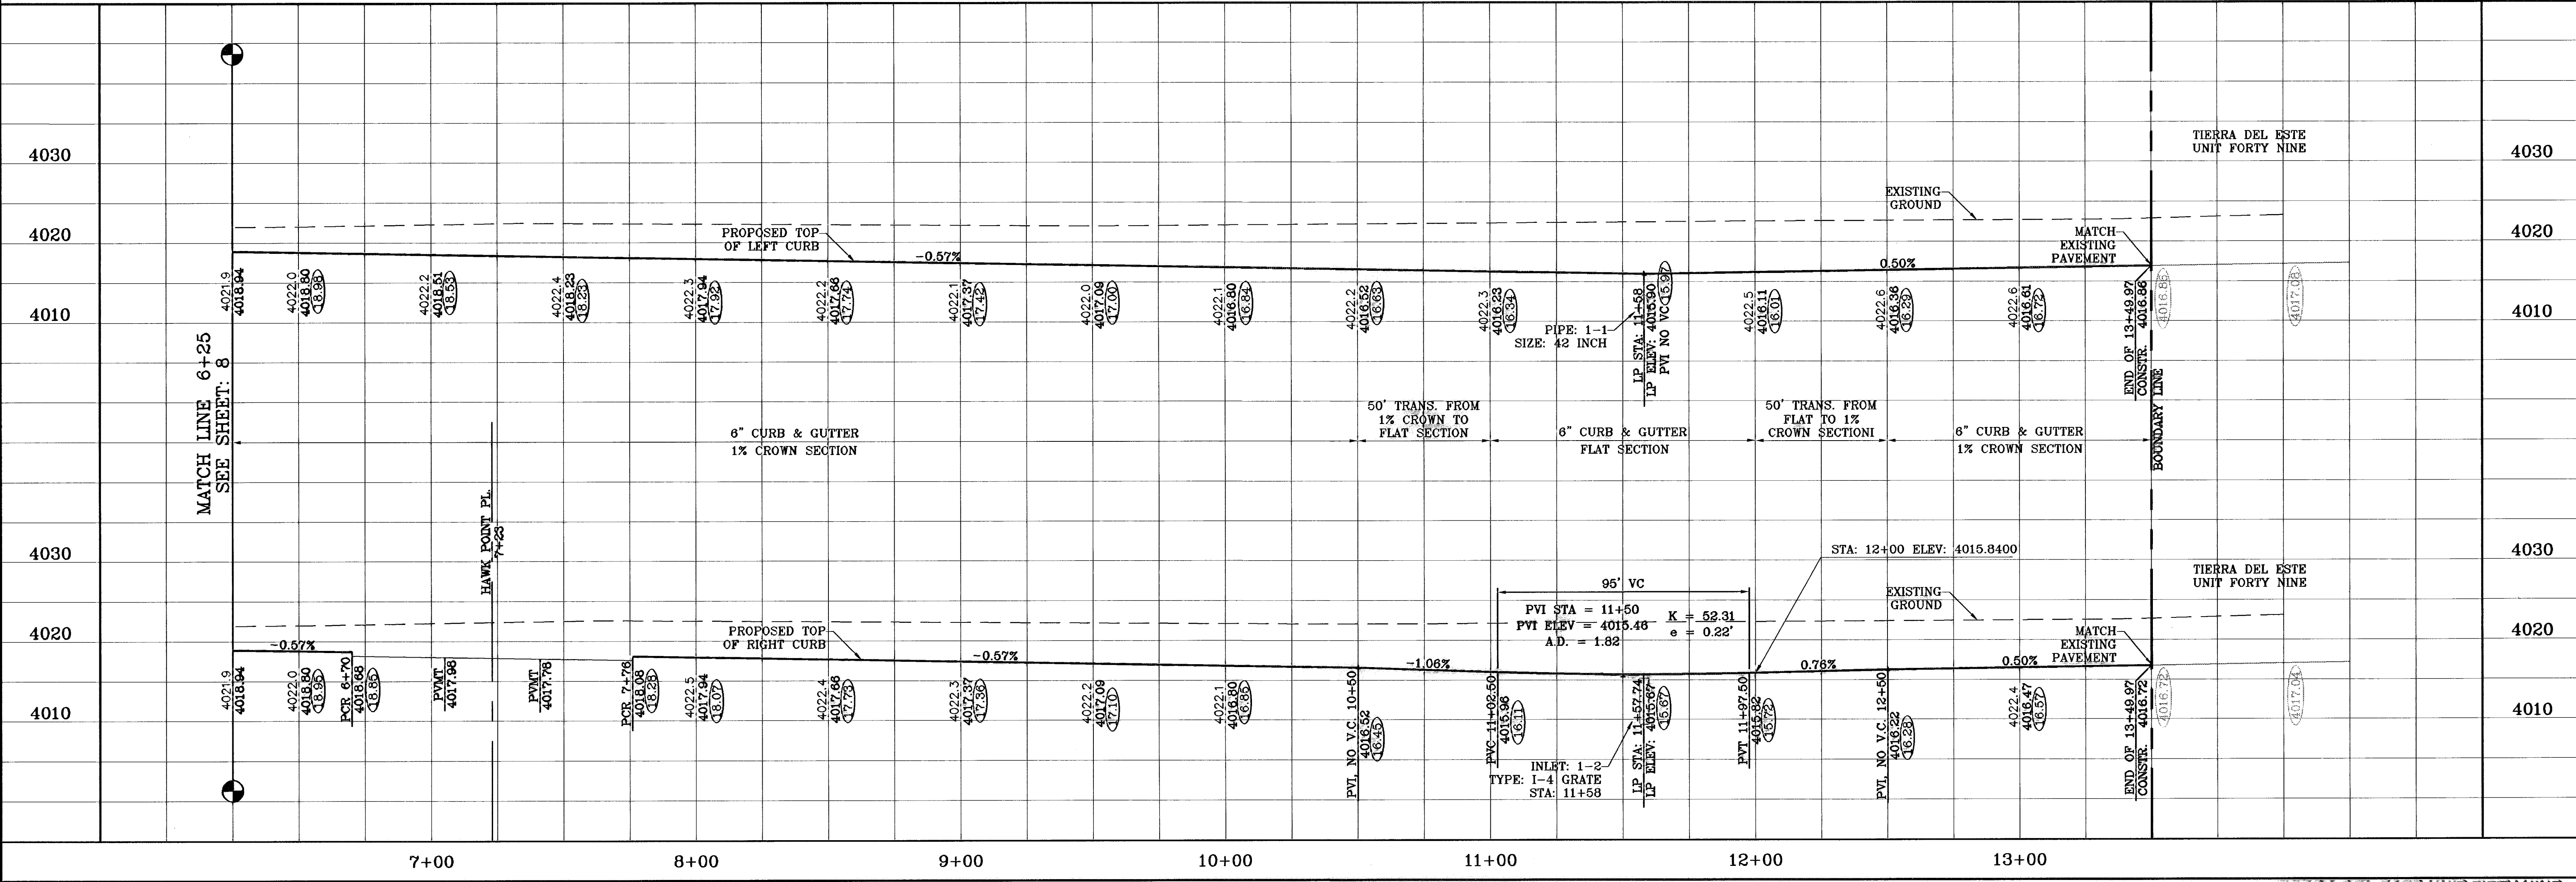

○ DENOTES AS BUILT CONDITION ONLY

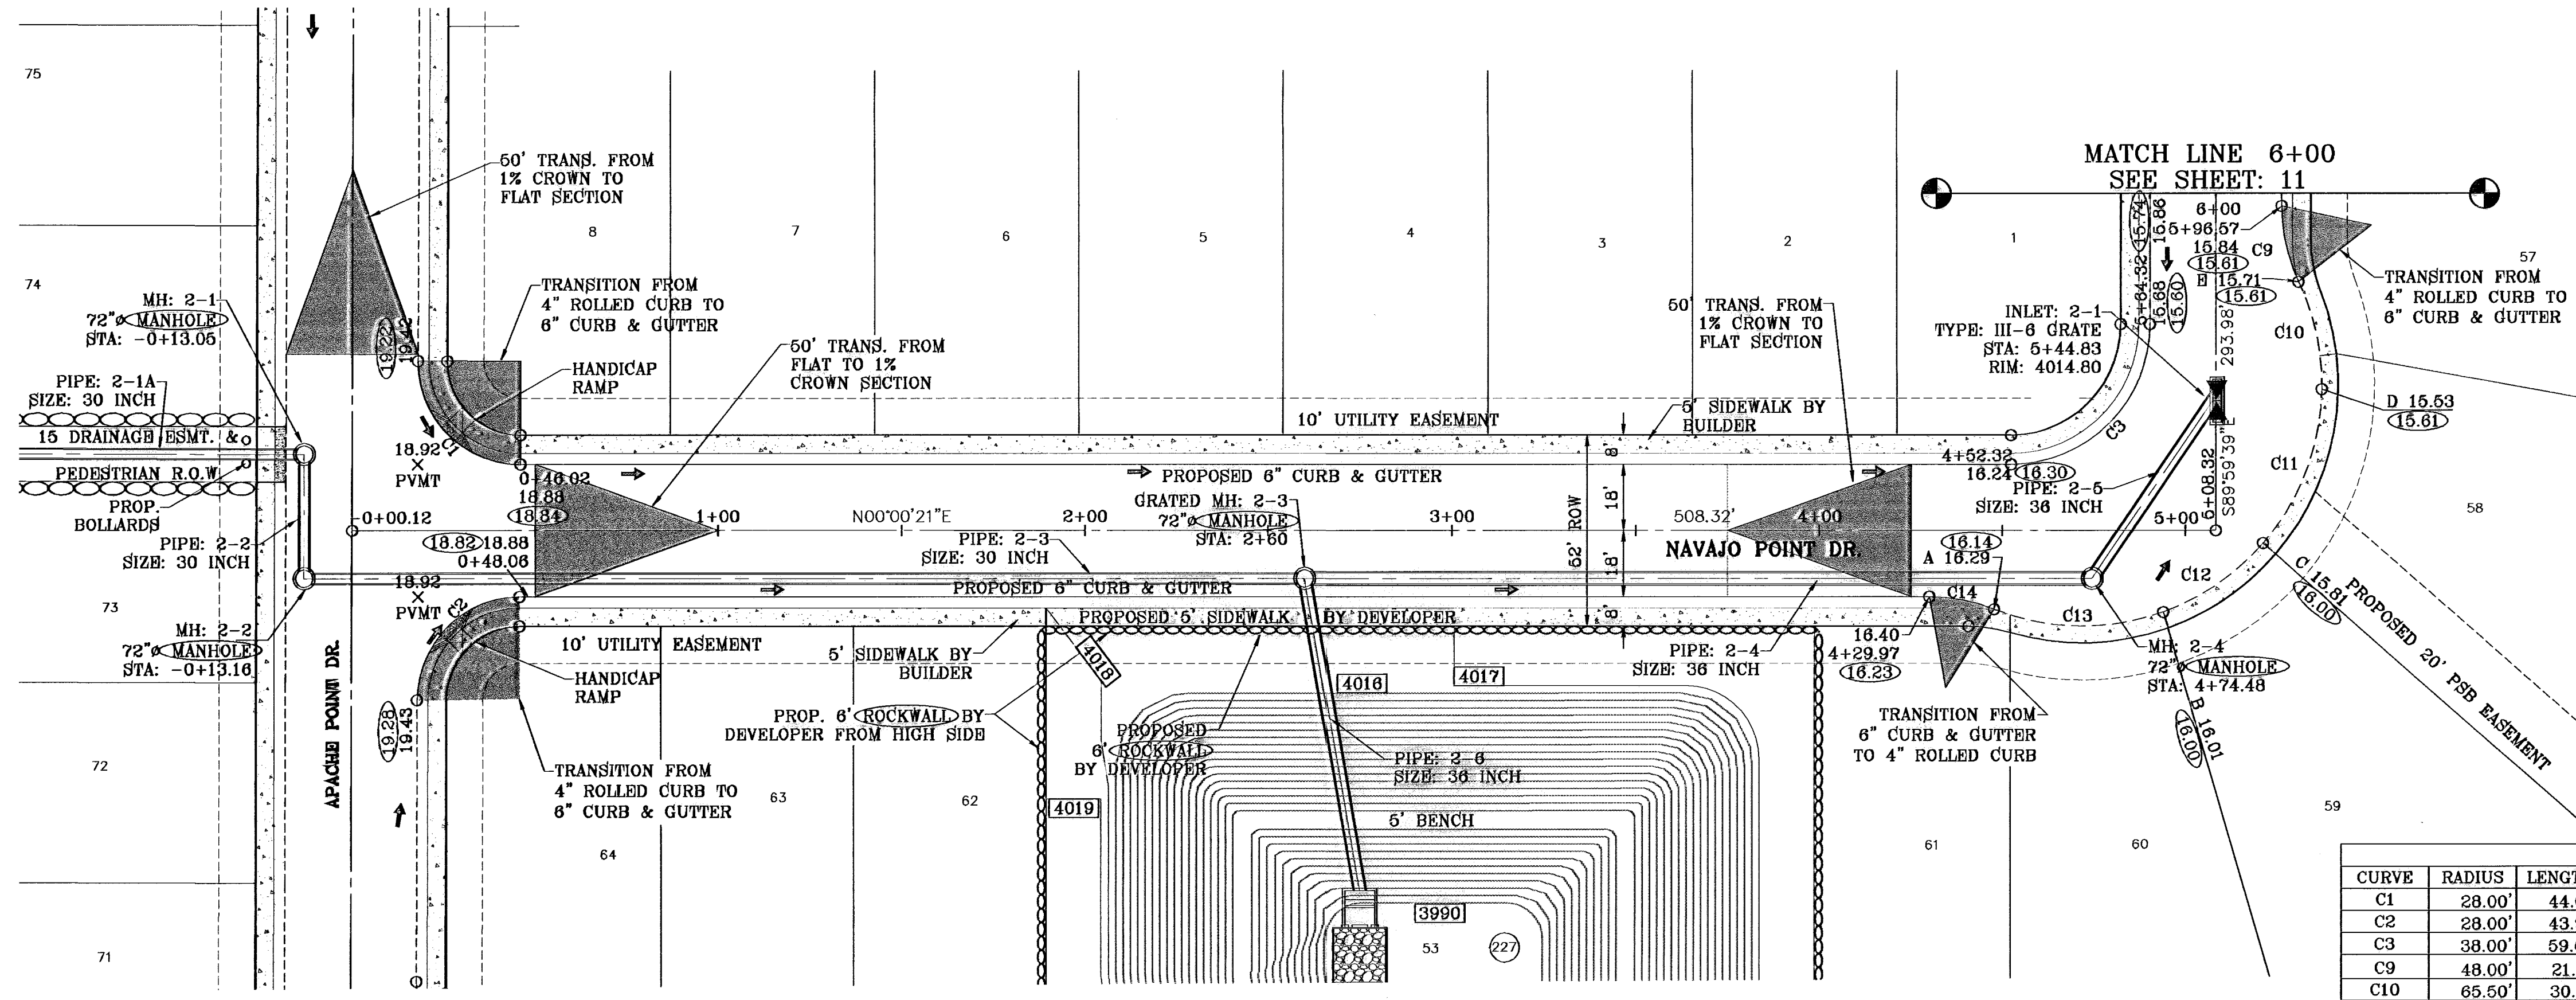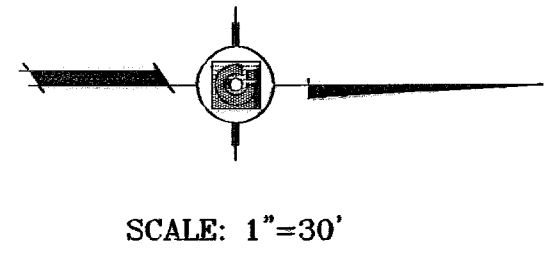


CURVE	RADIUS	LENGTH	TANGENT	CHORD	BEARING	DELTA
C1	28.00'	44.07'	28.09'	39.66'	N45°05'34"E	90°10'28"
C2	28.00'	43.90'	27.91'	39.54'	S44°54'28"E	89°49'32"
C3	38.00'	59.69'	38.00'	53.74'	N44°59'39"W	90°00'00"
C9	48.00'	21.31'	10.83'	21.13'	N77°17'20"E	25°28'01"
C10	65.50'	30.15'	15.35'	29.89'	S77°45'38"W	28°22'32"
C11	65.50'	45.80'	23.88'	44.87'	N69°01'17"W	40°03'42"
C12	65.50'	33.39'	17.07'	33.03'	N34°23'08"W	29°12'40"
C13	65.50'	47.36'	24.77'	46.33'	N00°58'00"E	41°25'33"
C14	48.00'	18.13'	9.17'	18.02'	S10°49'34"W	21°38'28"

NOTE:  
CENTERLINE STATION AT INTERSECTION OF  
APACHE POINT DR. AND NAVAJO POINT DR.  
BEGINS AT STATION -0+00.12

SEE SHEET 19 FOR GRATED  
MANHOLE COVER DETAILS

SEE SHEET 20 FOR  
BOLLARD DETAILS

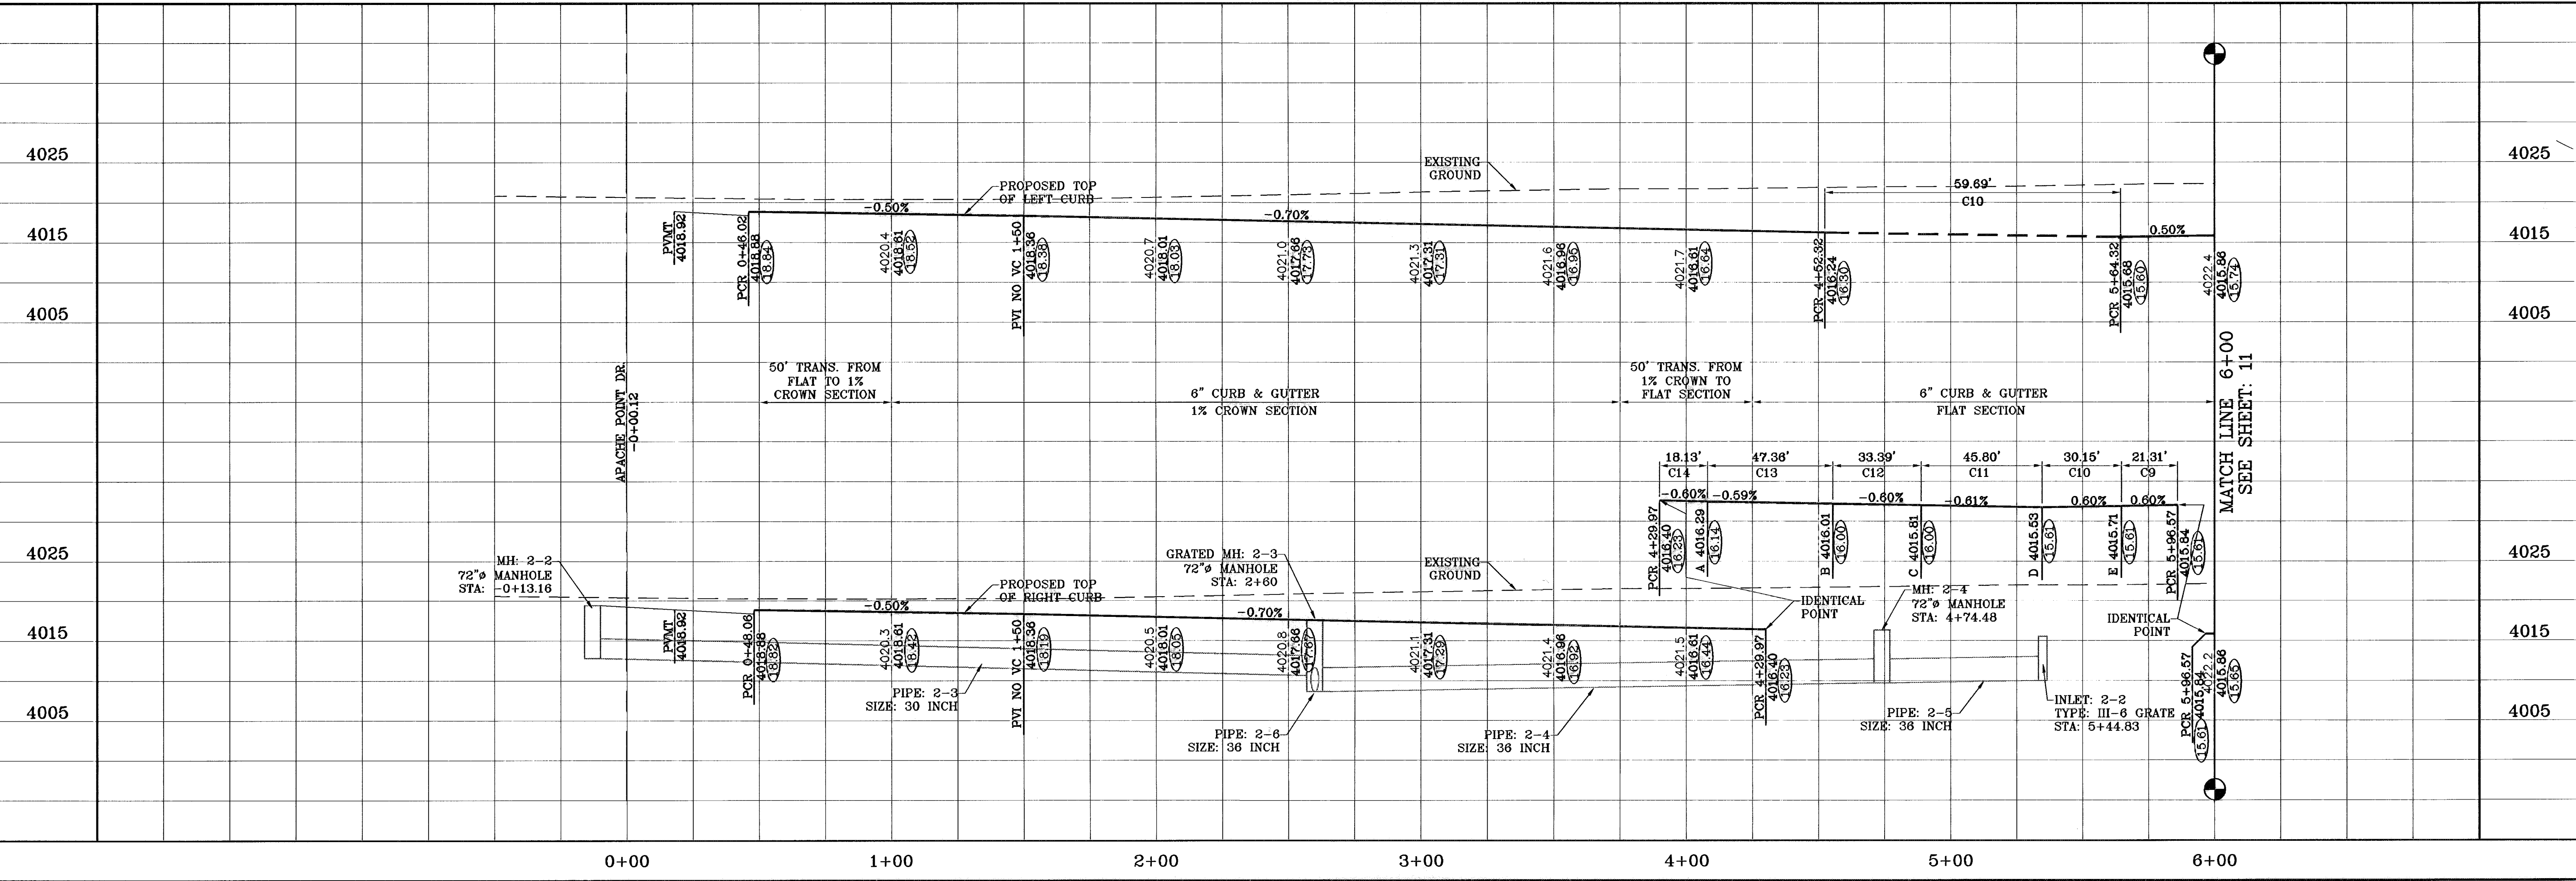

12-30-09	AS BUILT	BENCHMARK	NGS MARKER: COPPER-CLAD STEEL ROD DESIGNATED X 1119 P.D. C0141 ELEVATION: 3967.12
09-28-09	CITY RED LINES		

PROJECT NAME  
**TERRA DEL ESTE  
UNIT FIFTY NINE**

DATE  
12/05/08  
12/16/08  
02-27-09  
06-09-09

BY  
E.F.G.  
COMMENTS  
CITY REDLINES AS PER 11/26/08  
CITY REDLINES AS PER 12/16/08  
REVISION TO POND  
LOT REVISIONS

BEING A PORTION OF SECTION 38, BLOCK 79, TOWNSHIP 2,  
TEXAS AND PACIFIC RAILROAD COMPANY SURVEYS,  
CITY OF EL PASO, EL PASO COUNTY, TEXAS,  
CONTAINING 26.969 ACRES

SCALE  
HORIZ: 1"=30'  
VERT: 1"=10'



DATE: MAY 2008  
DESIGN BY: Y.C.  
INITIATED BY: O.M.  
CHECKED BY: Y.C.  
JOB NO.: 608-23

**CONDE INC.**  
ENGINEERING / PLANNING  
SURVEYING / GPS  
1700 LEE TREVINO STE. 400  
EL PASO, TEXAS 79936


SHEET TITLE  
**STREET  
PLAN-PROFILE**

**NAVAJO  
POINT DR.**  
STA: 0+00  
TO  
STA: 6+00

○ DENOTES AS BUILT CONDITION ONLY

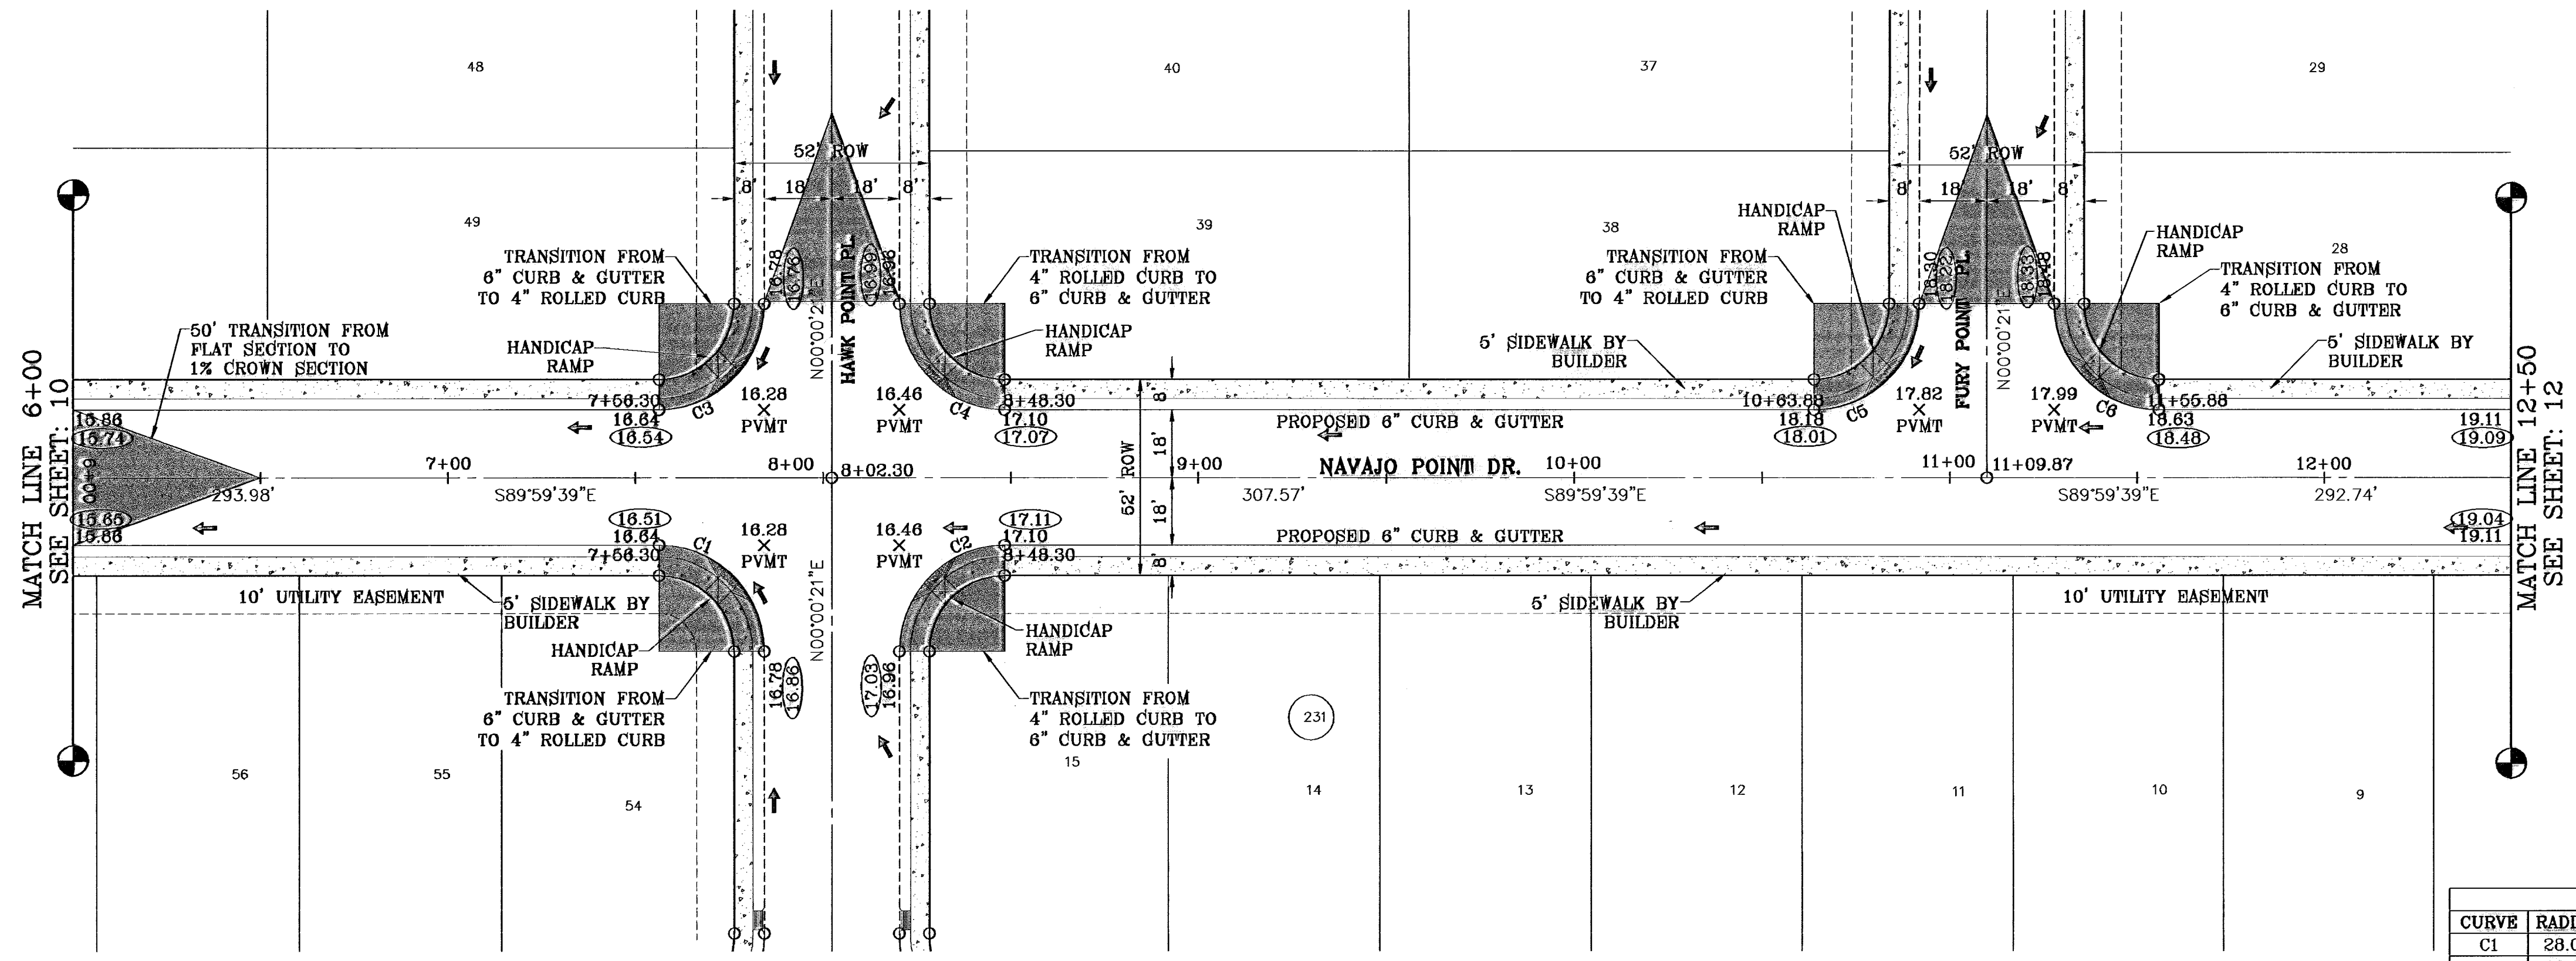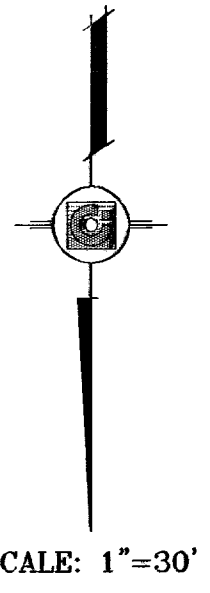

CURVE TABLE						
CURVE	RADIUS	LENGTH	TANGENT	CHORD	BEARING	DELTA
C1	28.00'	43.98'	28.00'	39.60'	S44°59'39"E	90°00'00"
C2	28.00'	43.98'	28.00'	39.60'	N45°00'21"E	90°00'00"
C3	28.00'	43.98'	28.00'	39.60'	S45°00'21"W	90°00'00"
C4	28.00'	43.98'	28.00'	39.60'	N44°59'39"W	90°00'00"
C5	28.00'	43.98'	28.00'	39.60'	N44°59'39"W	90°00'00"
C6	28.00'	43.98'	28.00'	39.60'	S45°00'21"W	90°00'00"

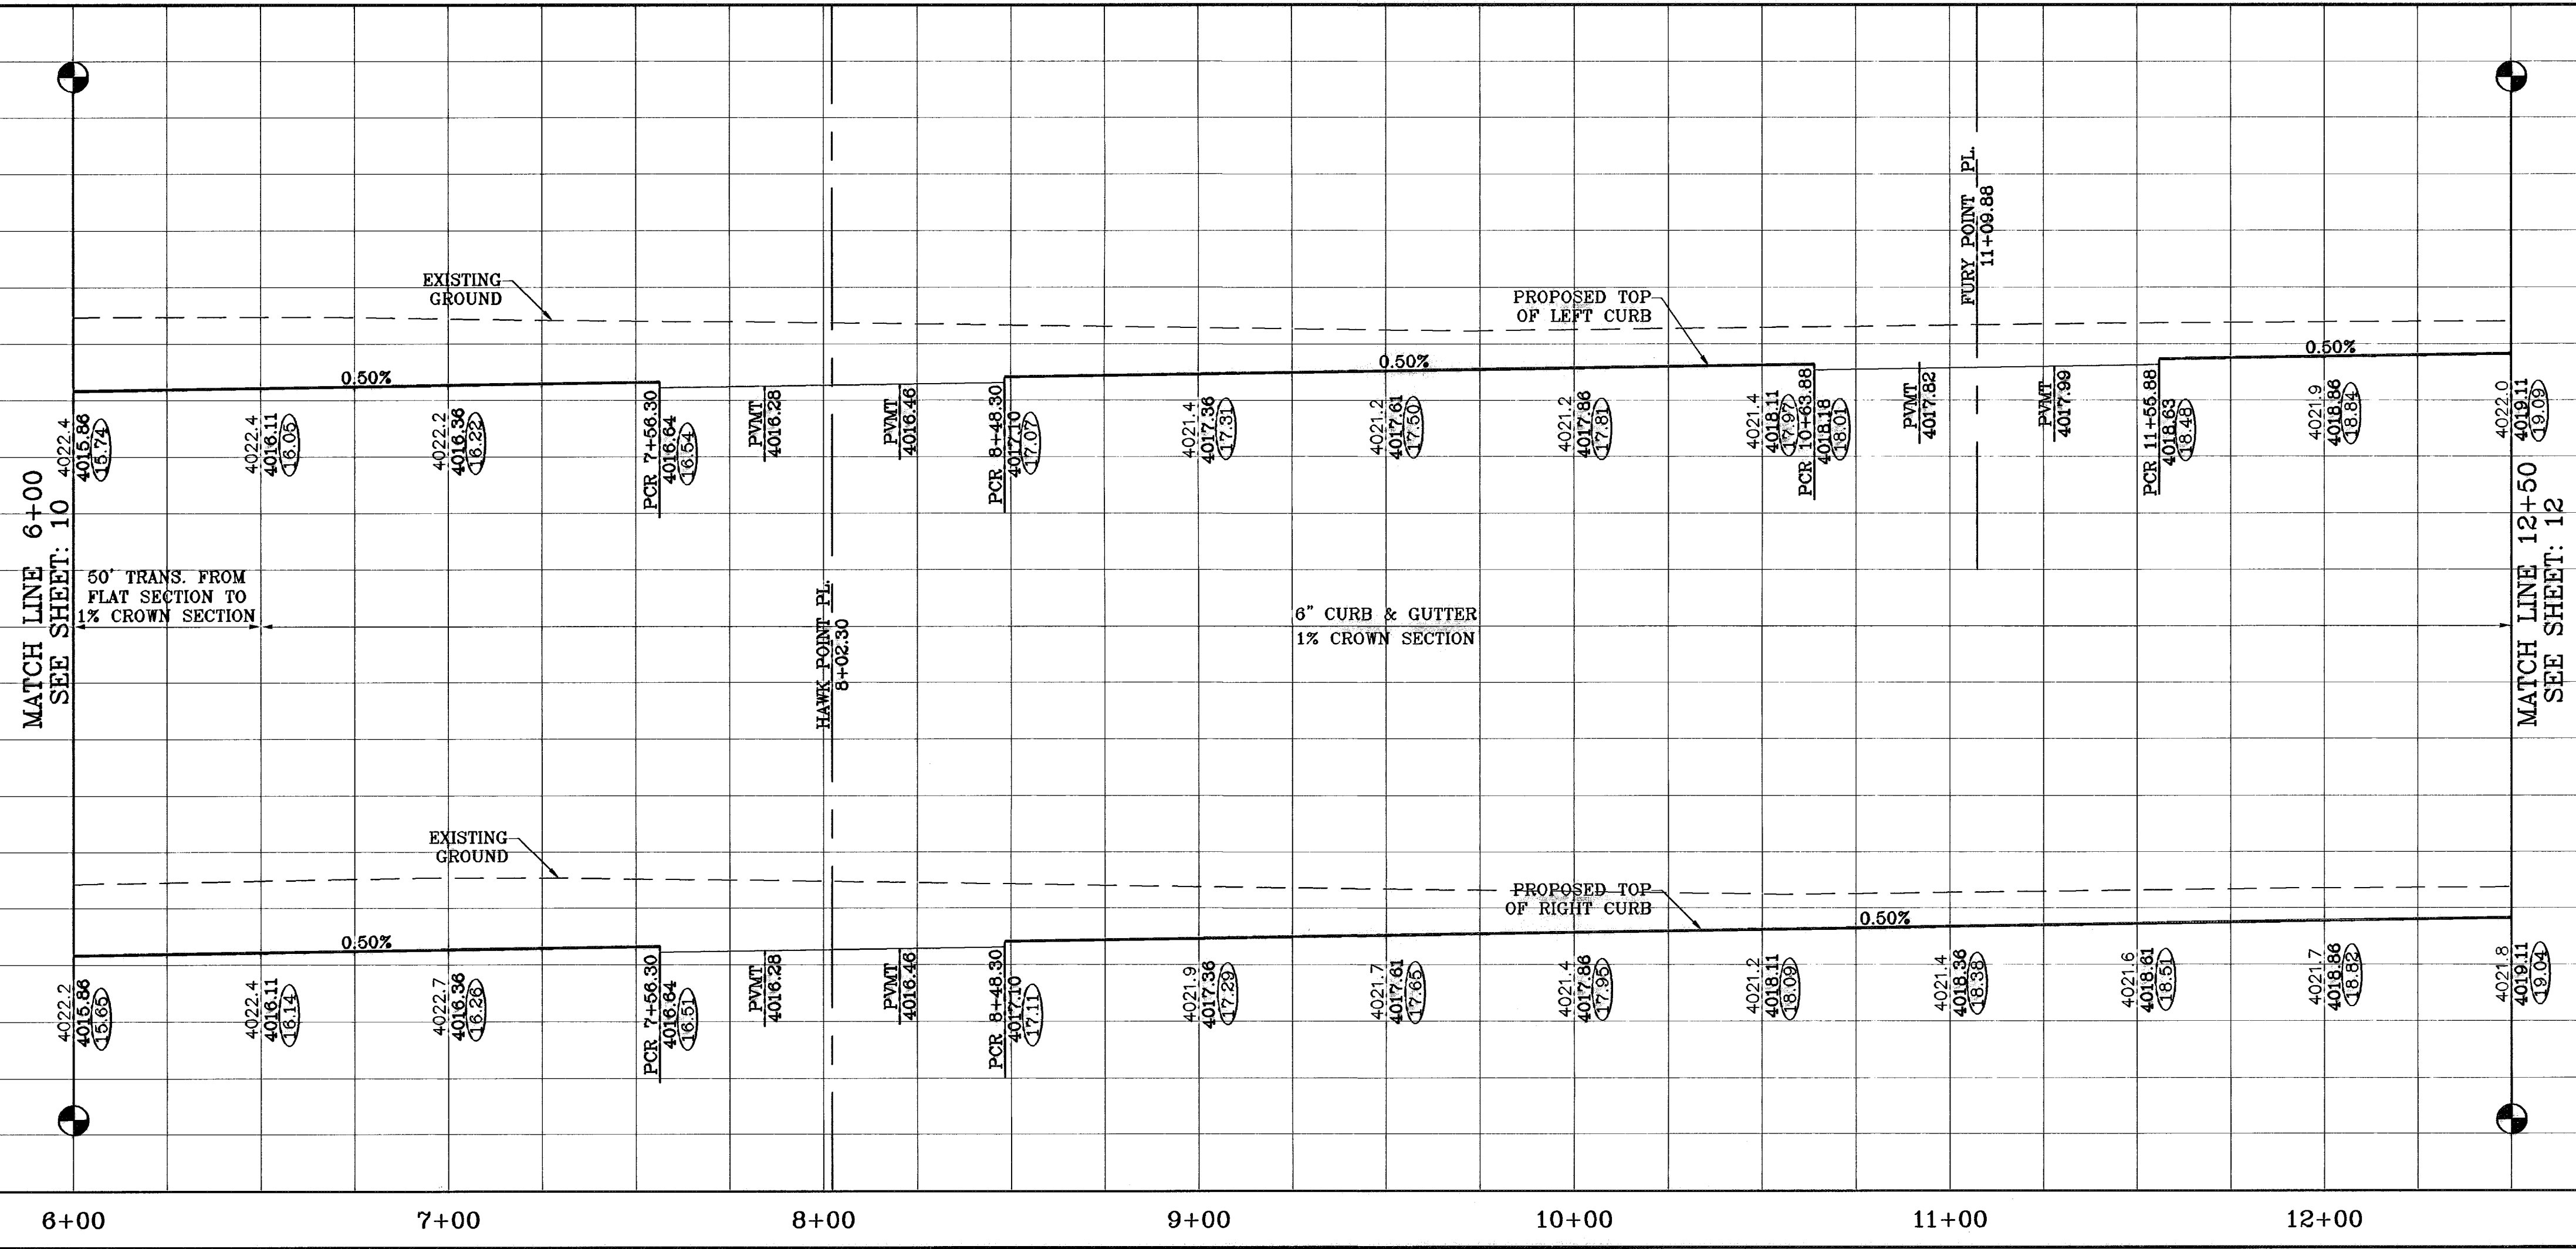

12-30-09	AS BUILT	BENCHMARK	NGS MARKER, COPPER-CLAD STEEL ROD DESIGNATED "X-1118" PID "CE0141" ELEVATION: 3987.12
DATE	REVISIONS	BY	E.F.G.
12/05/08	CITY REDLINES AS PER 11/26/08 COMMENTS		
12/16/08	CITY REDLINES AS PER 12/16/08 COMMENTS		
06/09/09	LOT REVISIONS		
06/28/09	CITY RED LINES		

PROJECT NAME  
**TERRA DEL ESTE  
UNIT FIFTY NINE**


BEING A PORTION OF SECTION 38, BLOCK 79, TOWNSHIP 2,  
TEXAS AND PACIFIC RAILROAD COMPANY SURVEYS,  
CITY OF CONTAINING 26.960 ACRES

SCALE  
HORIZ: 1"=30'  
VERT: 1"=10'

DATE: MAY 2008  
DESIGN BY: Y.C.  
INITIATED BY: O.M.  
CHECKED BY: Y.C.  
JOB NO.: 608-23

ENGINEER'S SEAL



**CONDE INC.**  
ENGINEERING / PLANNING  
SURVEYING / GPS  
1790 LEE TREVINO STE 400  
EL PASO, TEXAS 79936

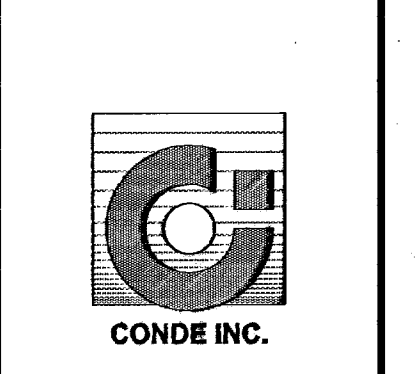

SHEET TITLE  
**STREET  
PLAN-PROFILE**

**NAVAJO  
POINT DR.**  
STA: 6+00  
TO  
STA 12+50

○ DENOTES AS BUILT CONDITION ONLY

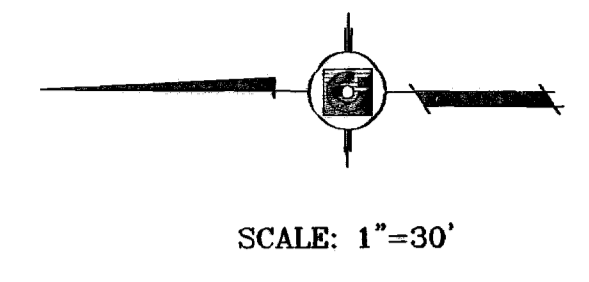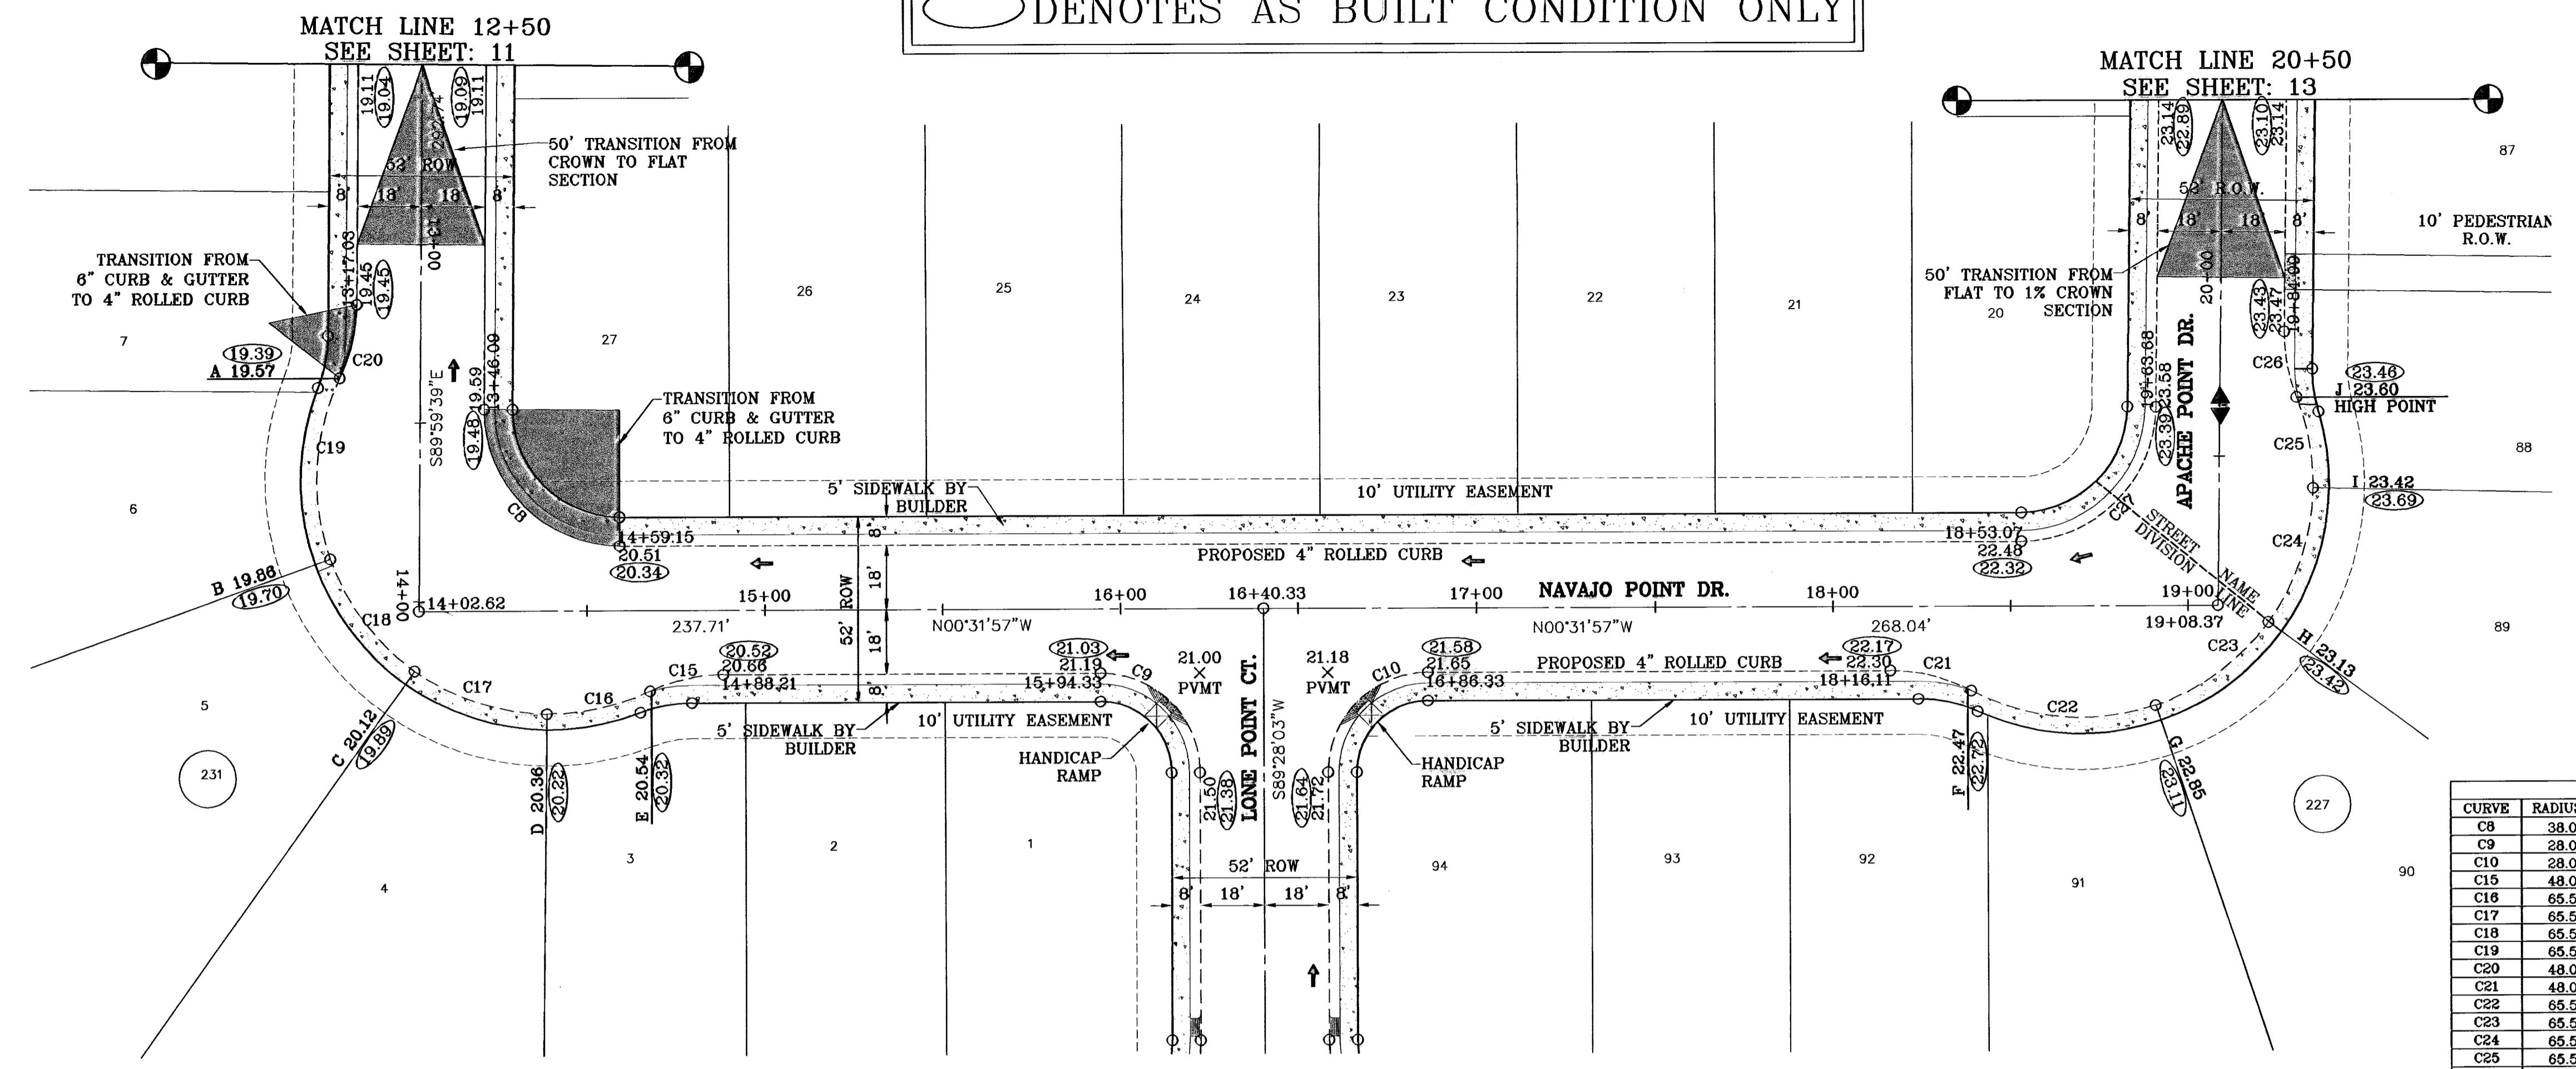


CURVE	RADIUS	LENGTH	TANGENT	CHORD	BEARING	DELTA
C6	38.00'	60.05'	38.34'	53.99'	S44°44'12\"	90°32'18\"
C9	28.00'	43.98'	28.00'	39.60'	N44°28'03\"	90°00'00\"
C10	28.00'	43.98'	28.00'	39.60'	N45°31'57\"	90°00'00\"
C15	48.00'	21.31'	10.83'	21.13'	N13°14'58\"	25°28'01\"
C16	65.50'	29.95'	15.24'	28.69'	S12°52'05\"	28°11'47\"
C17	65.50'	39.80'	20.53'	39.19'	S17°38'08\"	34°48'40\"
C18	65.50'	39.80'	20.53'	39.19'	S52°28'48\"	34°48'40\"
C19	65.50'	52.11'	27.53'	50.75'	N87°21'15\"	45°35'14\"
C20	48.00'	21.31'	10.83'	21.13'	S77°18'39\"	25°28'01\"
C21	48.00'	23.85'	12.07'	23.41'	N13°34'54\"	28°13'47\"
C22	65.50'	53.62'	28.42'	52.14'	S04°14'38\"	46°54'24\"
C23	65.50'	40.04'	20.67'	39.42'	S38°43'15\"	35°01'21\"
C24	65.50'	40.04'	20.67'	39.42'	S71°44'38\"	35°01'21\"
C25	65.50'	28.18'	13.25'	25.98'	N79°18'19\"	22°52'50\"
C26	48.00'	18.69'	9.47'	18.58'	S79°01'21\"	22°18'54\"
C27	38.00'	59.22'	37.53'	53.40'	S45°10'35\"	89°17'14\"

PROJECT NAME: TIERRA DEL ESTE UNIT FIFTY NINE

DATE: 12/05/08  
 REVISIONS: CITY REDLINES AS PER 11/26/08 COMMENTS E.F.G.  
 04/09/09 CHANGE DUE TO REVISED PLAN R.R.  
 06/09/09 LOT REVISIONS R.R.  
 12/30/09 AS BUILT F.R.

BENCHMARK: NGS MARKER: COPPER-CLAD STEEL ROD DESIGNATED X 1118 P.D. "C0141" ELEVATION: 3987.12

BEING A PORTION OF SECTION 38, BLOCK 79, TOWNSHIP 2, TEXAS AND PACIFIC RAILROAD COMPANY SURVEYS, CITY OF EL PASO, EL PASO COUNTY, TEXAS, CONTAINING 26.968 ACRES

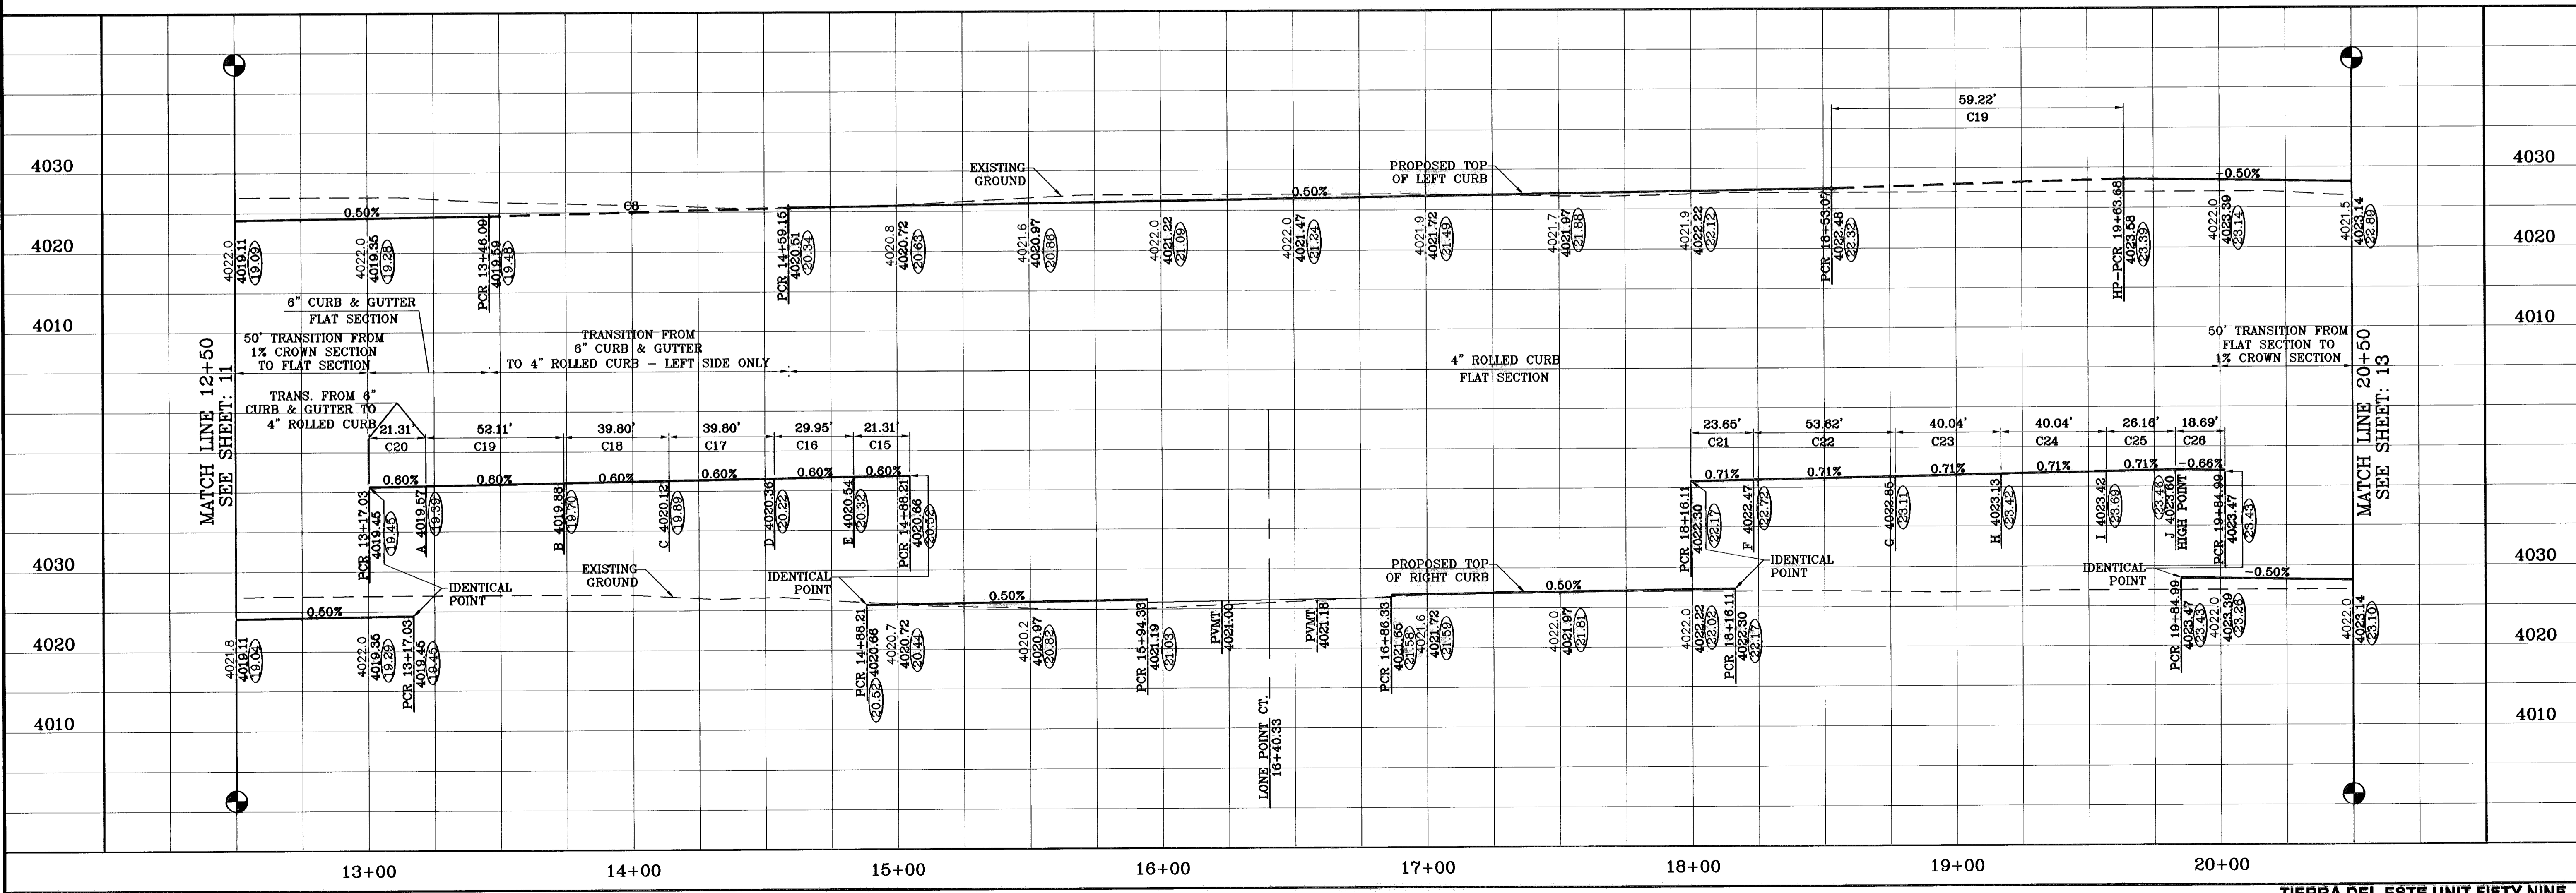

SCALE: HORIZ: 1"=30', VERT: 1"=10'

DATE: MAY 2008  
 DESIGN BY: Y.C.  
 INITIATED BY: O.M.  
 CHECKED BY: Y.C.  
 JOB NO.: 608-23

ENGINEER'S SEAL

CONDE INC.  
 ENGINEERING / PLANNING  
 SURVEYING / GPS  
 1700 LEE TREVINO STE 400  
 EL PASO, TEXAS 79936



SHEET TITLE: STREET PLAN-PROFILE

NAVAJO POINT DR.  
 STA: 12+50 TO STA 20+50

SHT 12 OF 24

○ DENOTES AS BUILT CONDITION ONLY

SCALE: 1"=30'

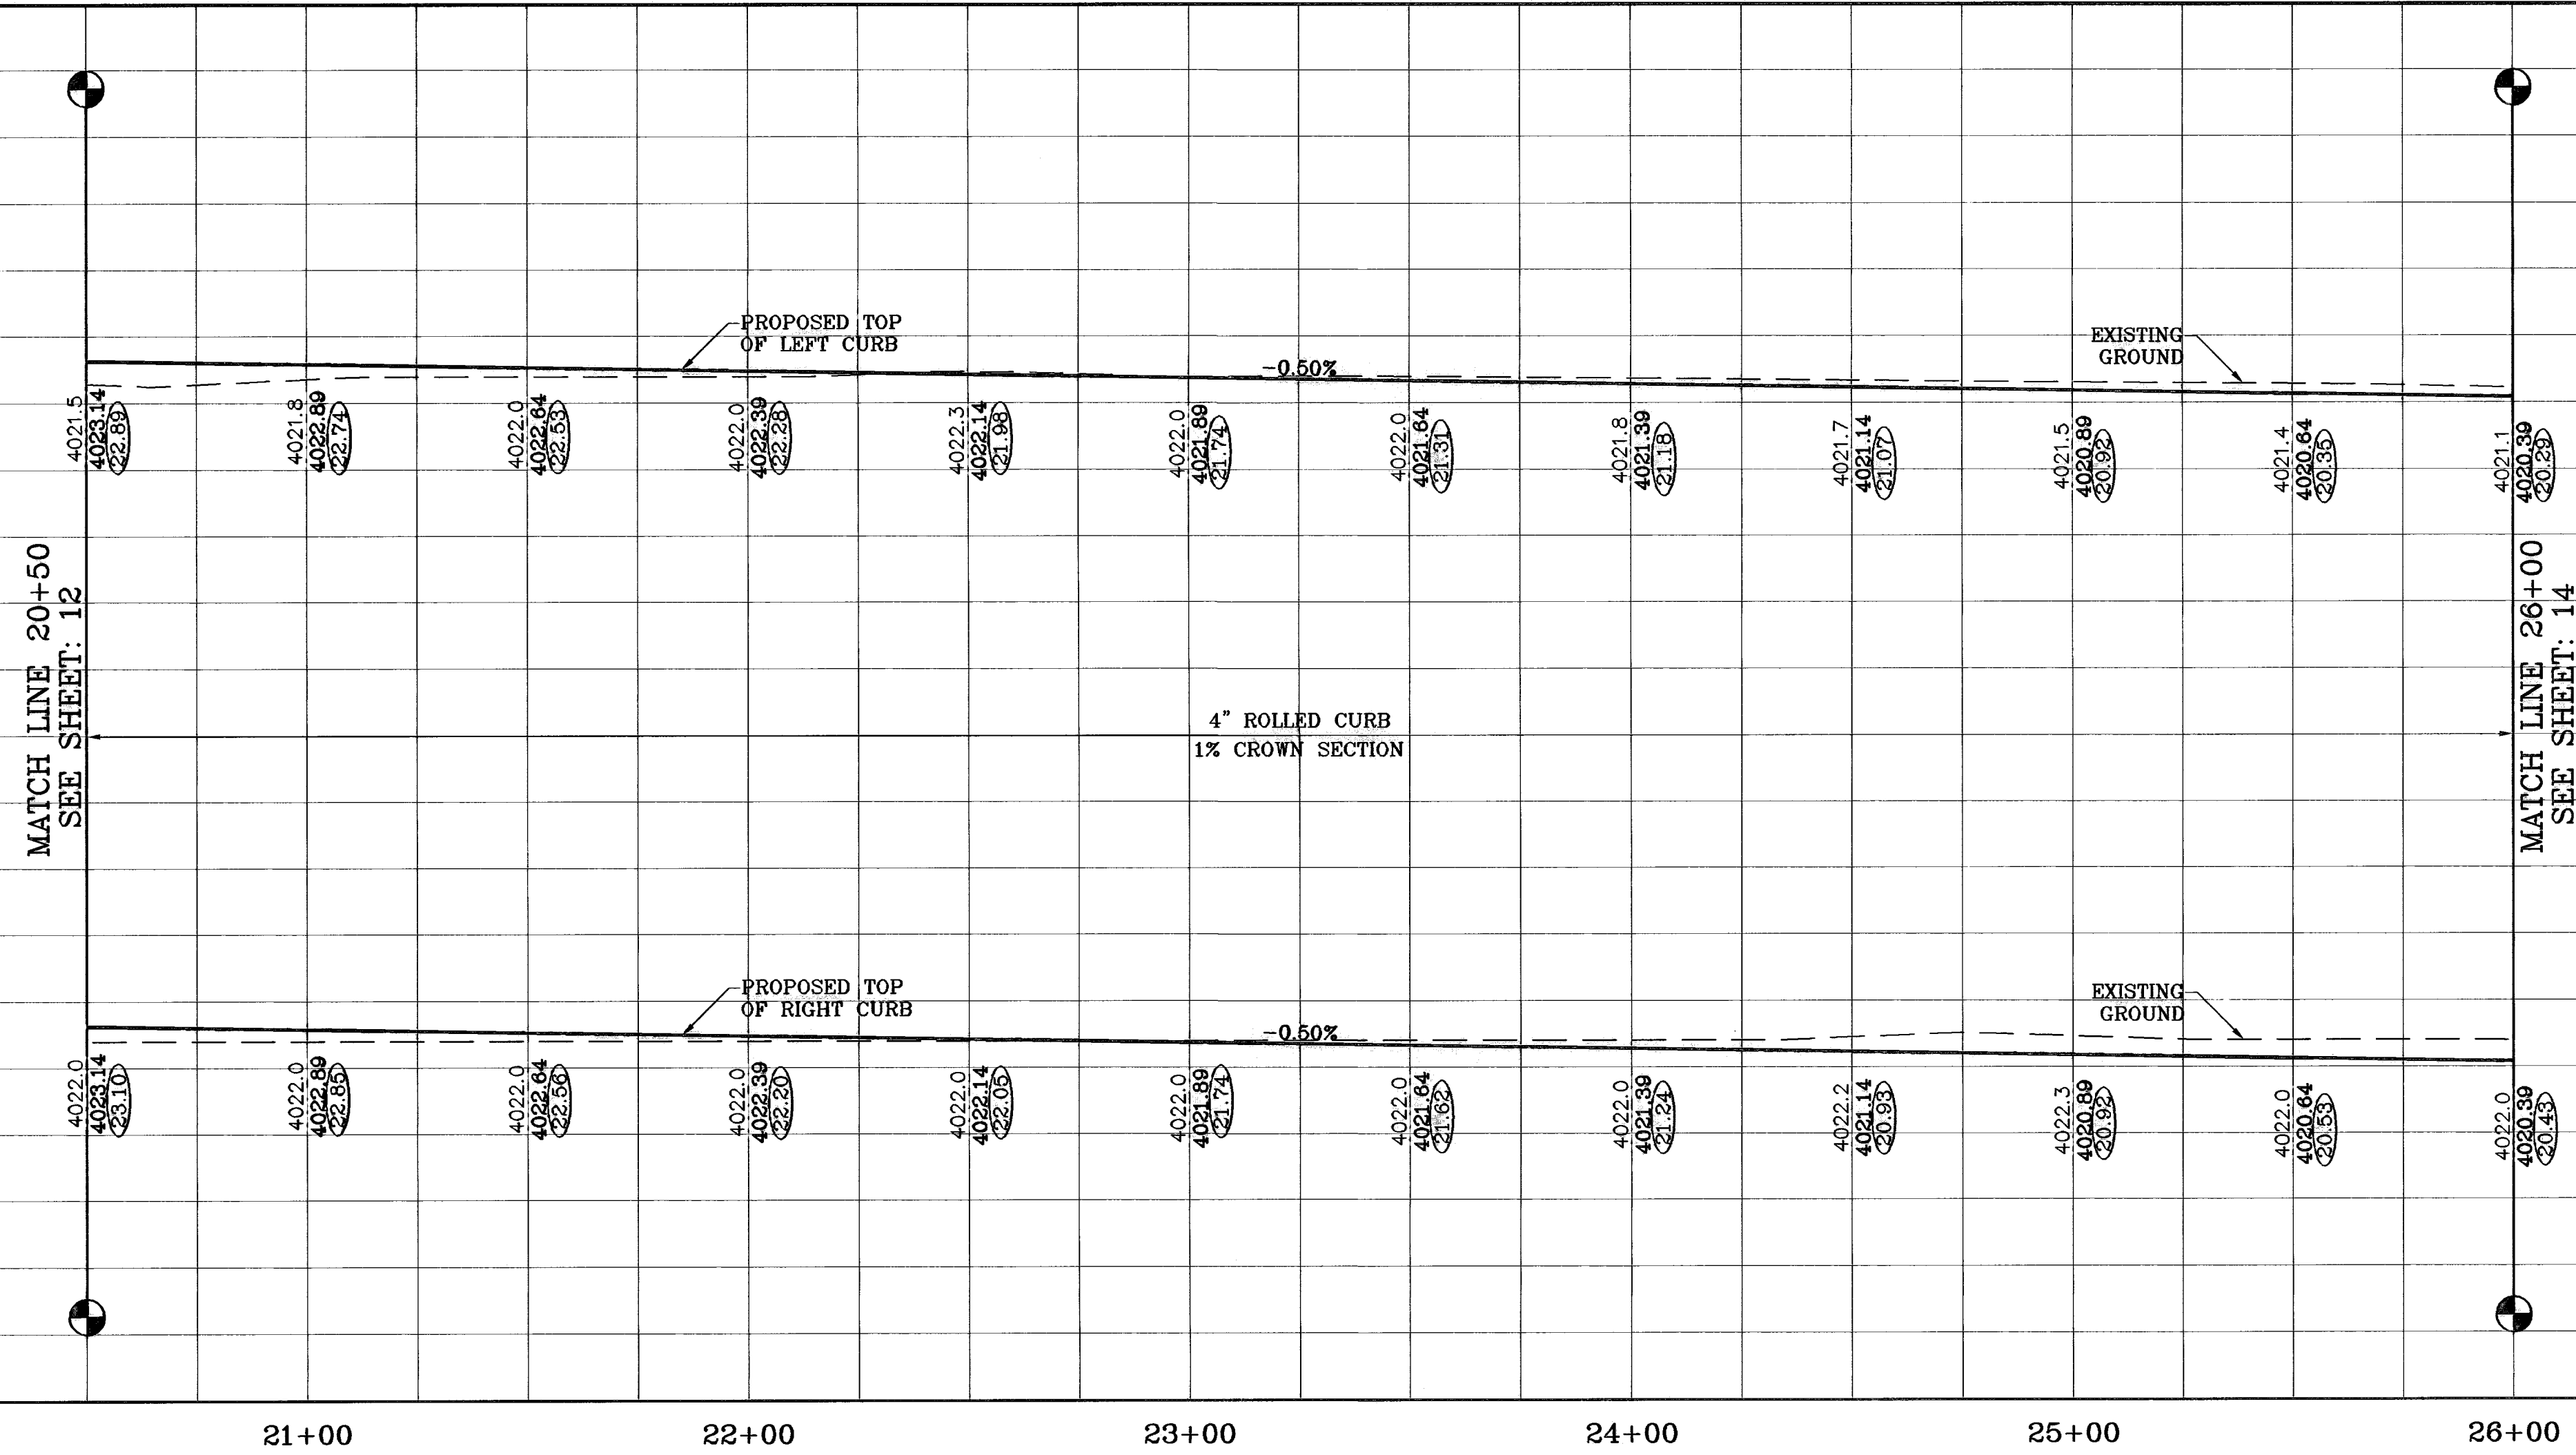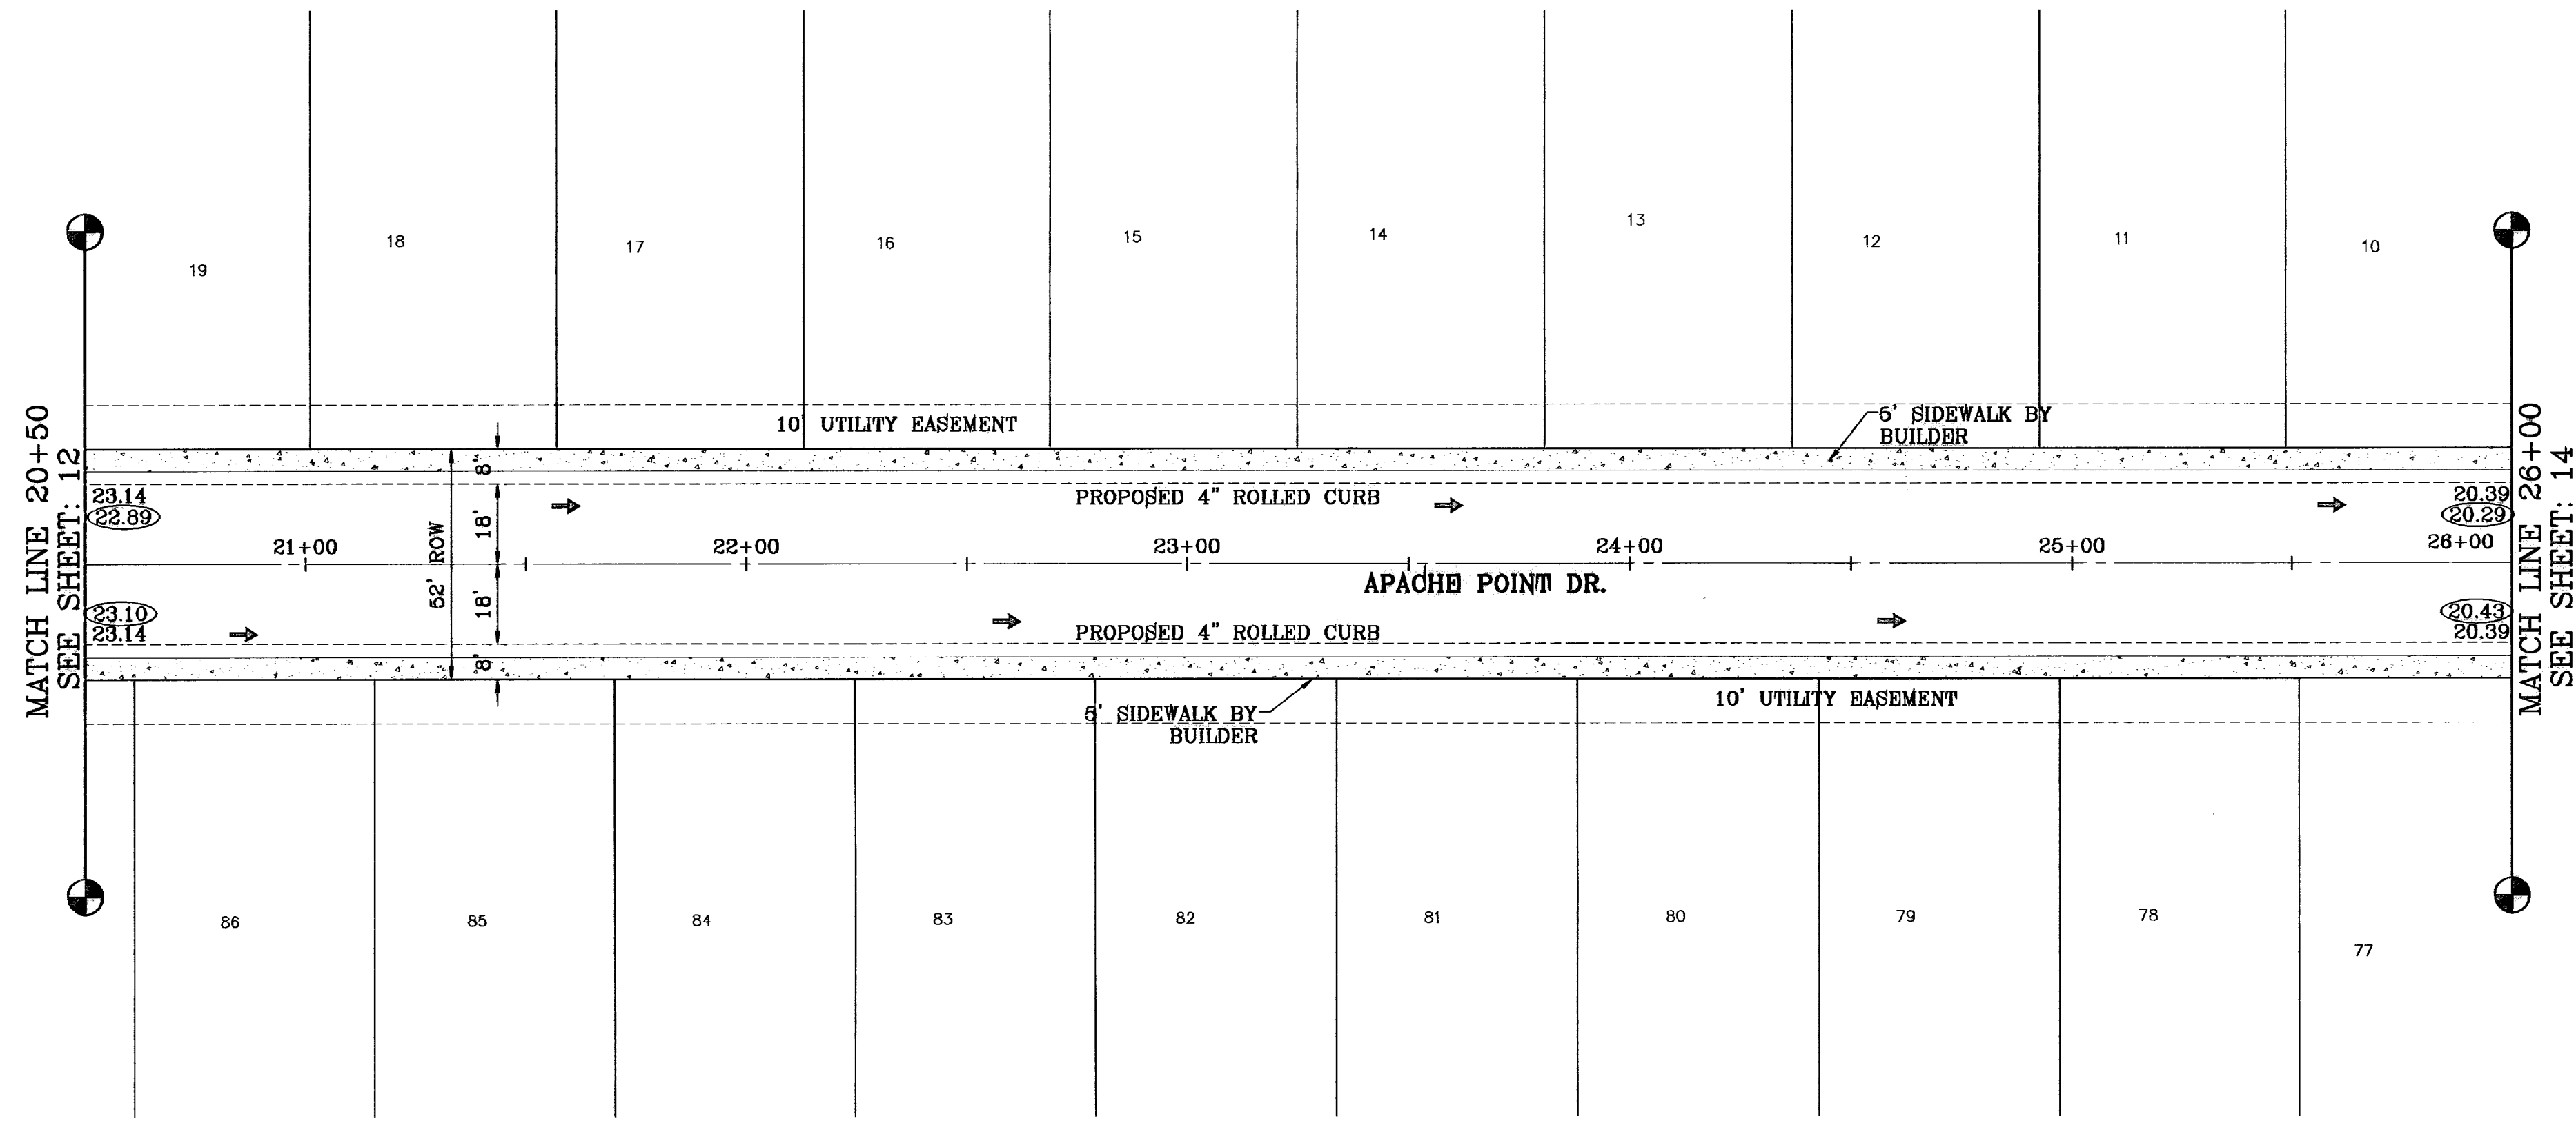

TIERRA DEL ESTE UNIT FIFTY NINE

DATE	REVISIONS	BY
12/05/08	CITY REDLINES AS PER 17/26/08 COMMENTS	E.P.G.
06/09/09	LOT REVISIONS	J.R.R.
12/30/09	AS BUILT	F.R.

**TIERRA DEL ESTE UNIT FIFTY NINE**  
 BEING A PORTION OF SECTION 38, BLOCK 79, TOWNSHIP 2, TEXAS AND PACIFIC RAILROAD COMPANY SURVEYS, CITY OF EL PASO, EL PASO COUNTY, TEXAS, CONTAINING 26.969 ACRES.

SCALE  
 HORIZ: 1"=30'  
 VERT: 1"=10'  
 DATE: MAY 2008  
 DESIGN BY: Y.C.  
 INITIATED BY: O.M.  
 CHECKED BY: Y.C.  
 JOB NO.: 608-23




**CONDE INC.**  
 ENGINEERING / PLANNING  
 SURVEYING / GPS  
 1790 LEE TREVINO STE 400  
 EL PASO, TEXAS 79966




SHEET TITLE  
**STREET PLAN-PROFILE**  
**APACHE POINT DR.**  
 STA: 20+50 TO STA 26+00

○ DENOTES AS BUILT CONDITION ONLY

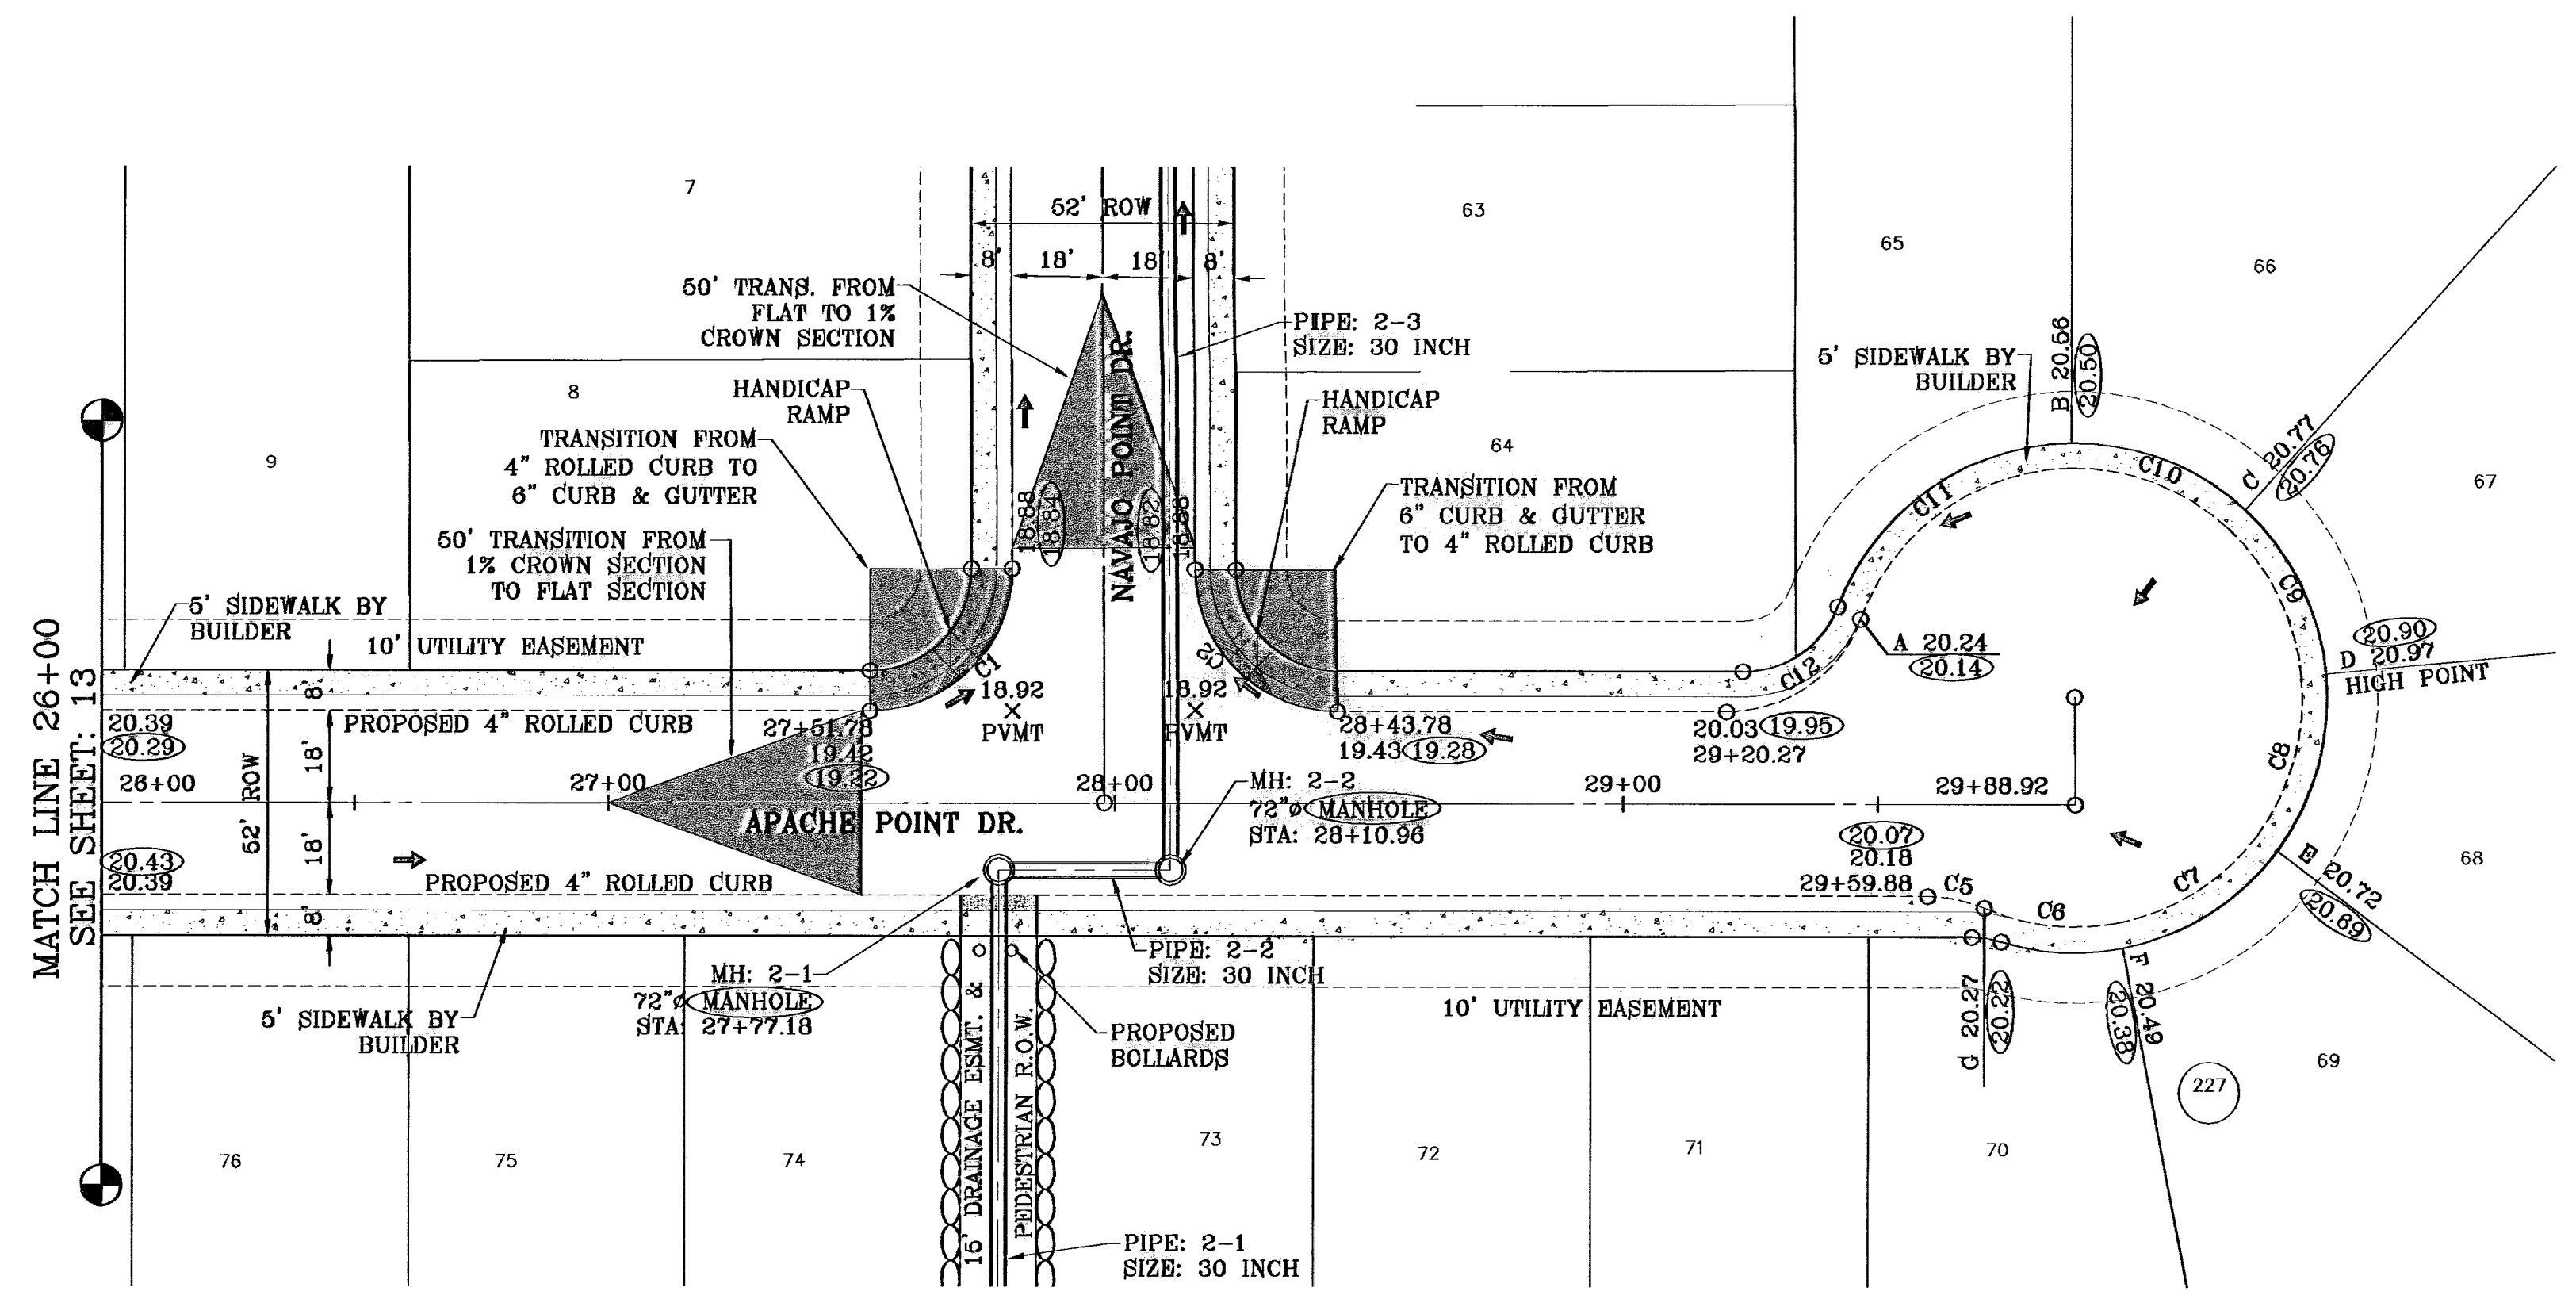

CURVE	RADIUS	LENGTH	TANGENT	CHORD	BEARING	DELTA
C1	28.00'	44.07'	28.09'	39.66'	N45°05'34"E	90°10'28"
C2	28.00'	43.90'	27.91'	39.54'	S44°54'26"E	89°49'32"
C5	28.00'	11.43'	5.80'	11.35'	N78°07'28"W	23°23'32"
C6	45.00'	28.95'	13.89'	28.55'	S83°35'04"E	34°18'48"
C7	45.00'	33.18'	17.38'	32.43'	N56°08'20"E	42°14'23"
C8	45.00'	33.18'	17.38'	32.43'	N15°53'57"E	42°14'23"
C9	45.00'	33.22'	17.41'	32.47'	N26°22'14"W	42°17'59"
C10	45.00'	33.87'	17.78'	33.08'	N69°04'58"W	43°07'29"
C11	45.00'	54.31'	31.01'	51.07'	S54°48'52"W	69°08'52"
C12	28.00'	34.20'	19.60'	32.11'	N55°11'37"E	69°58'22"

SEE SHEET 20 FOR BOLLARD DETAILS

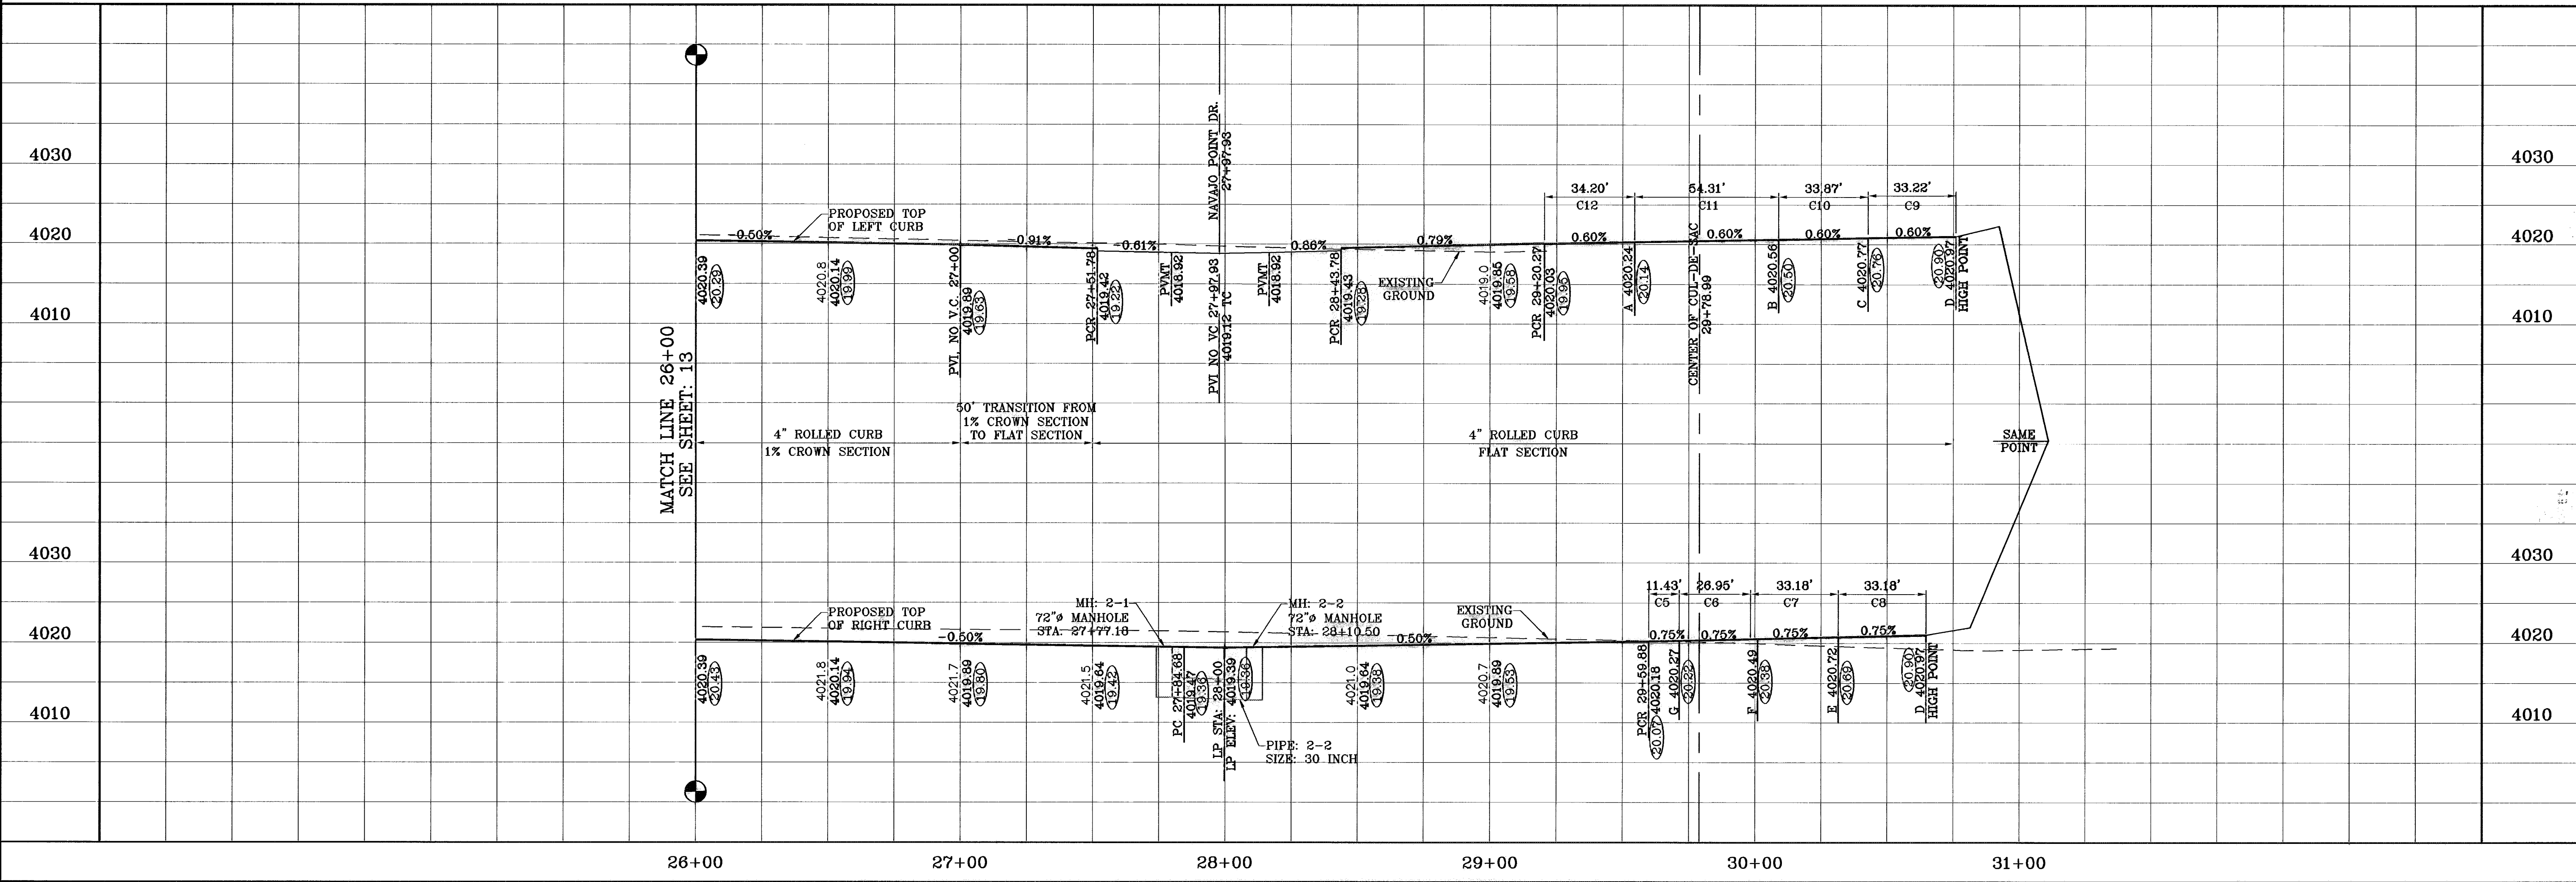

**CONDE INC.**  
ENGINEERING / PLANNING  
SURVEYING / GPS  
1760 LEE TREVINO STE 400  
EL PASO, TEXAS 79906

**TIERRA DEL ESTE UNIT FIFTY NINE**  
BEING A PORTION OF SECTION 38, BLOCK 79, TOWNSHIP 2,  
TEXAS AND PACIFIC RAILROAD COMPANY SURVEYS,  
CITY OF EL PASO, EL PASO COUNTY, TEXAS,  
CONTAINING 26.988 ACRES

**APACHE POINT DR.**  
STA: 26+00  
TO  
STA 29+78.99

**SHT 14 OF 24**


**SCALE:**  
HORIZ: 1"=30'  
VERT: 1"=10'

**DATE:** MAY 2008  
**DESIGN BY:** Y.C.  
**INITIATED BY:** O.M.  
**CHECKED BY:** Y.C.  
**JOB NO.:** 608-23

**REVISIONS:**  
DATE: 12/05/08  
BY: E.C.  
COMMENTS: CITY REDLINES AS PER 11/26/08  
DATE: 06/09/08  
BY: F.R.  
COMMENTS: LOT REVISIONS  
DATE: 12/30/06  
BY: F.R.  
COMMENTS: AS BUILT


**BENCHMARK:**  
NGS MARKER: COPPER-CLAD STEEL ROD  
DESIGNATED X 1118" PID "CE0141"  
ELEVATION: 3987.12

○ DENOTES AS BUILT CONDITION ONLY

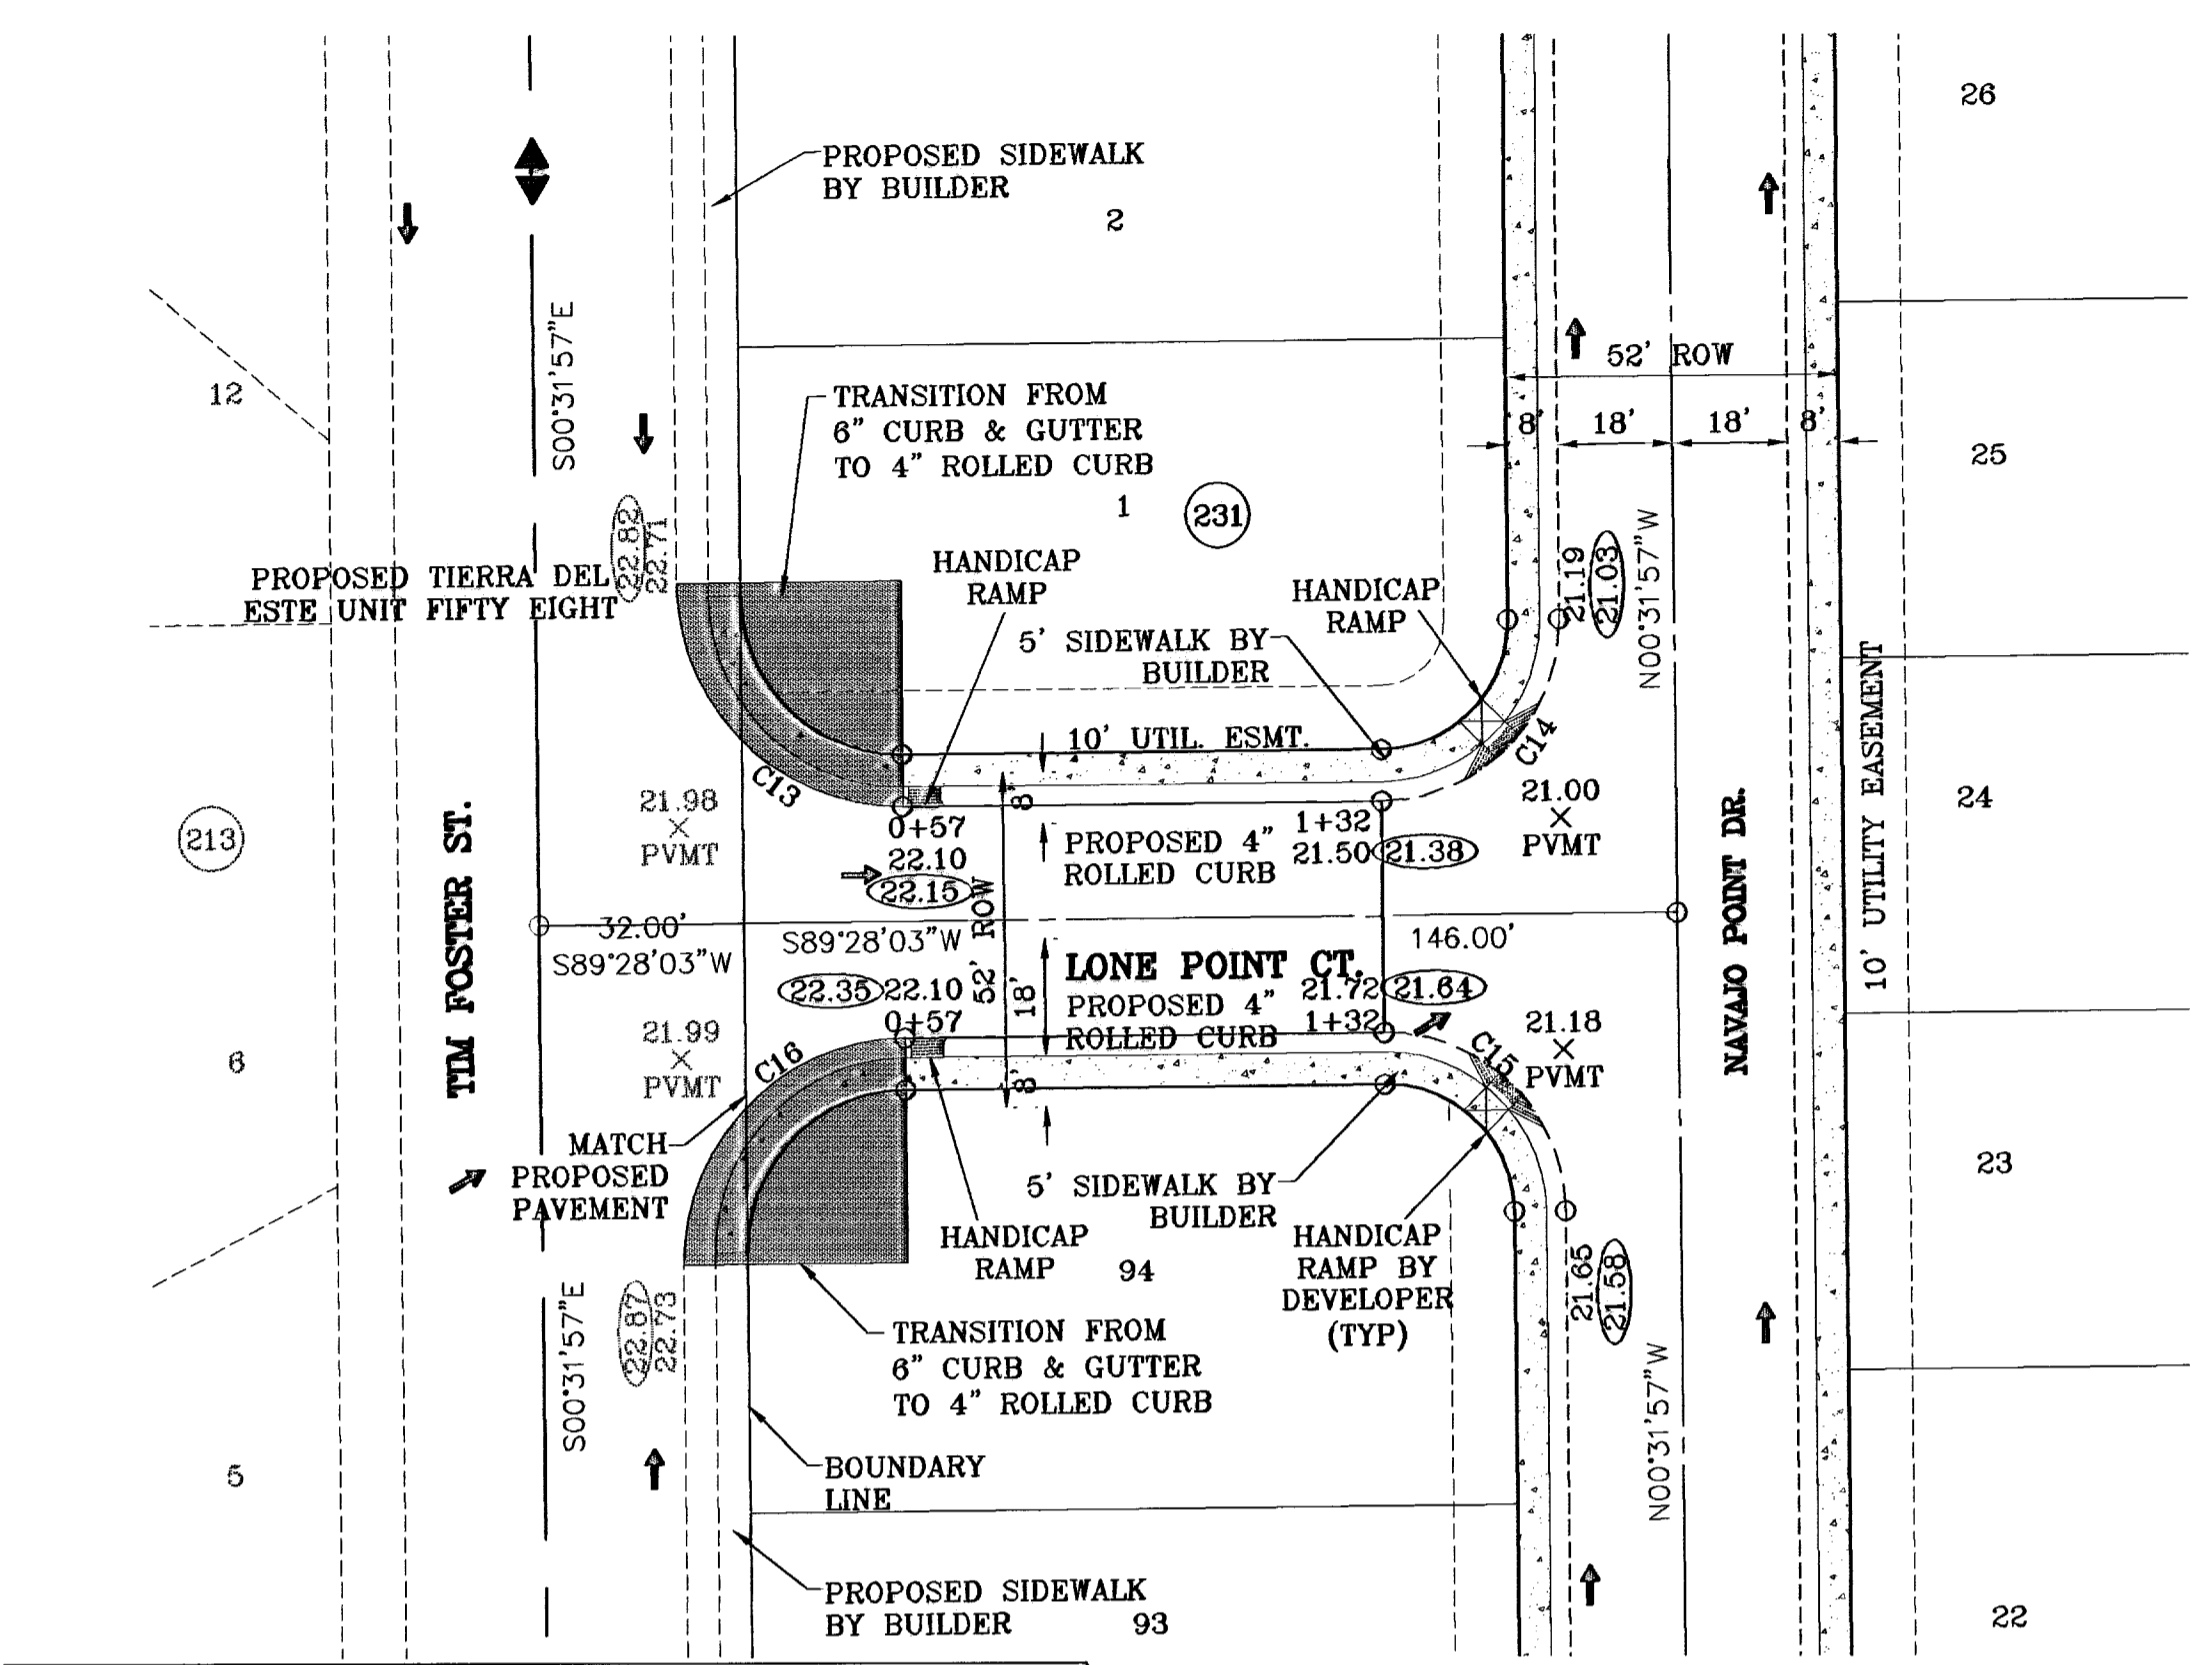


CURVE	RADIUS	LENGTH	TANGENT	CHORD	BEARING	DELTA
C13	35.00'	54.97'	35.00'	49.49'	S45°31'47"E	89°59'39"
C14	28.00'	43.98'	28.00'	39.60'	N44°28'23"E	90°00'00"
C15	28.00'	43.98'	28.00'	39.60'	N45°31'37"W	90°00'00"
C18	35.00'	54.98'	35.00'	49.50'	S44°28'13"W	90°00'21"

SCALE: 1"=30'

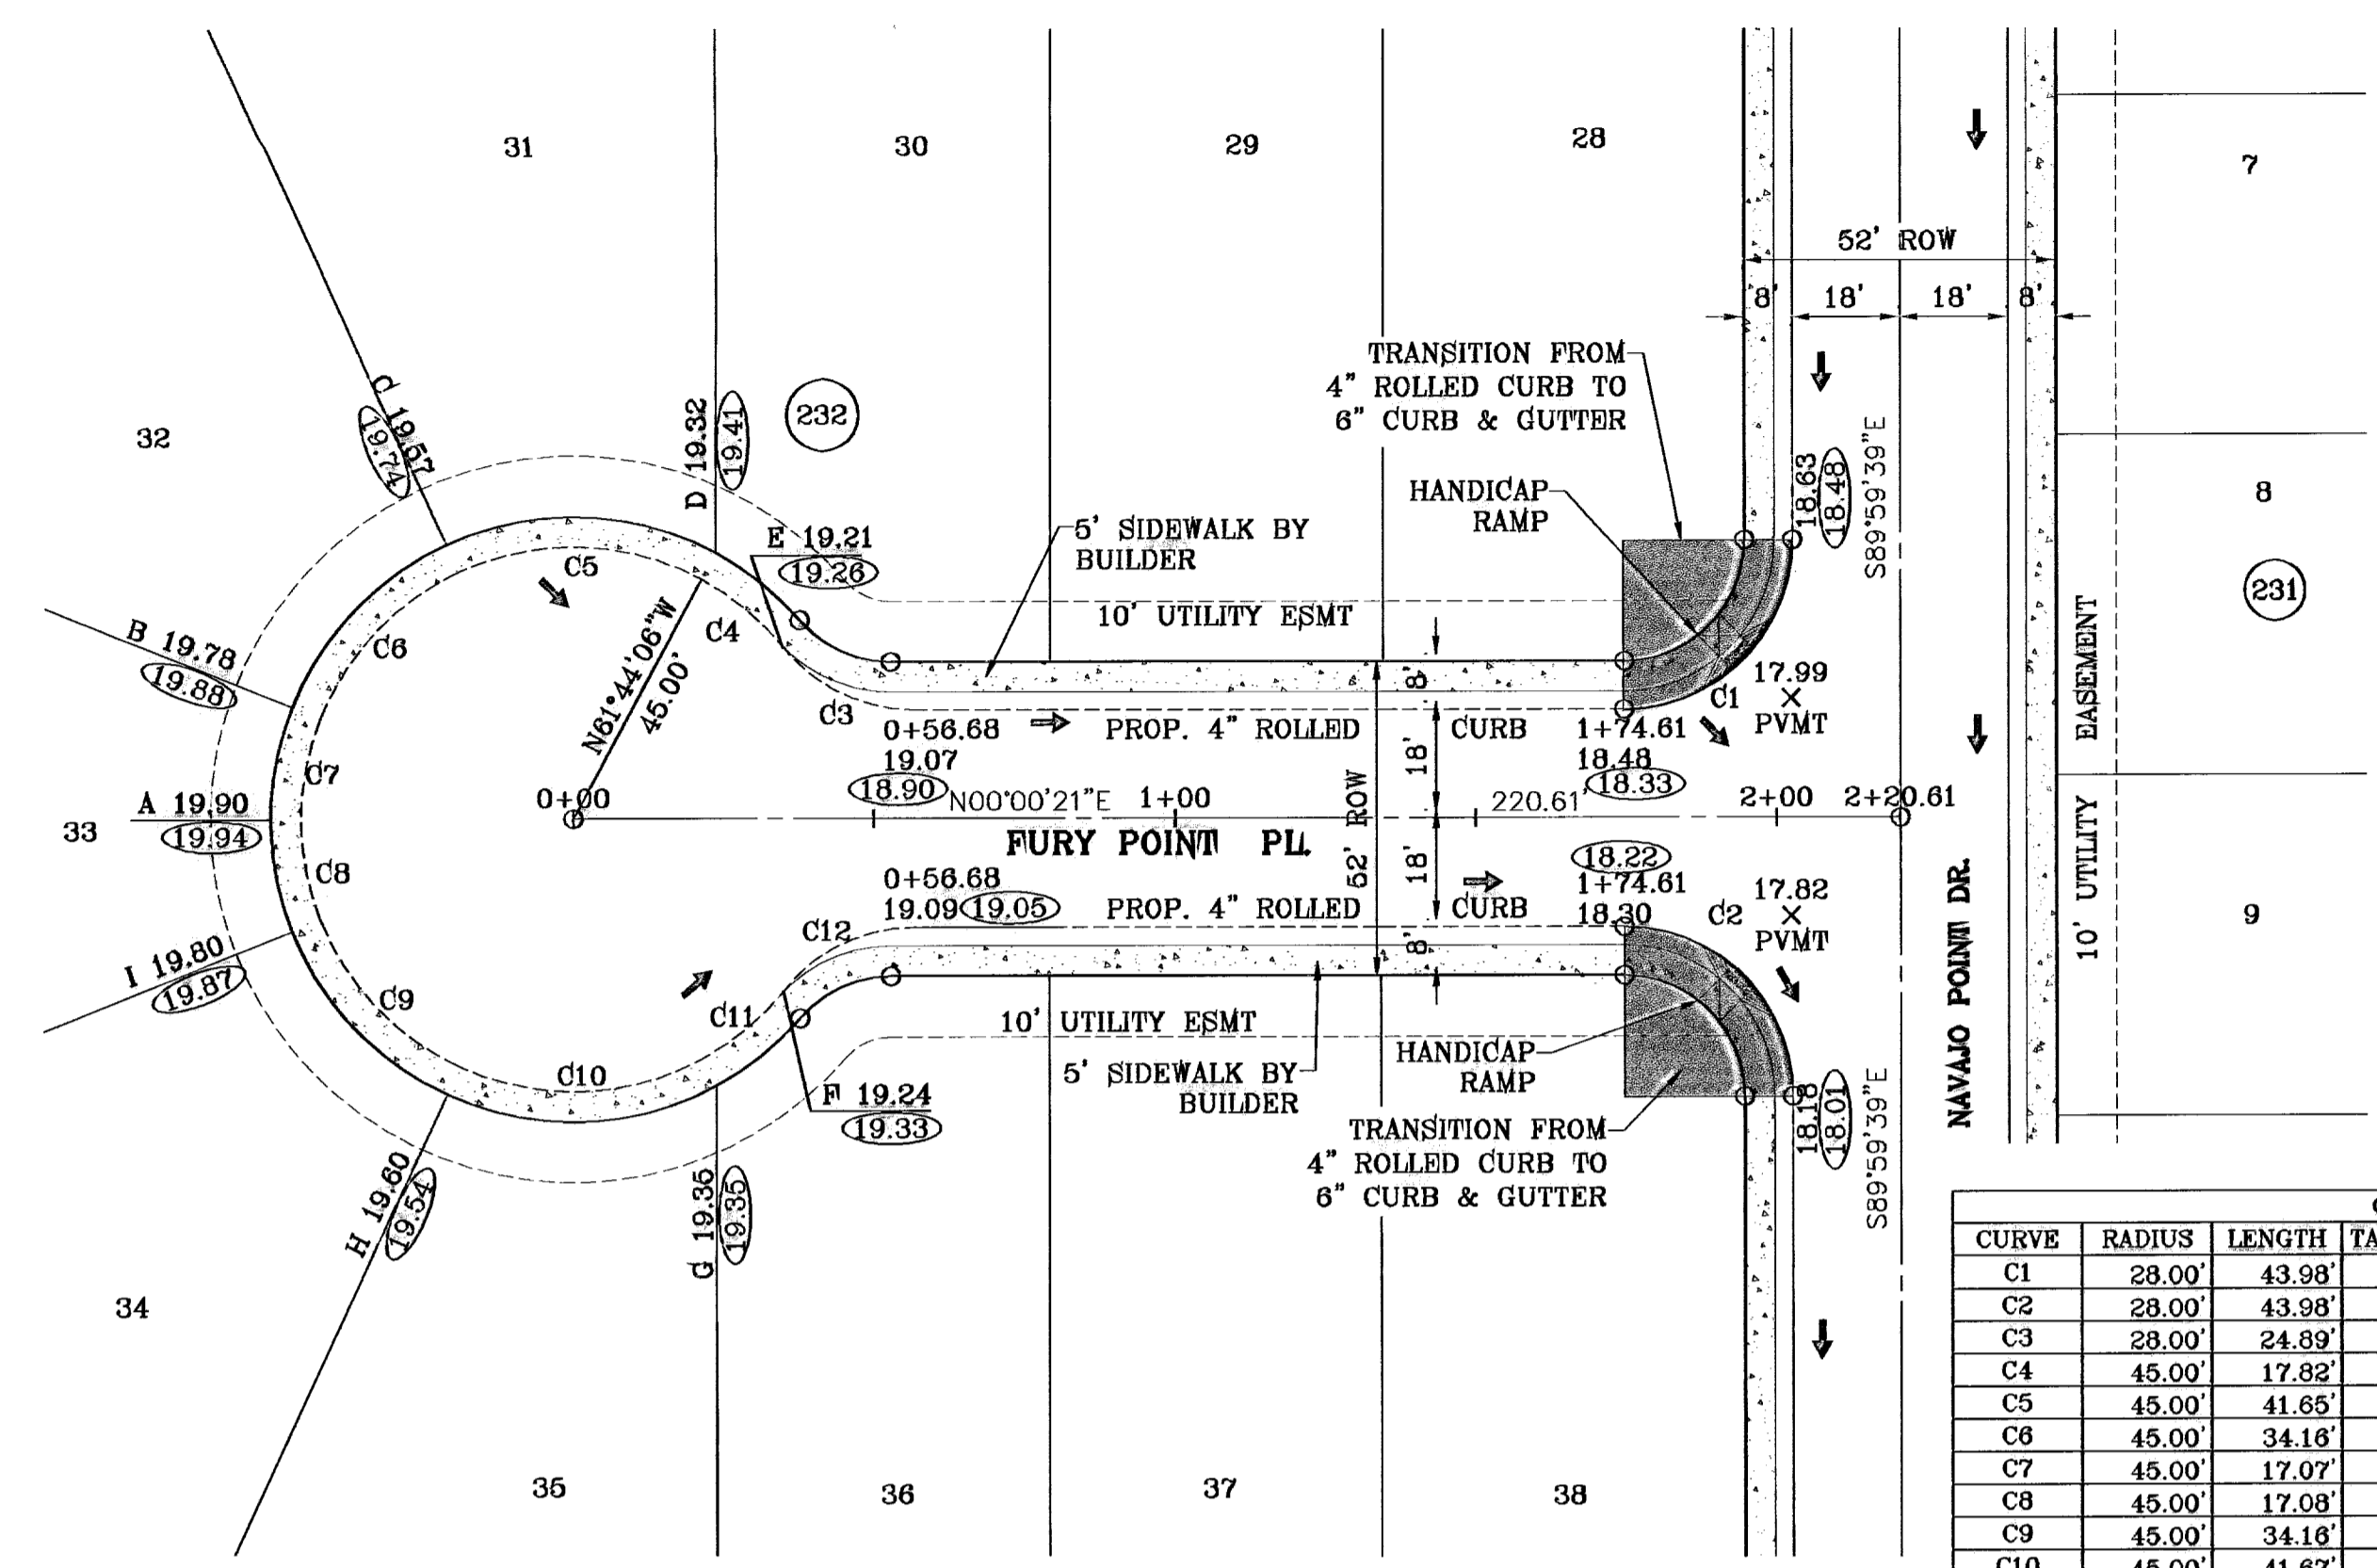

SCALE: 1"=30'

CURVE	RADIUS	LENGTH	TANGENT	CHORD	BEARING	DELTA
C1	28.00'	43.98'	28.00'	39.60'	N44°59'19"W	90°00'00"
C2	28.00'	43.98'	28.00'	39.60'	S45°00'41"W	90°00'00"
C3	28.00'	24.89'	13.34'	24.08'	N25°28'53"E	50°58'23"
C4	45.00'	17.82'	9.03'	17.70'	S39°36'29"W	22°41'10"
C5	45.00'	41.65'	22.45'	40.18'	S01°44'48"W	53°02'12"
C6	45.00'	34.16'	17.95'	33.34'	S46°30'57"E	43°29'18"
C7	45.00'	17.07'	8.64'	16.97'	S79°07'38"E	21°44'03"
C8	45.00'	17.08'	8.64'	16.98'	N79°07'28"E	21°44'39"
C9	45.00'	34.16'	17.95'	33.34'	N46°30'27"E	43°29'18"
C10	45.00'	41.67'	22.48'	40.20'	N01°45'54"W	53°03'25"
C11	45.00'	17.78'	9.01'	17.66'	N39°36'39"W	22°38'05"
C12	28.00'	24.89'	13.34'	24.08'	S25°27'30"E	50°58'23"

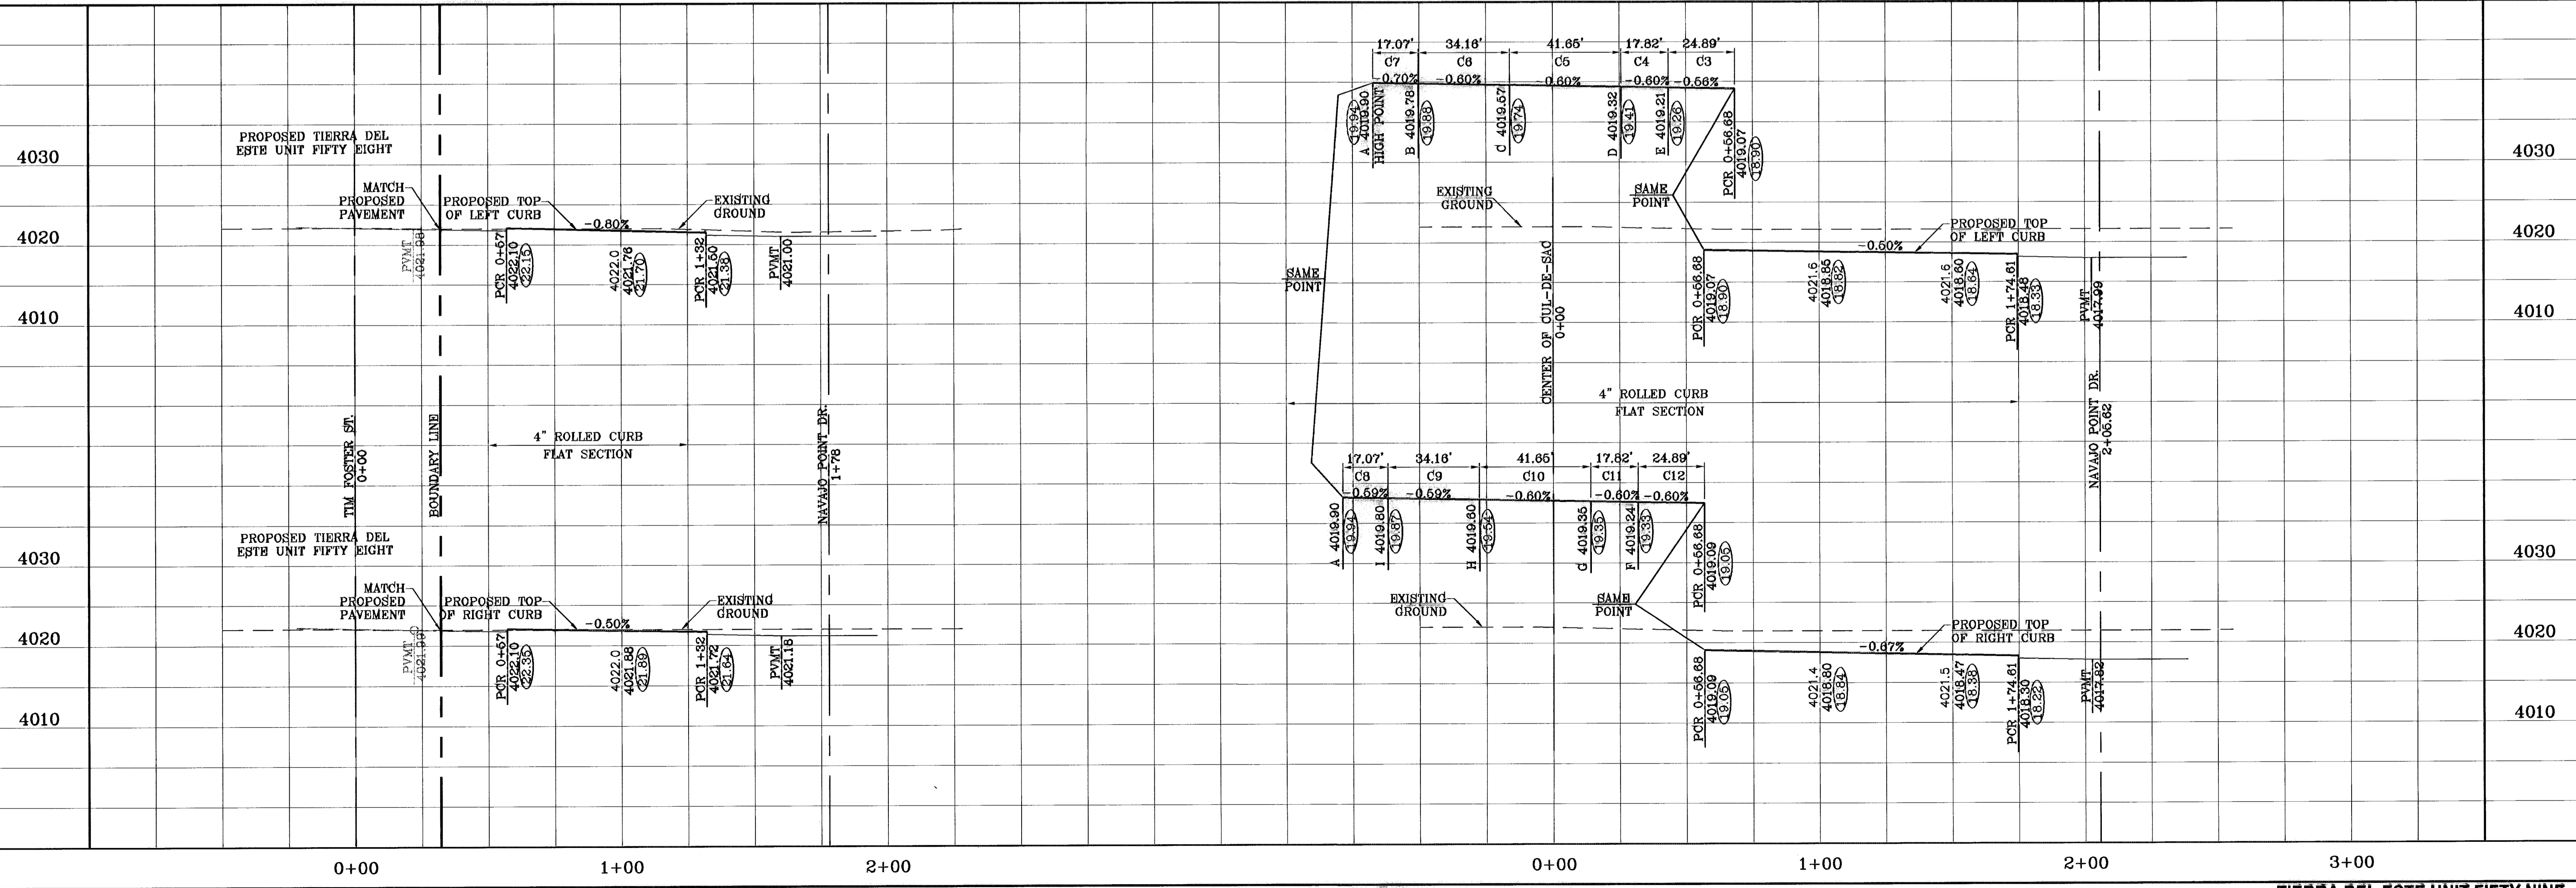

DATE	REVISIONS	BY
12/05/08	CITY REVISIONS AS PER 11/28/08 COMMENTS	E.F.C.
06/09/08	CHANGES AS PER REVISED PLAN	R.R.
06/09/08	LOT REVISIONS	R.R.
09/28/08	CITY RED LINES	R.R.



**TERRA DEL ESTE UNIT FIFTY NINE**  
 BEING A PORTION OF SECTION 88, BLOCK 79, TOWNSHIP 2, TEXAS AND PACIFIC RAILROAD COMPANY SURVEYS, CITY OF EL PASO, EL PASO COUNTY, TEXAS, CONTAINING 26.969 ACRES

SCALE:  
 HORIZ: 1"=30'  
 VERT: 1"=10'  
 DATE: MAY 2008  
 DESIGN BY: Y.C.  
 INITIATED BY: O.M.  
 CHECKED BY: Y.C.  
 JOB NO.: 608-23

**CONDE INC.**  
 ENGINEERING / PLANNING  
 SURVEYING / GPS  
 1790 LEE TREVINO STE 400  
 EL PASO, TEXAS 79936

SHEET TITLE  
**STREET PLAN-PROFILE**  
**LONE POINT CT. & FURY POINT PL.**  
 SHT 15 OF 24

○ DENOTES AS BUILT CONDITION ONLY

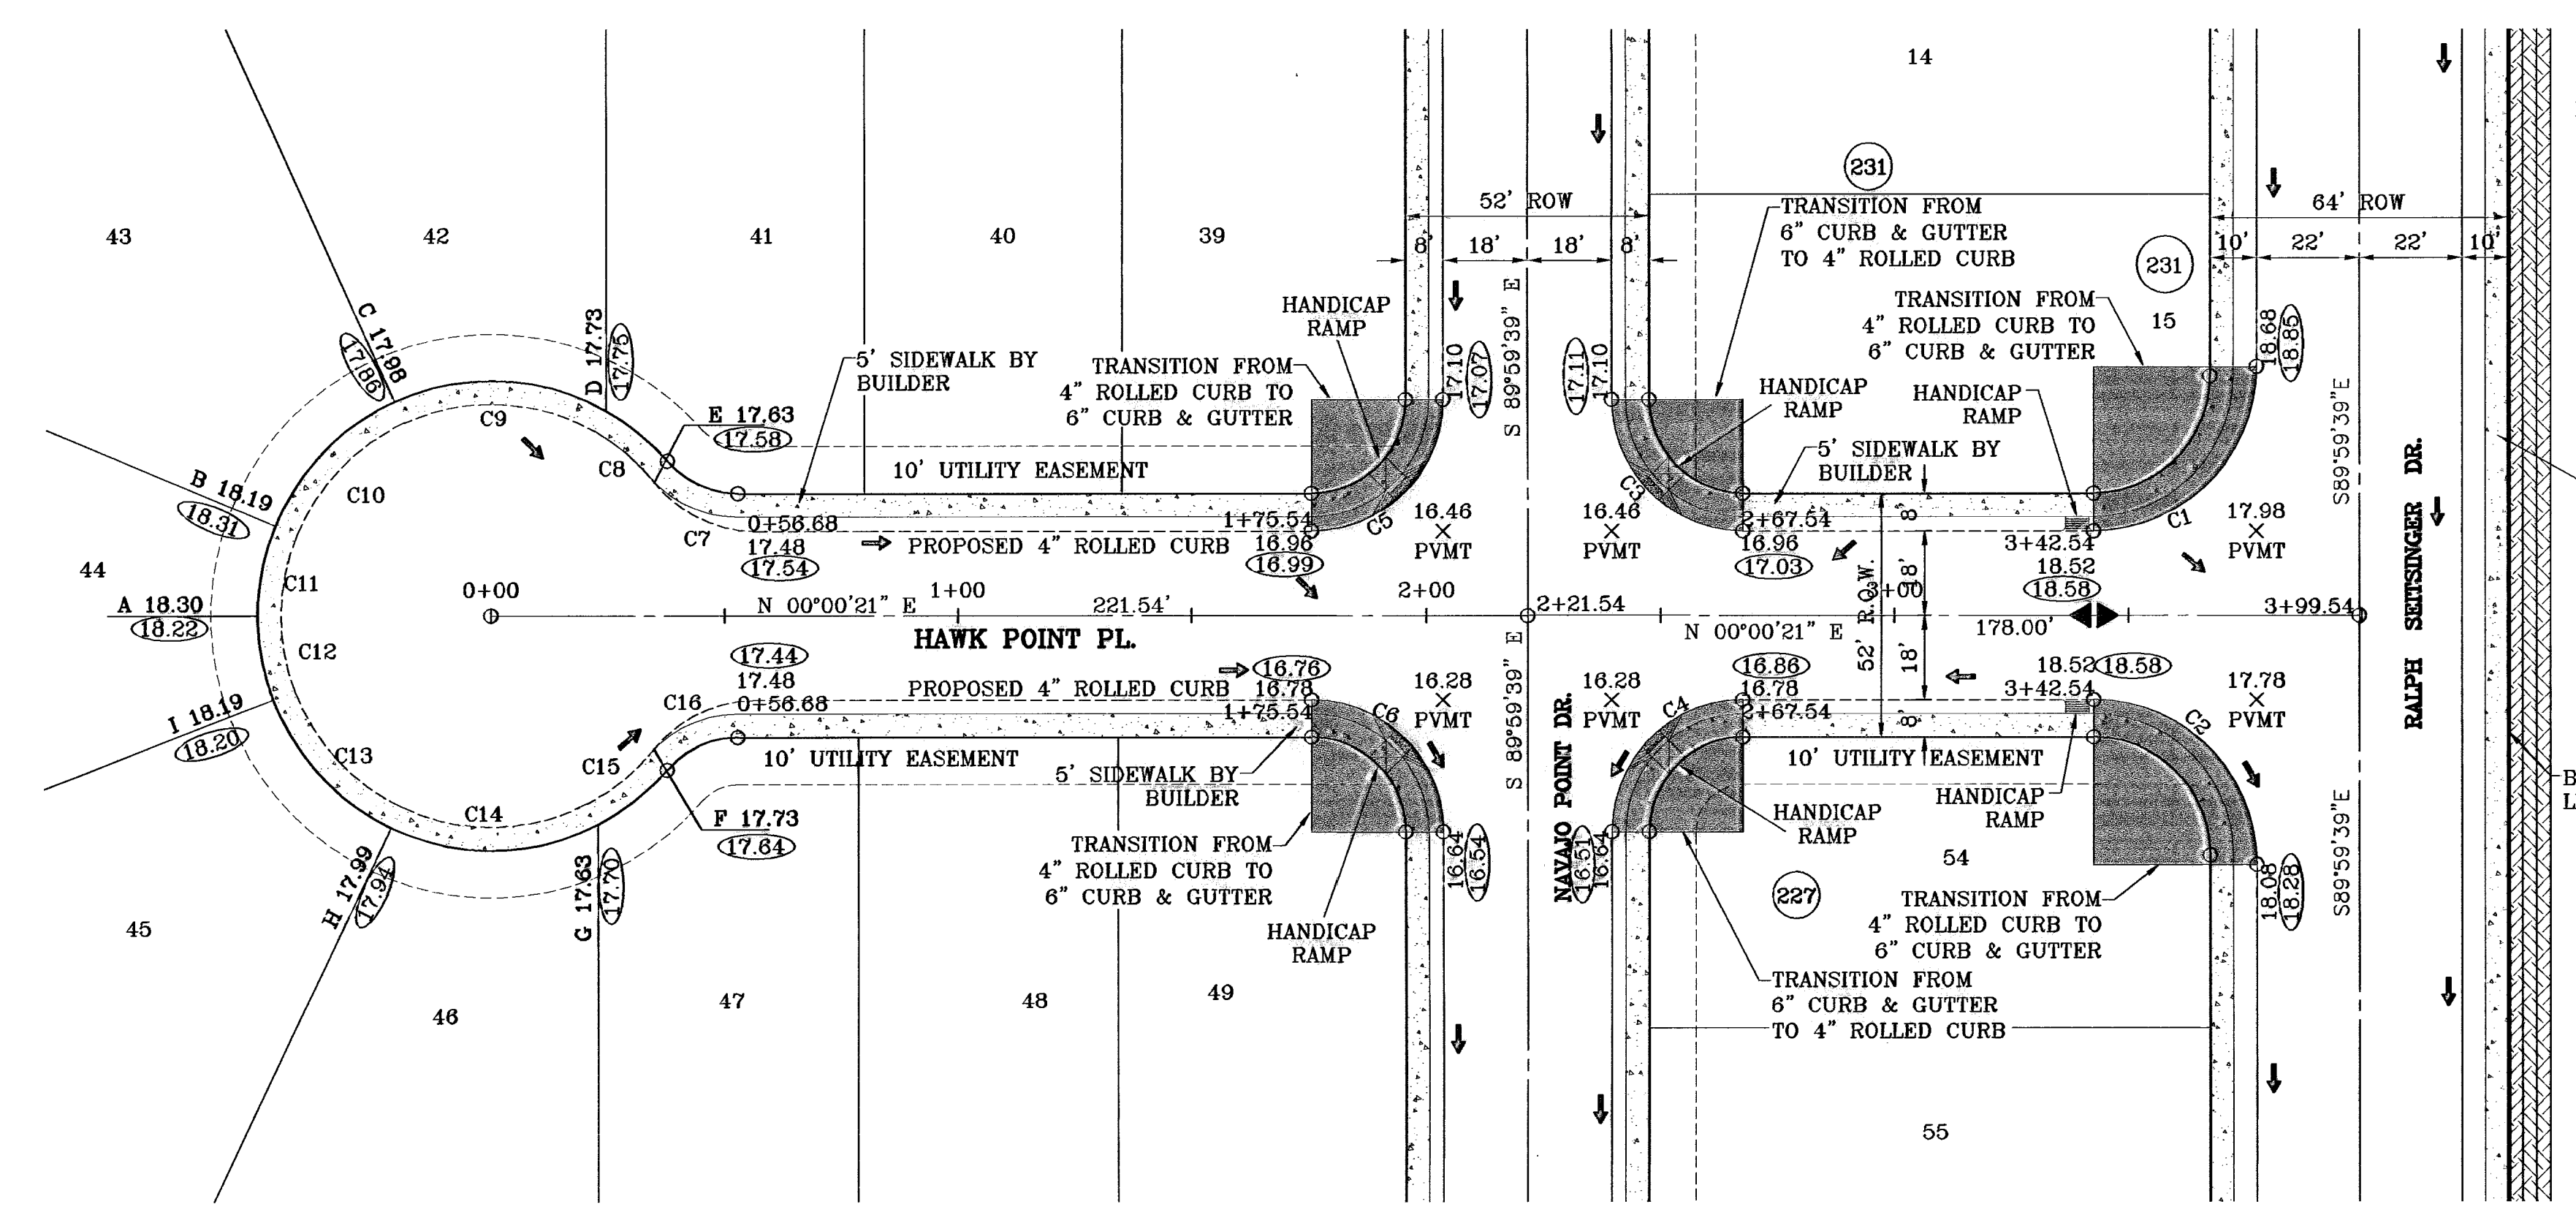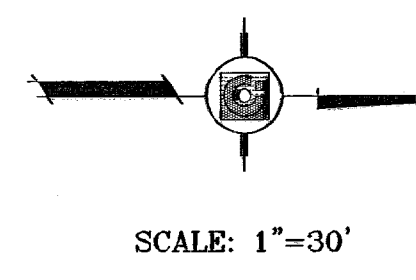

SECTION 38,  
BLOCK 79, TSP 2  
TRACT 5  
FUTURE SCHOOL

PROPOSED SIDEWALK  
BY BUILDER AT TIME  
OF DEVELOPMENT

BOUNDARY LINE


CURVE TABLE						
CURVE	RADIUS	LENGTH	TANGENT	CHORD	BEARING	DELTA
C1	35.00'	54.98'	35.00'	49.50'	N44°59'19"W	90°00'00"
C2	35.00'	54.98'	35.00'	49.50'	S45°00'41"W	90°00'00"
C3	28.00'	43.98'	28.00'	39.60'	N45°00'41"W	90°00'00"
C4	28.00'	43.98'	28.00'	39.60'	S44°59'19"E	90°00'00"
C5	28.00'	43.98'	28.00'	39.60'	N44°59'19"W	90°00'00"
C6	28.00'	43.98'	28.00'	39.60'	S45°00'41"W	90°00'00"
C7	28.00'	24.89'	13.34'	24.08'	N25°28'53"E	50°58'23"
C8	45.00'	16.81'	8.51'	16.72'	S40°14'47"W	21°24'34"
C9	45.00'	42.41'	22.93'	40.85'	S02°33'41"W	53°59'38"
C10	45.00'	33.85'	17.77'	33.05'	S45°59'56"E	45°05'38"
C11	45.00'	17.09'	8.65'	16.99'	S78°25'29"E	21°48'30"
C12	45.00'	17.09'	8.65'	16.99'	N79°49'01"E	21°48'30"
C13	45.00'	34.18'	17.96'	33.38'	N47°10'46"E	43°31'00"
C14	45.00'	41.38'	22.28'	39.93'	N00°55'13"W	52°40'59"
C15	45.00'	18.59'	9.43'	18.46'	S39°05'42"E	23°40'00"
C16	28.00'	24.89'	13.34'	24.08'	S25°27'30"E	50°58'23"

AS BUILT  
BENCHMARK  
NGS MARKER: COPPER-CLAD STEEL ROD  
DESIGNATED X 1118' PID "CE0141"  
ELEVATION: 3967.12

DATE: 12/05/08  
REVISIONS: CITY REDLINES AS PER 11/26/08 COMMENTS E.F.G.  
06/09/09 CHANGE DUE TO PLAT  
06/09/09 LOT REVISIONS  
09/28/09 CITY RED LINES

PROJECT NAME  
**TIERRA DEL ESTE  
UNIT FIFTY NINE**

BEING A PORTION OF SECTION 38, BLOCK 79, TOWNSHIP 2,  
TEXAS AND PACIFIC RAILROAD COMPANY SURVEYS,  
CITY OF EL PASO, EL PASO COUNTY, TEXAS,  
CONTAINING 26.969 ACRES

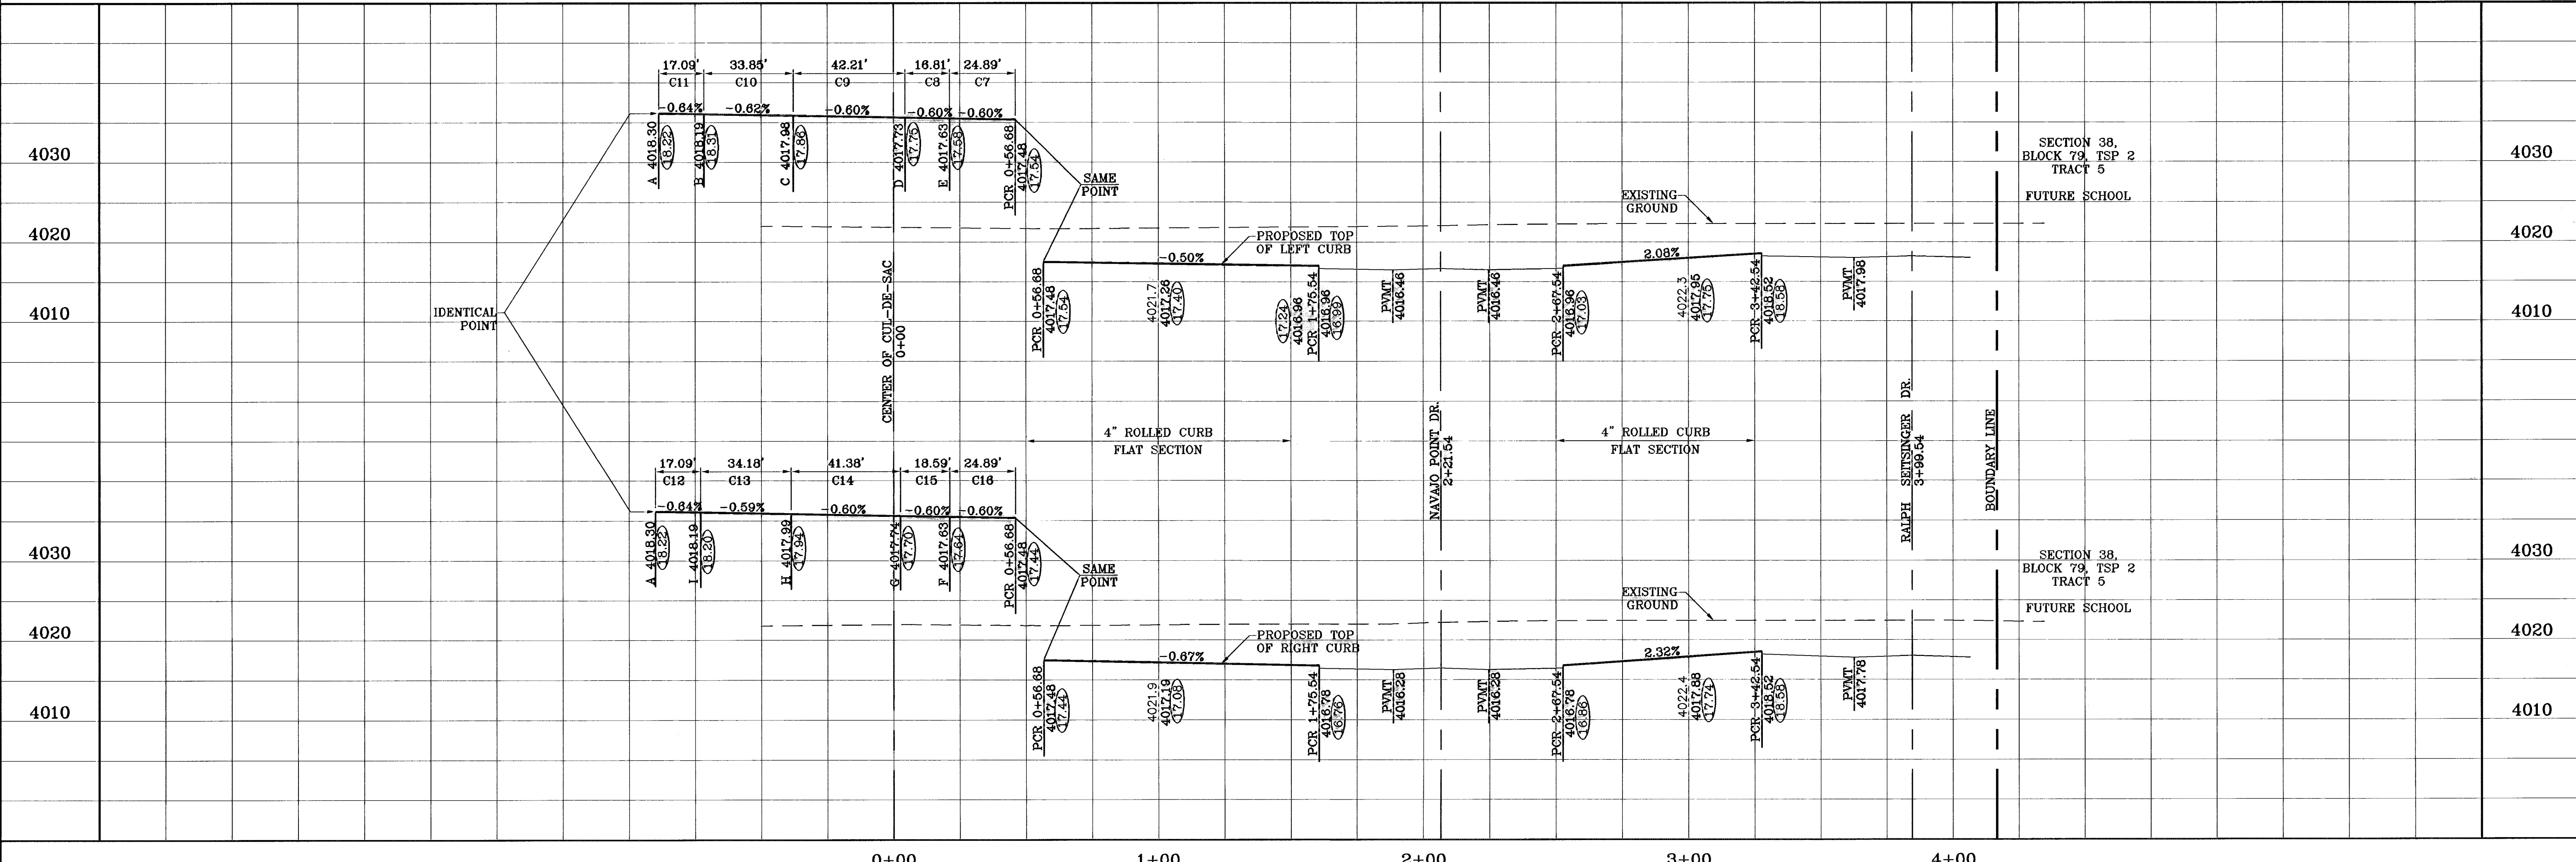

SCALE  
HORIZ. 1"=30'  
VERT. 1"=10'

DATE: MAY 2008  
DESIGN BY: Y.C.  
INITIATED BY: O.M.  
CHECKED BY: Y.C.  
JOB NO.: 608-23


ENGINEER'S SEAL

CONDE INC.  
ENGINEERING / PLANNING  
SURVEYING / GPS  
1760 LEE TRAVINO SITE 400  
EL PASO, TEXAS 79936

SHEET TITLE  
**STREET  
PLAN-PROFILE**


**HAWK POINT PL.**



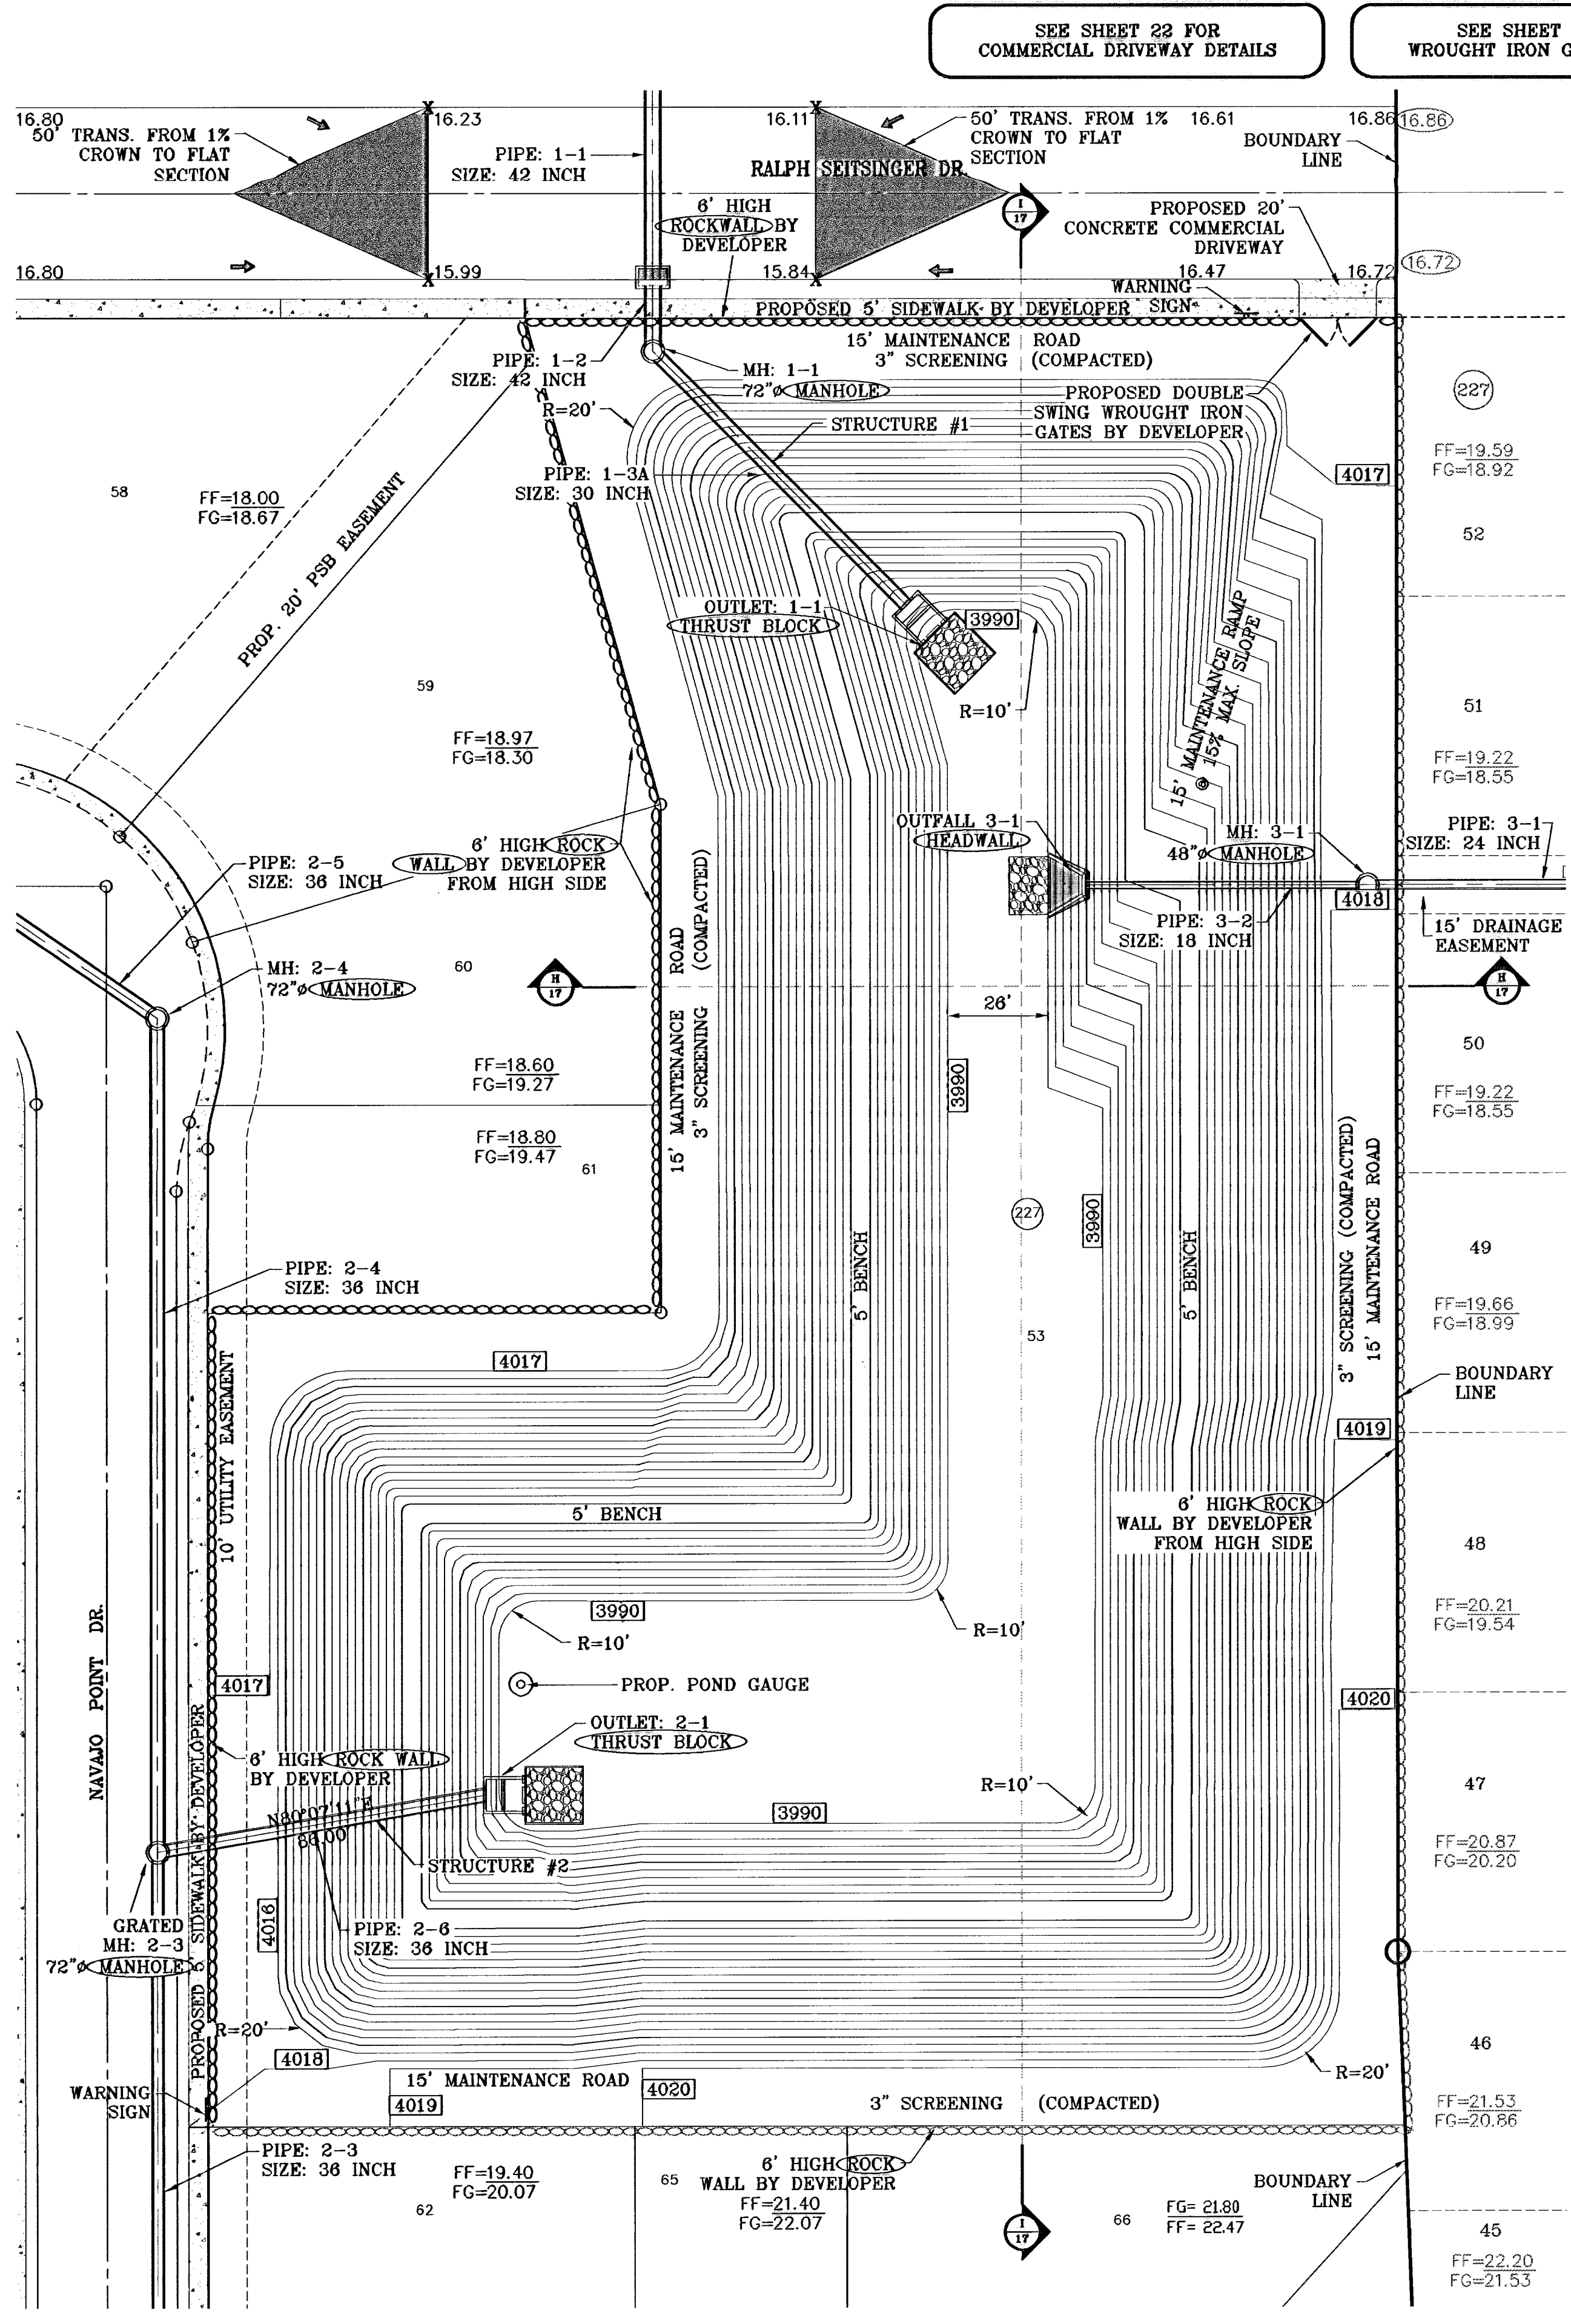

SEE SHEET 22 FOR COMMERCIAL DRIVEWAY DETAILS  
SEE SHEET 23 FOR WROUGHT IRON GATE DETAILS

SCALE: 1"=30'

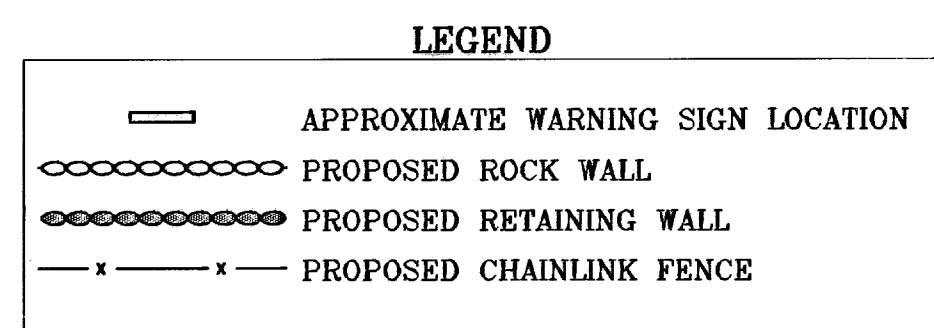

SEE SHEETS 18-19 FOR STRUCTURE #1, #2 & #3 DETAILS

ELEVATION FT	CONIC VOL. AC-FT	VOLUME CAP. AC-FT
4015.00	1.88	28.07
4014.00	1.82	26.19
4013.00	1.78	24.38
4012.00	1.69	22.82
4011.00	1.63	20.93
4010.00	1.57	19.31
4009.00	1.51	17.74
4008.00	1.45	16.23
4007.00	1.39	14.79
4006.00	1.33	13.40
4005.00	1.27	12.07
4004.00	1.21	10.80
4003.00	1.16	9.58
4002.00	1.10	8.43
4001.00	0.98	7.33
4000.00	0.86	6.35
3999.00	0.81	5.49
3998.00	0.76	4.68
3997.00	0.71	3.93
3996.00	0.66	3.22
3995.00	0.61	2.57
3994.00	0.56	1.96
3993.00	0.51	1.40
3992.00	0.47	0.89
3991.00	0.42	0.42
3990.00	0.00	0.00

**WATERSHED - POND**

$$Q = \frac{A R C}{12} = AC-FT$$

POND CALC.

Q=ARC/12  
A=TOTAL RUNOFF IN AC/FT.(100%)  
R=RAINFALL IN INCHES  
C=RUNOFF FACTOR


TDE 49 =  $\frac{9.55(4).60}{12} = -1.91$  ac-ft  
TDE 57 =  $\frac{9.54(4).50}{12} = -1.59$  ac-ft  
TDE 58 =  $\frac{0.57(4).90}{12} = -0.17$  ac-ft  
TDE 59 =  $\frac{28.97(4).50}{12} = -4.50$  ac-ft & POND  
TDE 60 =  $\frac{20.37(4).50}{12} = -3.40$  ac-ft

FUT. SCHOOL =  $\frac{35.00(4).55}{12} = -6.42$  ac-ft



25% EMERG. = 4.50 ac-ft  
SILT & DEBIRS = 1.22 ac-ft

Qreq (TOTAL) = 23.71  
Qcap (TOTAL) = 26.34

100 YR PONDED DEPTH = 4012.66  
100 YR HW ELEV = 4009.15

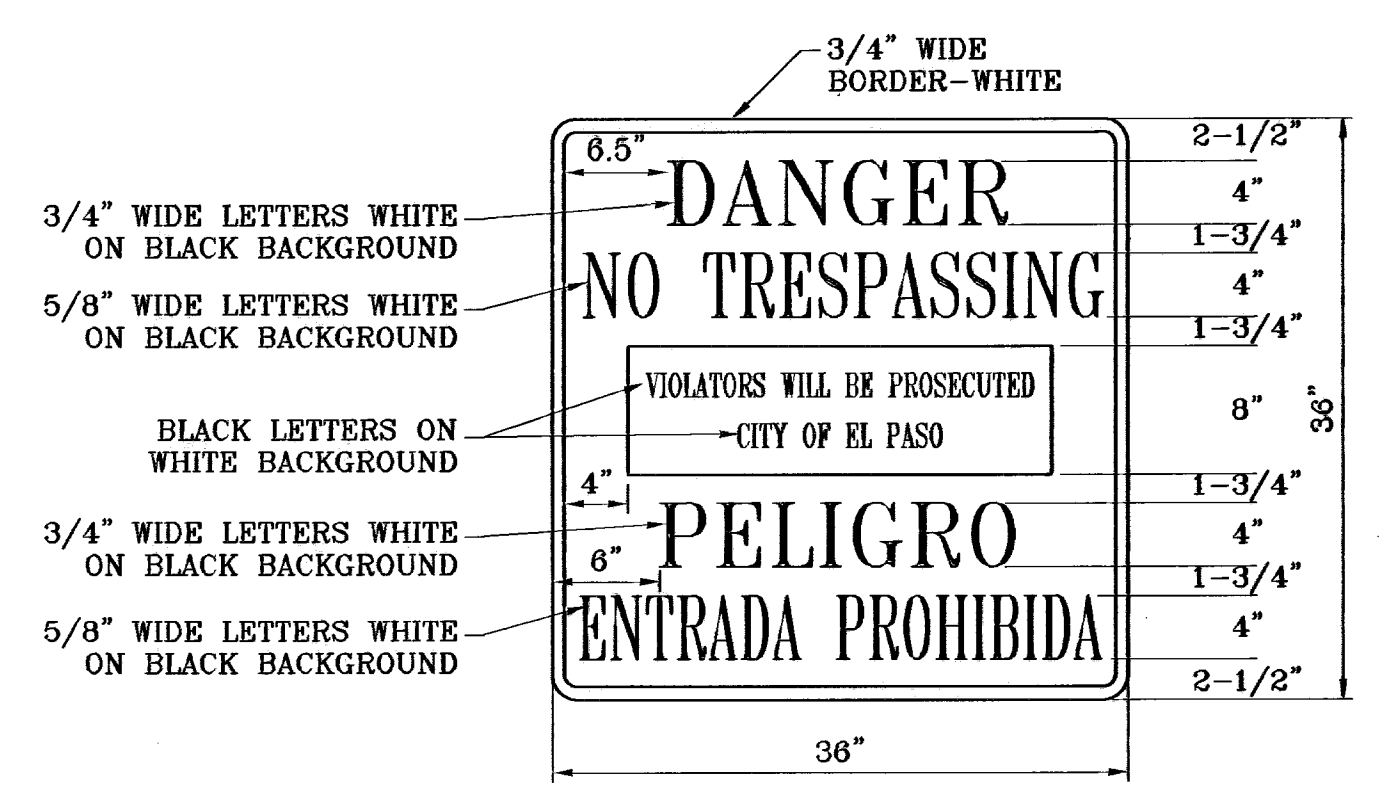


WARNING SIGN DETAIL  
SCALE: 1"=1'

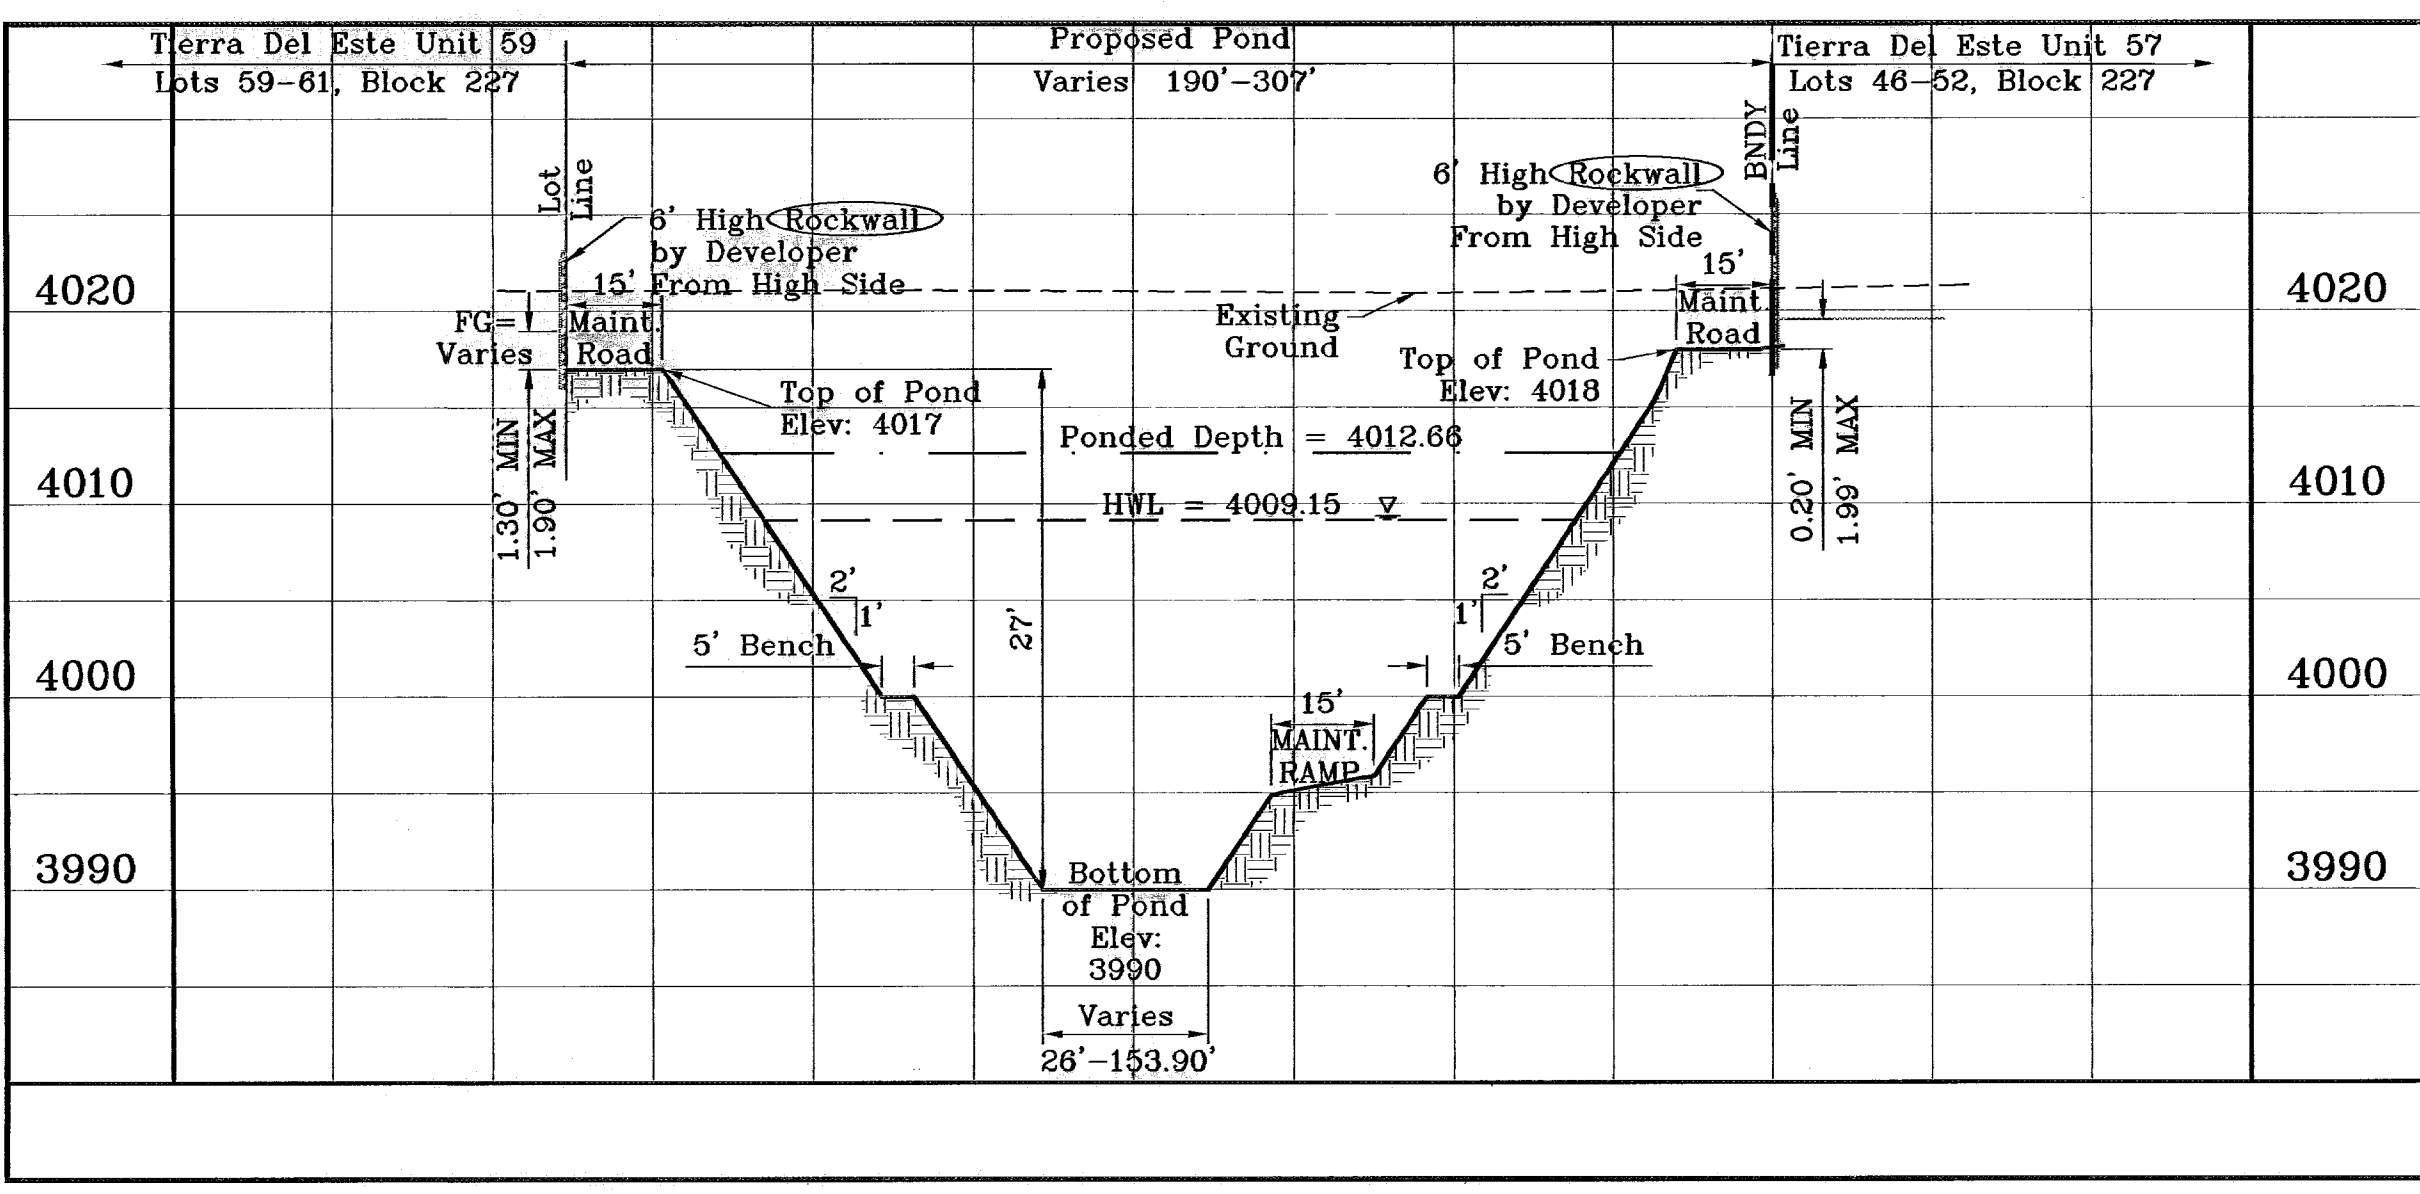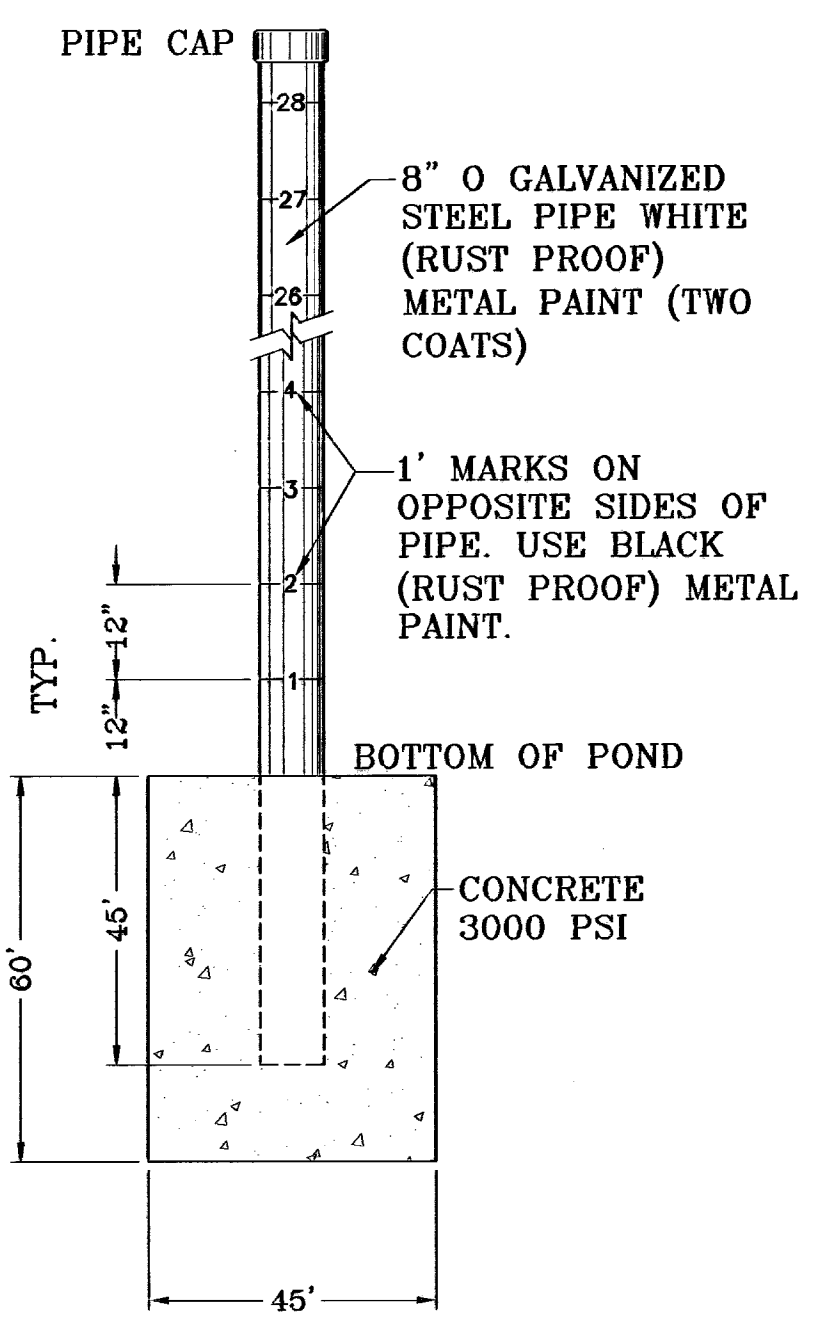

SECTION H  
SCALE: 1"=30' HOR.  
SCALE: 1"=10' VERT.

○ DENOTES AS BUILT CONDITION ONLY

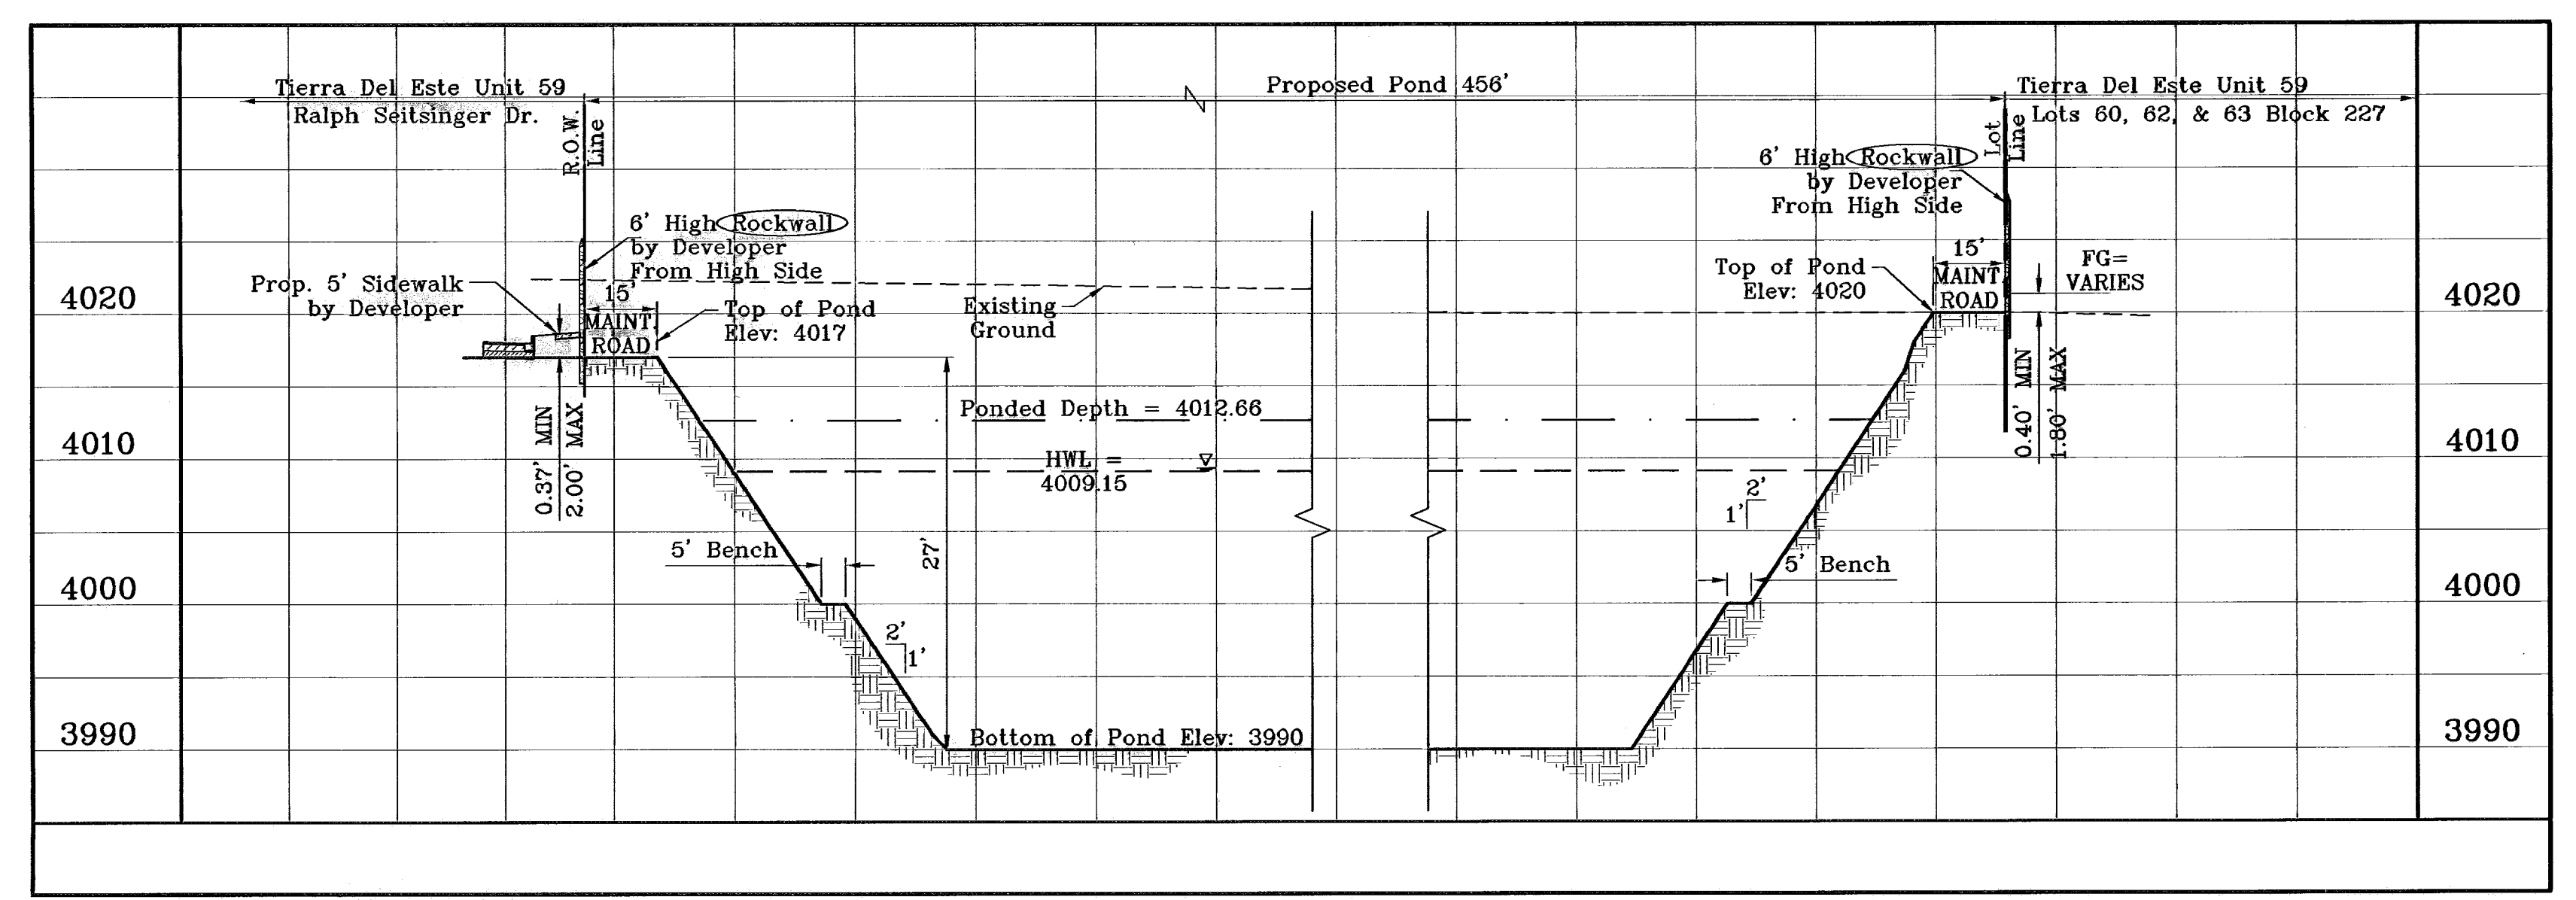

CITY RED LINES BENCHMARK 09/28/09

PROJECT NAME: TIERRA DEL ESTE UNIT FIFTY NINE

SCALE: HORIZ: 1"=30' VERT: 1"=10'

DATE: MAY 2008

DESIGN BY: Y.C.

INITIATED BY: O.M.

CHECKED BY: Y.C.


JOB NO.: 608-23

CONDE INC. ENGINEERING / PLANNING SURVEYING / GPS 1790 LEE TREVINO STE. 400 EL PASO, TEXAS 79936

SHEET TITLE: POND SECTIONS


SHT. 17 OF 24

TIERRA DEL ESTE UNIT FIFTY NINE

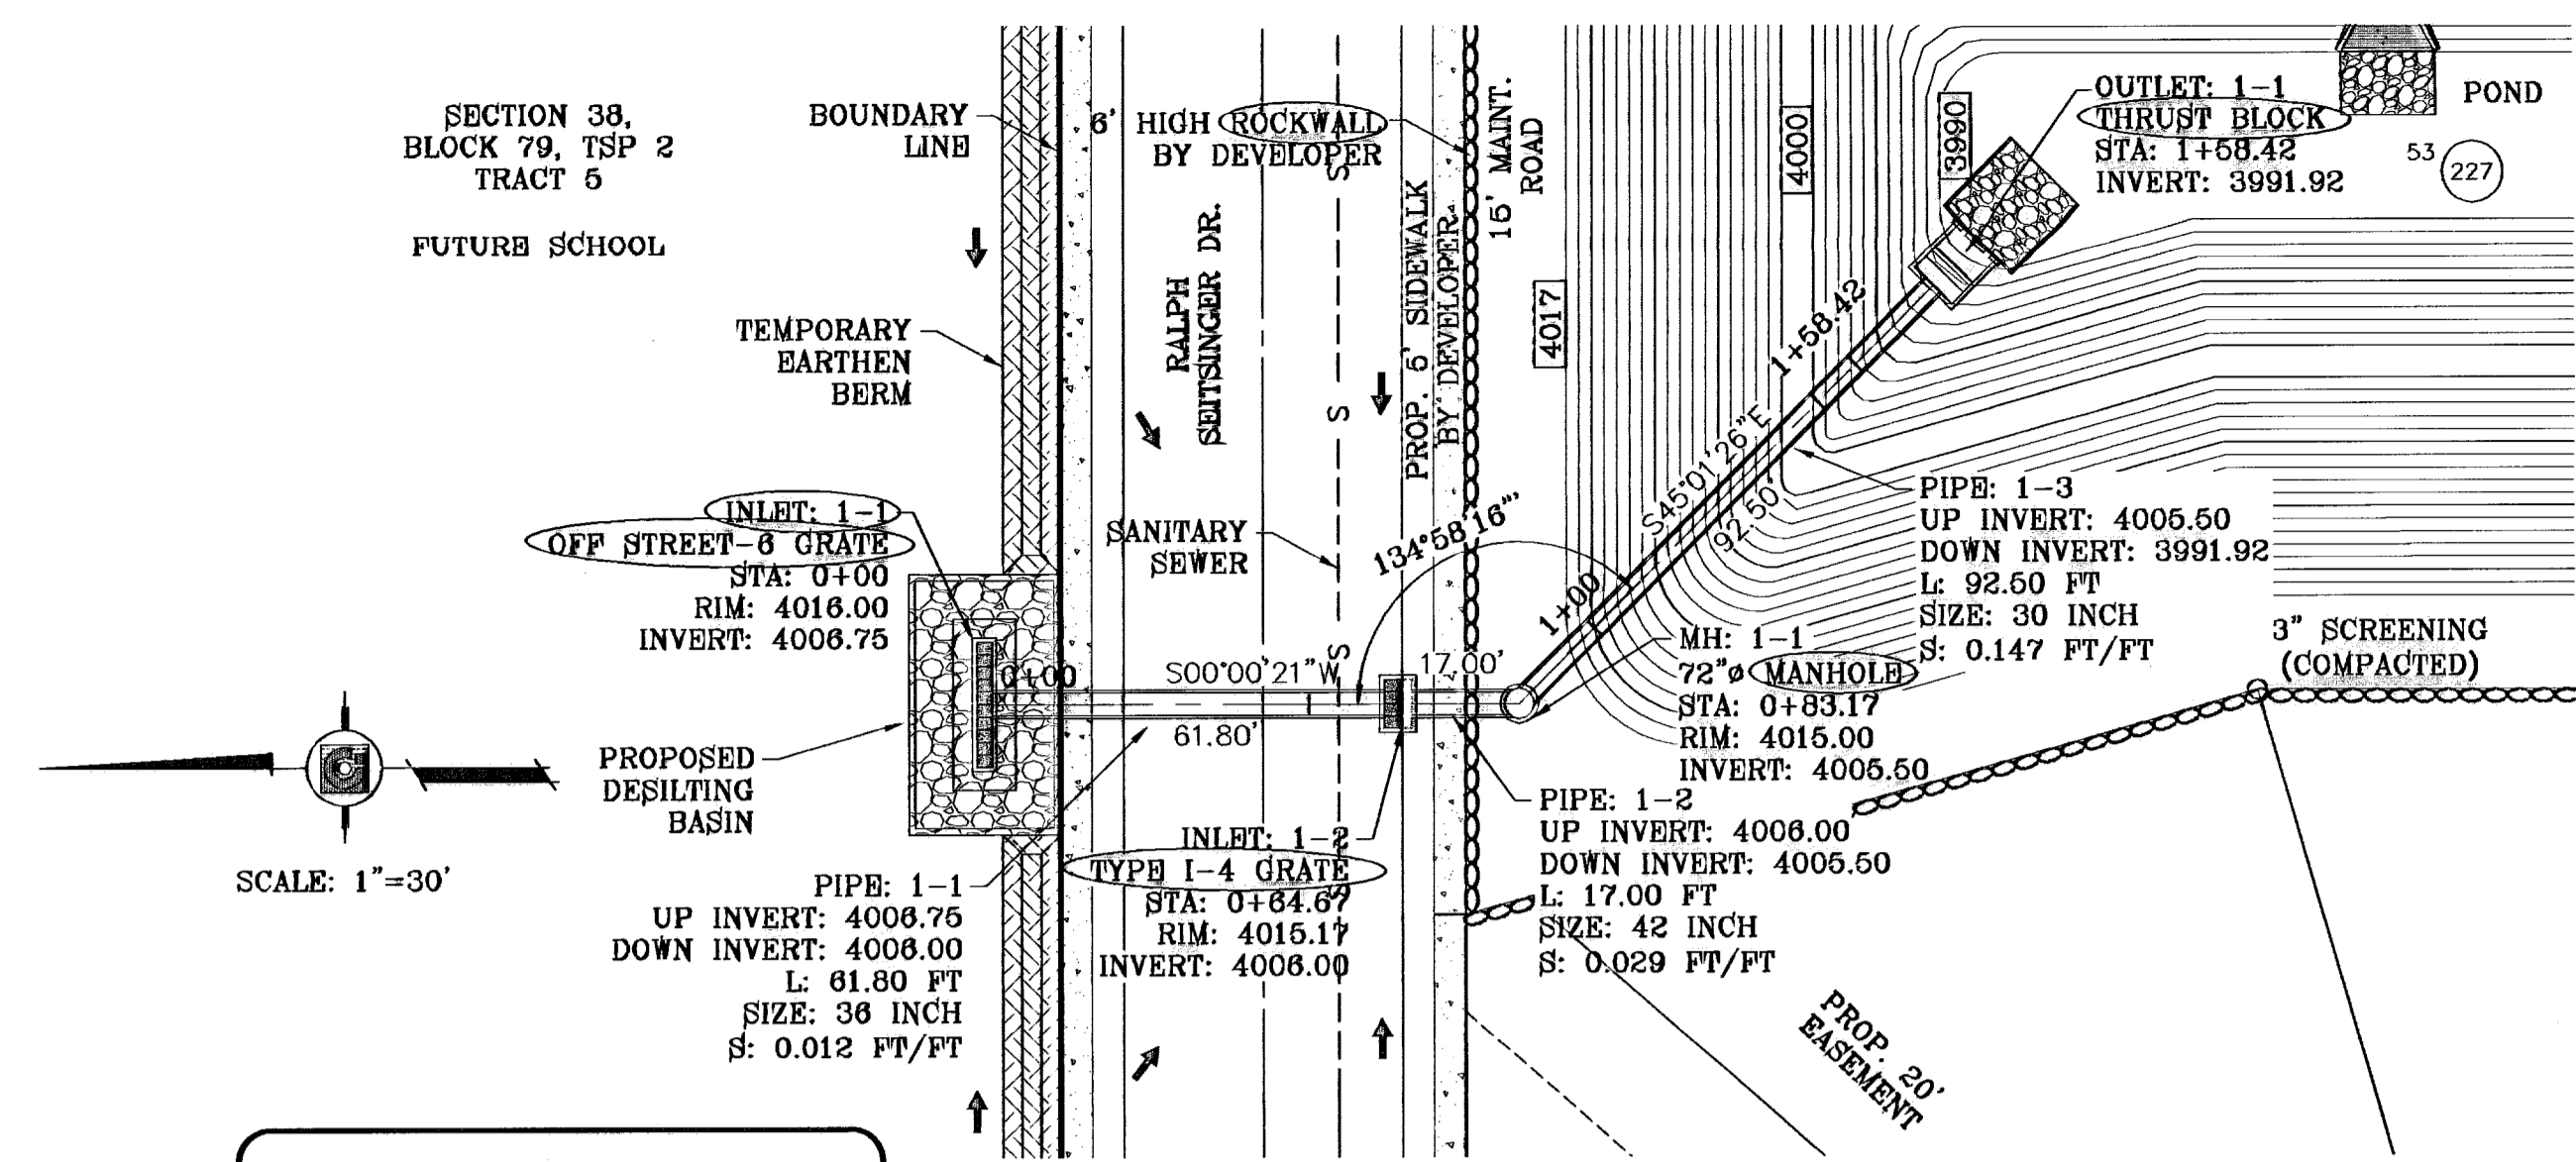

SEE SHEET 6 FOR DESILTING BASIN & BERM DETAILS



STRUCTURE 1-PLAN VIEW  
SCALE: 1"=30'

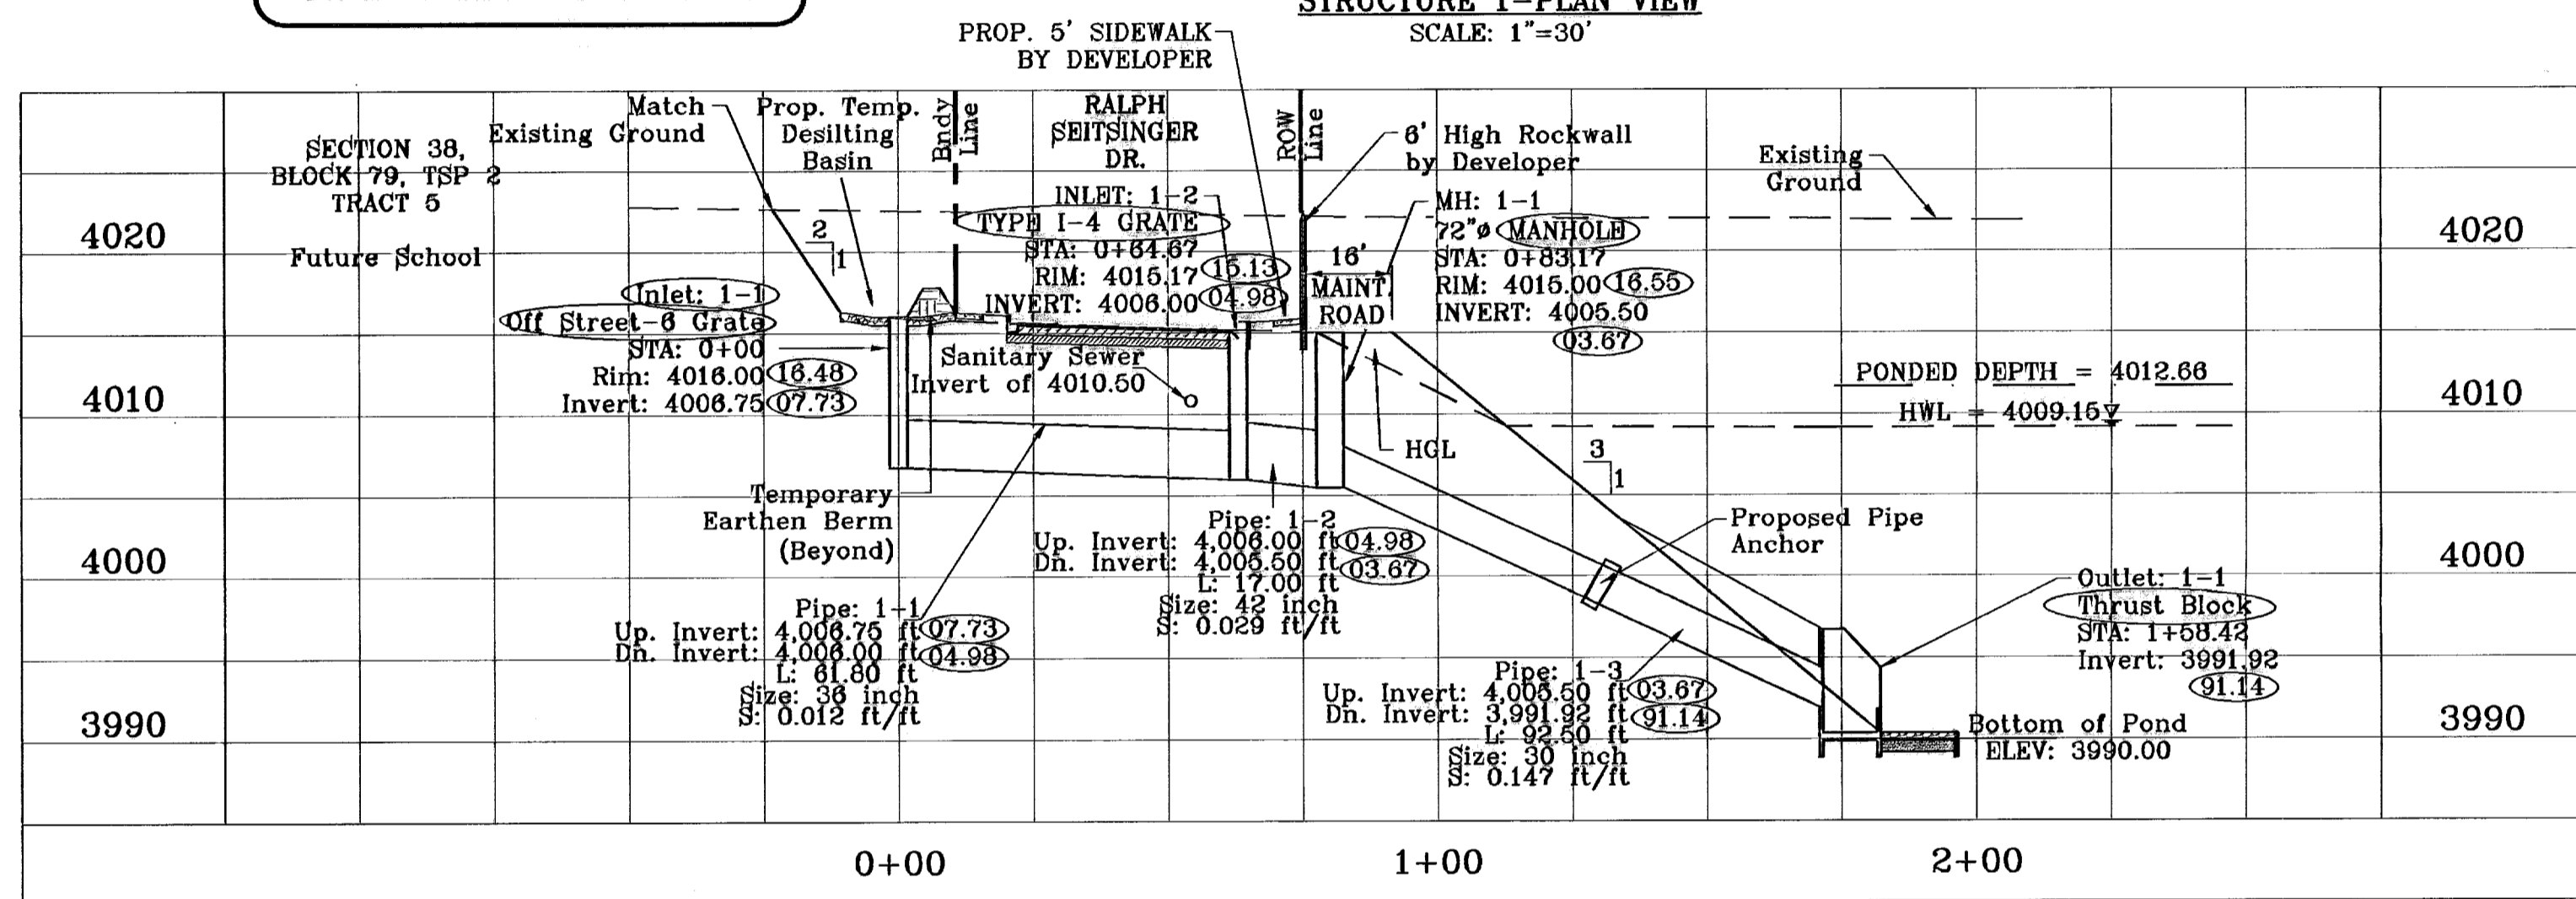

STRUCTURE 1-PROFILE  
SCALE:  
HORIZONTAL: 1"=30'  
VERTICAL: 1"=10'


○ DENOTES AS BUILT CONDITION ONLY

DIA. OF PIPE	A	B	C	D	E	F	G	H	I	J	K	L (MIN.)	M	N
18"	18"	36"	3' 6"	16"	2' 4"	3' 0"	7"	9"	5 1/2"	9"	9"	2"	2' 6"	3"

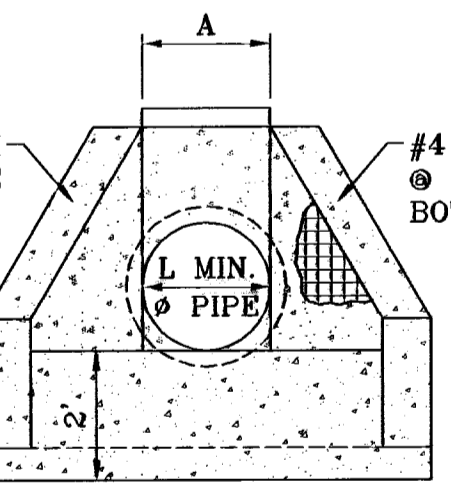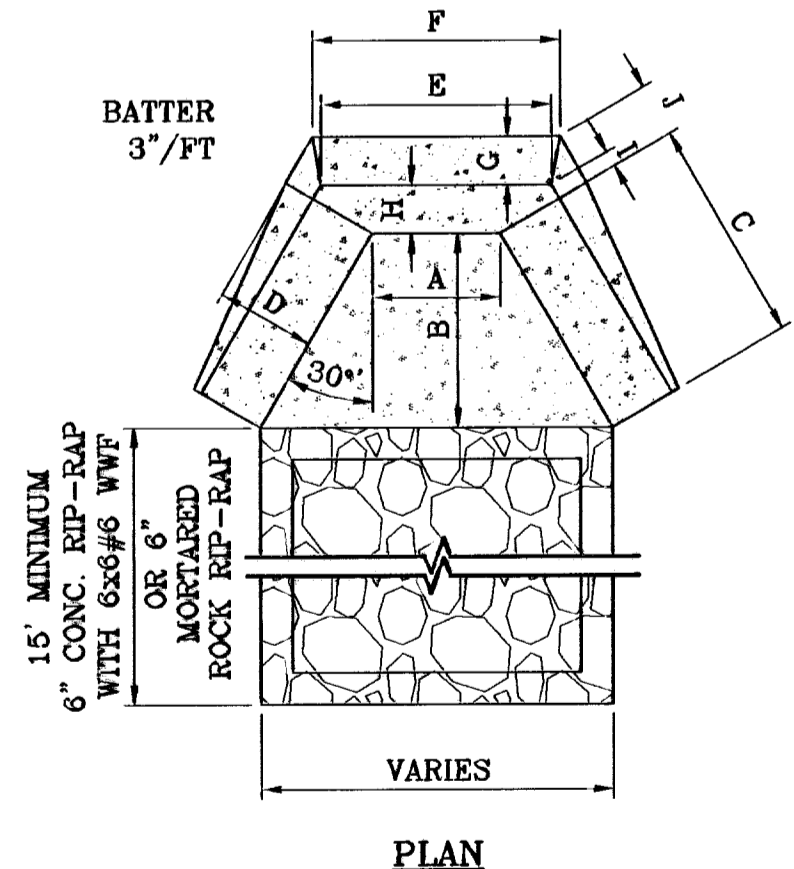


FRONT ELEVATION

HEADWALL DETAIL  
SCALE: 1"=3'

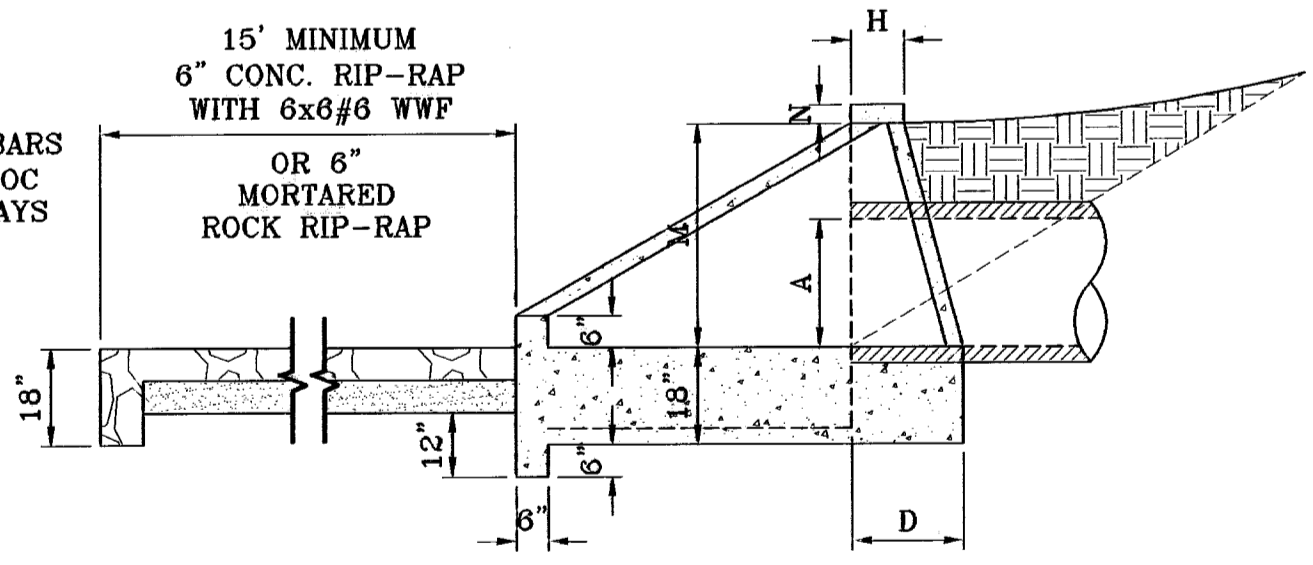

SIDE ELEVATION

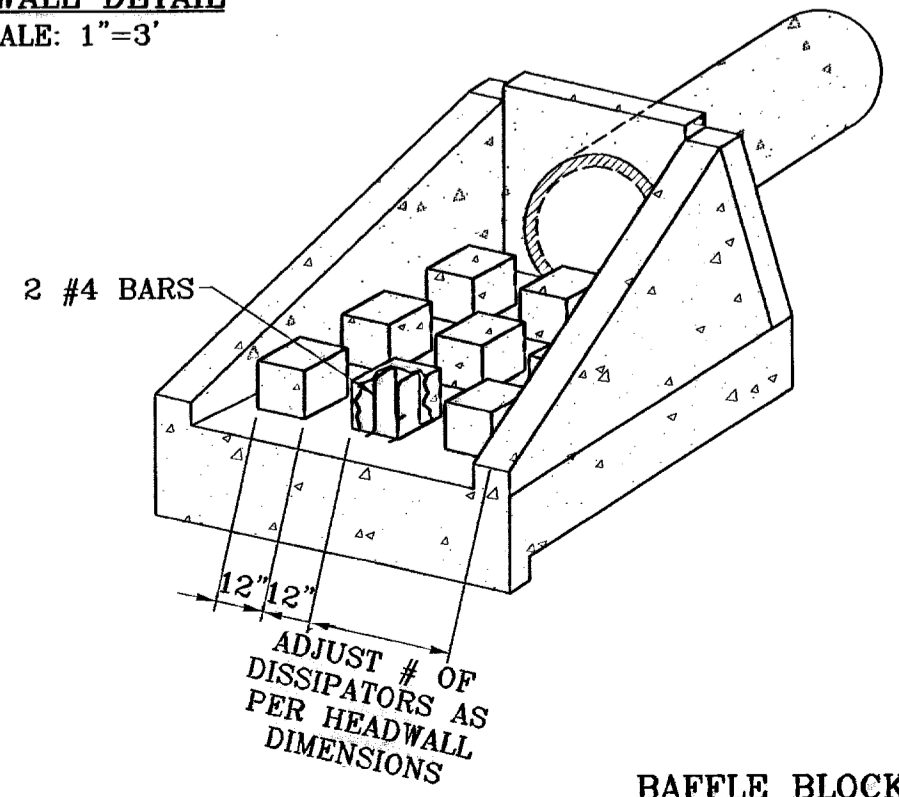

BAFFLE BLOCK DETAIL  
SCALE: 1"=4'

SEE SHEET 19 FOR THRUST BLOCK DETAILS

SEE SHEET 20 FOR MANHOLE DETAILS

R.C.P. PIPE DATA

PIPE	SECTION	SIZE (in)	LENGTH (ft)	CONSTRUCTED SLOPE (ft/ft)	DISCHARGE (cfs)	CAPACITY (cfs)	AVERAGE VELOCITY (fps)	DOWN STREAM GROUND	DOWN STREAM HGL	DOWN STREAM INVERT	UPSTREAM GROUND	UPSTREAM HGL	UPSTREAM INVERT
1-1	36	61.80	0.012	68.92	72.77	9.75	4015.17	4015.17	4008.00	4018.00	4015.84	4008.75	
1-2	42	17.00	0.029	97.26	172.53	10.11	4015.00	4015.00	4005.50	4015.17	4015.16	4006.00	
1-3	30	92.50	0.147	97.26	157.15	19.81	3998.00	4009.15	3991.92	4015.00	4014.35	4005.50	
3-1	24	125.00	0.010	16.50	22.62	7.28	4018.00	4011.45	4010.44	4016.71	4013.15	4011.69	
3-2	18	73.00	0.219	16.50	49.17	9.34	4015.00	4009.15	3990.00	4018.00	4010.95	4008.00	

CONSTRUCTION NOTES:


- ALL CONCRETE FOR STRUCTURES SHALL BE 3000 PSI UNLESS OTHERWISE NOTED.
- MINIMUM COVER FOR REINFORCING STEEL SHALL BE 2" UNLESS OTHERWISE NOTED.
- 95% COMPACTION REQUIRED FOR STRUCTURES AS PER ASTM D1557.
- REINFORCING SHALL CONFORM TO THE REQUIREMENTS OF ASTM A615 GRADE 60.

INLET DATA

INLET No.	INLET TYPE	No. GRATES	Qd cfs	Qc cfs
1-1	OFF. ST.	6	68.92	76.33
1-2	I	4	28.34	43.36
3-1	I	2	16.50	21.68


CLOGGING FACTOR IS EQUAL TO 2/3

ALL PIPES ARE R.C.P. CLASS III UNLESS OTHERWISE NOTED.

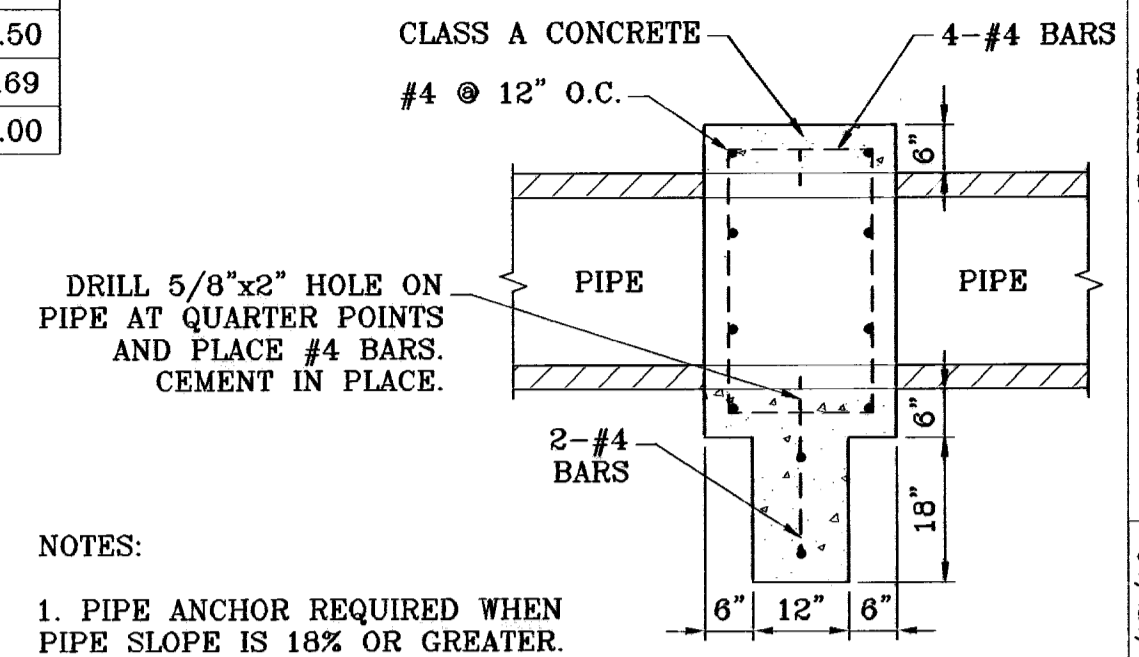


PIPE ANCHOR  
SCALE: 1"=2'

- NOTES:
- PIPE ANCHOR REQUIRED WHEN PIPE SLOPE IS 18% OR GREATER.
  - PIPE ANCHOR TO BE PLACED EVERY 10 VERTICAL FEET.

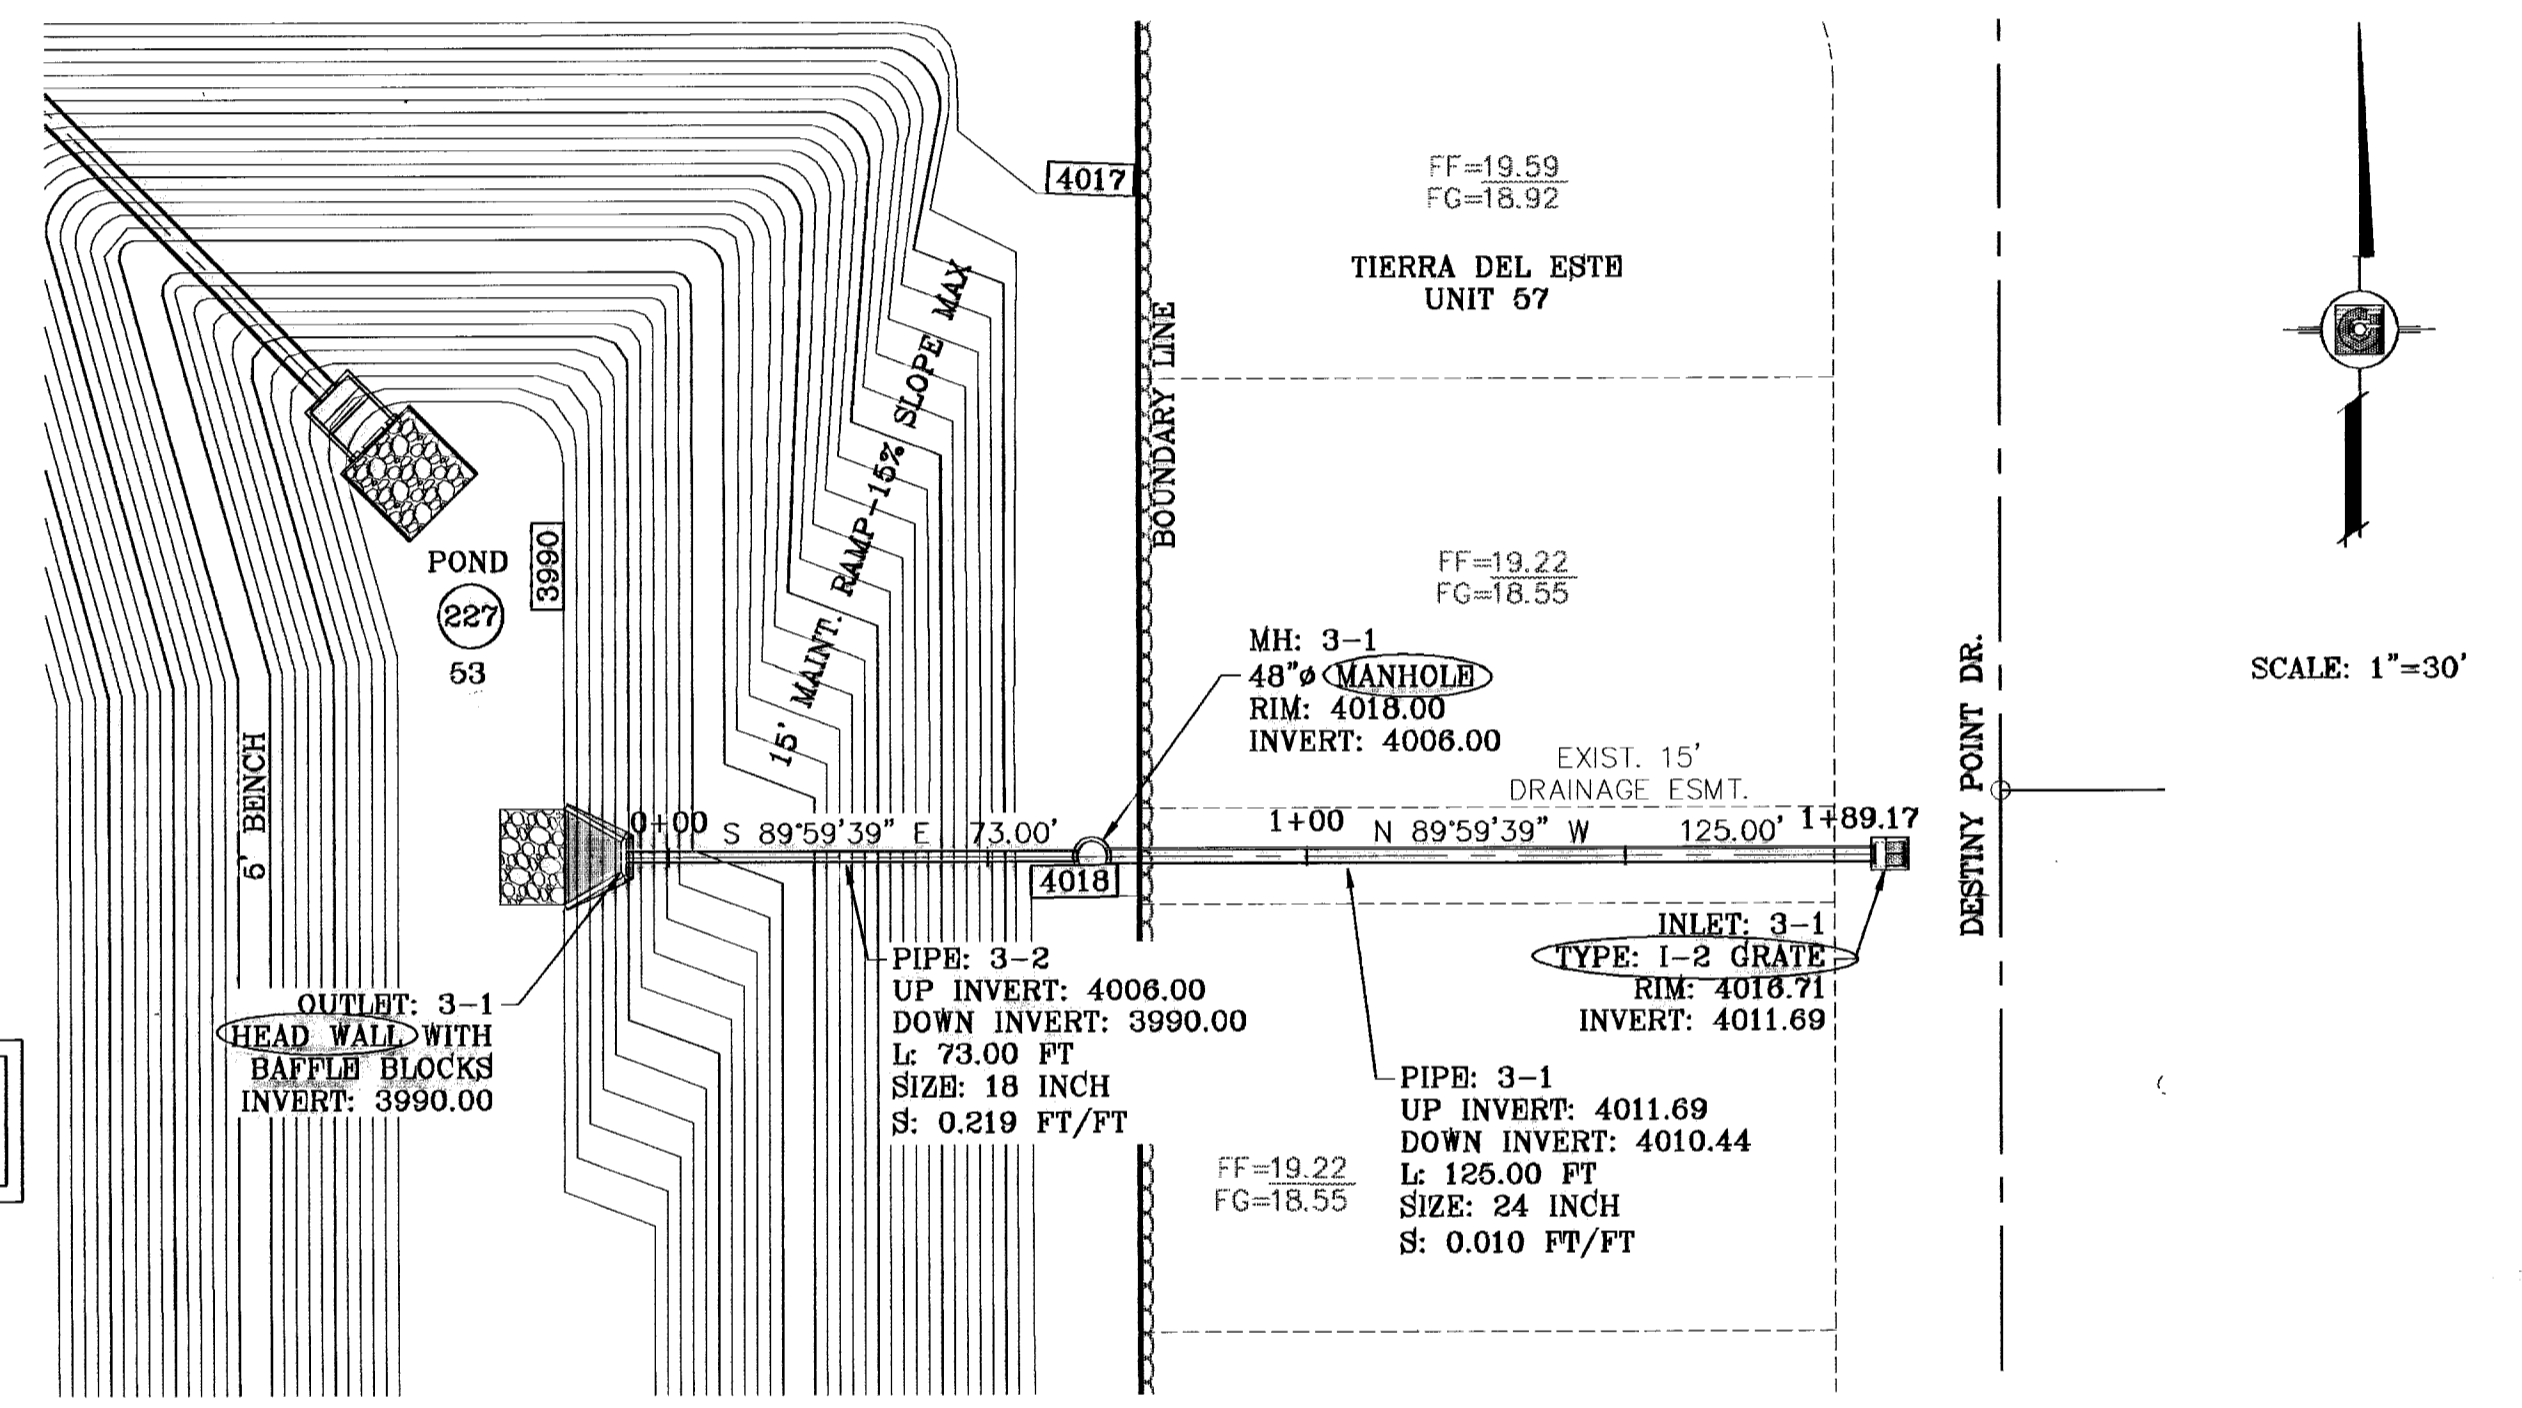

STRUCTURE 3-PLAN VIEW  
SCALE: 1"=30'

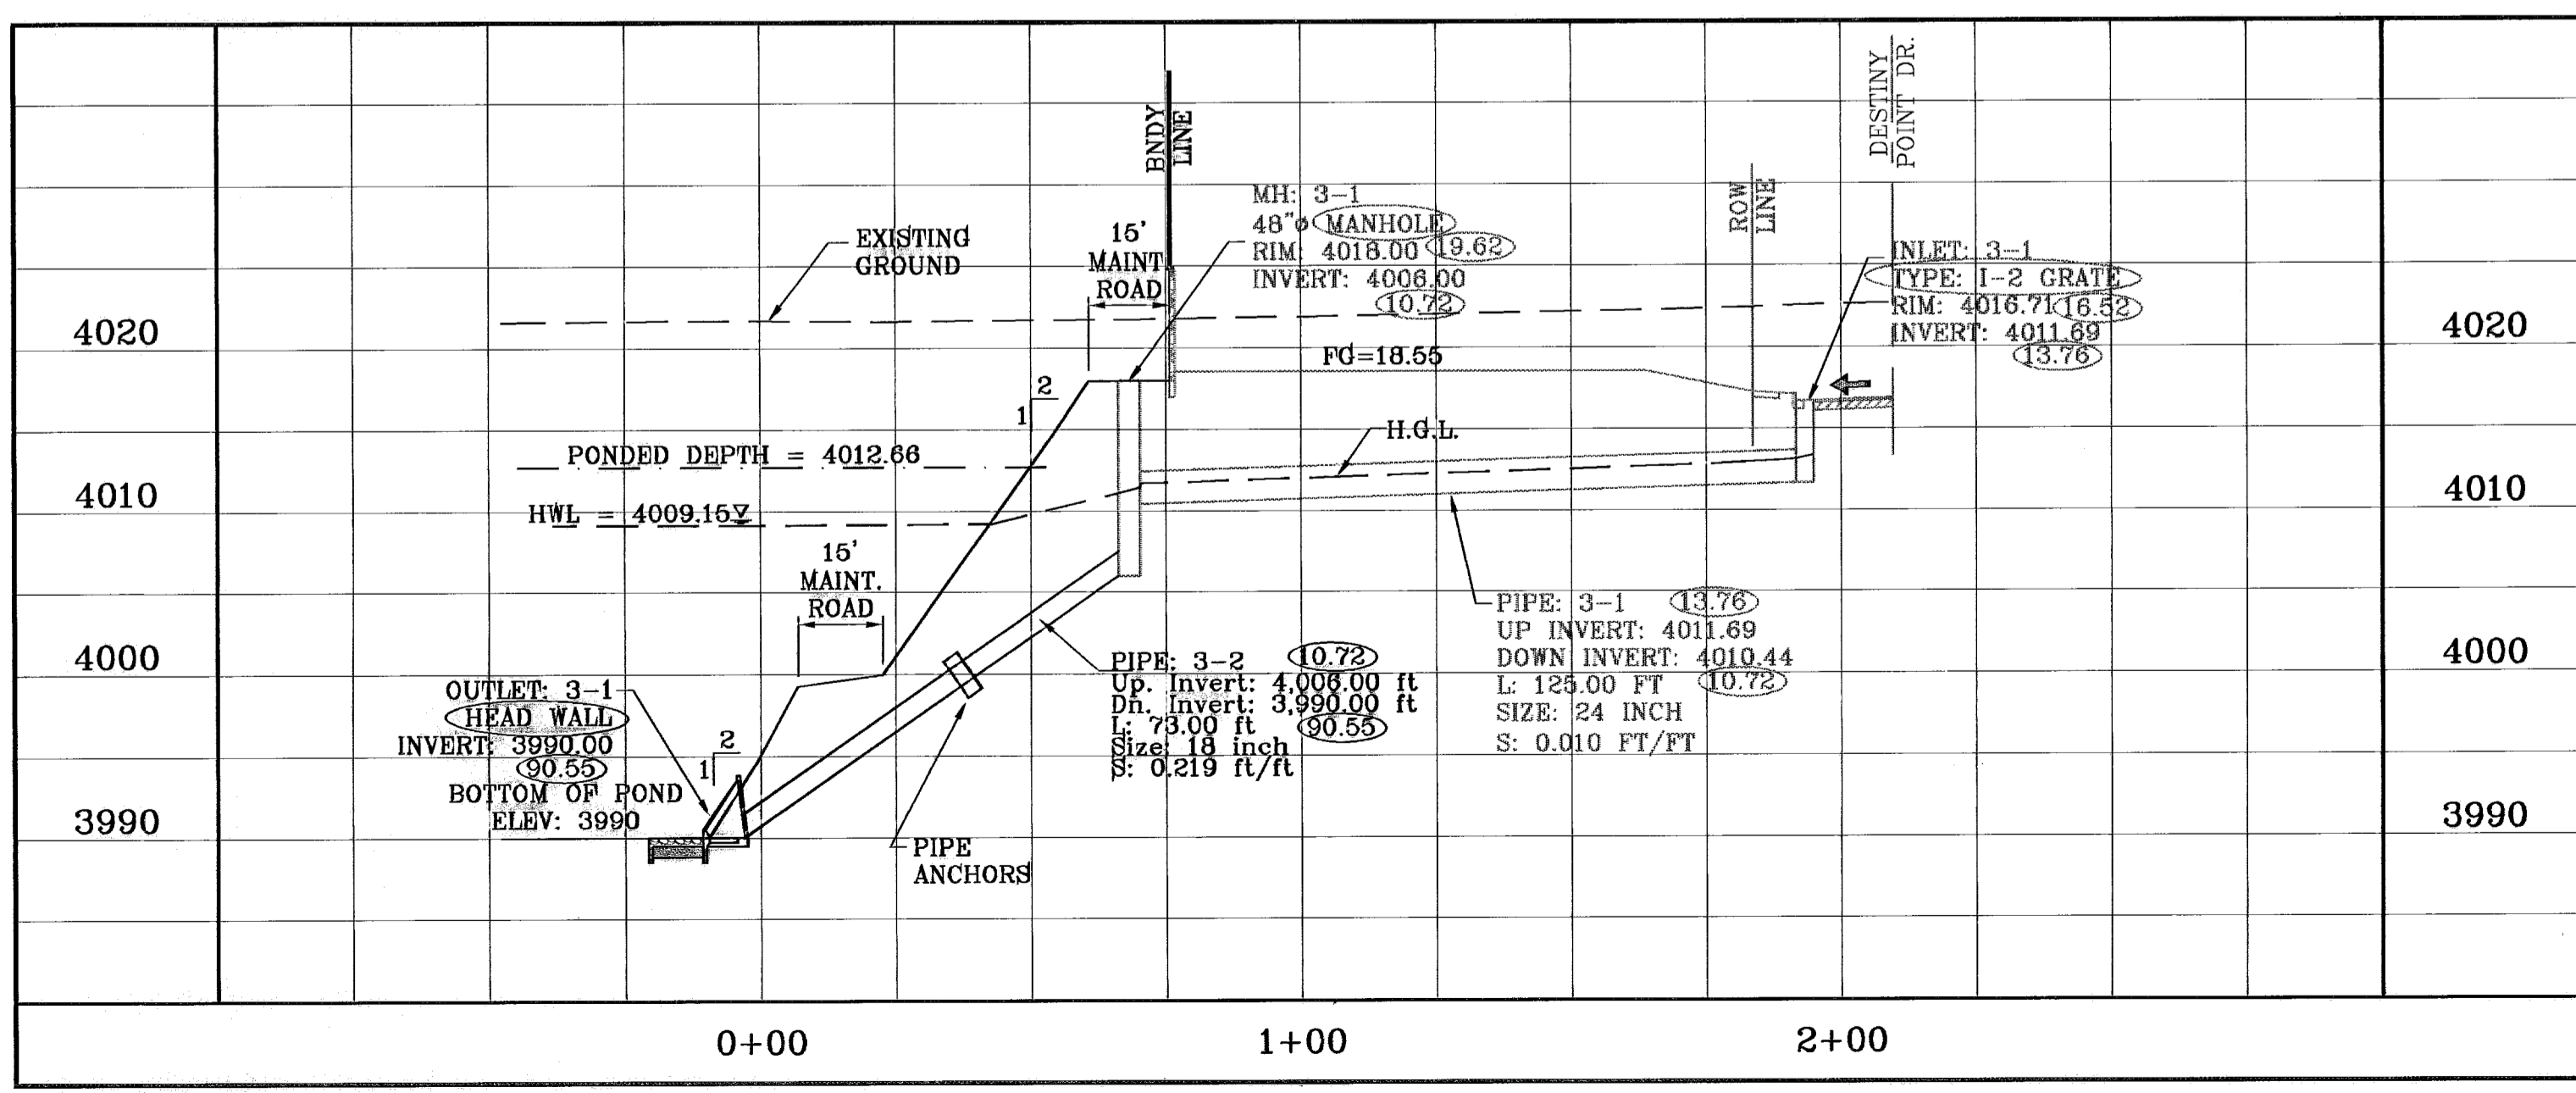

STRUCTURE 3-PROFILE  
SCALE:  
HORIZONTAL: 1"=30'  
VERTICAL: 1"=10'

F.R.	CITY RED LINES	LOT REVISIONS	BENCHMARK
02/17/10			
09/25/09			
06/05/09			

PROJECT NAME  
**TERRA DEL ESTE UNIT FIFTY NINE**

DATE  
12/05/08  
12/16/08  
02/27/08  
03/31/08

REVISIONS  
BY  
E.F.G. COMMENTS  
E.F.G. COMMENTS  
E.F.G. COMMENTS  
E.F.G. COMMENTS

REVISION TO PER 11/26/08 COMMENTS  
REVISION TO PER 12/16/08 COMMENTS  
REVISION TO PER 02/27/08 COMMENTS  
REVISION TO STRUCTURE #1

NGS MARKER: COPPER-CLAD STEEL ROD  
DESIGNATED X.1118 P.D. '0041'  
ELEVATION: 387.12

BEING A PORTION OF SECTION 38, BLOCK 79, TOWNSHIP 2, TEXAS AND PACIFIC RAILROAD COMPANY SURVEYS, CITY OF EL PASO, EL PASO COUNTY, TEXAS, CITY OF CONTAINING 26.969 ACRES

SCALE  
HORIZ: 1"=30'  
VERT: 1"=10'

DATE: MAY 2008

DESIGN BY: Y.C.

CHECKED BY: O.M.

QUANTIFIED BY: Y.C.


JOBS NO.: 608-23

ENGINEER'S SEAL

CONDE INC.  
ENGINEERING / PLANNING  
SURVEYING / GPS  
1700 LEE TRAVINO STE 400  
EL PASO, TEXAS 79906



SHEET TITLE  
**DRAINAGE STRUCTURE #1 & #3**

SHT 18 OF 24

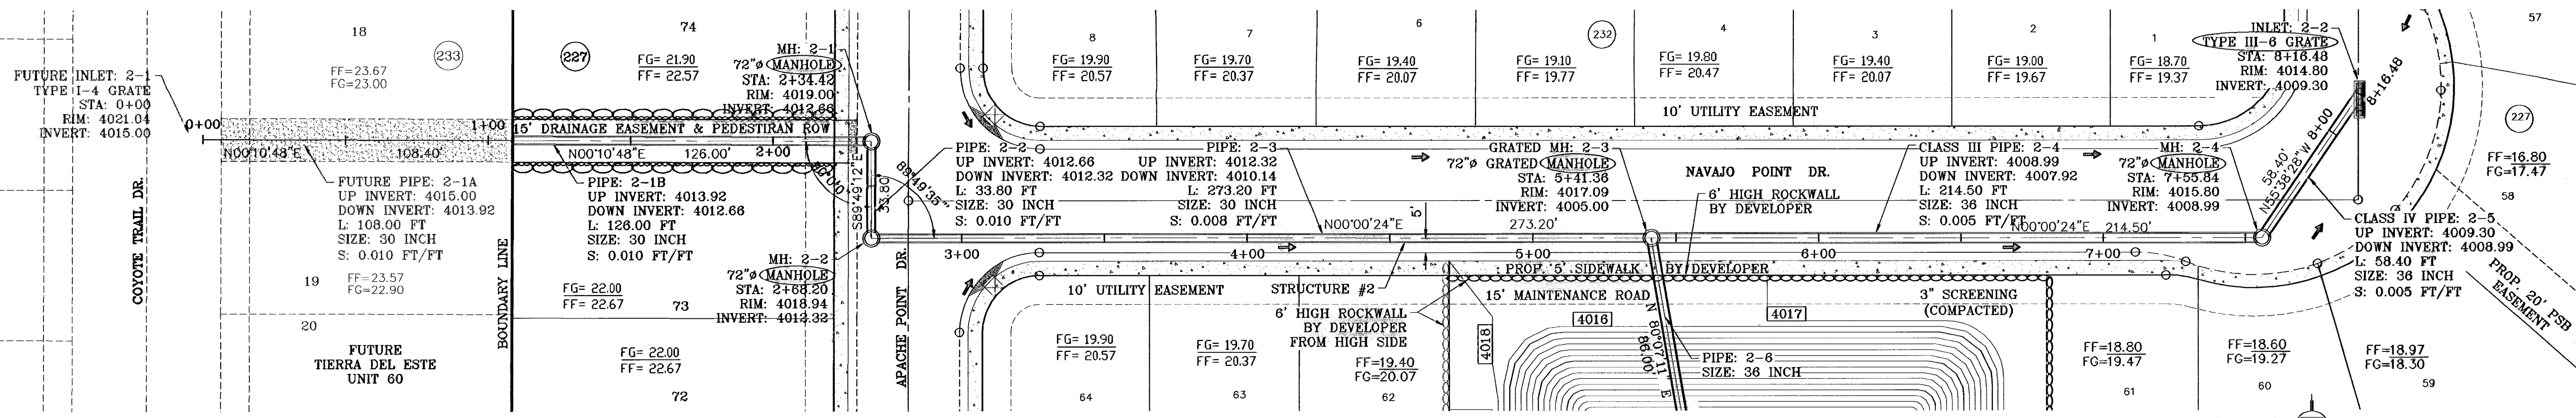

STRUCTURE 2-PLAN VIEW  
SCALE: 1"=30'

SEE SHEET 18 FOR  
STRUCTURE #1 DETAILS

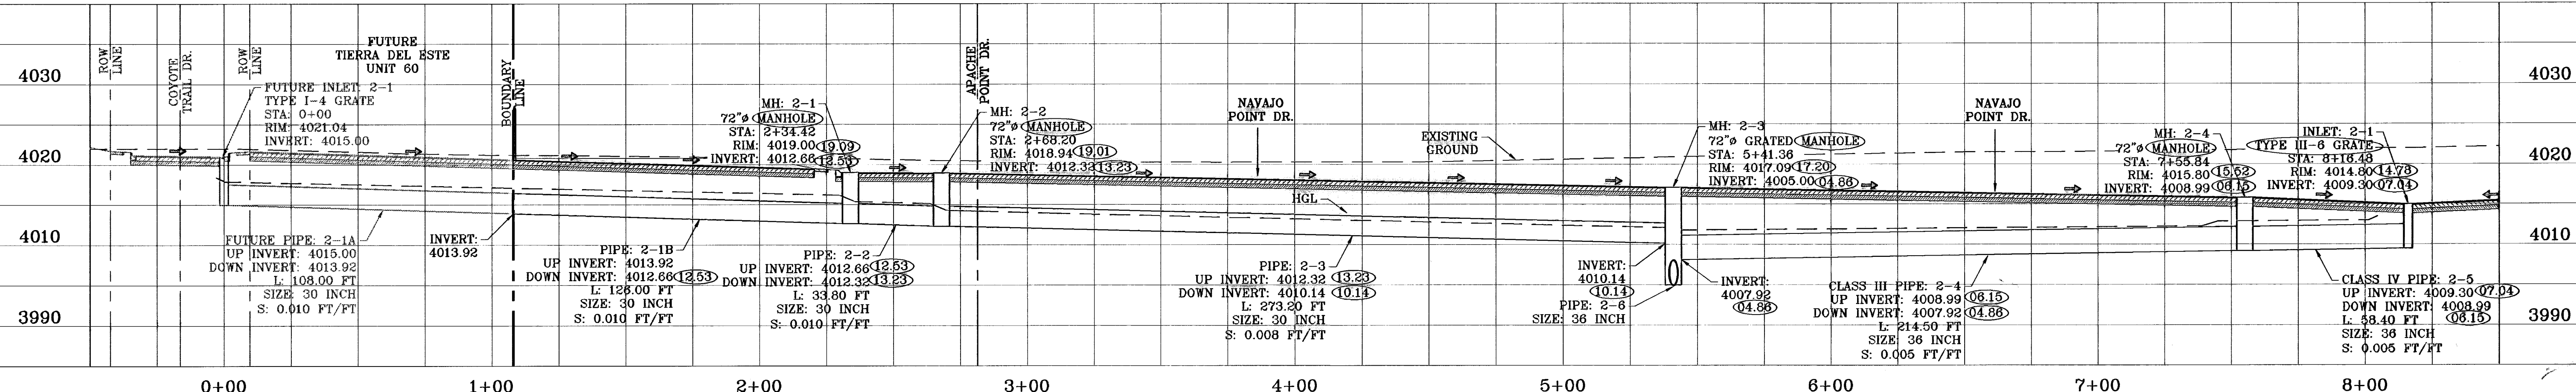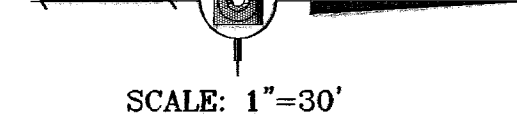

STRUCTURE 2-PERFILE  
SCALE: 1"=10'

R.C.P. PIPE DATA

PIPE	SECTION SIZE (in)	LENGTH (ft)	CONSTRUCTED SLOPE (ft/ft)	DISCHARGE (cfs)	CAPACITY (cfs)	AVERAGE VELOCITY (fps)	DOWN STREAM GROUND	DOWN STREAM HGL	DOWN STREAM INVERT	UPSTREAM GROUND	UPSTREAM HGL	UPSTREAM INVERT
2-1	30	234.40	0.010	34.74	40.98	7.08	4019.00	4018.41	4012.66	4021.04	4017.85	4015.00
2-2	30	33.80	0.010	34.74	41.14	7.08	4018.94	4015.12	4012.32	4019.00	4015.81	4012.66
2-3	30	273.20	0.008	34.74	36.65	7.08	4017.09	4010.80	4010.14	4018.94	4014.32	4012.32
2-4	36	214.50	0.005	32.42	47.11	5.43	4017.09	4010.80	4007.92	4015.80	4011.51	4008.99
2-5	36	58.40	0.005	32.42	48.59	5.07	4015.80	4011.87	4008.99	4014.80	4011.73	4009.30
2-6	36	86.00	0.157	73.76	264.25	10.43	4015.00	4009.15	3991.50	4017.09	4010.20	4005.00

INLET DATA

INLET No.	INLET TYPE	No. GRATES	Qd cfs	Qc cfs
2-1	I	4	34.74	43.36
2-2	III	6	32.42	46.32

CLOGGING FACTOR IS EQUAL TO 2/3


ALL PIPES ARE R.C.P. CLASS III UNLESS OTHERWISE NOTED.

CONSTRUCTION NOTES:

1. ALL CONCRETE FOR STRUCTURES SHALL BE 3000 PSL. UNLESS OTHERWISE NOTED.
2. MINIMUM COVER FOR REINFORCING STEEL SHALL BE 2" UNLESS OTHERWISE NOTED.
3. 95% COMPACTION REQUIRED FOR STRUCTURES AS PER ASTM D1557.
4. REINFORCING SHALL CONFORM TO THE REQUIREMENTS OF ASTM A615 GRADE 60.


GENERAL NOTES:

1. MATCHING SURFACES MARKED "MF" TO BE MACHINE FINISHED OF ANY IRREGULARITIES THAT WOULD PREVENT A SNUG FIT.
2. CASTING TO BE SMOOTH & VOID OF AIR HOLES.
3. THIS MANHOLE COVER FITS IN A STANDARD MANHOLE RING.

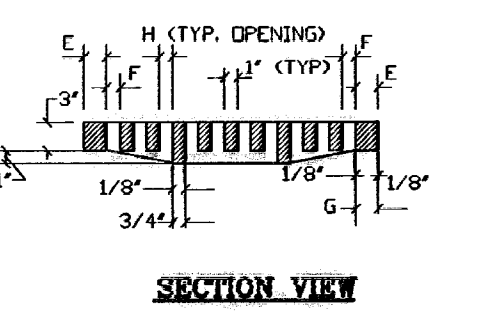

SECTION VIEW

MANHOLE COVER	48"	72"
WEIGHT	175 LBS	310 LBS
A	1'-11 3/4"	2'-7 1/4"
B	4 1/2"	7"
C	6"	8"
D	1 1/2"	3 3/8"
E	1 3/8"	1 3/8"

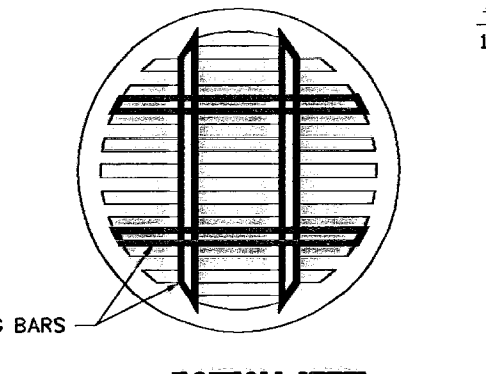


BOTTOM VIEW




YARD DRAIN SECTION (YD)  
SCALE: NTS

SEE SHEET 20 FOR  
MANHOLE DETAILS


DENOTES AS BUILT CONDITION ONLY

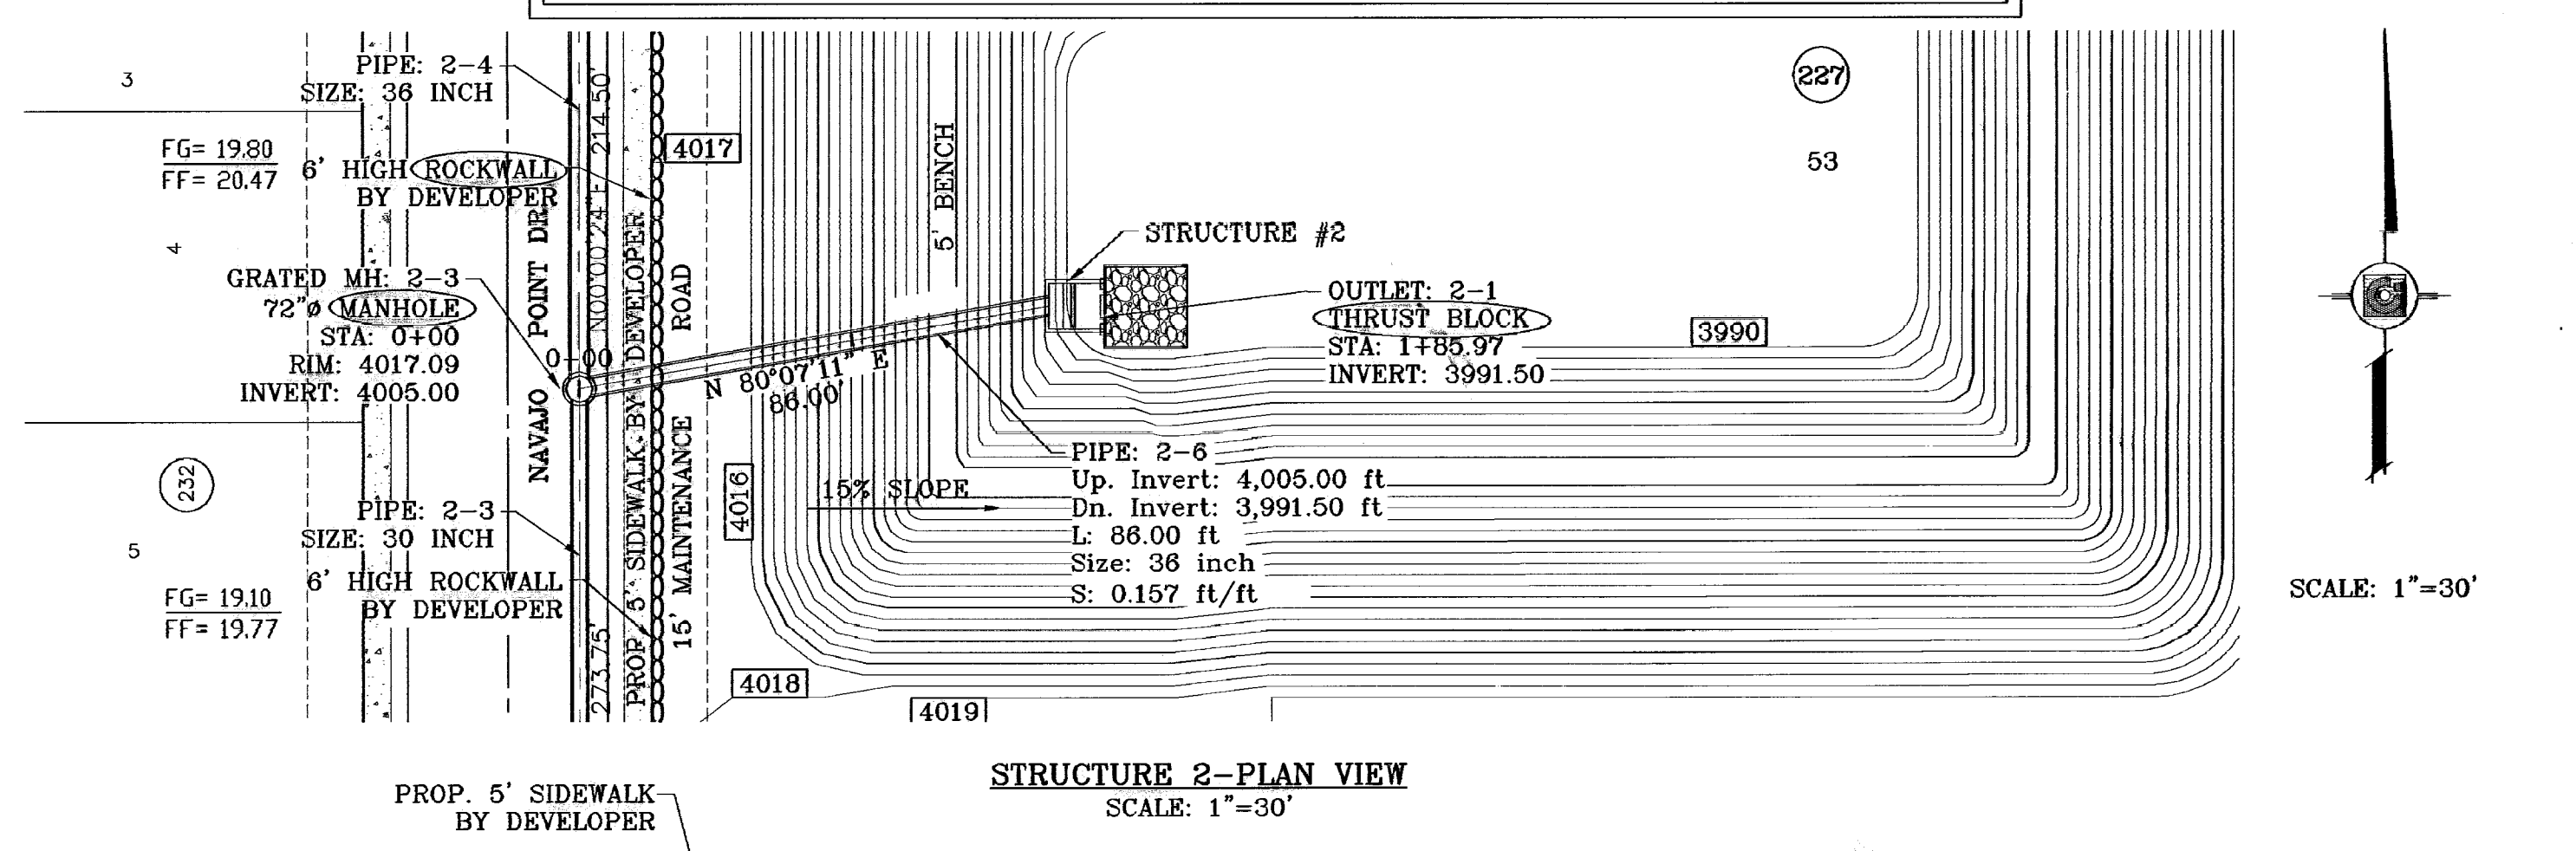

STRUCTURE 2-PLAN VIEW  
SCALE: 1"=30'

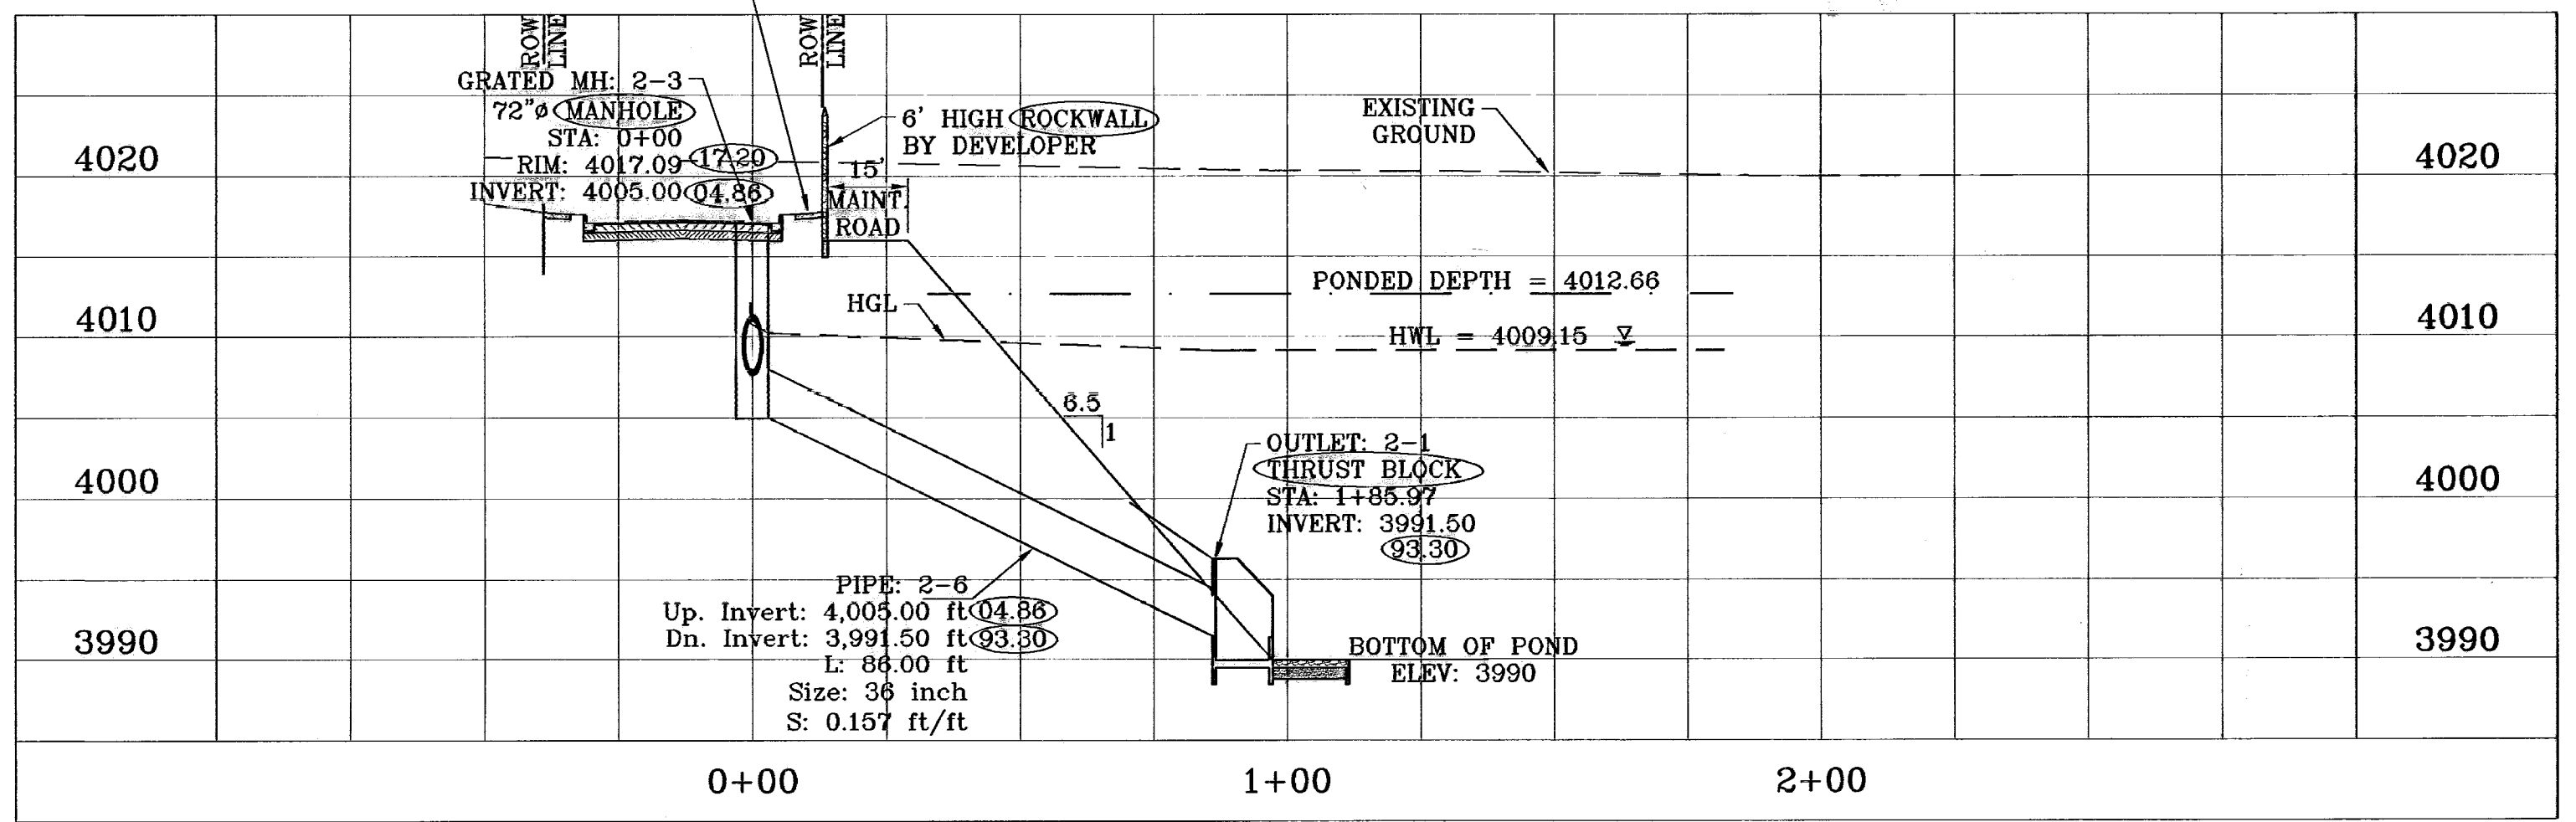

STRUCTURE 2-PERFILE  
SCALE: 1"=10'

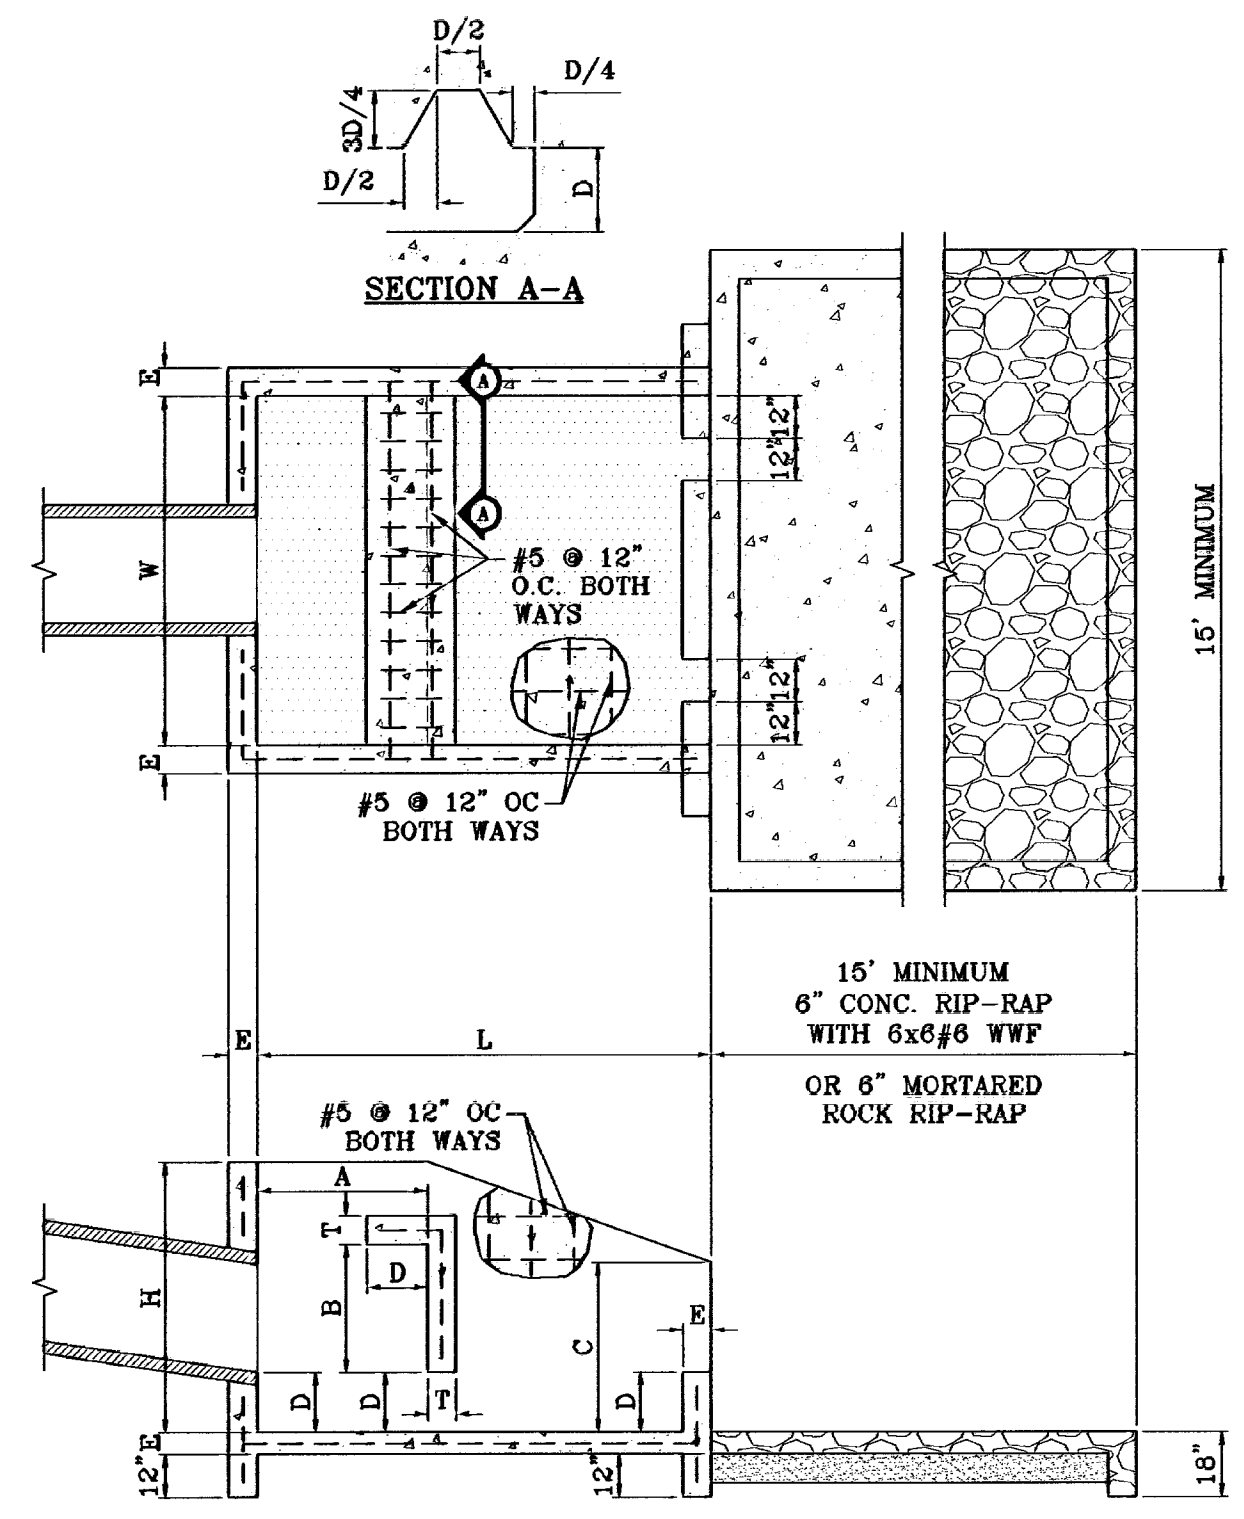

THRUST BLOCK DETAIL  
SCALE: 1"=4"

PIPE Ø	H	L	A	B	C	D	E	T	W
30" RCP	5'3"	9'4"	3'8"	2'8"	3'8"	1'2"	0'7"	0'7"	7'0"
36" RCP	3'9"	6'8"	2'8"	1'11"	2'8"	0'10"	0'5"	0'5"	5'0"

F.R.	R.R.
02/17/10	06/28/09

AS BUILT  
CITY RED LINES  
BENCHMARK

NGS MARKER: COPPER-CLAD STEEL ROD  
DESIGNATED "X 1118" PID "CD041"  
ELEVATION: 3897.12

DATE	BY	REVISIONS
12/05/08	CITY	REVISIONS AS PER 11/28/08 COMMENTS E.F.G.
12/19/08	CITY	REVISIONS AS PER 12/19/08 COMMENTS E.F.G.
06/09/09	CITY	CHANGES MADE DUE TO REVISED PLAT
06/09/09	CITY	LOT REVISIONS

PROJECT NAME  
**TERRA DEL ESTE  
UNIT FIFTY NINE**

BEING A PORTION OF SECTION 38, BLOCK 79, TOWNSHIP 2,  
TEXAS AND PACIFIC RAILROAD COMPANY SURVEY,  
CITY OF EL PASO, EL PASO COUNTY, TEXAS,  
CONTAINING 26.969 ACRES

SCALE  
HORIZ: 1"=30'  
VERT: 1"=10'


DATE: MAY 2008  
DESIGN BY: Y.C.  
INITIATED BY: O.M.  
CHECKED BY: Y.C.  
JOB NO.: 608-23

ENGINEER'S SEAL

**CONDE INC.**  
ENGINEERING / PLANNING  
SURVEYING / GPS  
1700 LEE TREVINO STE 400  
EL PASO, TEXAS 79968

SHEET TITLE  
**DRAINAGE  
STRUCTURE #2**


SHT 19 OF 24

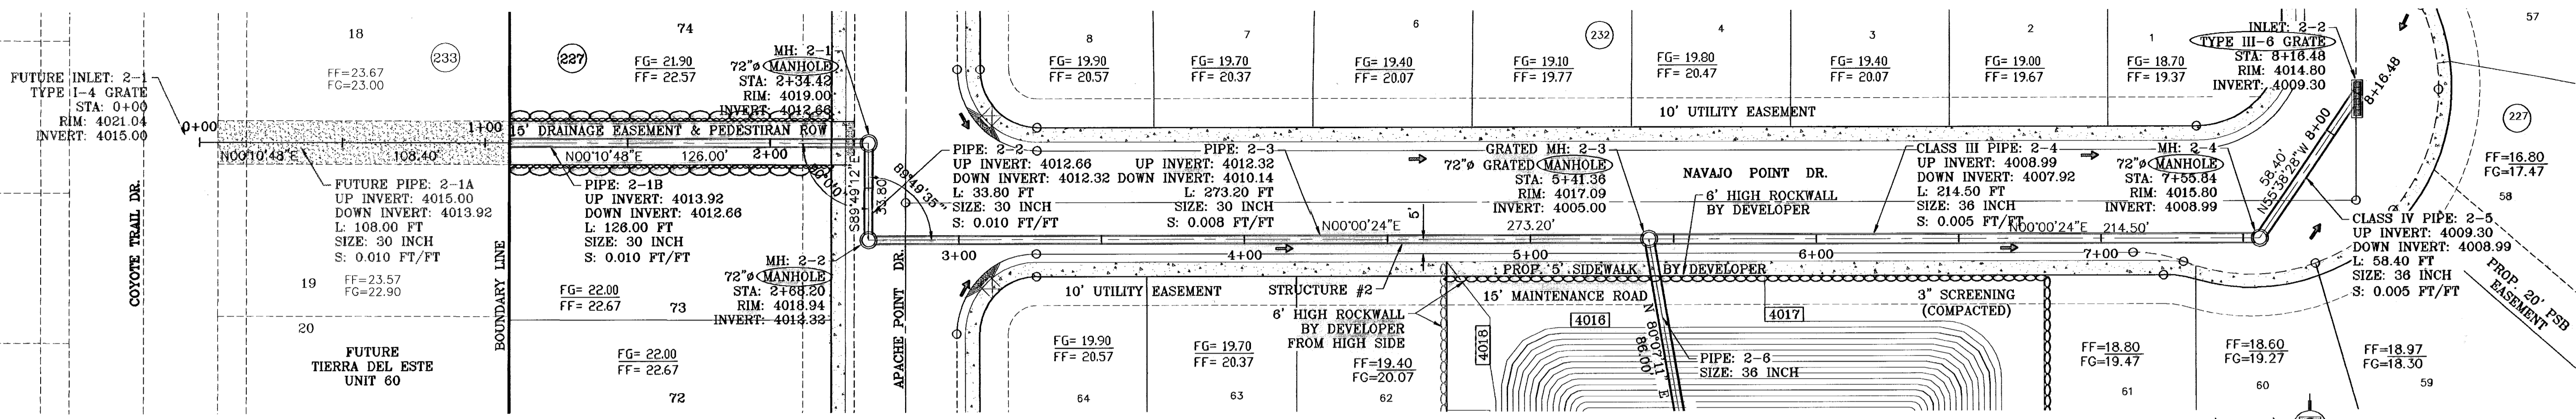

STRUCTURE 2-PLAN VIEW  
SCALE: 1"=30'

SEE SHEET 18 FOR  
STRUCTURE #1 DETAILS

SCALE: 1"=30'

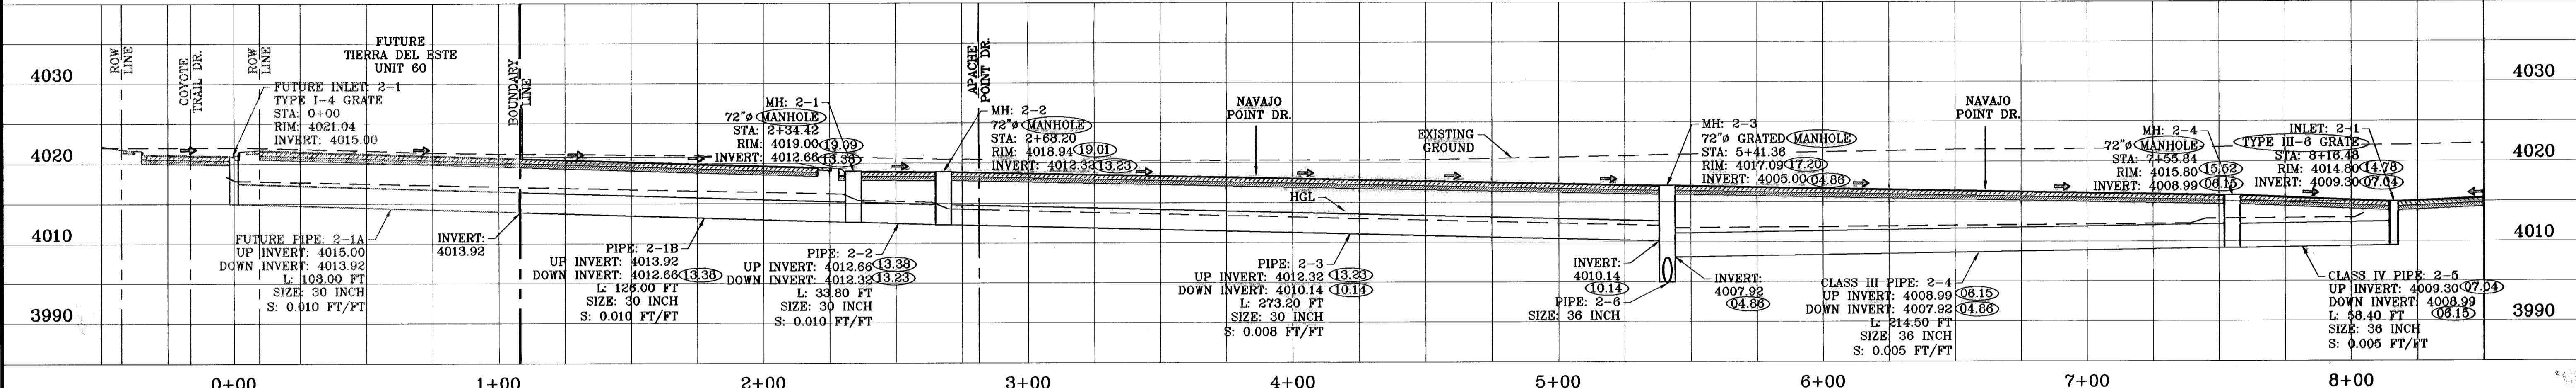

STRUCTURE 2-PROFILE  
SCALE: 1"=10'

DENOTES AS BUILT CONDITION ONLY

SCALE: 1"=30'

R.C.P. PIPE DATA

PIPE	SECTION SIZE (in)	LENGTH (ft)	CONSTRUCTED SLOPE (ft/ft)	DISCHARGE (cfs)	CAPACITY (cfs)	AVERAGE VELOCITY (fps)	DOWN STREAM GROUND	DOWN STREAM HGL	DOWN STREAM INVERT	UPSTREAM GROUND	UPSTREAM HGL	UPSTREAM INVERT
2-1	30	234.40	0.010	34.74	40.98	7.08	4019.00	4018.41	4012.66	4021.04	4017.85	4015.00
2-2	30	33.80	0.010	34.74	41.14	7.08	4018.94	4015.12	4012.32	4019.00	4015.81	4012.66
2-3	30	273.20	0.008	34.74	36.65	7.08	4017.09	4010.80	4010.14	4018.94	4014.32	4012.32
2-4	36	214.50	0.005	32.42	47.11	5.43	4017.09	4010.80	4007.92	4015.80	4011.51	4008.99
2-5	36	58.40	0.005	32.42	48.59	5.07	4015.80	4011.67	4008.99	4014.80	4011.73	4009.30
2-6	36	88.00	0.157	73.76	264.25	10.43	4015.00	4009.15	3991.50	4017.09	4010.20	4005.00

INLET DATA

INLET No.	INLET TYPE	No. GRATES	Qd cfs	Qc cfs
2-1	I	4	34.74	43.38
2-2	III	6	32.42	46.32

CLOGGING FACTOR IS EQUAL TO 2/3


ALL PIPES ARE R.C.P. CLASS III UNLESS OTHERWISE NOTED.

CONSTRUCTION NOTES:

1. ALL CONCRETE FOR STRUCTURES SHALL BE 3000 PSI. UNLESS OTHERWISE NOTED.
2. MINIMUM COVER FOR REINFORCING STEEL SHALL BE 2" UNLESS OTHERWISE NOTED.
3. 95% COMPACTION REQUIRED FOR STRUCTURES AS PER ASTM D1557.
4. REINFORCING SHALL CONFORM TO THE REQUIREMENTS OF ASTM A615 GRADE 60.


GENERAL NOTES:

1. MATCHING SURFACES MARKED "M" TO BE MACHINE FINISHED OF ANY IRREGULARITIES THAT WOULD PREVENT A SNUG FIT.
2. CASTING TO BE SMOOTH & VOID OF AIR HOLES.
3. THIS MANHOLE COVER FITS IN A STANDARD MANHOLE RING.

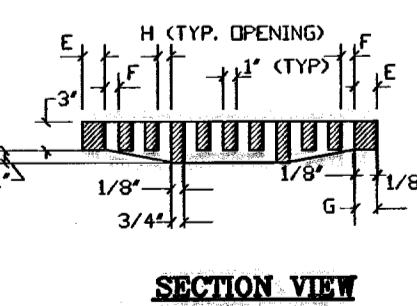


MANHOLE COVER	48" MANHOLE	72" MANHOLE
A	11 3/4"	27 1/4"
B	8 1/2"	17 1/2"
C	1 1/2"	1 1/2"
D	1 1/2"	1 1/2"
E	1 1/2"	1 1/2"
F	1 1/2"	1 1/2"
G	1 1/2"	1 1/2"
H	3/4"	1 1/2"

SEE SHEET 20 FOR  
MANHOLE DETAILS

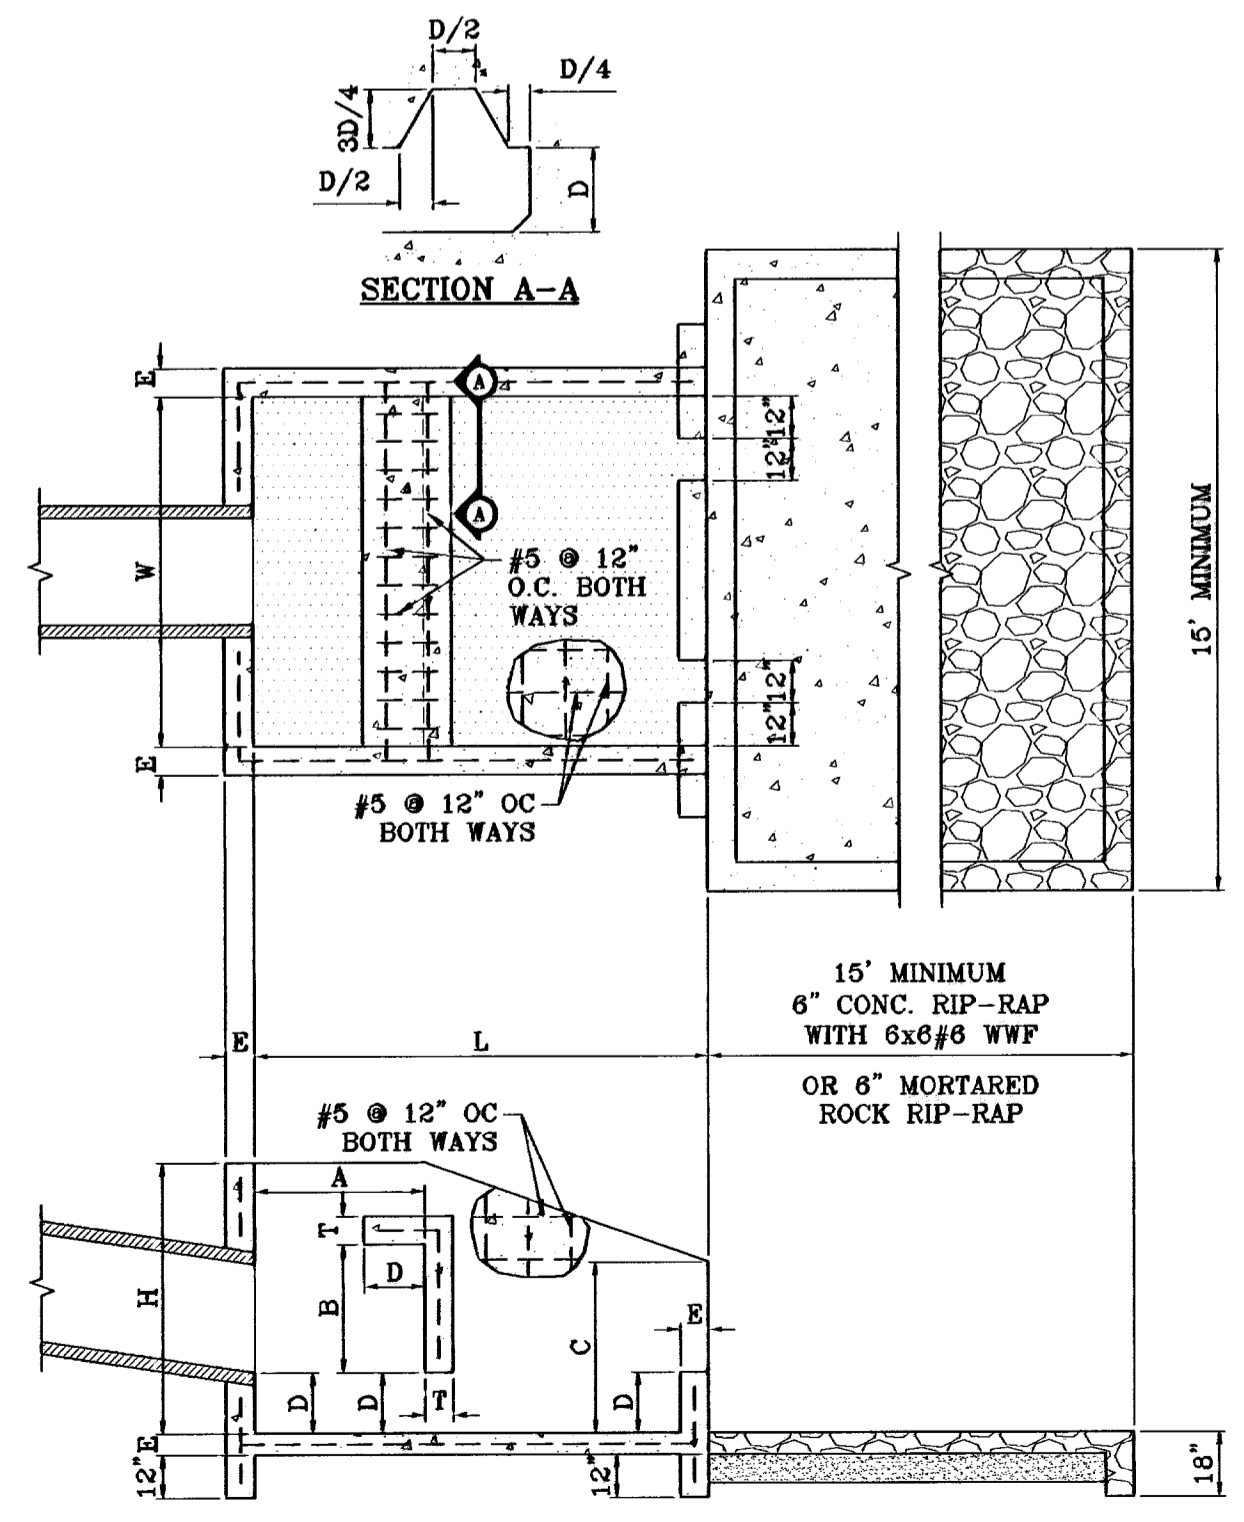

THRUST BLOCK DETAIL  
SCALE: 1"=4'

PIPE	φ	H	L	A	B	C	D	E	T	W
30" RCP	5'3"	9'4"	3'8"	2'8"	3'6"	1'2"	0'7"	0'7"	7'0"	
36" RCP	3'9"	8'8"	2'8"	1'11"	2'8"	0'10"	0'5"	0'5"	5'0"	

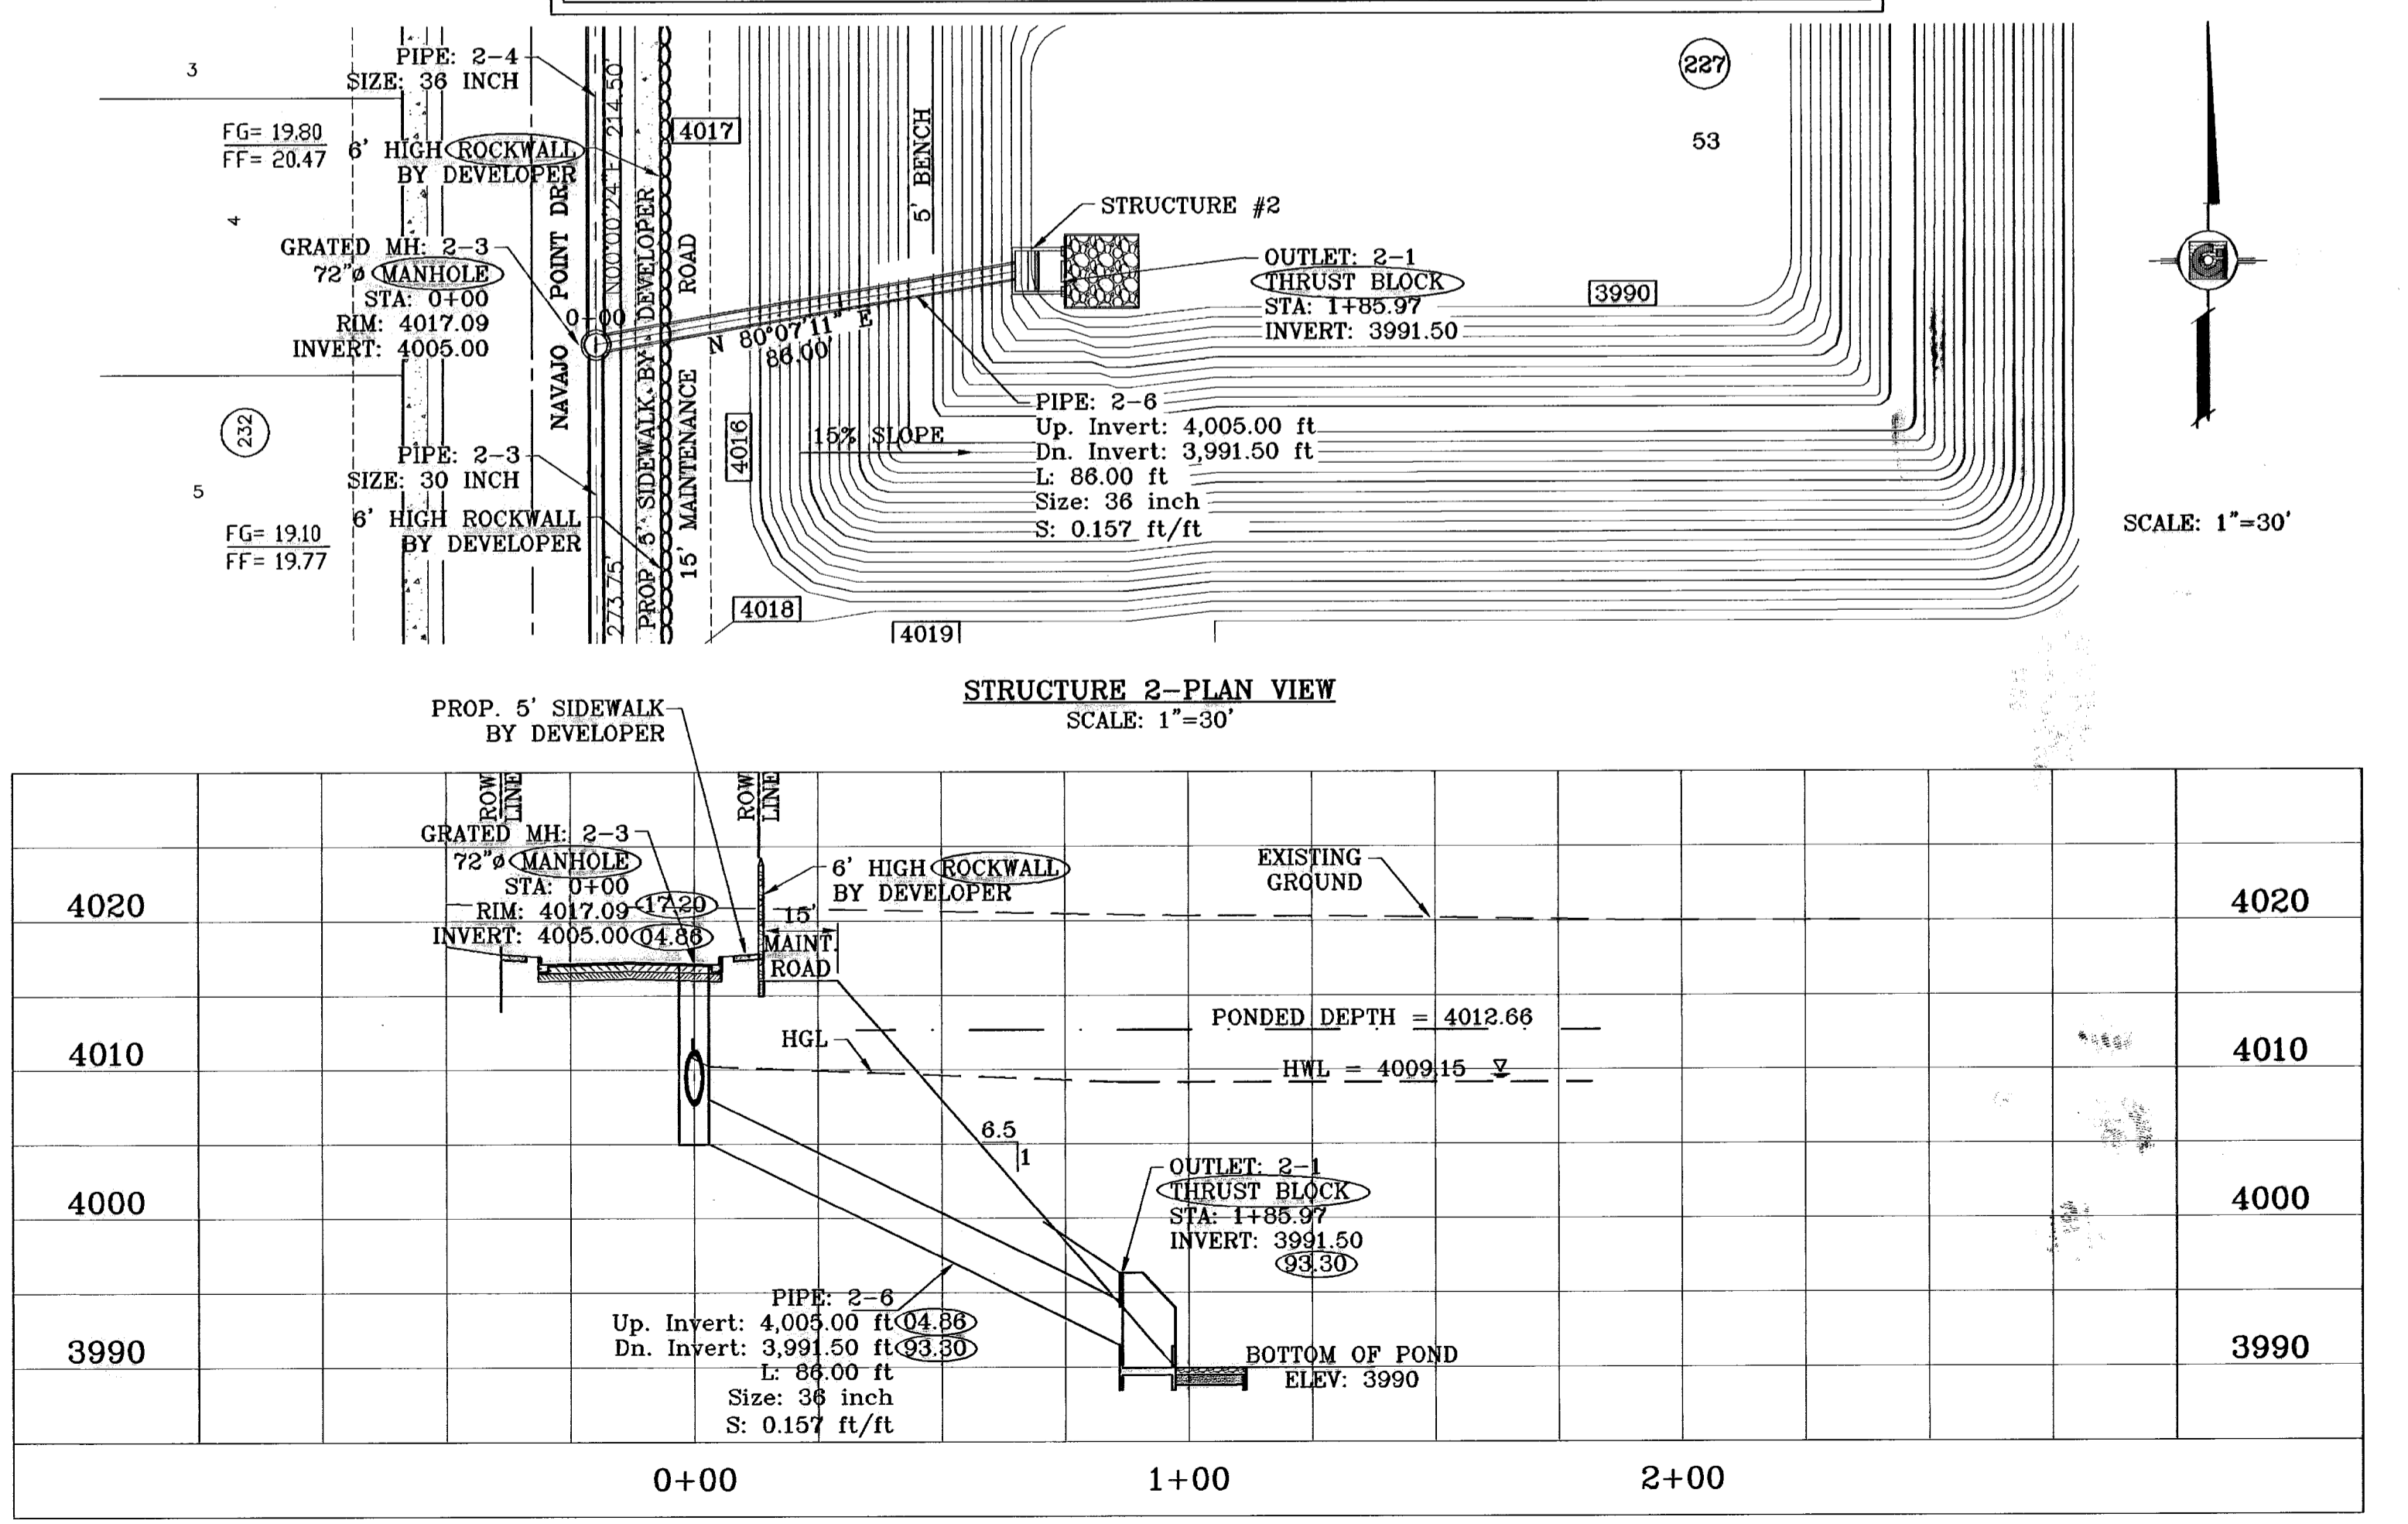

STRUCTURE 2-PLAN VIEW  
SCALE: 1"=30'

STRUCTURE 2-PROFILE  
SCALE: 1"=10'

TIERRA DEL ESTE UNIT FIFTY NINE

DATE	REVISIONS	BY
12/05/08	CITY REDLINES AS PER 11/28/08 COMMENTS	E.F.C.
12/16/08	CITY REDLINES AS PER 12/16/08 COMMENTS	E.F.C.
06/09/09	CHANGES MADE DUE TO REVEALED PLAT	E.F.C.
08/09/09	LOT REVISIONS	E.F.C.

PROJECT NAME  
**TIERRA DEL ESTE  
UNIT FIFTY NINE**


BEING A PORTION OF SECTION 38 BLOCK 79 TOWNSHIP 2,  
TEXAS AND PACIFIC RAILROAD COMPANY SURVEYS,  
CITY OF EL PASO, EL PASO COUNTY, TEXAS,  
CONTAINING 26.969 ACRES

SCALE  
HORIZ. 1"=30'  
VERT. 1"=10'

DATE: MAY 2008

DESIGN BY: Y.C.  
INITIATED BY: O.M.  
CHECKED BY: Y.C.  
JOB NO.: 608-23


CONDE INC.  
ENGINEERING / PLANNING  
SURVEYING / GPS  
1790 LEE TREVINO STE 400  
EL PASO, TEXAS 79966

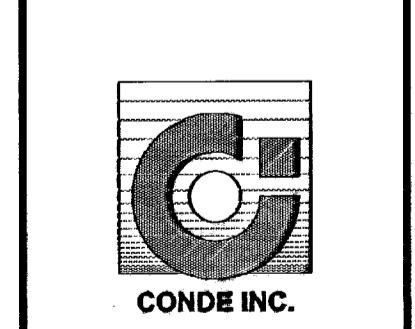


SHEET TITLE

**DRAINAGE  
STRUCTURE #2**

SCALE: 1"=10'

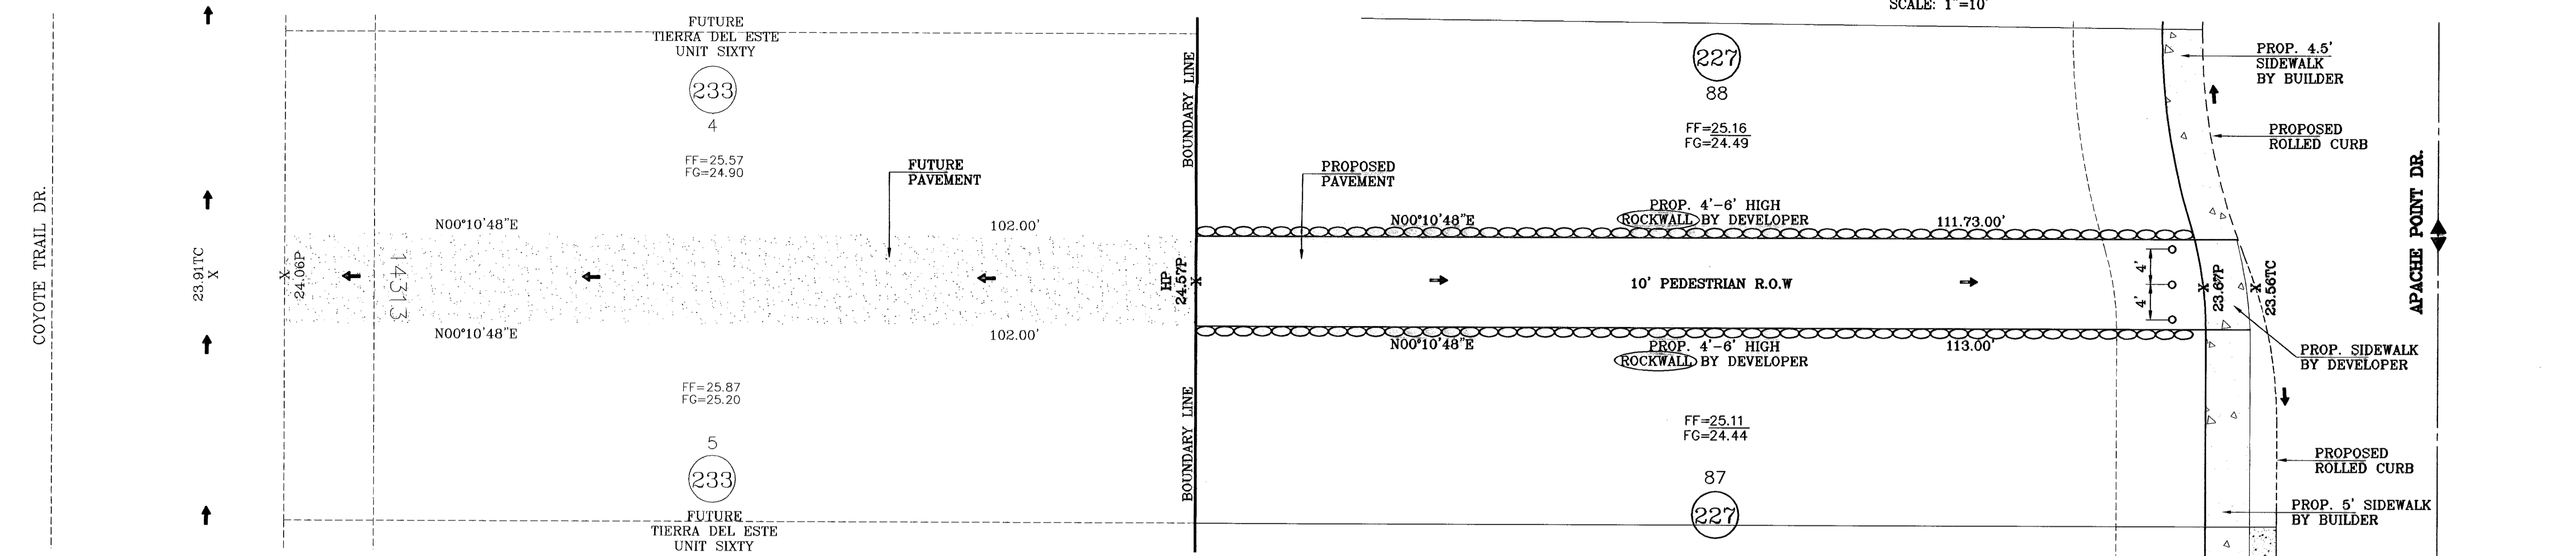

10' PEDESTRIAN R.O.W.  
SCALE: 1"=10'

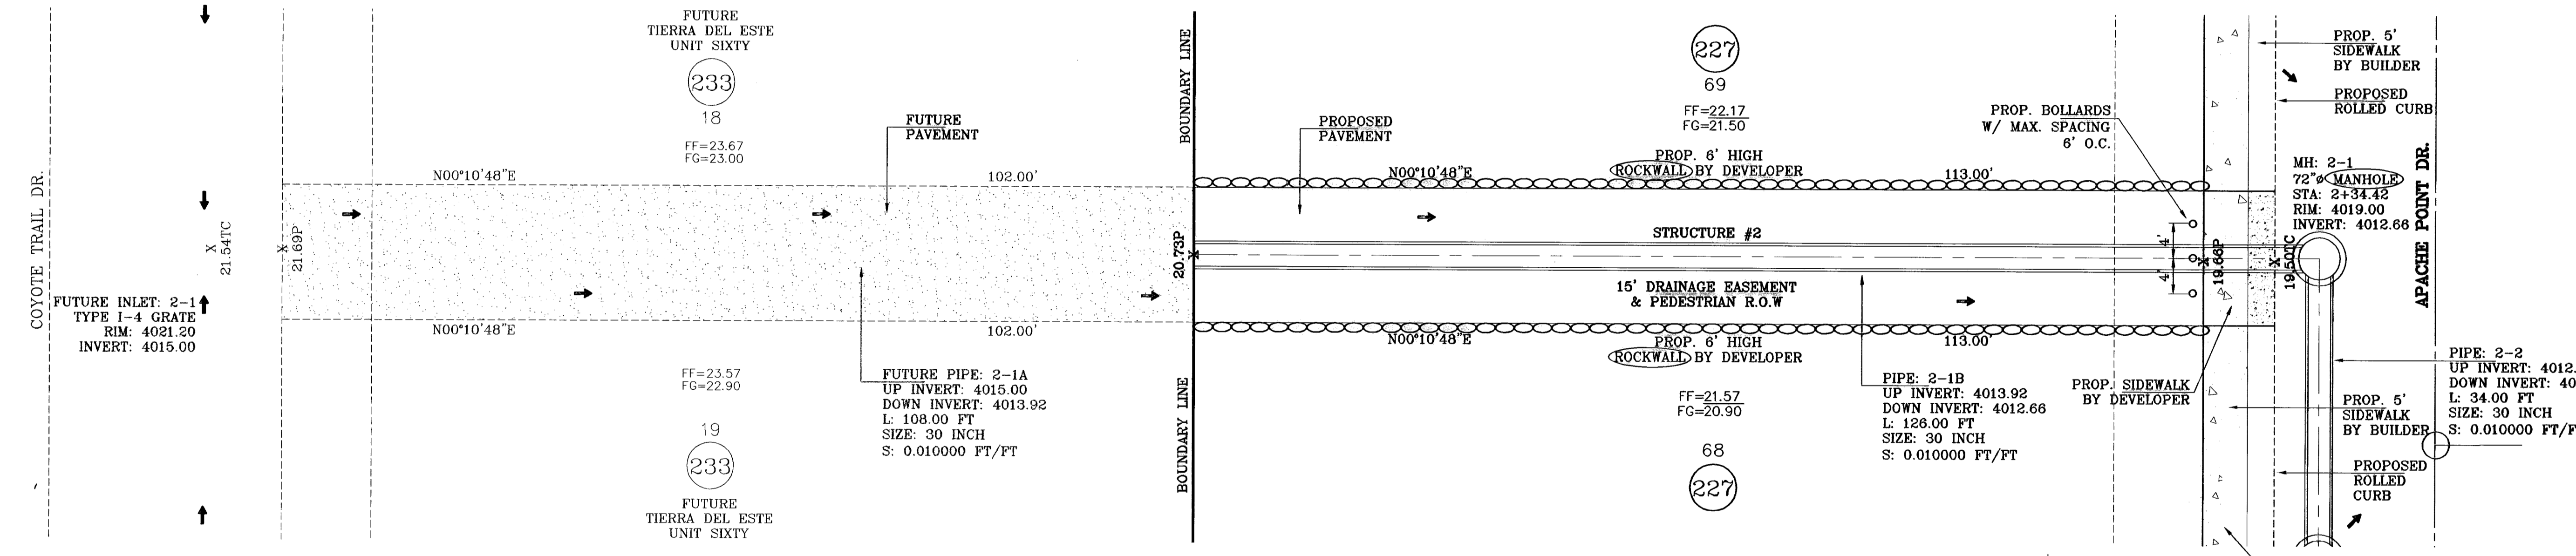


15' DRAINAGE EASEMENT & PEDESTRIAN R.O.W.  
SCALE: 1"=10'


SCALE: 1"=10'

SEE SHEET 18 FOR  
STRUCTURE #1 DETAILS


- CONSTRUCTION NOTES:**
1. ALL CONCRETE FOR STRUCTURES SHALL BE 3000 PSI. UNLESS OTHERWISE NOTED.
  2. MINIMUM COVER FOR REINFORCING STEEL SHALL BE 2" UNLESS OTHERWISE NOTED.
  3. 95% COMPACTION REQUIRED FOR STRUCTURES AS PER ASTM D1557.
  4. REINFORCING SHALL CONFORM TO THE REQUIREMENTS OF ASTM A615 GRADE 60.

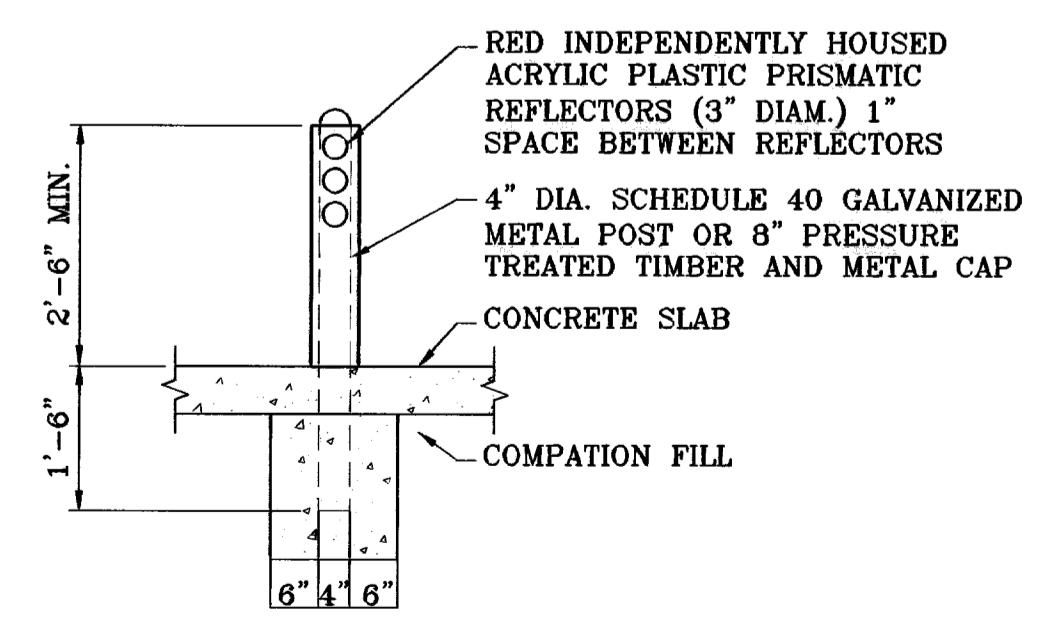

BOLLARD DETAIL  
SCALE: 1"=2'

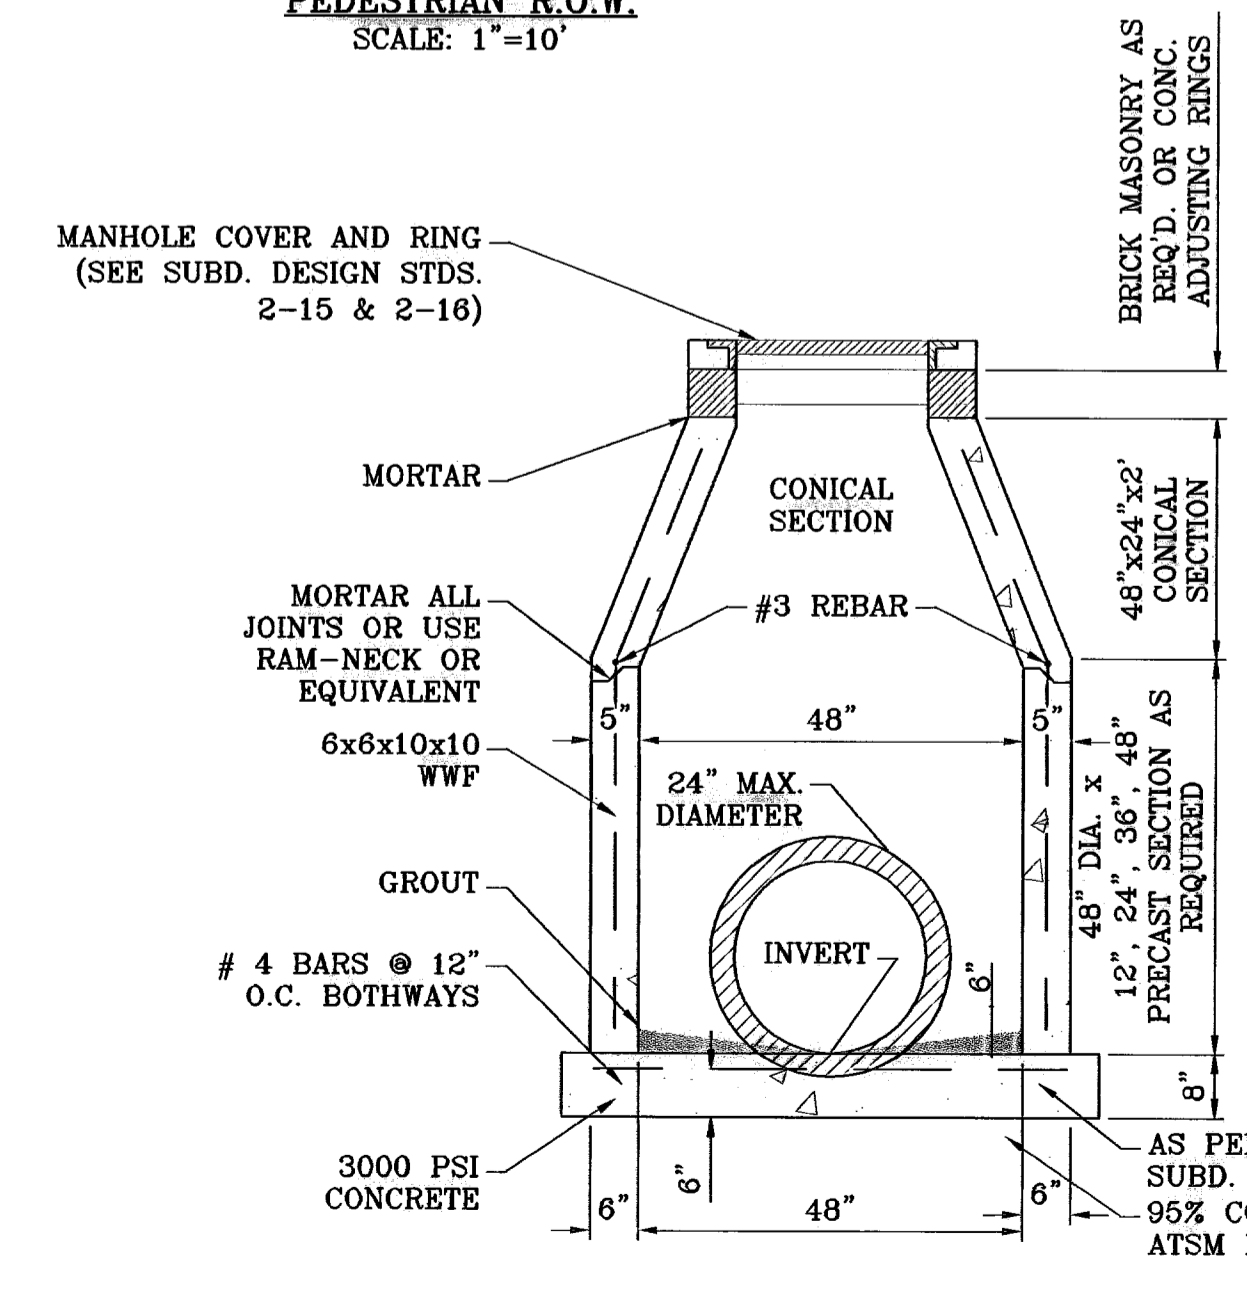

PRECAST 48" MANHOLE SECTION  
SCALE: 1"=2'

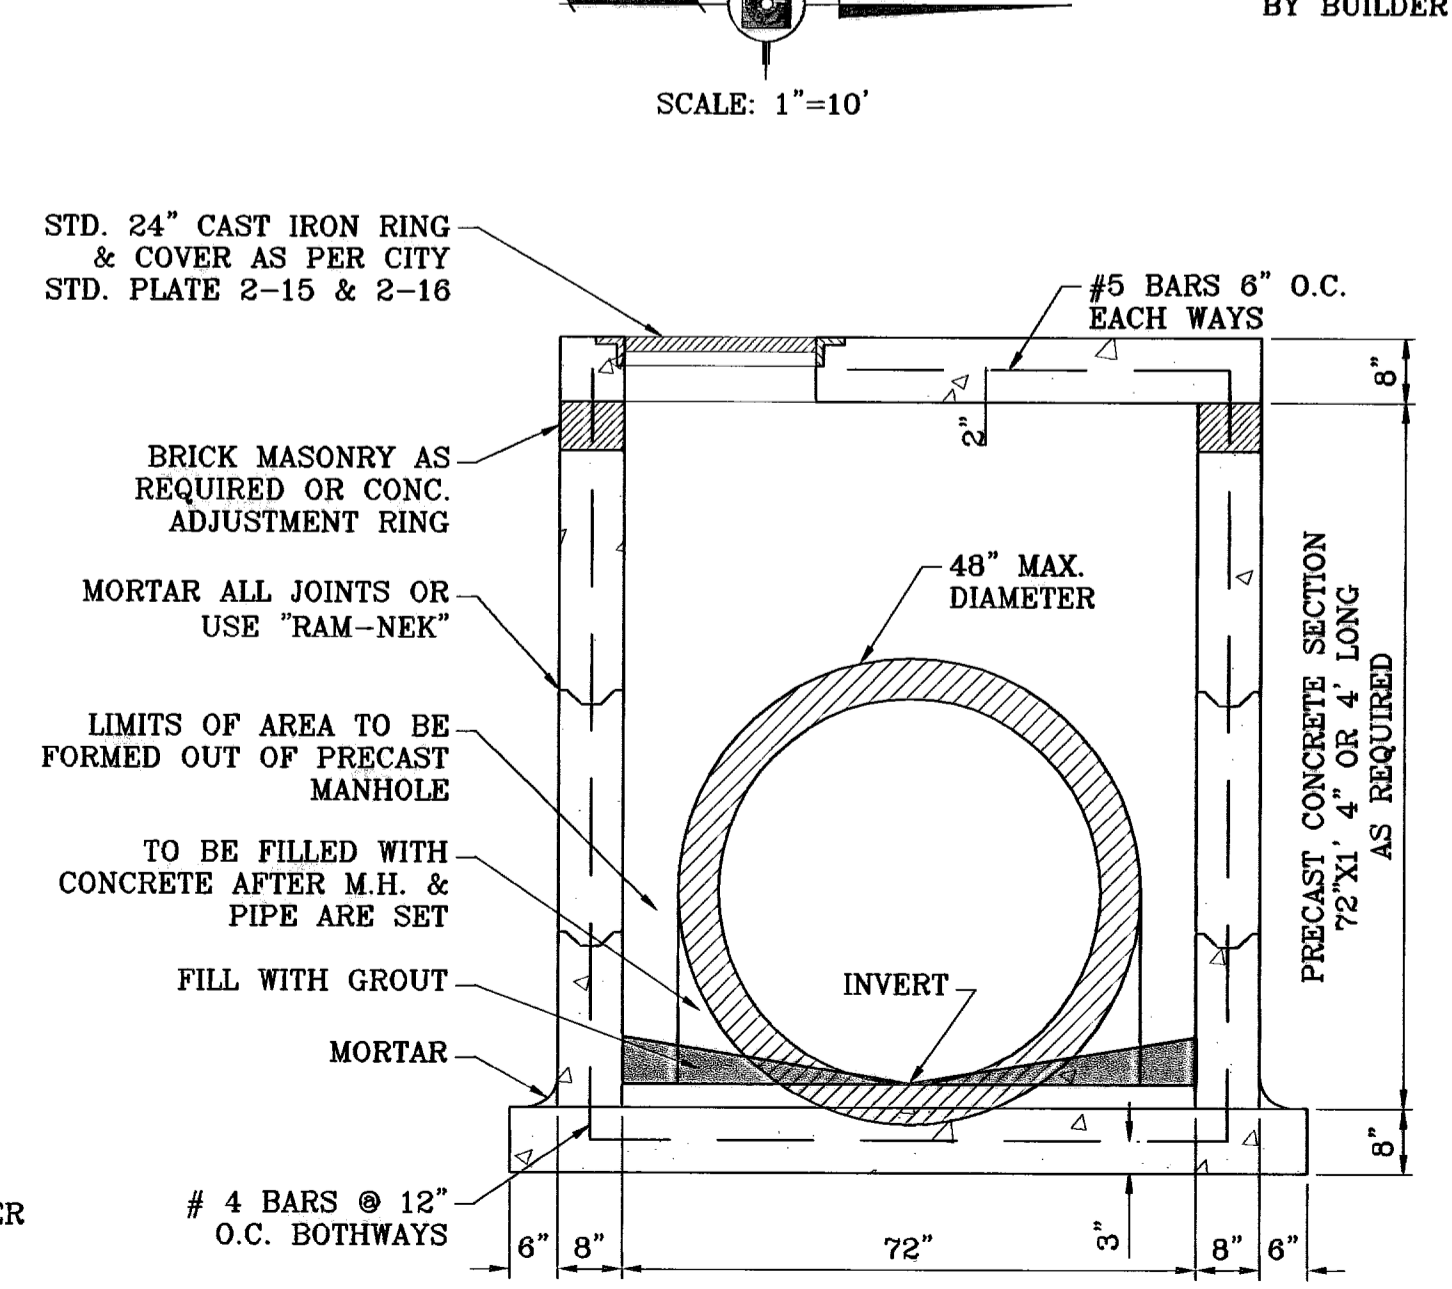

PRECAST 72" MANHOLE SECTION  
SCALE: 1"=2'

BENCHMARK

NGS MARKER COPPER-CLAD STEEL ROD DESIGNATED X 1118 PID "CE0141" ELEVATION : 3987.12

DATE	REVISIONS	BY
12/05/08	CITY REDLINES AS PER 11/26/08 COMMENTS	E.F.G


PROJECT NAME  
**TERRA DEL ESTE UNIT FIFTY NINE**

BEING A PORTION OF SECTION 38, BLOCK 79, TOWNSHIP 2, TEXAS AND PACIFIC RAILROAD COMPANY SURVEYS, CITY OF EL PASO, EL PASO COUNTY, TEXAS, CONTAINING 26.968 ACRES


SCALE  
HORIZ: 1"=90'  
VERT: 1"=10'

DATE: MAY 2008  
DESIGN BY: Y.C.  
INITIATED BY: O.M.  
CHECKED BY: Y.C.  
JOB NO.: 608-23

**CONDE INC.**  
ENGINEERING / PLANNING  
SURVEYING / GPS  
1790 LEE TREVINO STE 400  
EL PASO, TEXAS 79908

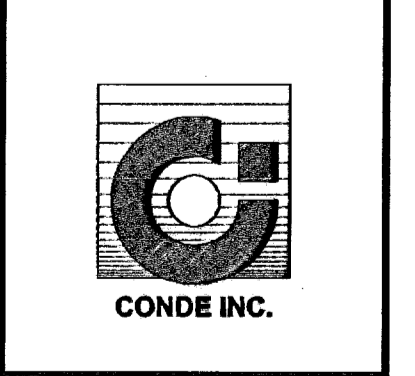


SHEET TITLE  
**DRAINAGE EASEMENT & PEDESTRIAN R.O.W.**

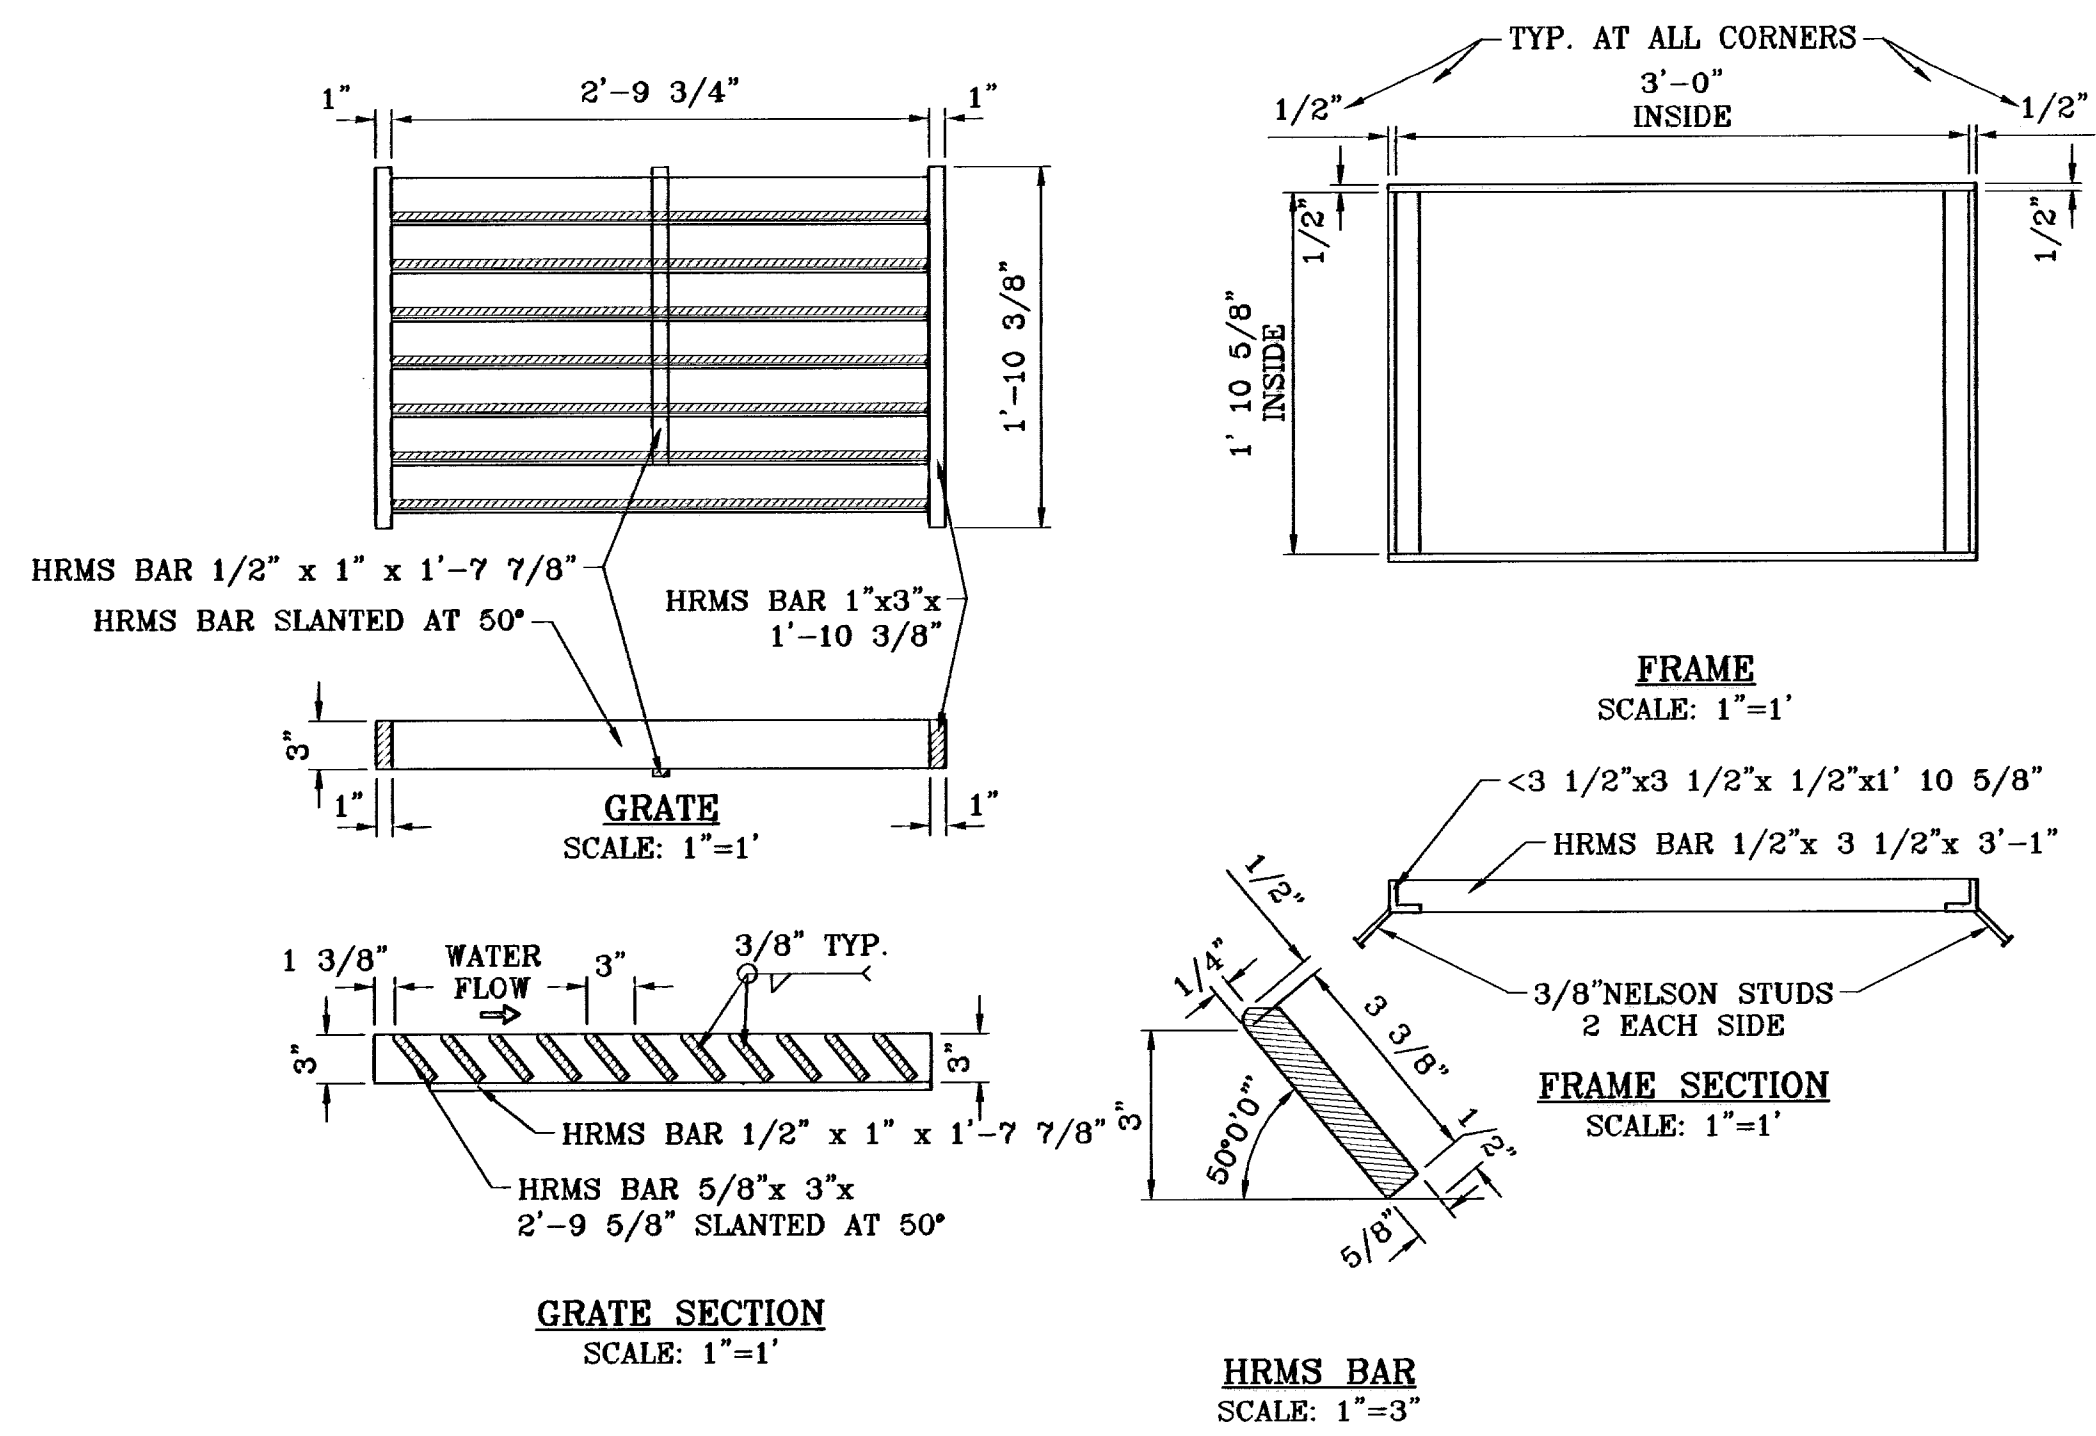


FRAME AND GRATE DETAIL





No. OF GRATES	L	L	
		LENGTH	MINIMUM SIZES
1	3'-2 5/8"	2'-10"	W6x12, S4x13, MC6x8.2
2	5'-1 1/8"	4'-7 1/8"	W6x12, S6x12.5, MC6x15.1
3	7'-0 1/4"	6'-5 1/8"	W8x15, S7x15.3, MC7x17.8
4	8'-9 7/8"	8'-3 7/8"	W9x18, S8x18.4, MC10x21.9
5	10'-8"	10'-2"	W12x18, S8x21, MC10x21.9
6	12'-6 5/8"	12'-0 5/8"	W12x19, S8x23, MC10x25

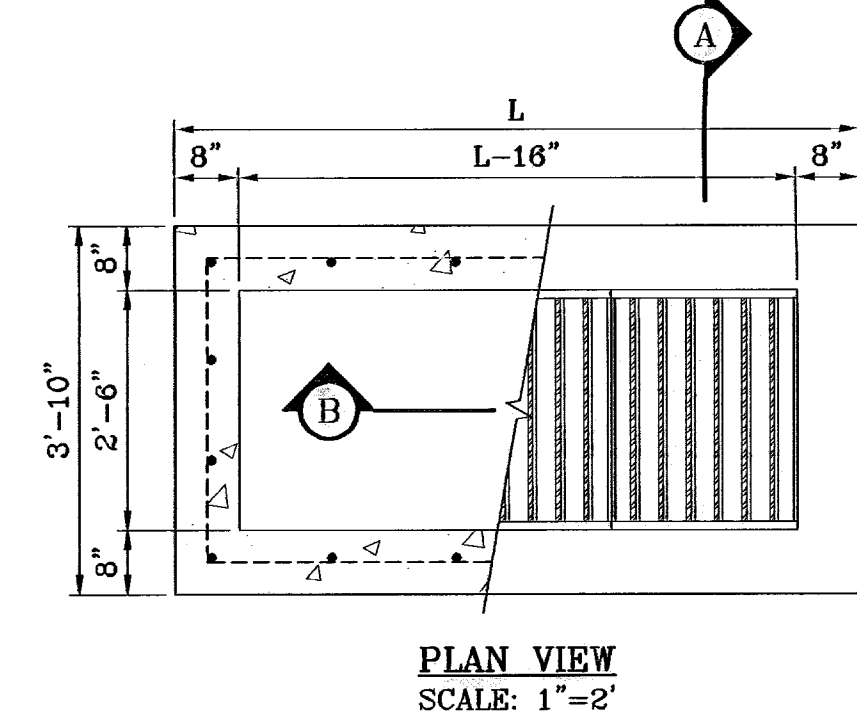

No. OF GRATES	L
1	3'-2 5/8"
2	5'-2 1/4"
3	7'-1 7/8"
4	9'-1 1/2"
5	11'-1 1/8"
6	13'-0 3/4"
7	15'-0 3/8"
8	17'-0"
9	18'-11 5/8"
10	20'-11 1/4"
11	22'-10 7/8"
12	24'-10 1/2"

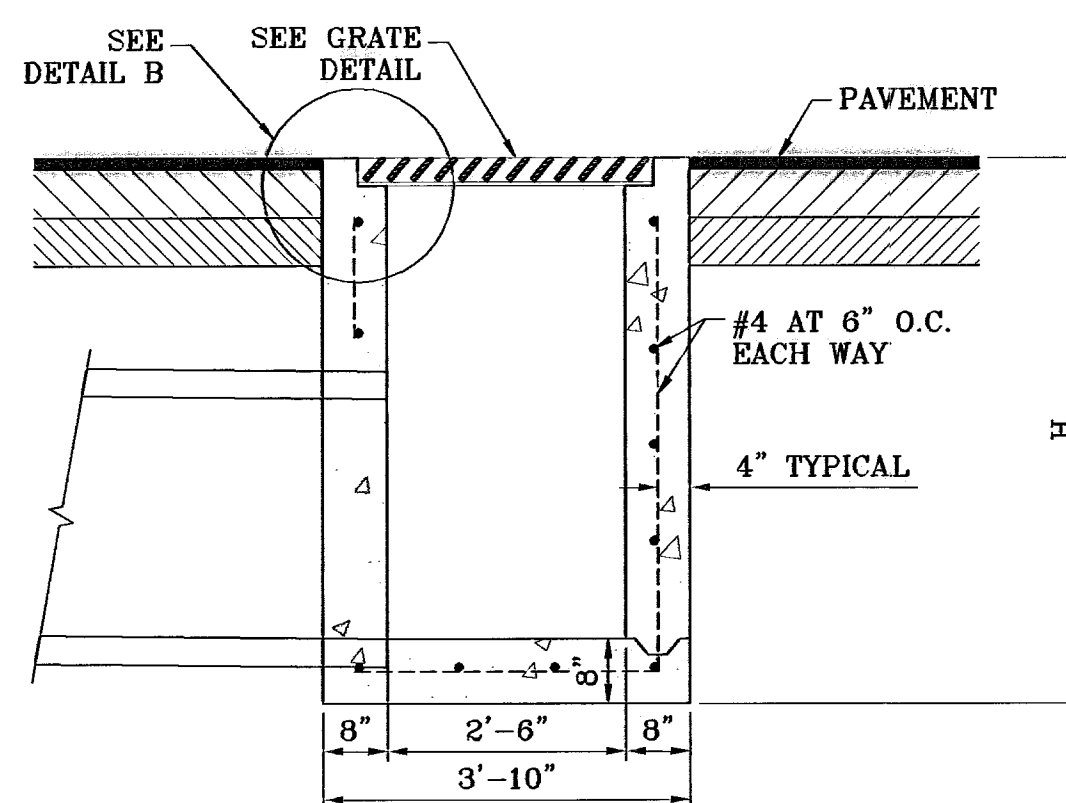


TYPE III INLET

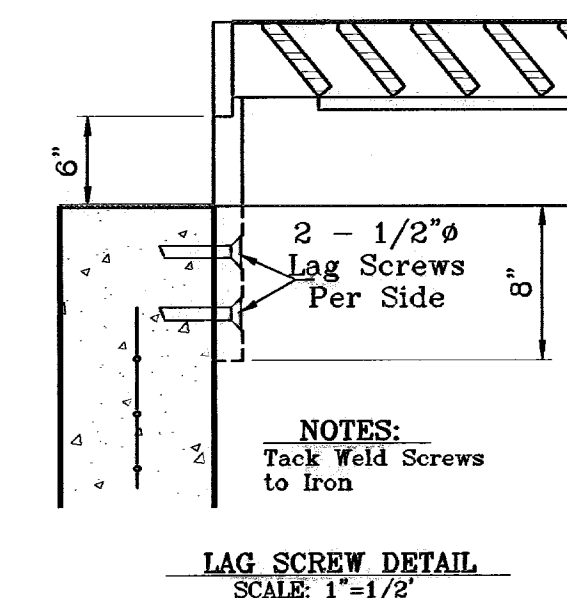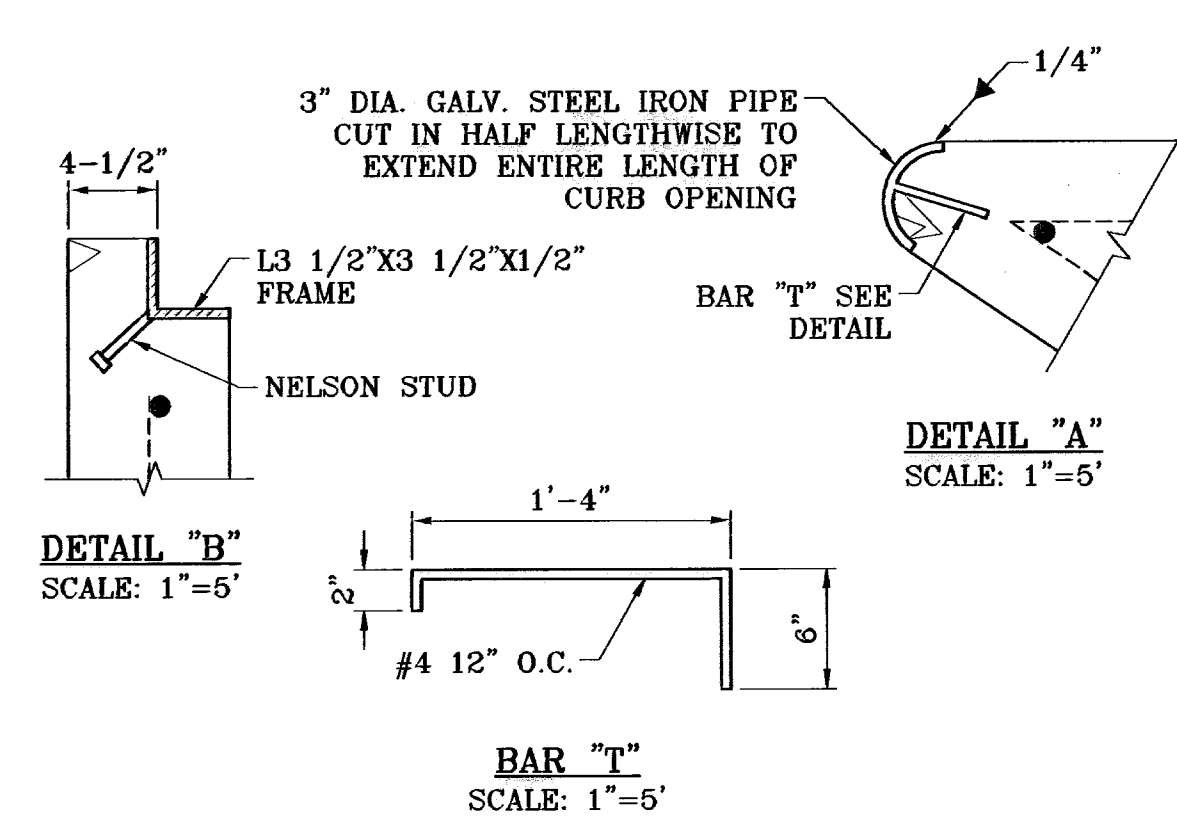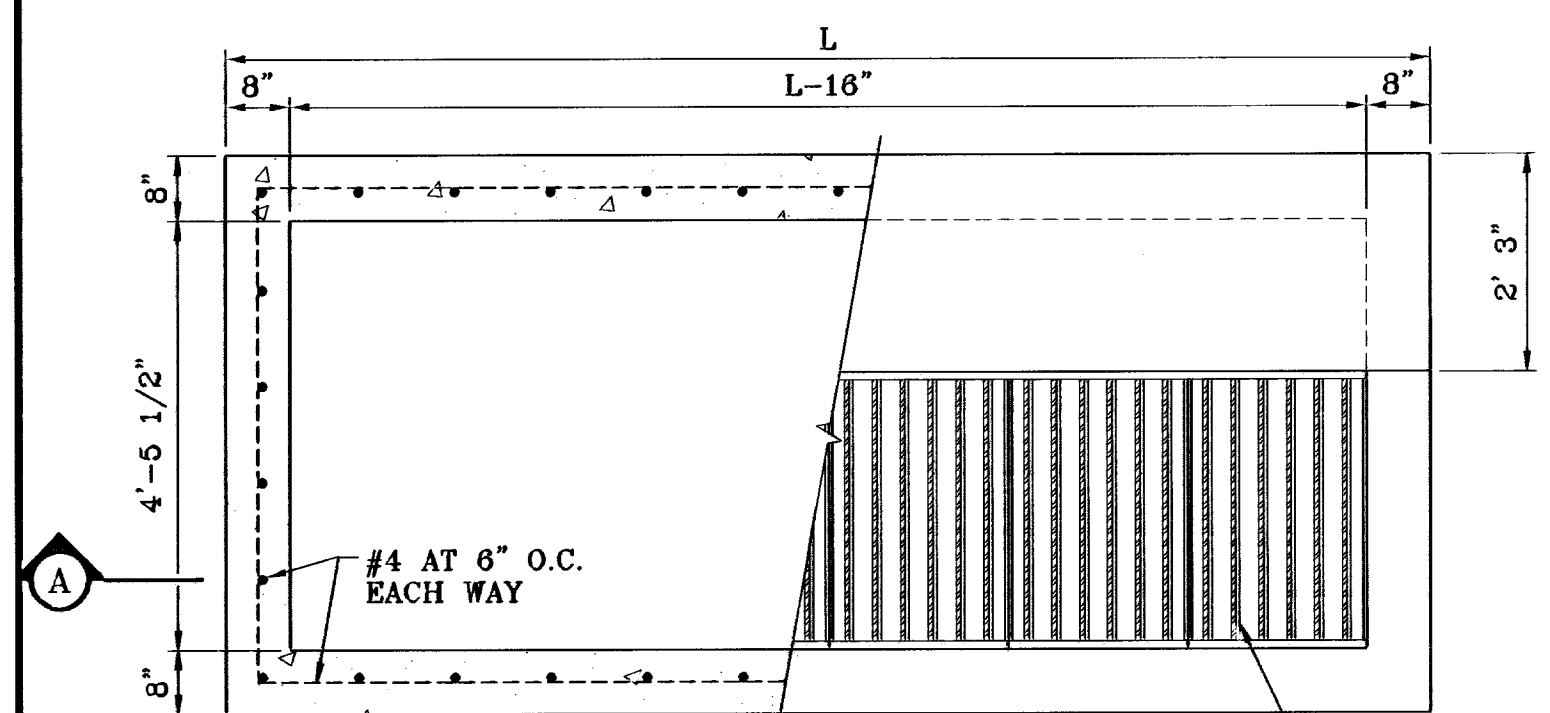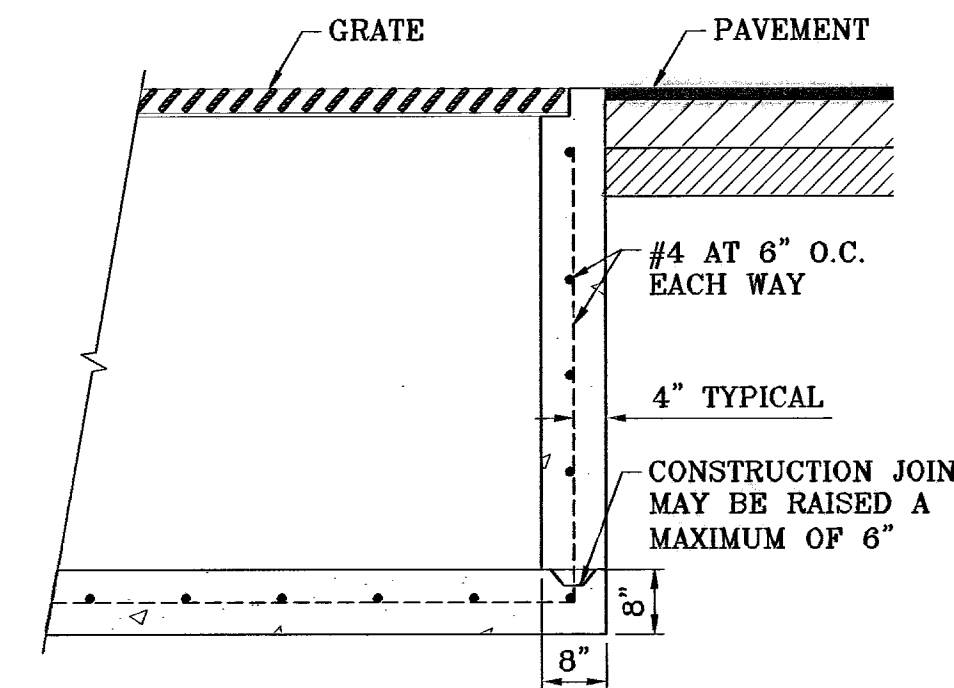


No. OF GRATES	L
1	3' 4"
2	5' 3"
3	7' 2"
4	9' 1"
5	11' 0"
6	12' 11"

OFF-STREET STORM INLET


SCALE: 1"=1'

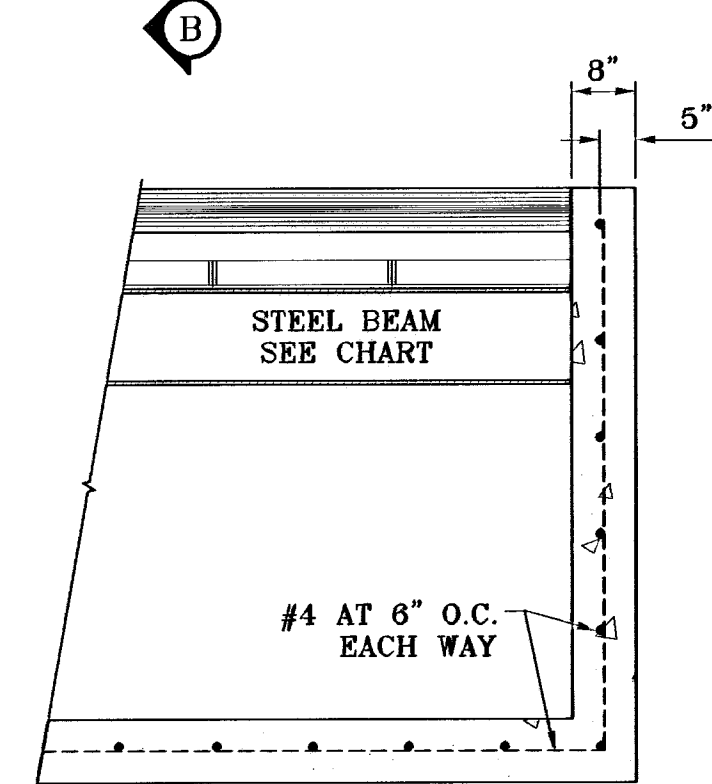


TYPE I INLET

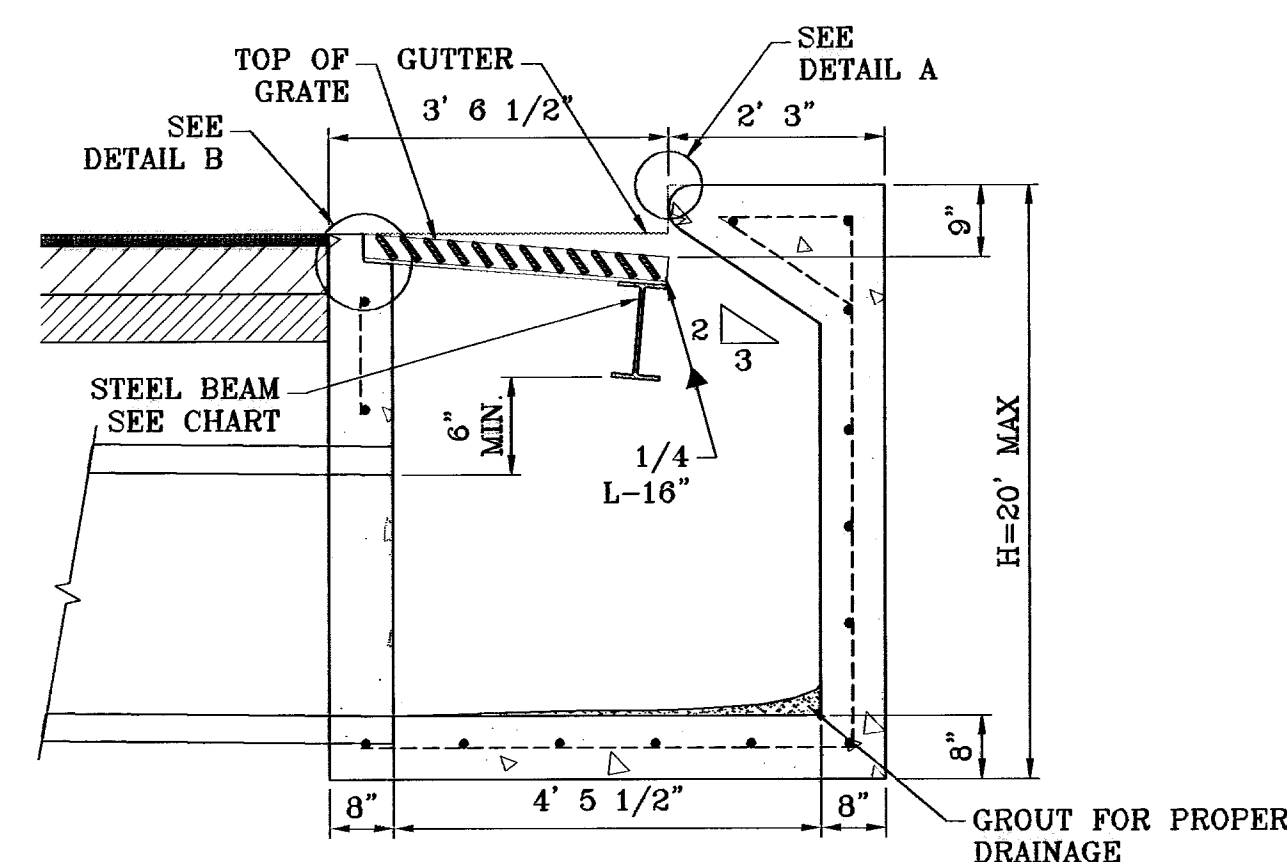

CONSTRUCTION JOINT MAY BE RAISED A MAXIMUM OF 6"

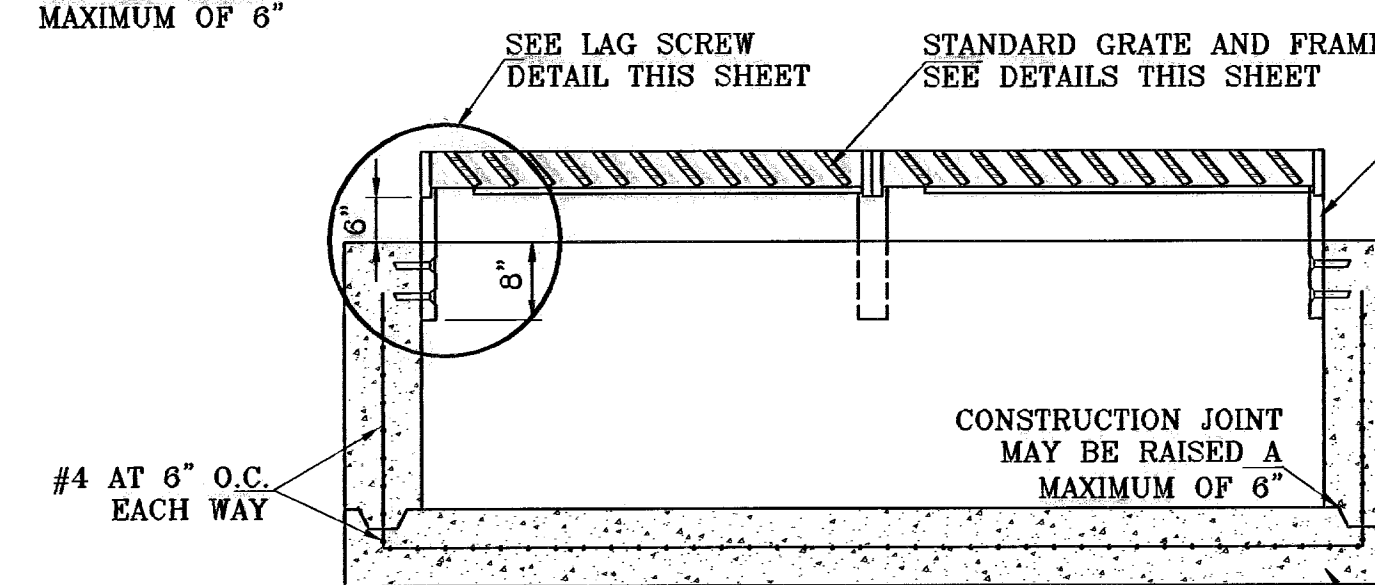

3000 PSI CONCRETE CORE TEST AT 28 DAYS

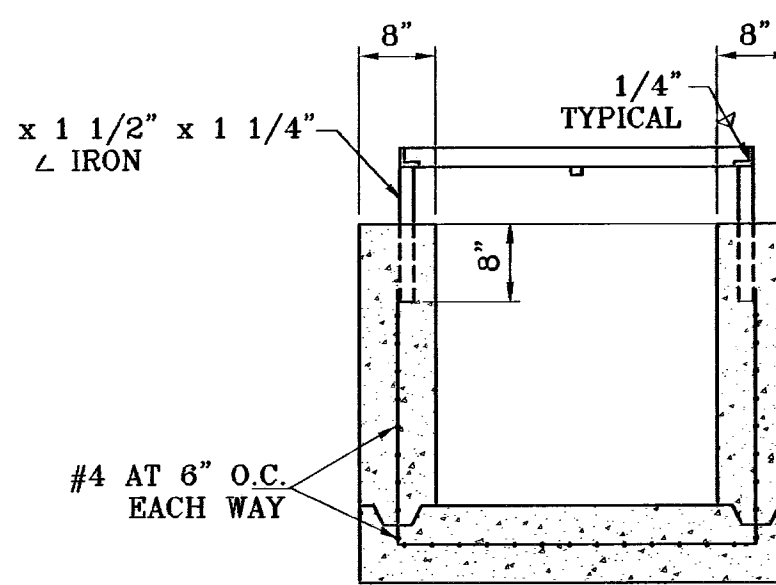

3000 PSI CONCRETE CORE TEST AT 28 DAYS

GENERAL NOTES:

- CONCRETE TO BE 3000 P.S.I. MINIMUM CORE TEST AT 28 DAYS.
- WELDED STEEL OR CAST GRATES AS DETAILED ARE ALL ACCEPTABLE GRATES. MIXING OF ALTERNATES TYPES OF GRATES ON THE SAME PROJECT WILL BE PERMITTED WITH THE APPROVAL OF THE CITY ENGINEER.
- ALL CONSTRUCTION AND MATERIALS SHALL BE IN ACCORDANCE WITH THE CURRENT STANDARD SPECIFICATIONS.
- SHARP EDGES RESULTING FROM FABRICATION SHALL BE DULLED ONLY BY ACCEPTABLE METHODS FOR SAFETY.
- GRATES SHALL BE INSTALLED IN FRAME WITH FLOW ARROW POINTING DOWNSTREAM OR TOWARD THE LOW POINT IN A SUMP.
- WELDED GRATES SHALL BE STRUCTURAL STEEL CONFORMING TO THE REQUIREMENTS OF AASHTO M-183 OR OF CORROSION RESISTANT STRUCTURAL STEEL CONFORMING TO THE REQUIREMENTS OF AASHTO M-161 OR M-222 OR BE MADE OF OTHER APPROVED STEELS OF EQUAL QUALITY. MIXING OF GRADES OF STEEL ON THE SAME GRATE WILL NOT BE PERMITTED.
- GRATES MADE OF M-183 STEEL SHALL BE GALVANIZED IN ACCORDANCE WITH AASHTO M-111 SPECIFICATIONS OR SHALL BE PAINTED WITH INORGANIC ZINC PAINTS, MEETING THE REQUIREMENTS OF CURRENT STANDARD SPECIFICATIONS.
- ALL WELDS SHALL BE A MINIMUM OF 1/4 INCH FILLED AND SHALL CONFORM TO THE SPECIFICATIONS FOR HIGHWAY CONSTRUCTION AND TO THE AWS STRUCTURAL WELDING CODES. ELECTRODES SHALL BE COMPATIBLE TO THE DIFFERENT GRADES OF STEEL THAT COMPRISE THE GRATE MEMBERS.
- CAST GRATES SHALL BE CAST STEEL CONFORMING TO THE REQUIREMENTS OF AASHTO M-103, GRADE 65-35 OR OF DUCTILE IRON CONFORMING TO THE REQUIREMENTS OF ASTM A-536, SPECIAL GRADES 60-45, OR OF GRAY IRON CONFORMING TO THE REQUIREMENTS OF AASHTO M-105, CLASS 35B OR ASTM A-48 CLASS 35B, THIS SPECIFICATION OF GENERAL APPLICATION FOR CAST STEEL GRATES SHALL BE AASHTO M-103, SCOPE 121, GRADE N-1.
- FERROUS CASTINGS SHALL BE OF UNIFORM QUALITY FREE OF BLOW-HOLES, POROSITY, HARD SPOTS, SHRINKAGE DISTORTION OR OTHER DEFECTS. THEY SHALL BE SMOOTH AND WELL CLEANED BY SHOT BLASTING OR OTHER APPROVED CLEANING METHOD. AFTER CLEANING THEY SHALL BE COATED WITH ASPHALT BASE PAINT RESULTING IN A SMOOTH COATING, TOUGH AND TENACIOUS WHEN COLD, NOT TACKY, NOT BRITTLE.
- ALL CASTING SHALL BE MANUFACTURED TRUE TO PATTERN. COMPONENT PARTS SHALL FIT TOGETHER IN A SATISFACTORY MANNER.
- GRATE WILL BE DEPRESSED 1 INCH BELOW PROPOSED OR EXISTING GRADE.
- TWO 3/8 INCH X 4 INCH LONG CONCRETE ANCHOR STUDS REQUIRED FOR EACH SIDE OF FRAME, WHERE FRAME IS RESTING ON CONCRETE, USE NELSON STUDS OR EQUAL
- THE GRATES OF ALL INLETS WITHIN THE STREET PAVEMENT MUST BE CONSTRUCTED WITH THE GRATE BARS PERPENDICULAR TO THE CURB.
- CHAMFER ALL EXPOSED EDGES 3/4 INCH. ALL DIMENSIONS RELATING TO REINFORCING STEEL ARE TO CENTER OF BARS.
- ALL CONCRETE TO BE 3000 P.S.I. MINIMUM CONCRETE COVER SHALL BE 2 INCH FOR STEEL REINFORCING.
- EXPANSION MATERIAL TO BE 1/2 INCH BITUMINOUS FIBER AND BE PLACED WHERE PROPOSED CONCRETE COMES IN CONTACT WITH ANY EXISTING OR PROPOSED CONCRETE OR MASONRY STRUCTURE.
- STRUCTURAL STEEL SHALL BE SHOP PAINTED IN ACCORDANCE WITH T.H.D. ITEM 446 "PAINT AND PAINTING".
- ALL REINFORCING BARS TO BE #4 BARS AT 6" O.C. GRADE 60. BEND BARS AROUND PIPE OPENINGS.
- SURFACE OF ALL EXPOSED CONCRETE SHALL CONFORM IN SLOPED AND GRADE TO EXISTING OR PROPOSED CURB AND WALK ADJACENT TO INLETS.
- INLETS TO BE DESIGNATED IN PLANS BY NUMBER OF GRATES REQUIRED.
- LOCATION OF SEWER PIPES SHOWN ELSEWHERE IN PLANS.

BENCHMARK  
NGS MARKER: COPPER-CLAD STEEL ROD  
DESIGNATED "X 1118" PID "CE0141"  
ELEVATION : 3987.12

REVISIONS  
DATE 12/05/08 CITY REVISIONS AS PER 11/26/08 COMMENTS E.F.G.


PROJECT NAME  
**TERRA DEL ESTE UNIT FIFTY NINE**

BRING A PORTION OF SECTION 38, BLOCK 79, TOWNSHIP 2, TEXAS AND PACIFIC RAILROAD COMPANY SURVEYS, CITY OF EL PASO, EL PASO COUNTY, TEXAS, CONTAINING 28.963 ACRES.


SCALE  
HORIZ. AS NOTED  
VERT. ---  
DATE: MAY 2008  
DESIGN BY: Y.C.  
INITIATED BY: O.M.  
CHECKED BY: Y.C.  
JOB NO.: 608-23

ENGINEER'S SEAL  
ENGINEER'S SEAL NOT REQUIRED.  
THIS SHEET IS A REPRODUCED COPY OF THE ORIGINAL DESIGN STANDARDS

**CONDE INC.**  
ENGINEERING / PLANNING  
SURVEYING / GPS  
1796 LEE TREVINO STE 400  
EL PASO, TEXAS 79936

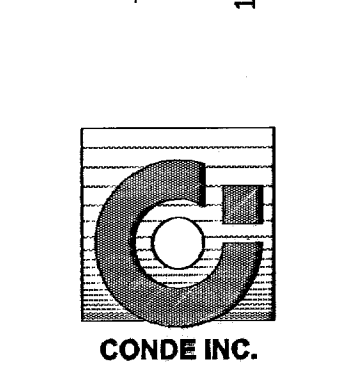


SHEET TITLE  
**STRUCTURE DETAILS**

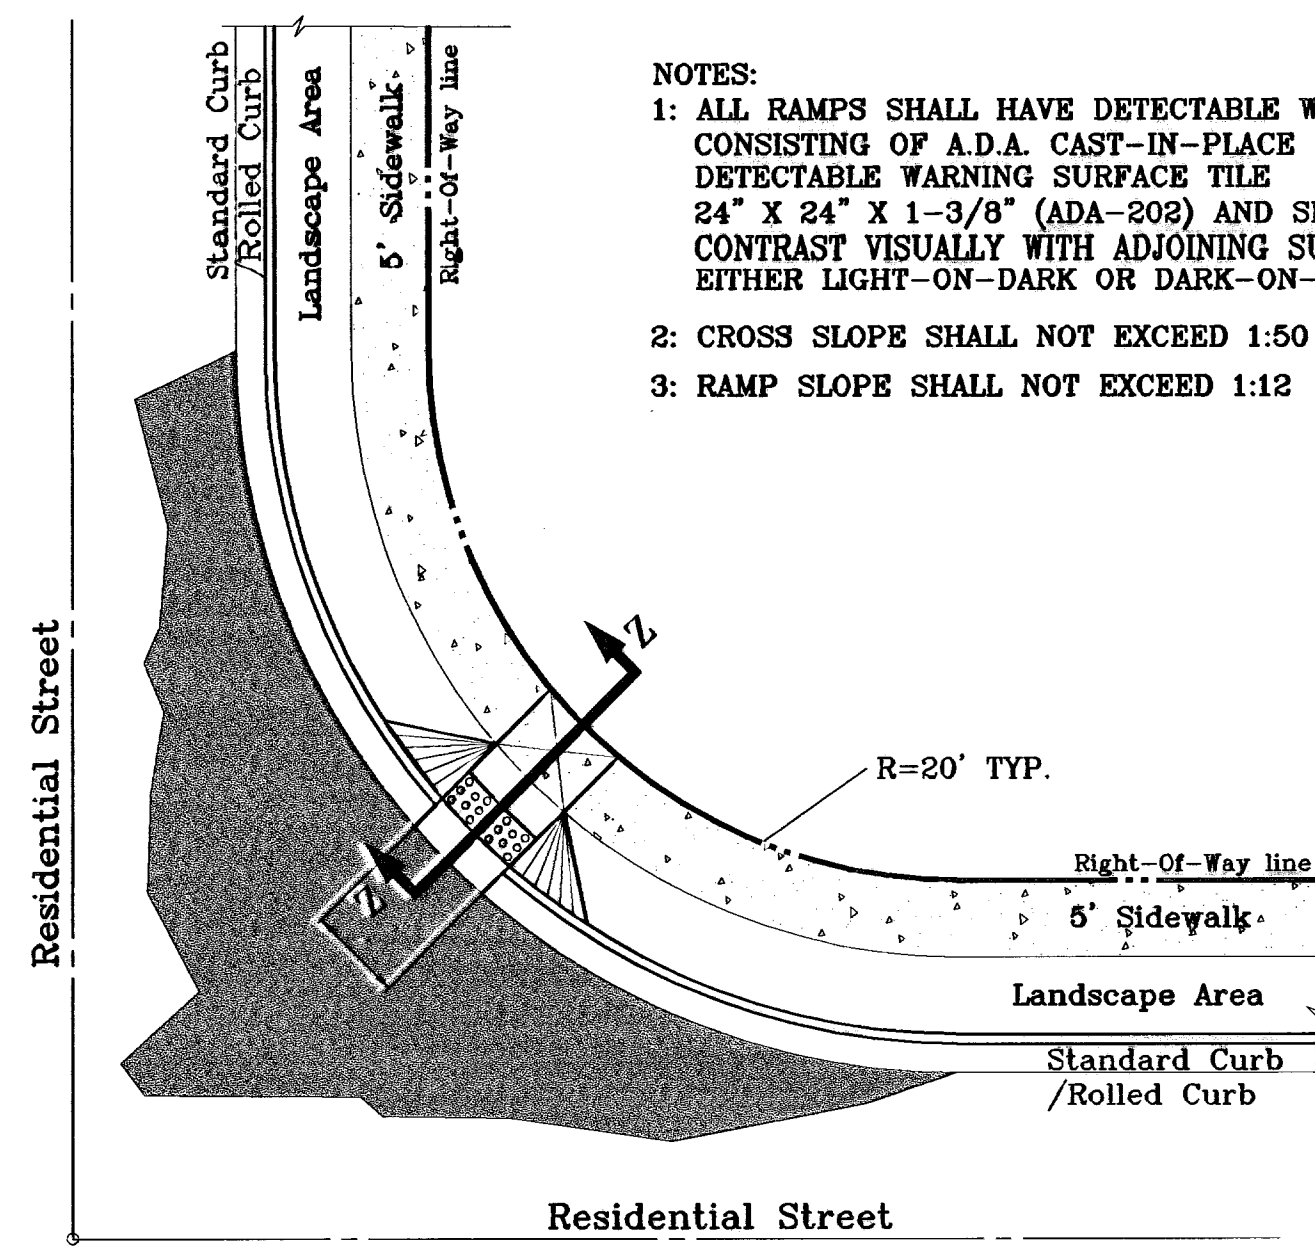


- NOTES:**
- 1: ALL RAMP SHALL HAVE DETECTABLE WARNINGS CONSISTING OF A.D.A. CAST-IN-PLACE DETECTABLE WARNING SURFACE TILE 24" X 24" X 1-3/8" (ADA-202) AND SHALL CONTRAST VISUALLY WITH ADJOINING SURFACES, EITHER LIGHT-ON-DARK OR DARK-ON-LIGHT.
  - 2: CROSS SLOPE SHALL NOT EXCEED 1:50
  - 3: RAMP SLOPE SHALL NOT EXCEED 1:12

**RAMP ON SIDEWALK AT STANDARD / ROLLED CURB**


52' R.O.W.  
SCALE: 1" = 10'

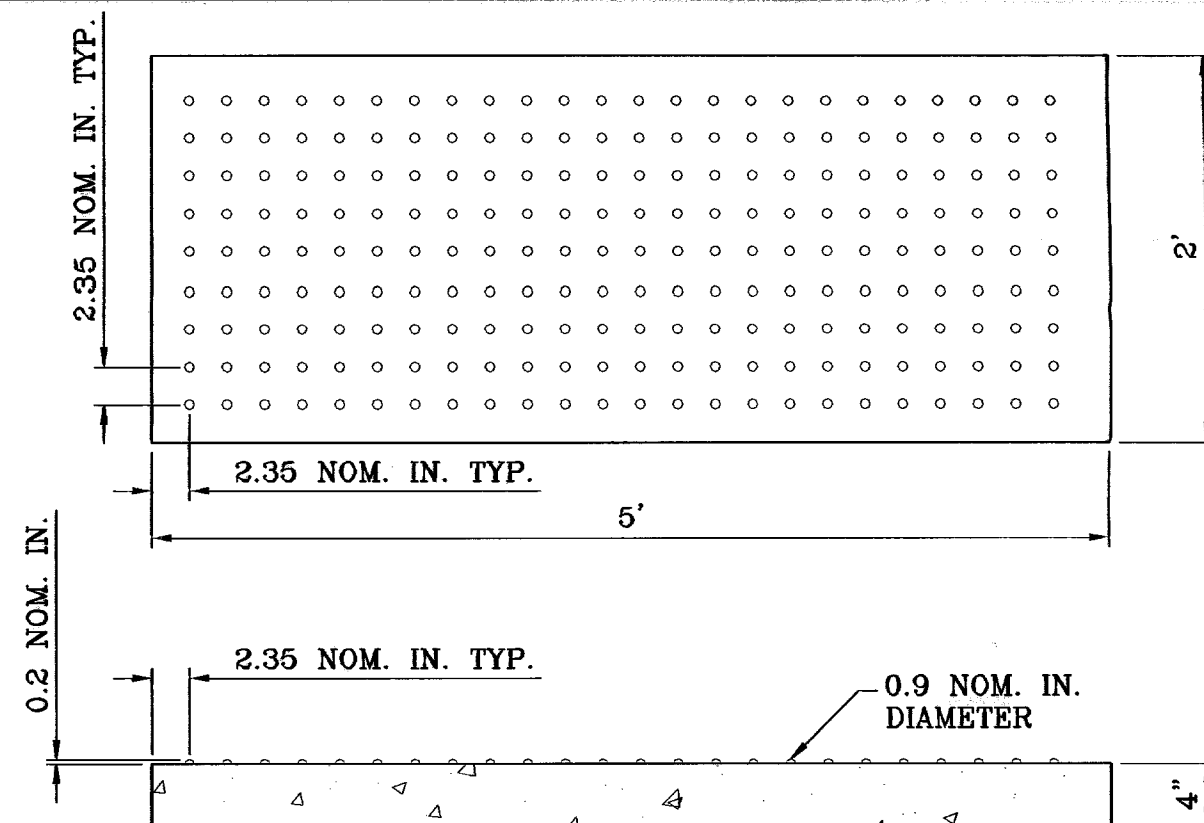


**TRUNCATED DOMES**  
SCALE: 1" = 1'

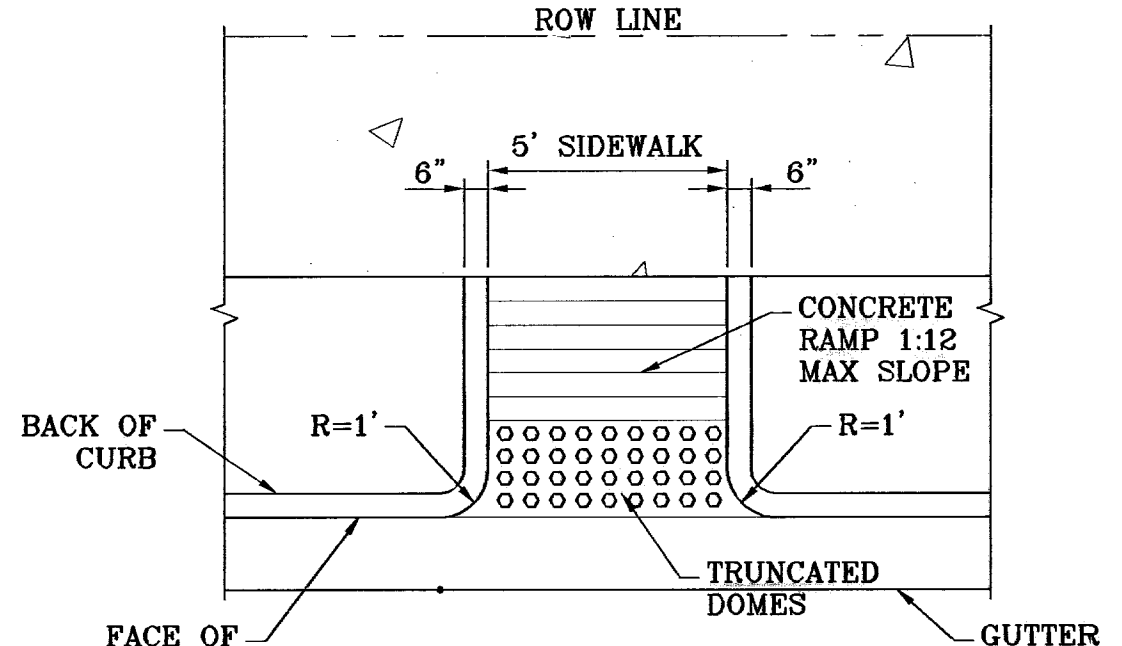

**STRAIGHT RAMP**  
SCALE: 1" = 4'

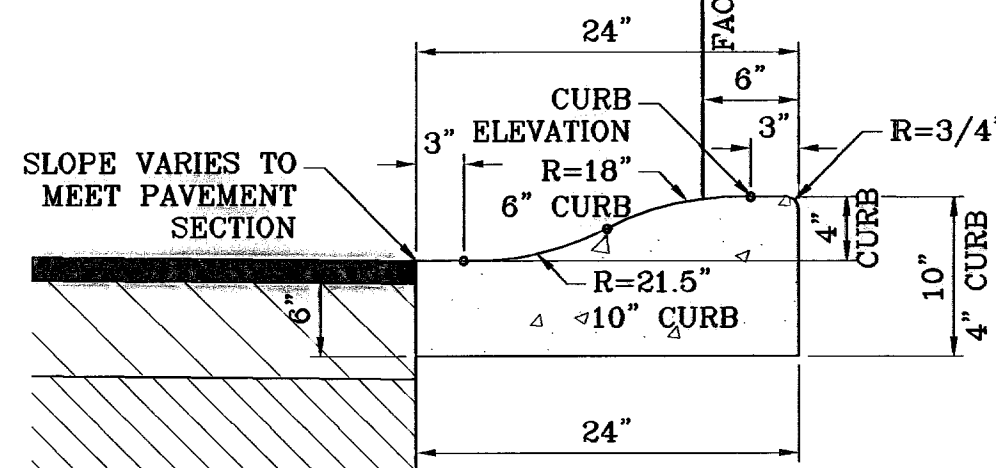


**ROLLED CURB DETAIL**  
SCALE: 1" = 1'

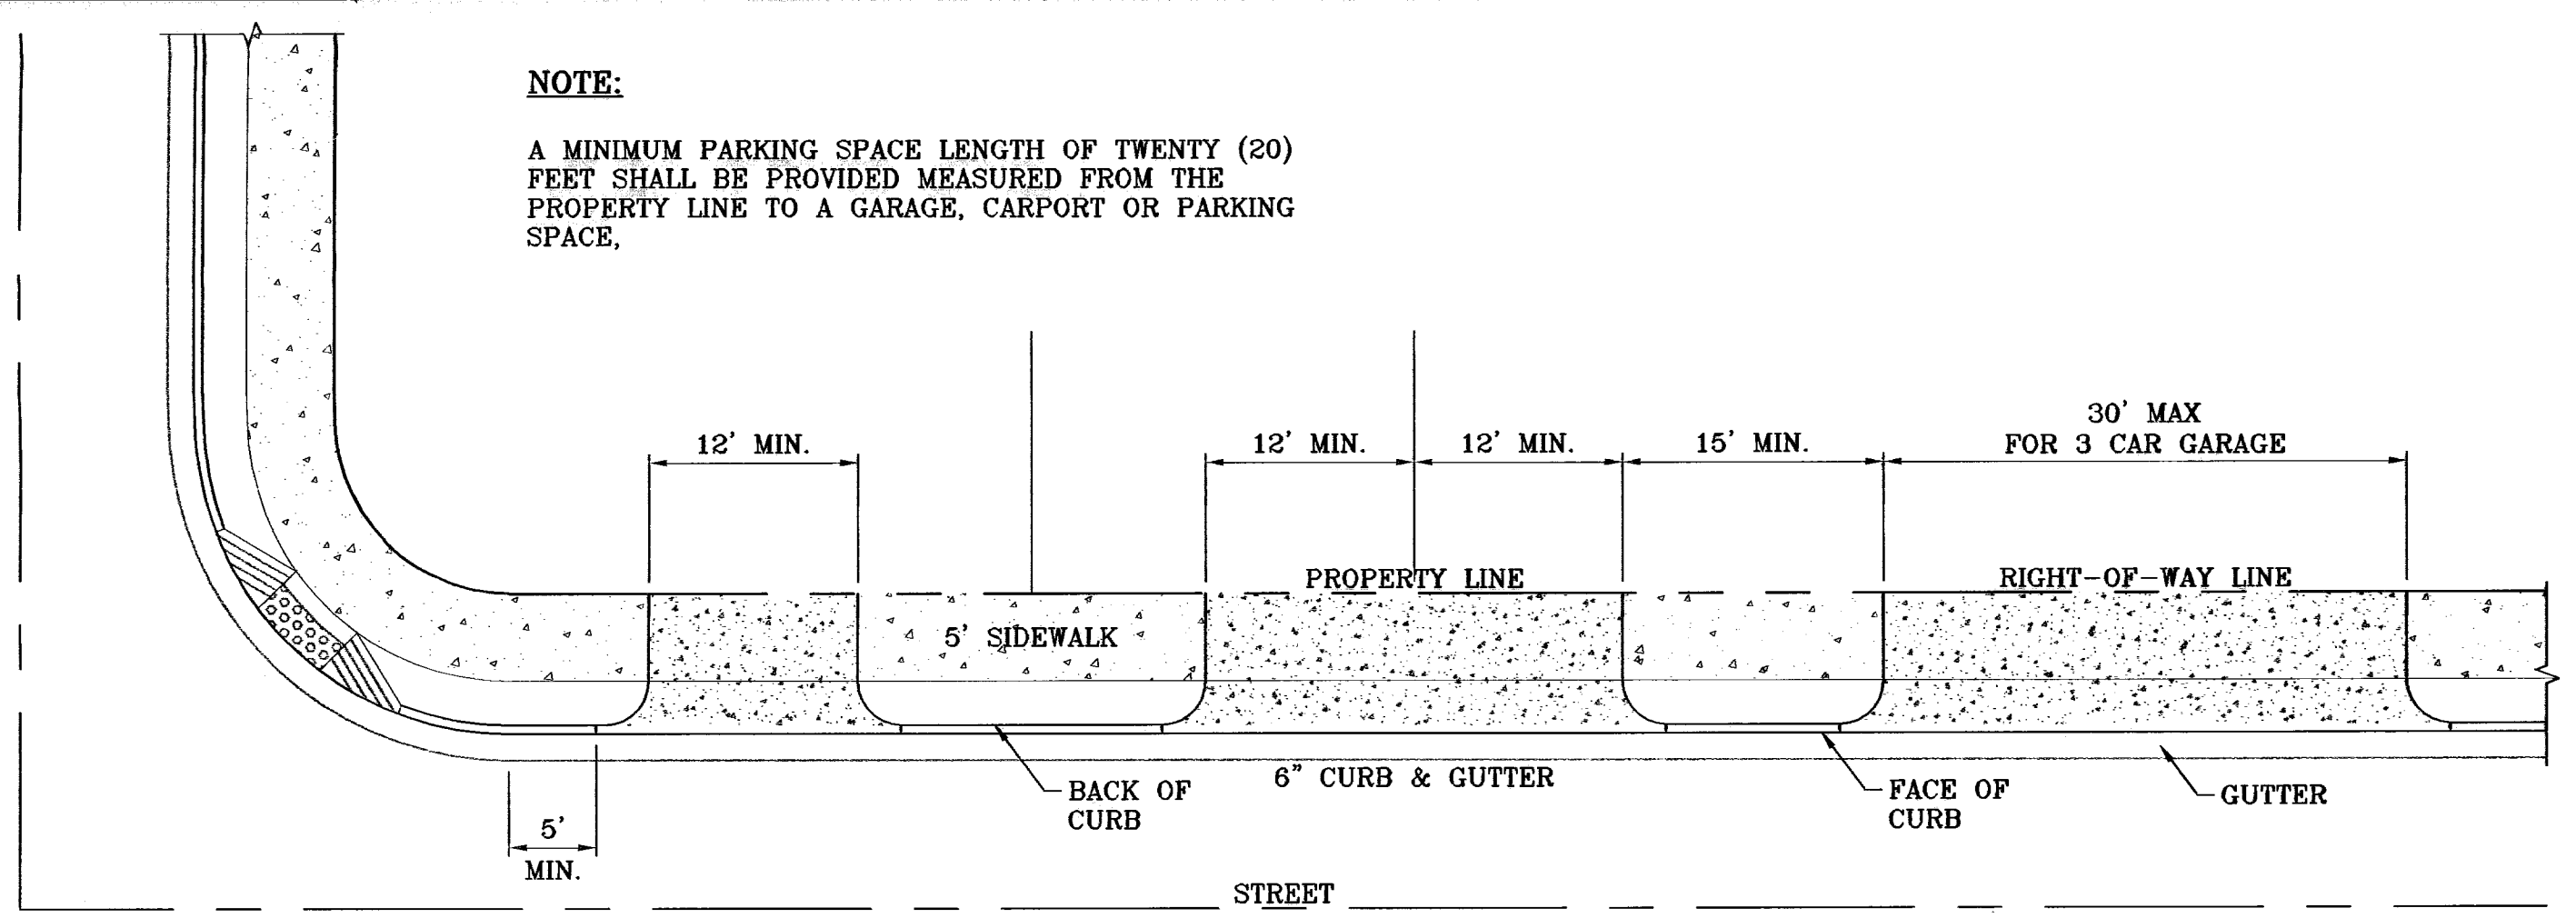

**NOTE:**

A MINIMUM PARKING SPACE LENGTH OF TWENTY (20) FEET SHALL BE PROVIDED MEASURED FROM THE PROPERTY LINE TO A GARAGE, CARPORT OR PARKING SPACE.


**TYPICAL RESIDENTIAL DRIVEWAY WITH CURB & GUTTER**  
SCALE: 1" = 10'

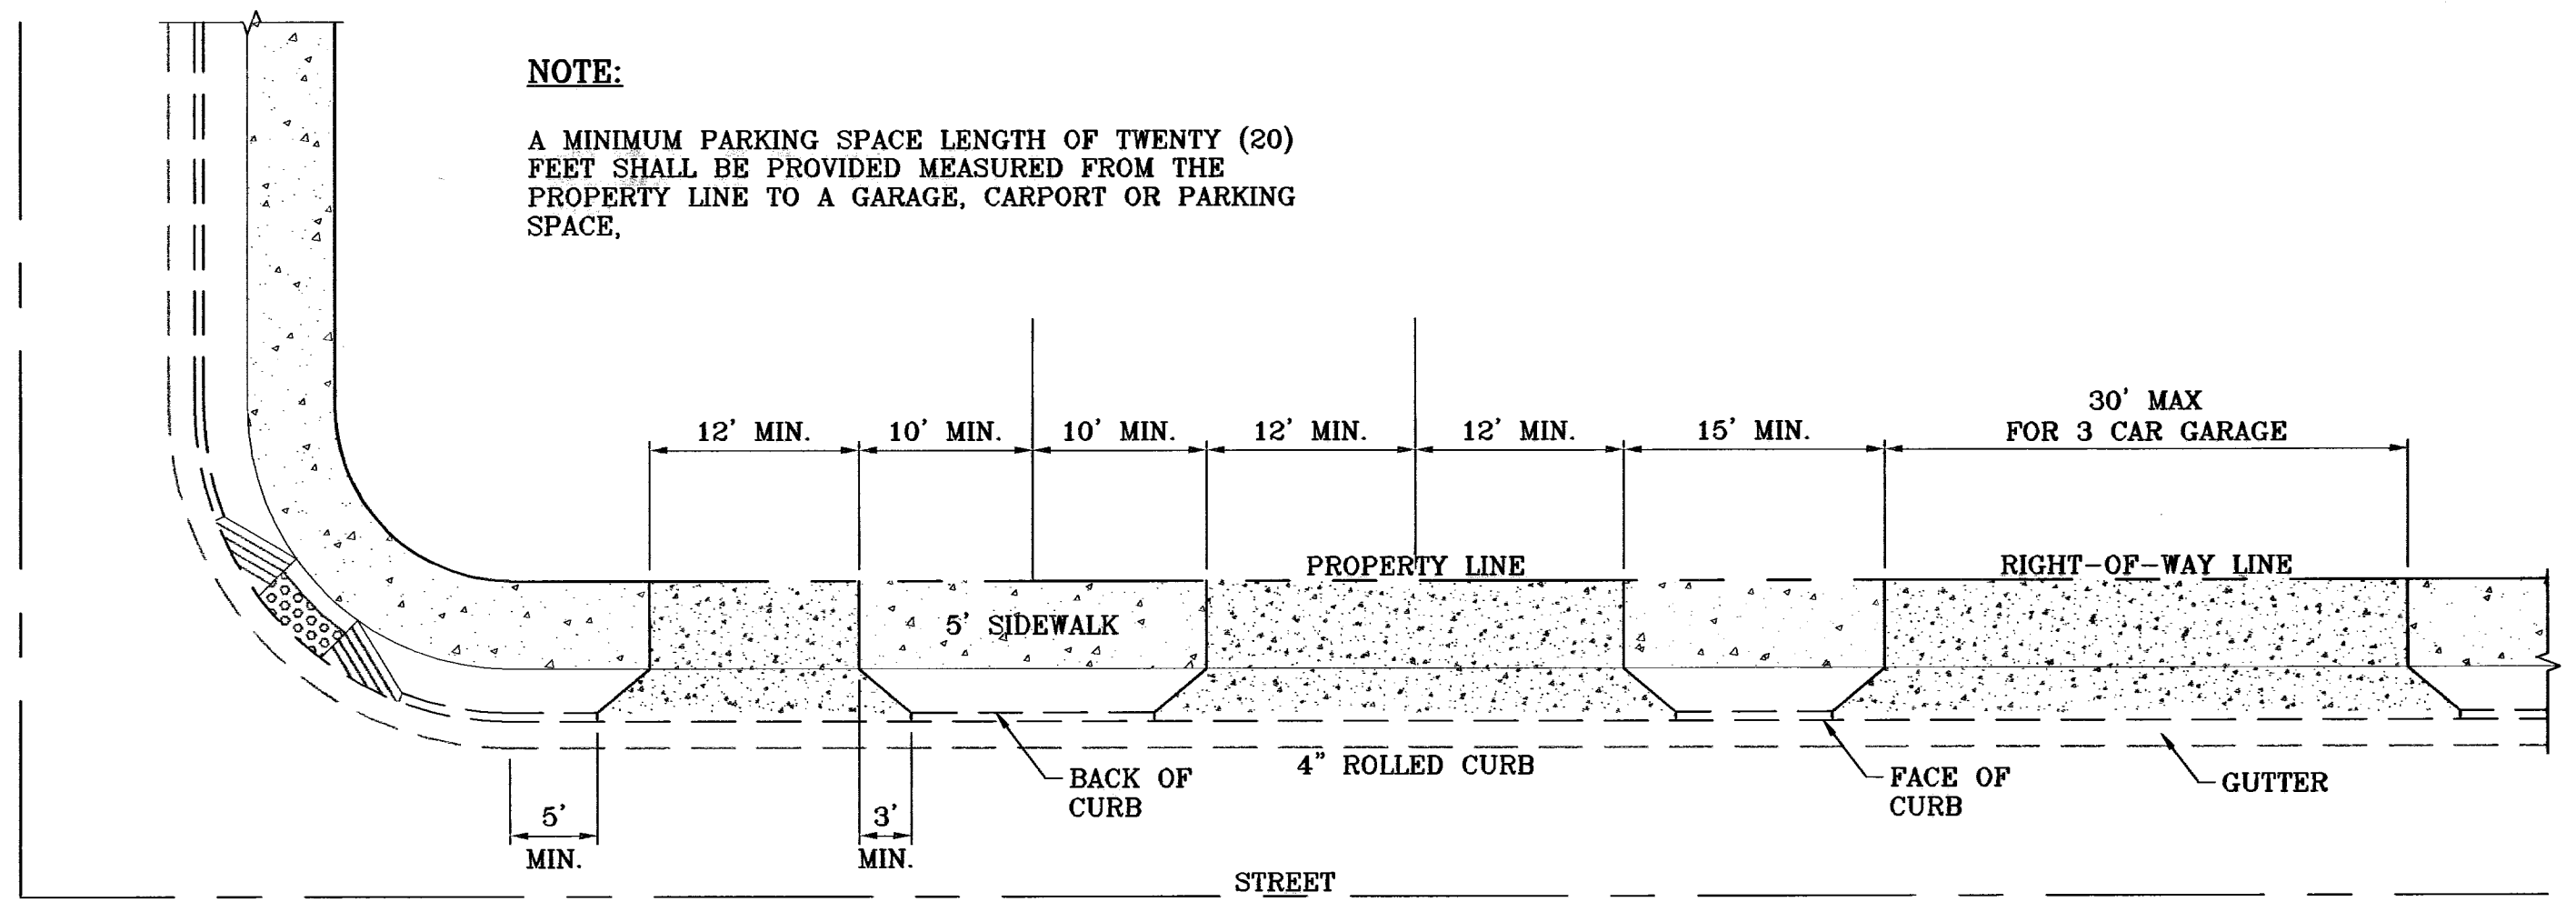

**NOTE:**


A MINIMUM PARKING SPACE LENGTH OF TWENTY (20) FEET SHALL BE PROVIDED MEASURED FROM THE PROPERTY LINE TO A GARAGE, CARPORT OR PARKING SPACE.

**TYPICAL RESIDENTIAL DRIVEWAY WITH ROLLED CURB**  
SCALE: 1" = 10'

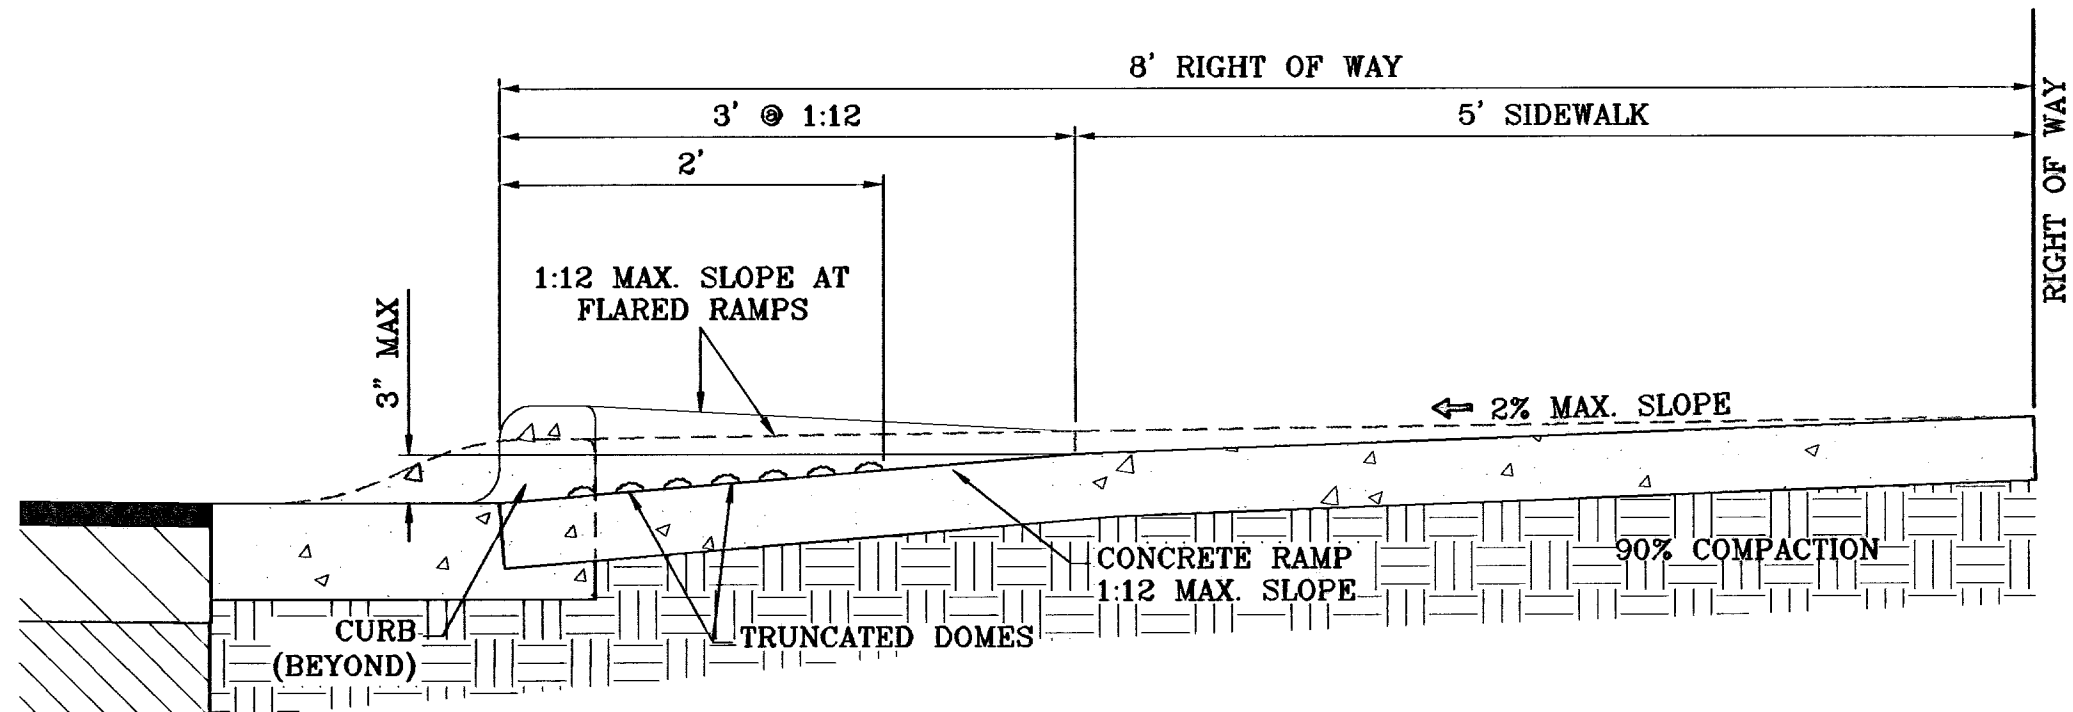


**TYPICAL WHEELCHAIR RAMP AT 4" ROLLED CURB/6" CURB & GUTTER**

SECTION Z  
SCALE: 1" = 1'

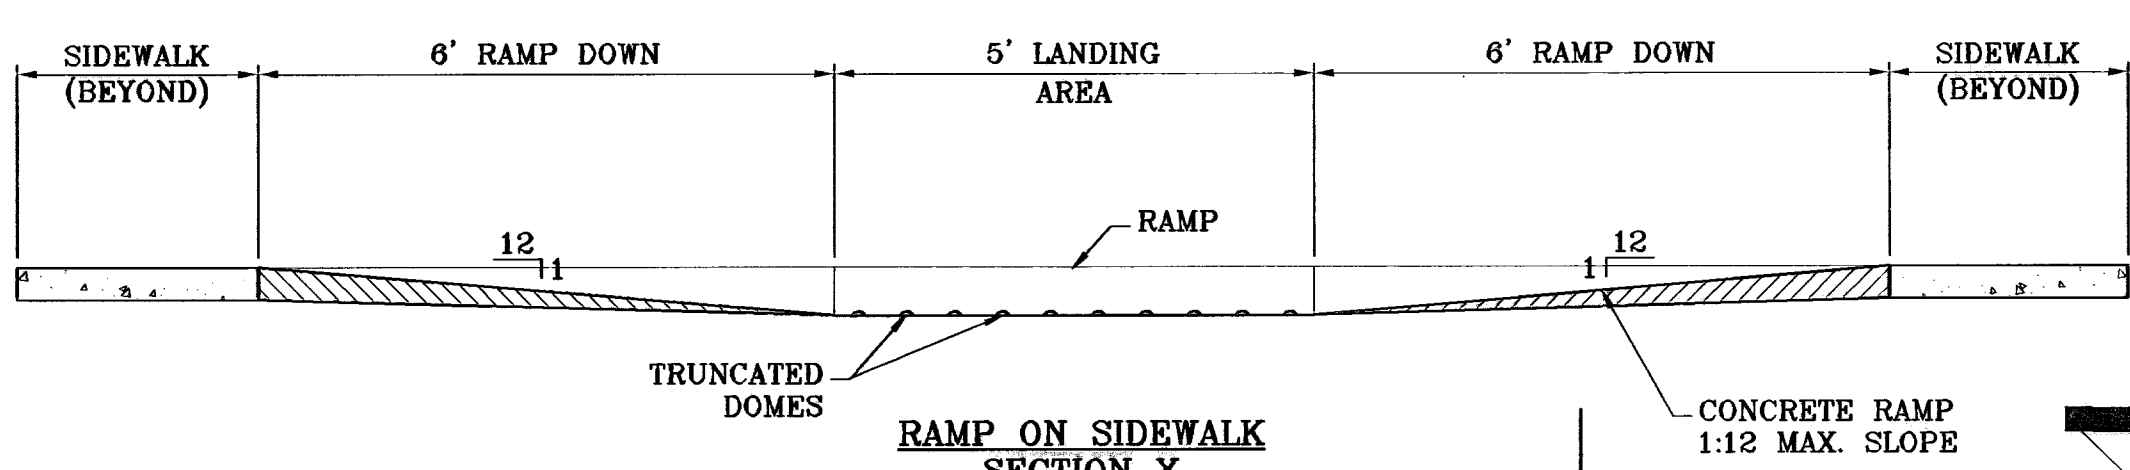


**RAMP ON SIDEWALK**


SECTION Y  
SCALE: 1" = 2'

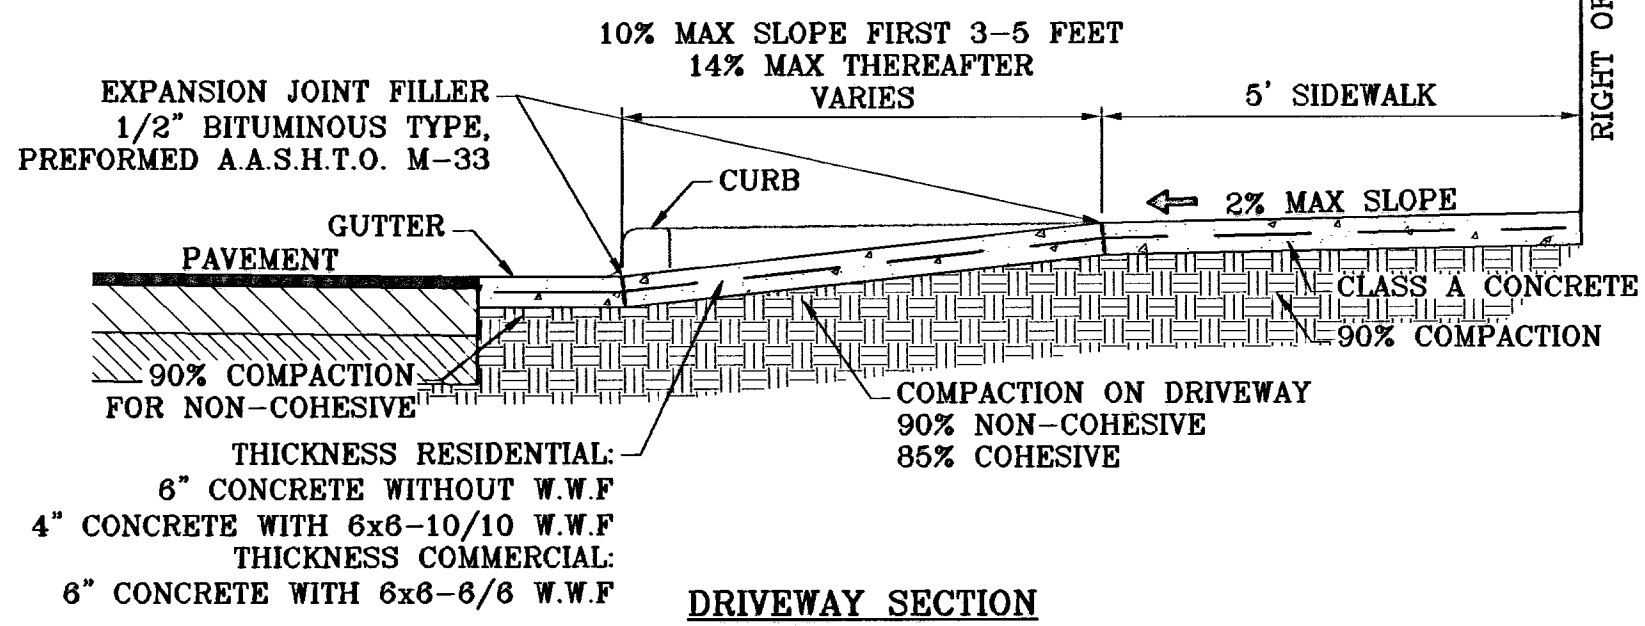

**DRIVEWAY SECTION**  
SCALE: 1" = 2'

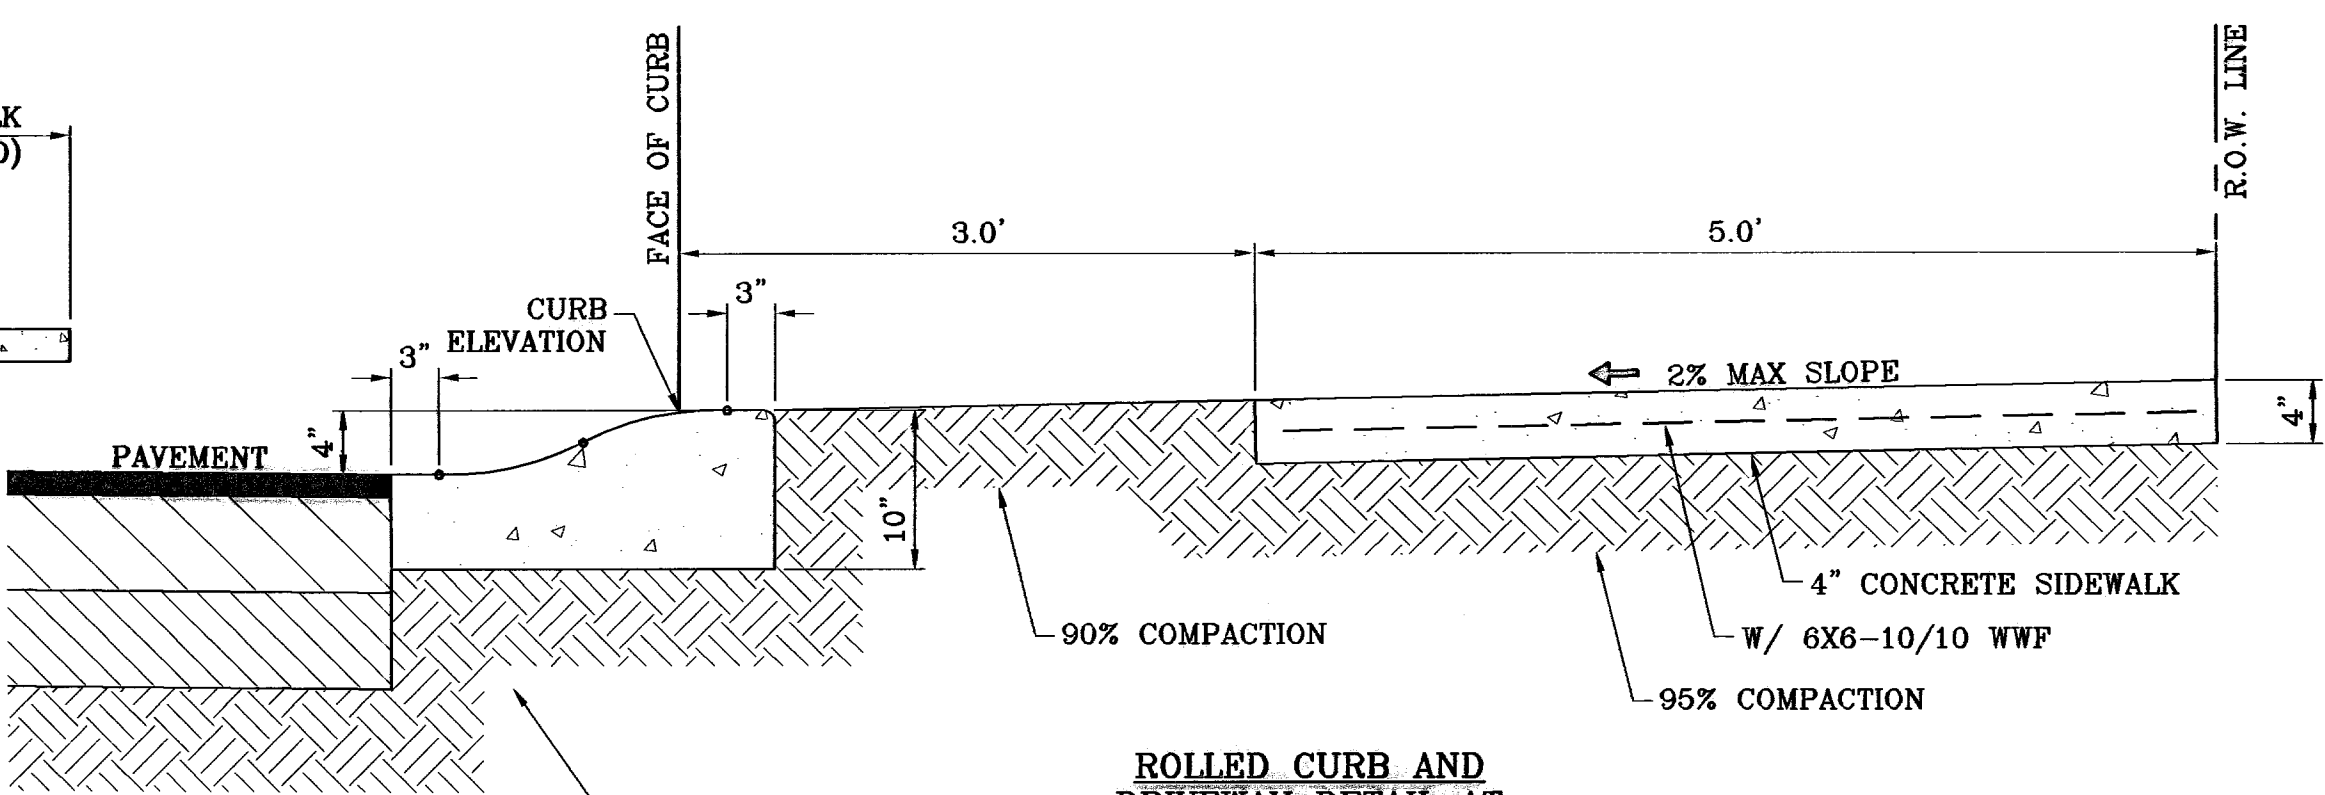

**ROLLED CURB AND DRIVEWAY DETAIL AT CUL-DE-SAC**  
SCALE: 1" = 1'

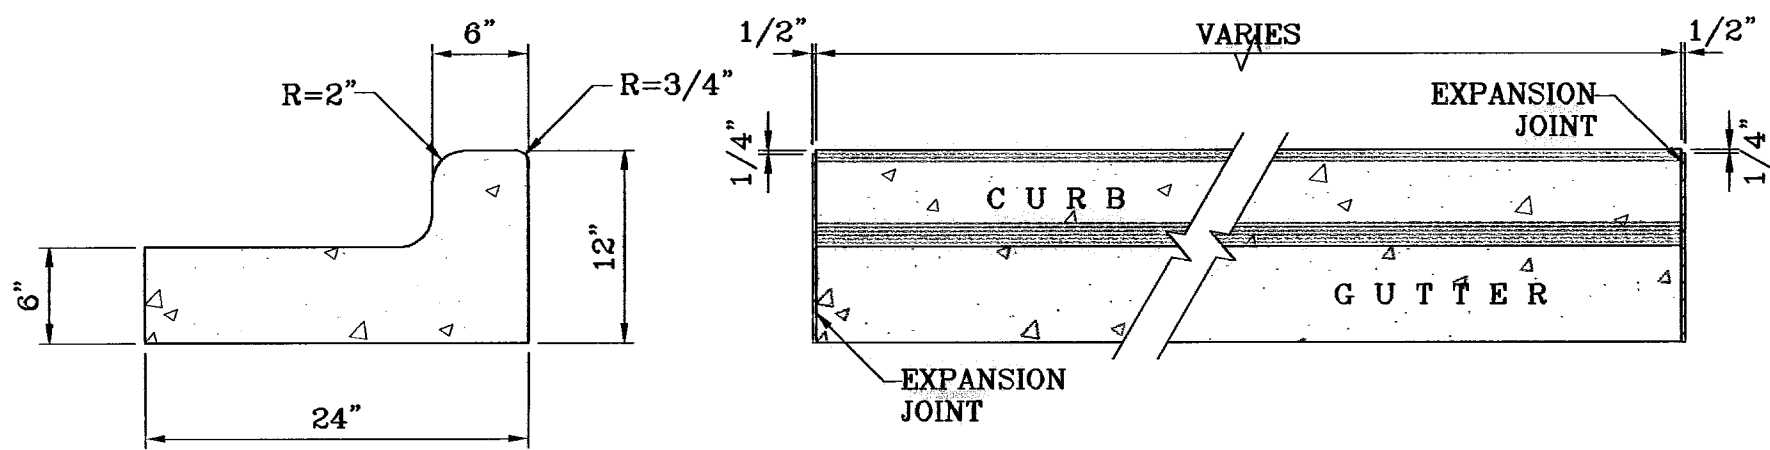


**END SECTION**

**PLAN VIEW**


**NOTES:**

1. NO EXPANSION JOINT WILL BE REQUIRED EXCEPT AT THE END OF CURB RETURNS. (POINT OF TANGENCY WITH STRAIGHT LINE).
2. CONTRACTION JOINTS (1/2" INCH MIN.) MUST BE SCORD EVERY 10 FEET IN CURB AND GUTTER.
3. ALL EXPANSION JOINTS WILL BE OF PREFORMED BITUMINOUS FIBER 1/2" INCH THICK.
4. CONCRETE: CLASS "A" 3000 PSI.
5. EXPANSION JOINTS REQUIRED AT 5' O.C. WHEN FORMING FOR CURBS.

**CURB & GUTTER DETAIL**  
SCALE: 1" = 1'

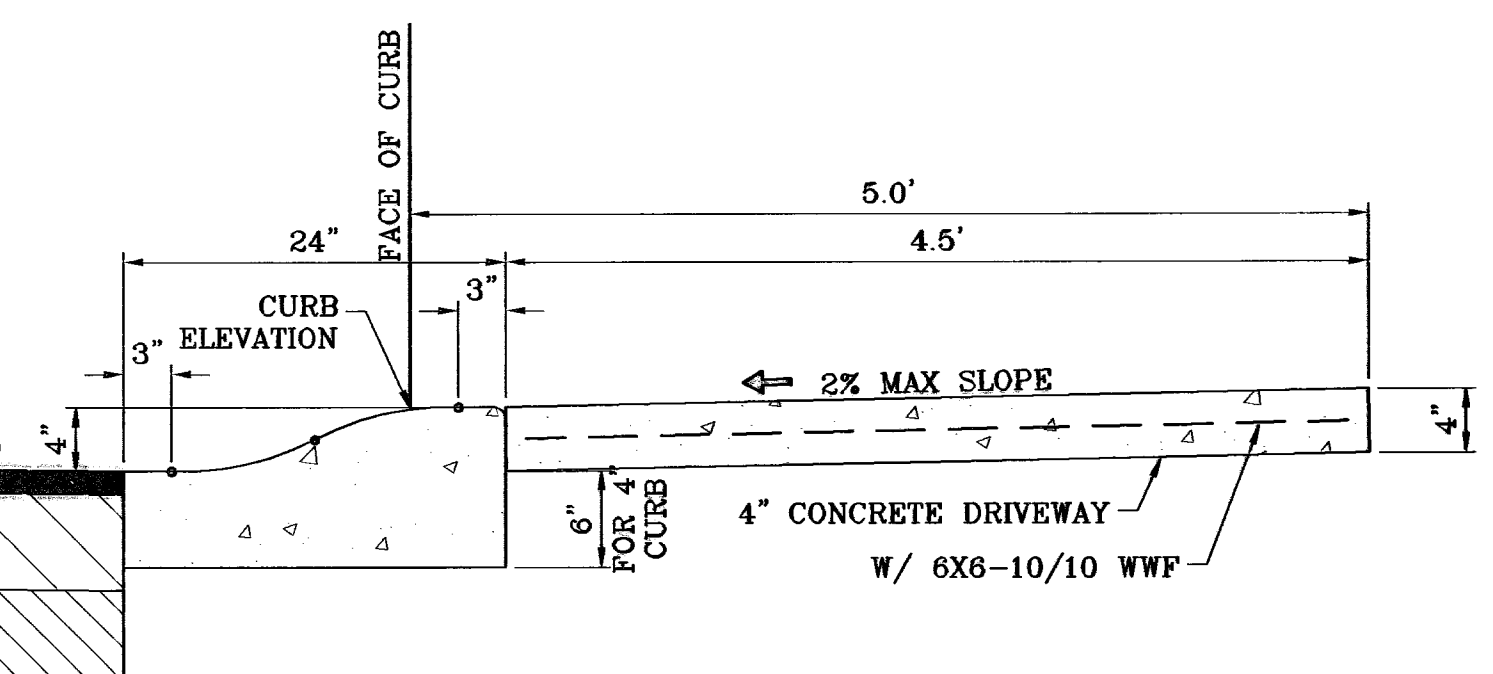


**ROLLED CURB AND DRIVEWAY DETAIL AT CUL-DE-SAC**  
SCALE: 1" = 1'

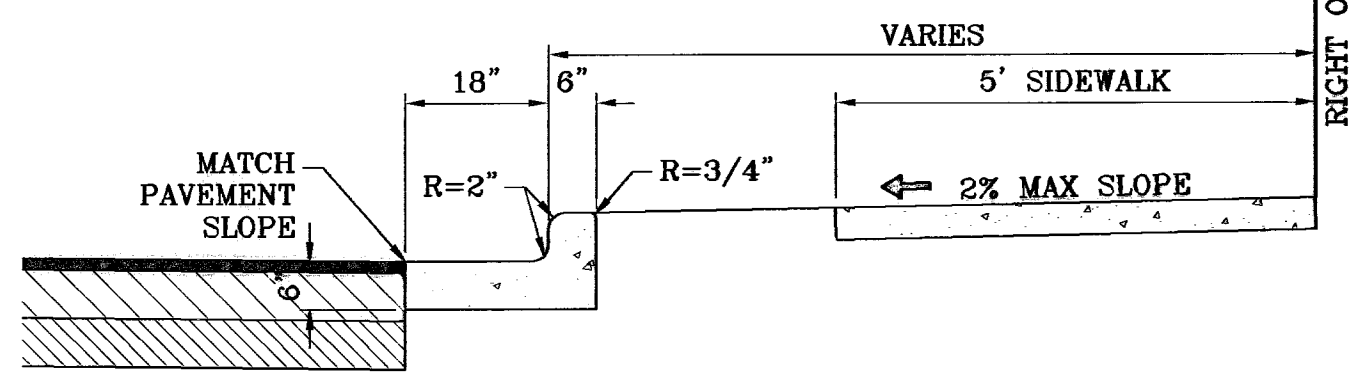

**NOTES:**

1. CONCRETE SHALL BE 3000 P.S.I. MINIMUM.
2. DUMMY JOINTS REQUIRED AT 10' O.C. FOR CURB/GUTTER AND 5' O.C. FOR SIDEWALK.
3. EXPANSION MATERIAL REQUIRED AT CURB RETURNS WITH 1/2" PREFORMED ASPHALT IMPREGNATED EXPANSION MATERIAL OR EQUAL.
4. EXPANSION JOINTS REQUIRED AT 50' O.C. WHEN FORMING FOR CURBS.
5. WHENEVER SIDEWALK ABUTS ROCK OR MASONRY STRUCTURES SUCH AS CURBS OR BUILDINGS, EXPANSION JOINT FILLER SHALL BE USED IN ACCORDANCE WITH STANDARD SPECIFICATIONS.

**CURB & GUTTER AND SIDEWALK DETAIL**  
SCALE: 1" = 2'

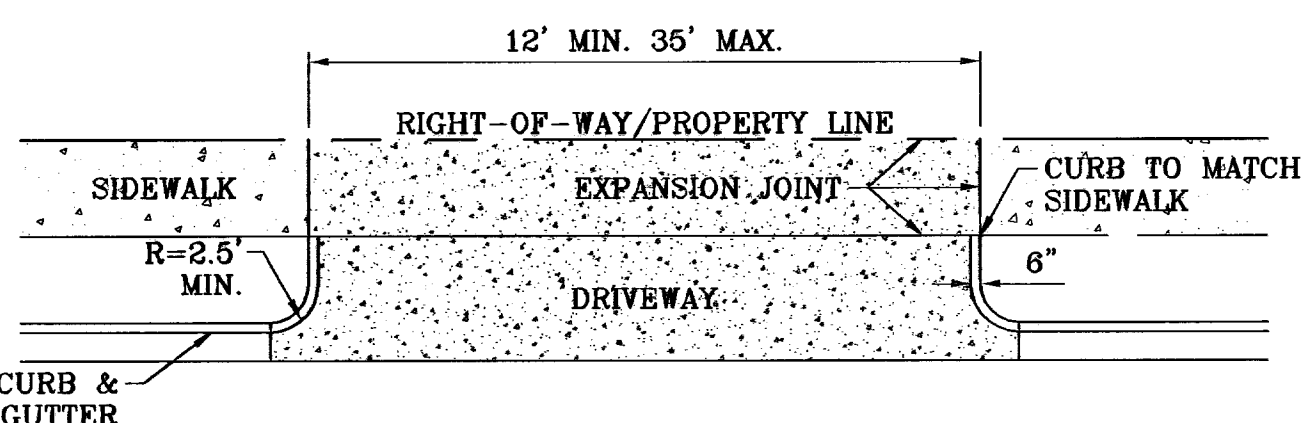

**DRIVEWAY DETAIL**  
SCALE: 1" = 10'

BENCHMARK	N/S MARKER: COPPER-CLAD STEEL ROD DESIGNATED "X 1118" PID "CE0141" ELEVATION: 3967.12
DATE	12/05/08
REVISIONS	CITY REDLINES AS PER 11/26/08 COMMENTS E.F.G.
BY	

**PROJECT NAME**  
TIERRA DEL ESTE  
UNIT FIFTY NINE

**SCALE**  
HORIZ. AS NOTED  
VERT. ---


**ENGINEER'S SEAL**  
ENGINEER'S SEAL NOT REQUIRED.  
IS PRODUCED FROM CITY SUBDIVISION DESIGN STANDARDS


**DATE:** MAY 2008  
**DESIGN BY:** Y.C.  
**INITIATED BY:** O.M.  
**CHECKED BY:** Y.C.  
**JOB NO.:** 608-23

**REVISIONS**


BEING A PORTION OF SECTION 38, BLOCK 79, TOWNSHIP 2, TEXAS AND PACIFIC RAILROAD COMPANY SURVEYS, CITY OF EL PASO, EL PASO COUNTY, TEXAS, CONTAINING 28.969 ACRES.

**CONDE INC.**  
ENGINEERING / PLANNING  
SURVEYING / GPS  
1790 LEE TRIVINO SITE 400  
EL PASO, TEXAS 79966



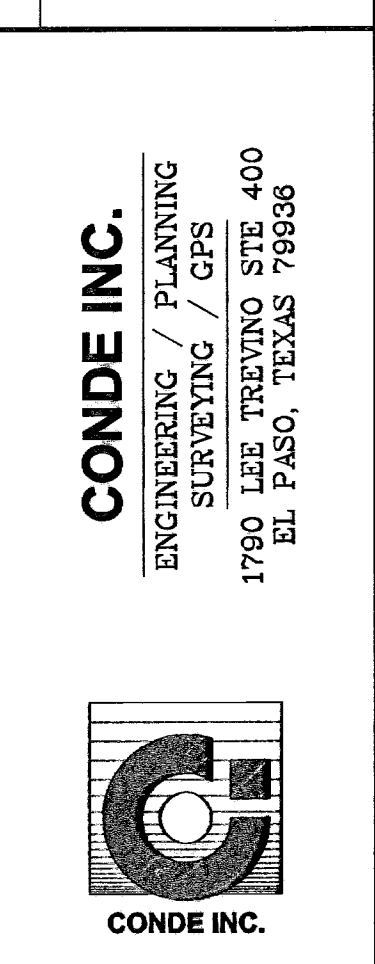


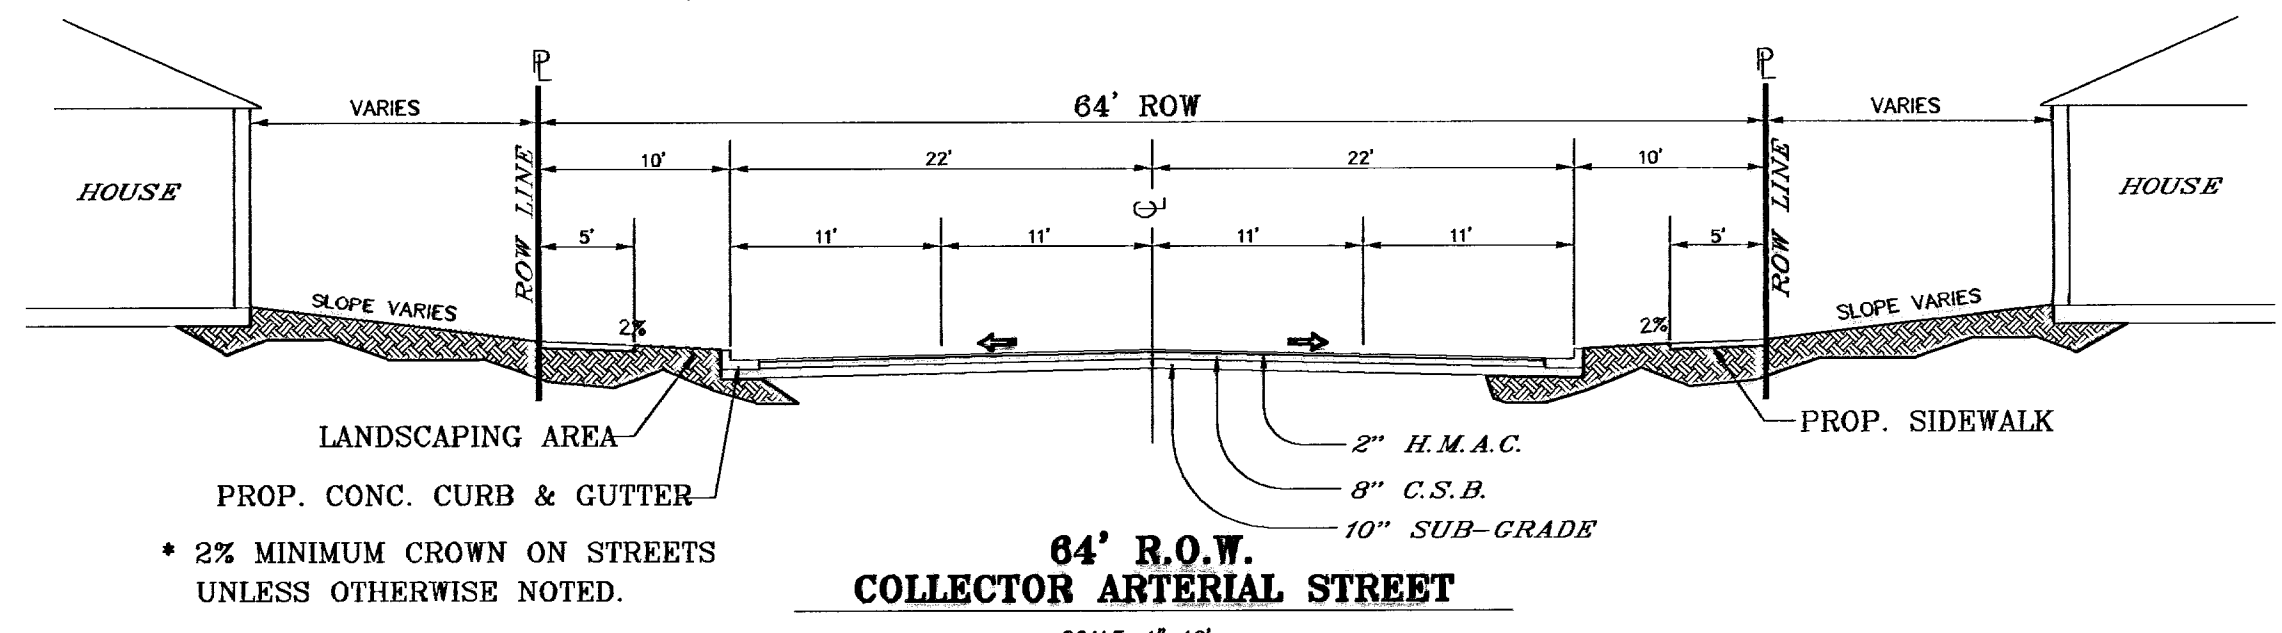

**64' R.O.W. COLLECTOR ARTERIAL STREET**  
SCALE: 1"=10'

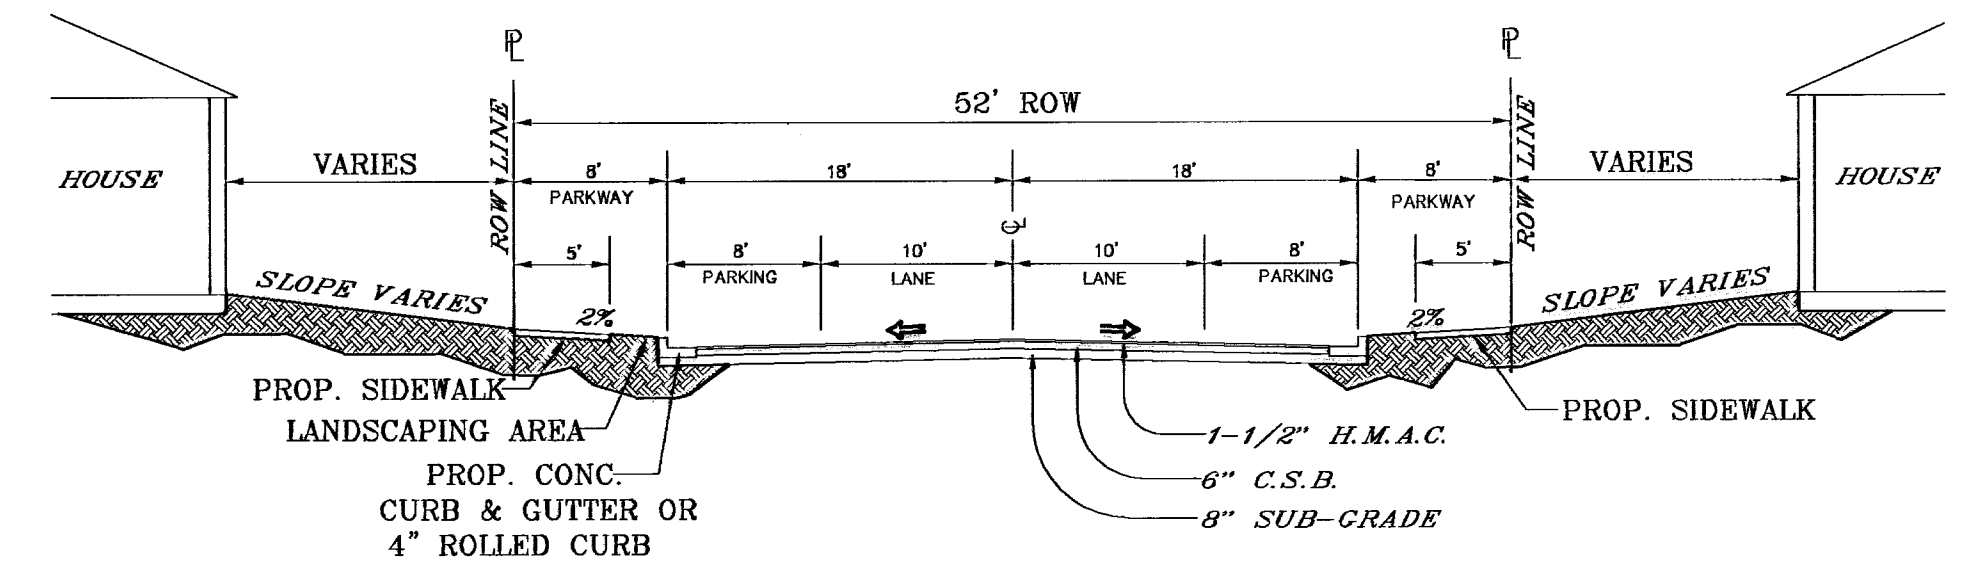

**52' R.O.W. RESIDENTIAL SUBCOLLECTOR STREET - & PEDESTRIAN R.O.W.**  
SCALE: 1"=10'

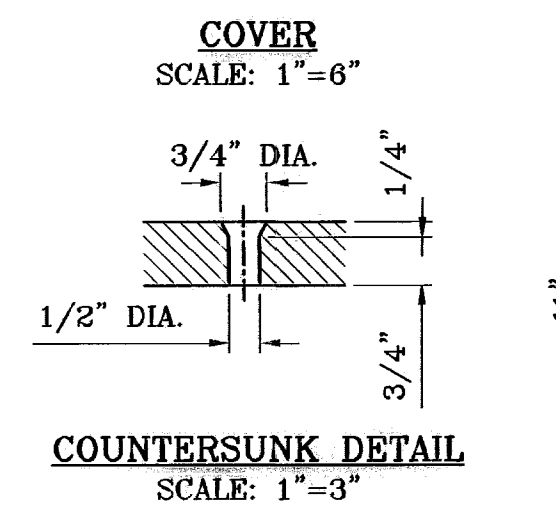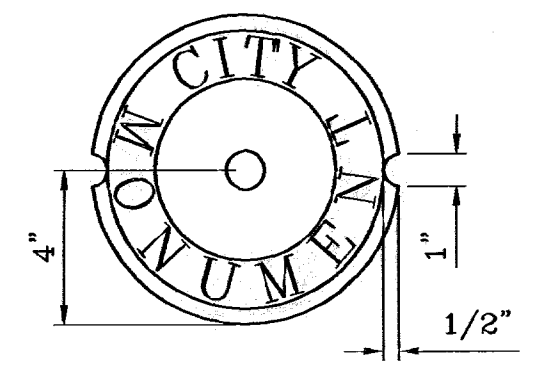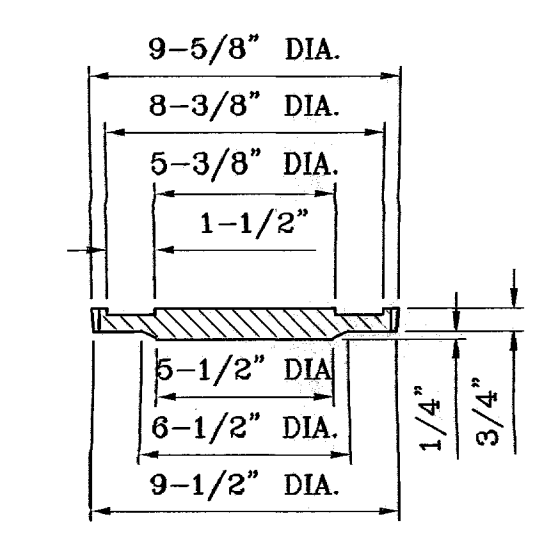

**SIZE AND CONSTRUCTION:**

THE STANDARD CITY MONUMENT SHALL BE POURED-IN-PLACE CONCRETE CONE. EIGHT (8) INCHES MINIMUM DIAMETER AT THE TOP, EIGHTEEN (18) INCHES MINIMUM DIAMETER AT THE BOTTOM, THIRTY-SIX (36) INCHES MINIMUM IN DEPTH WITH THE MONUMENT CAP IN PLACE ON TOP.

THE MONUMENT SHALL BE COVERED WITH A CAST IRON BOX AND COVER.




**NUMBER AND LOCATIONS:**

THE MONUMENTS SHALL BE INSTALLED WHERE SHOWN ON THE SUBDIVISION PLAT AS APPROVED BY THE CITY ENGINEER.


THE SIZE, TOPOGRAPHY AND LAYOUT OF THE SUBDIVISION SHALL GOVERN MONUMENT MUST BE WITHIN THE LINE OF SIGHT OF ANY OTHER MONUMENT (2000 FEET MAXIMUM DISTANCE BETWEEN MONUMENTS). THE NUMBER OF MONUMENTS REQUIRED.

NO FEWER THAN TWO MONUMENTS SHALL BE PLACED IN A ONE STREET SUB-DIVISION.


AT LEAST ONE (1) MONUMENT SHALL BE PLACED ON EACH HORIZONTAL CURVE. TWO SHALL BE PLACED IF THE POINT OF INTERSECTION (P.I.) OF THE TANGENTS LEADING INTO THE CURVE FALLS OUTSIDE OF CITY RIGHT-OF-WAY. MONUMENTS SHALL BE INSTALLED SO THAT ALL FRONT PROPERTY CORNERS OF ALL LOTS IN THE SUBDIVISION ARE WITHIN LINE OF SIGHT OF A MONUMENT, OR WITHIN SIGHT OF LINE BETWEEN TWO ADJACENT MONUMENTS.

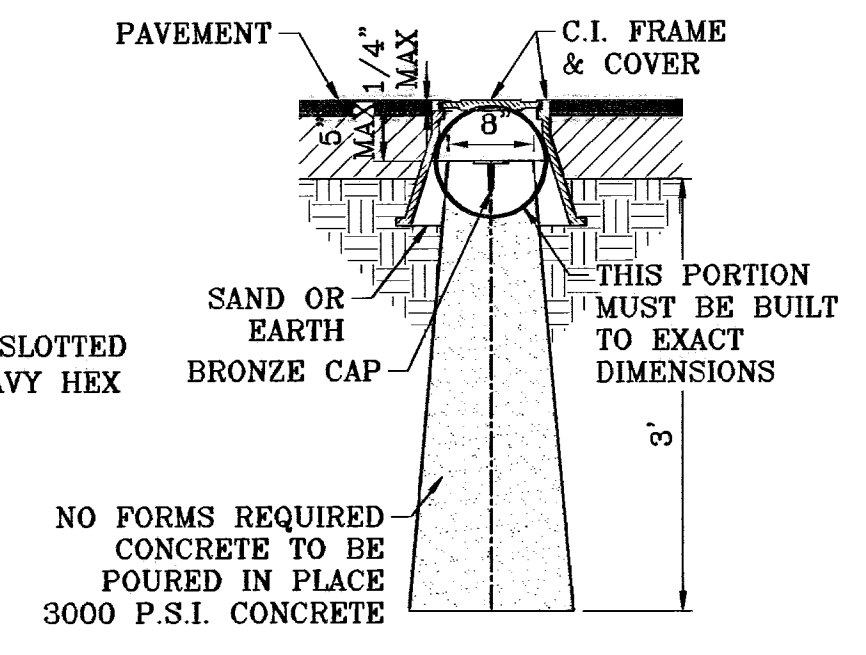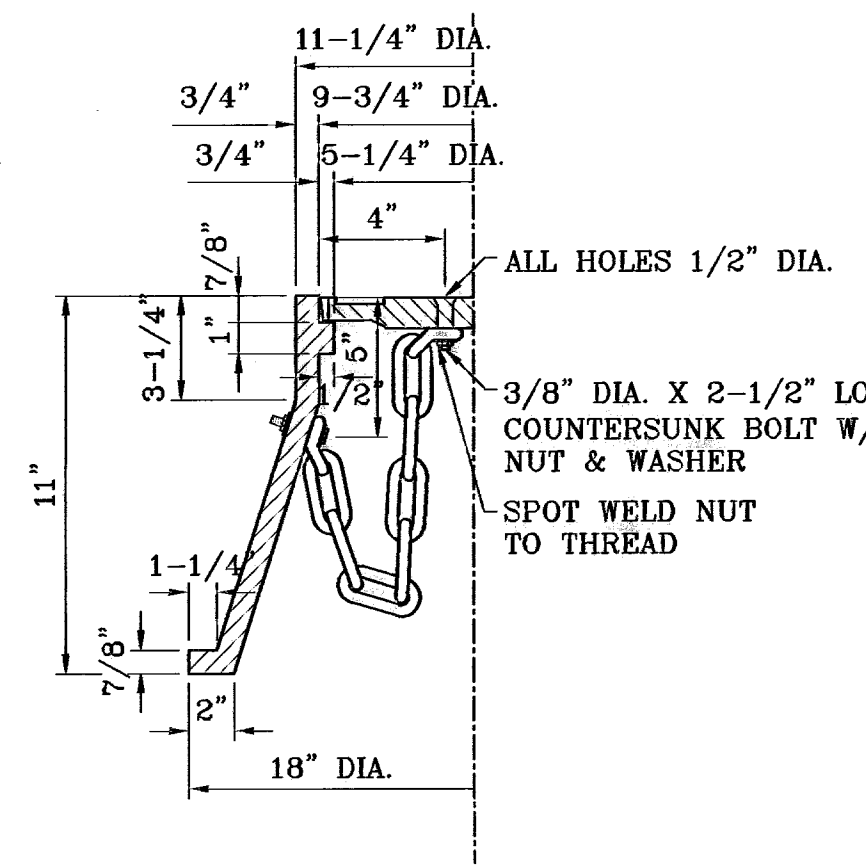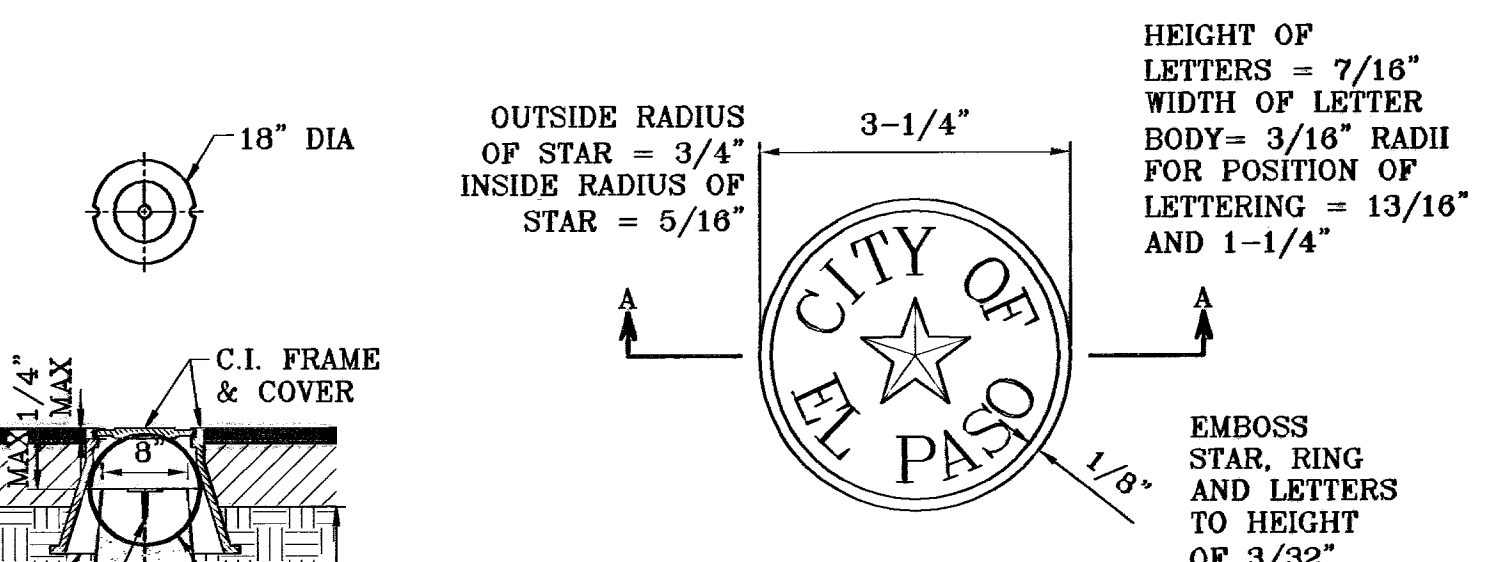


**CITY MONUMENT DETAIL**  
SCALE: 1"=2"

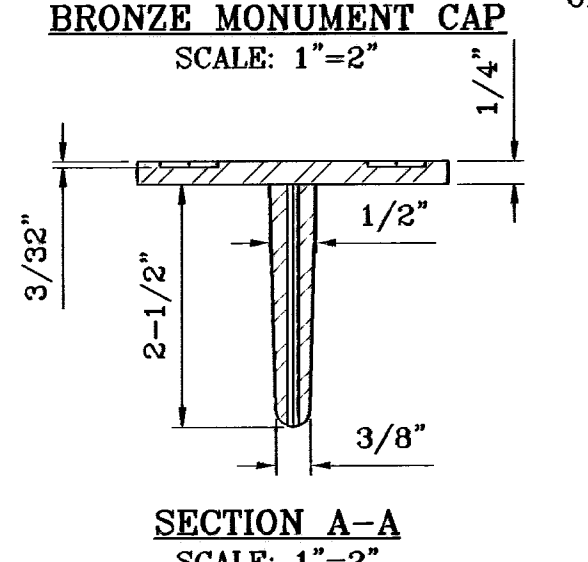


**SECTION A-A**  
SCALE: 1"=2"

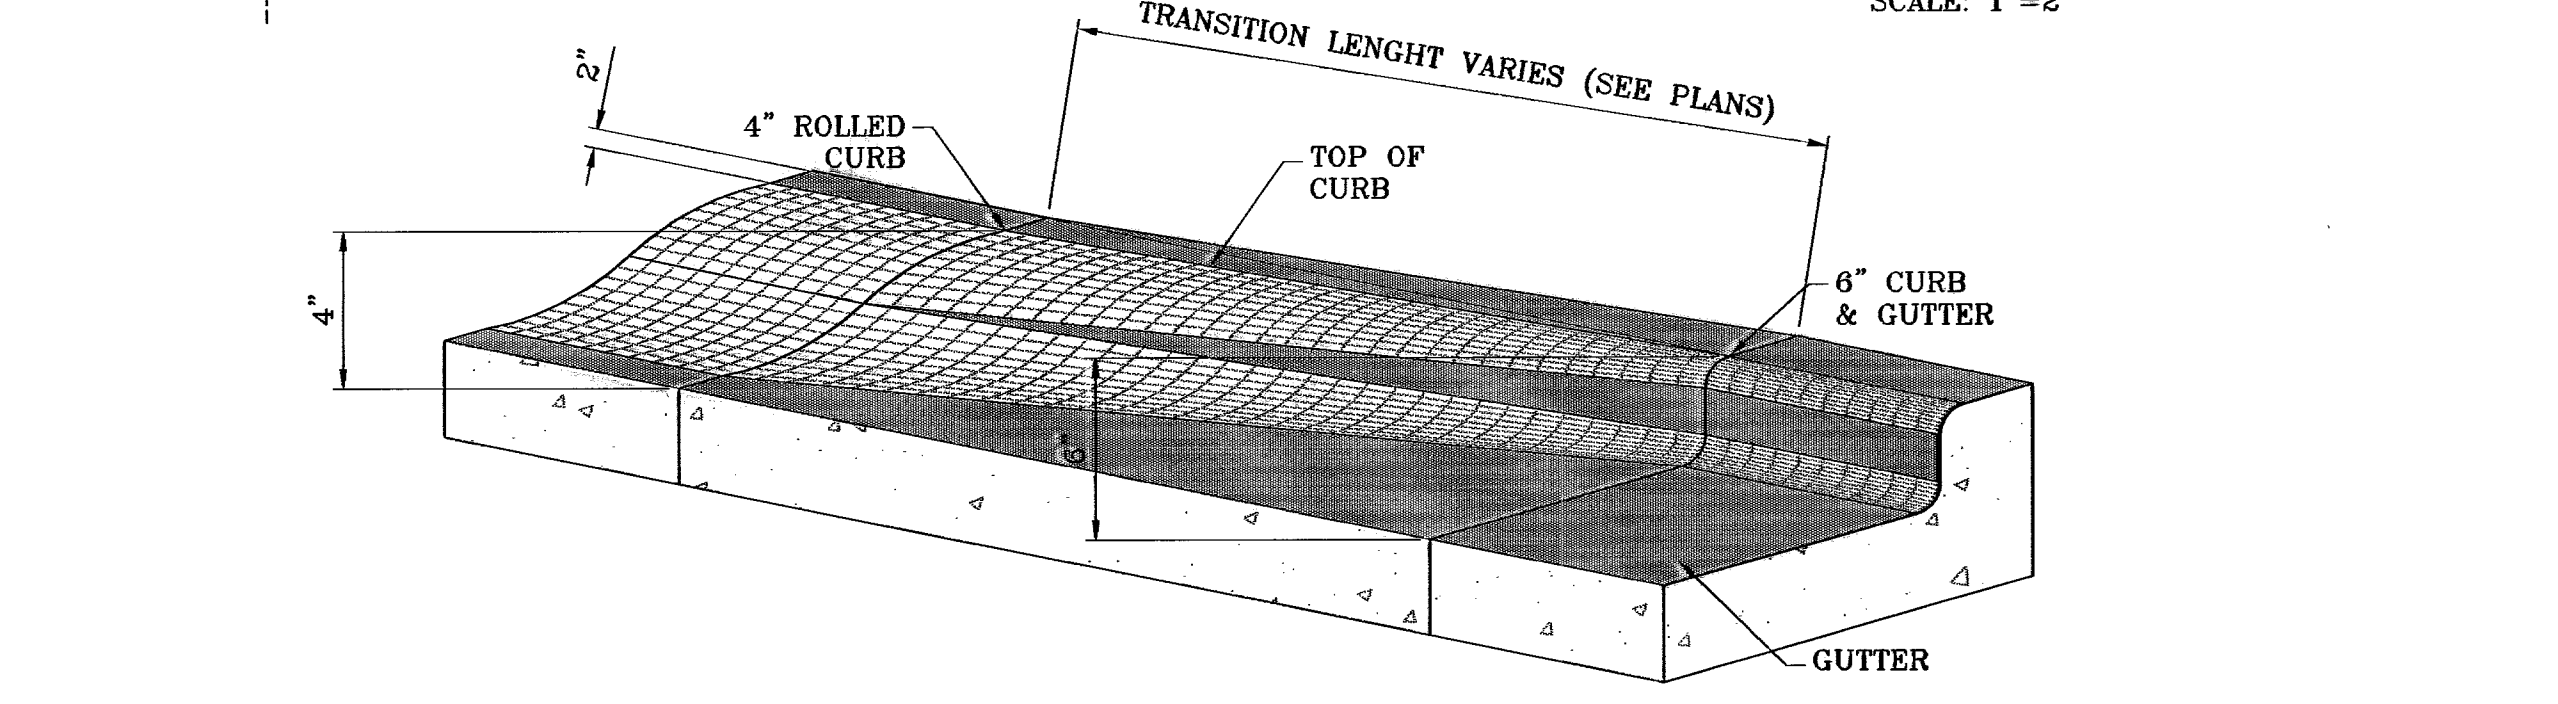


**ROLLED CURB TO CURB & GUTTER TRANSITION**  
SCALE: 1"=1'

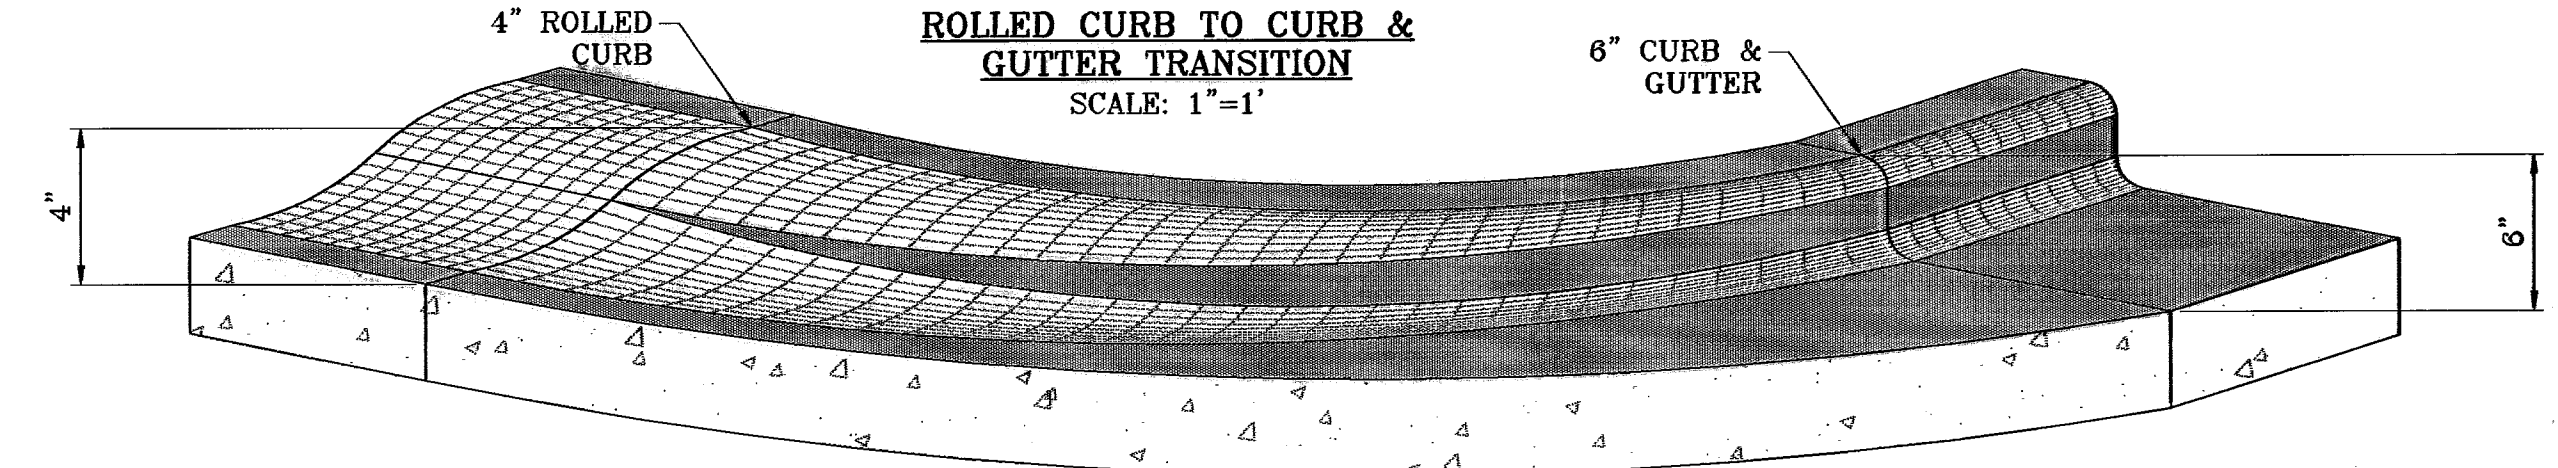


**CURB TRANSITION AT RETURNS**  
SCALE: 1"=1'

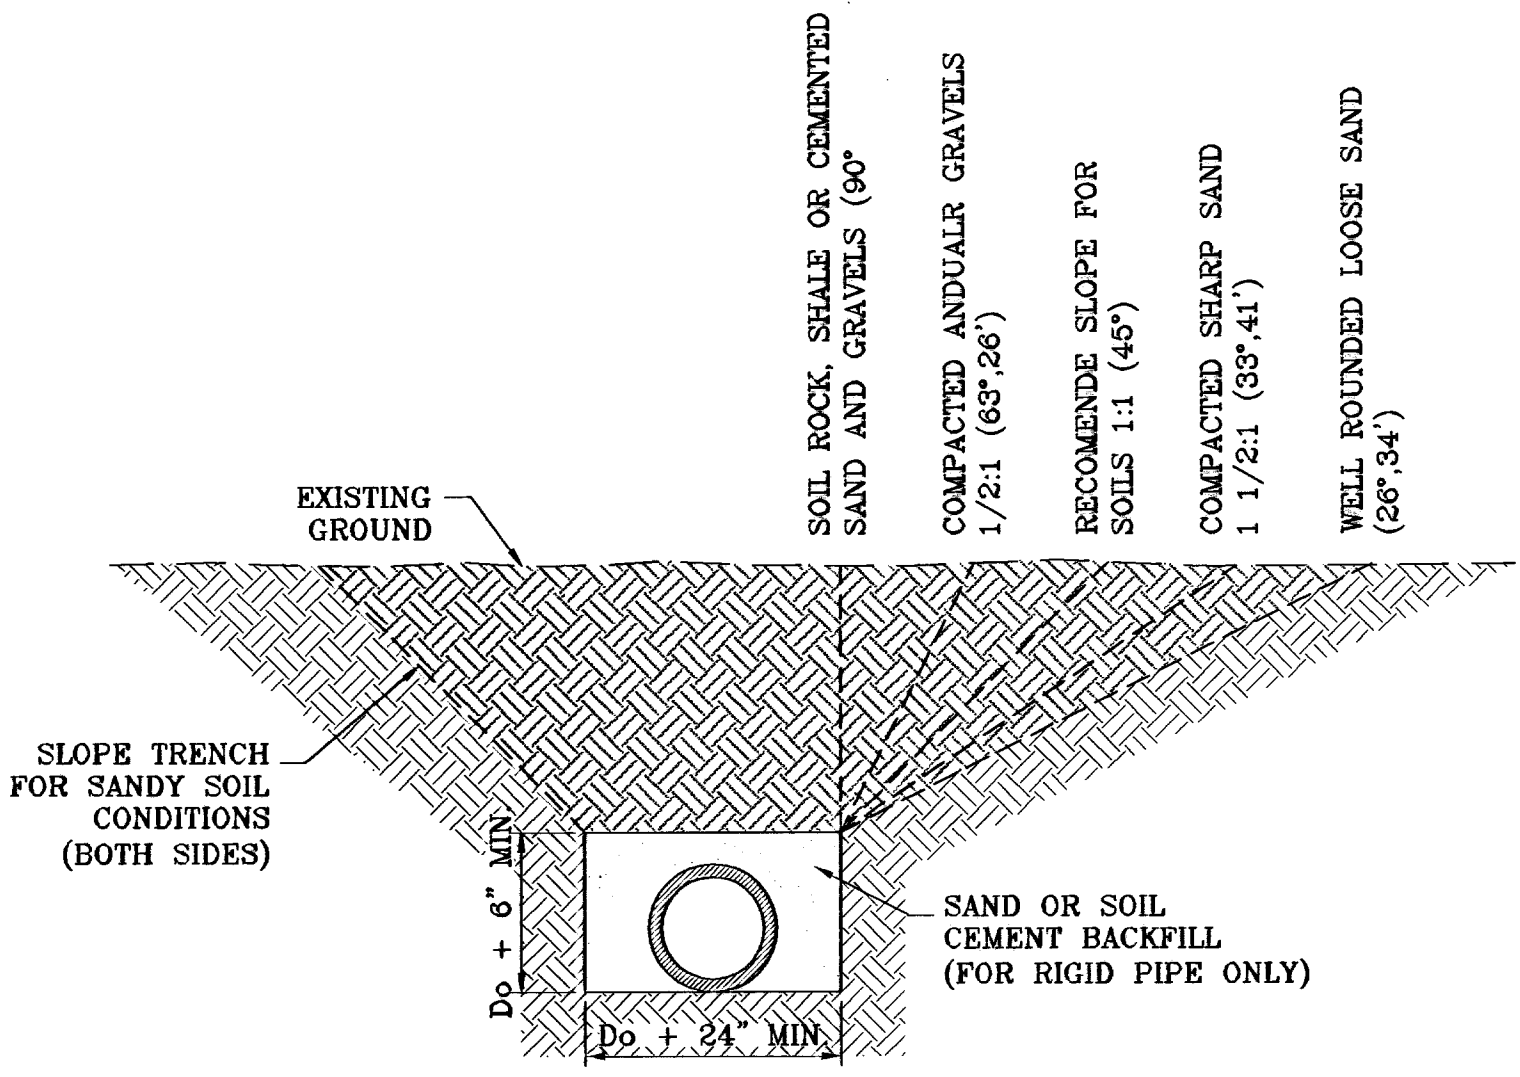


**TYPICAL TRENCH SECTION**  
SCALE: 1"=3'

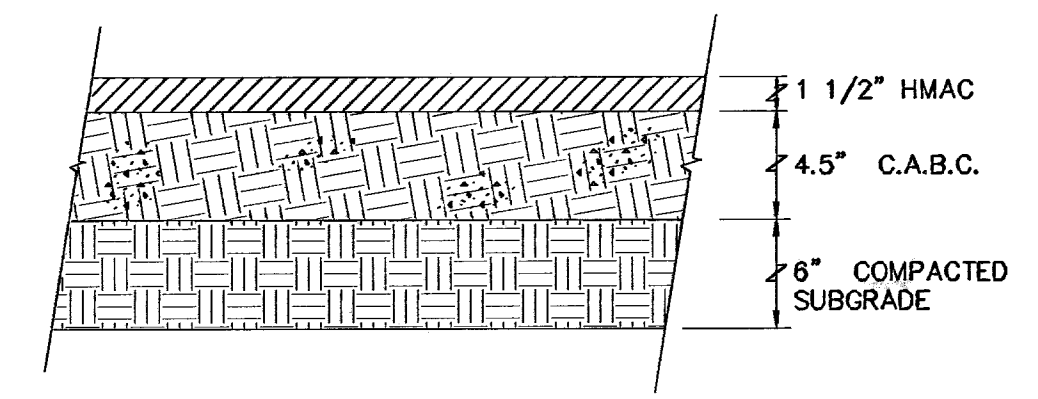


**TYPICAL PAVEMENT SECTION PEDESTRIAN R.O.W.**  
NOT TO SCALE

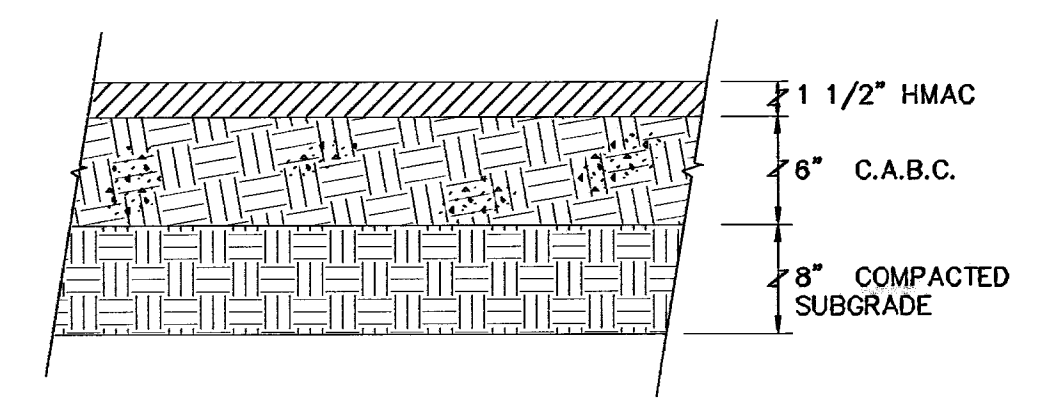

**TYPICAL PAVEMENT SECTION 52' RESIDENTIAL SUBCOLLECTOR STREETS**  
NOT TO SCALE

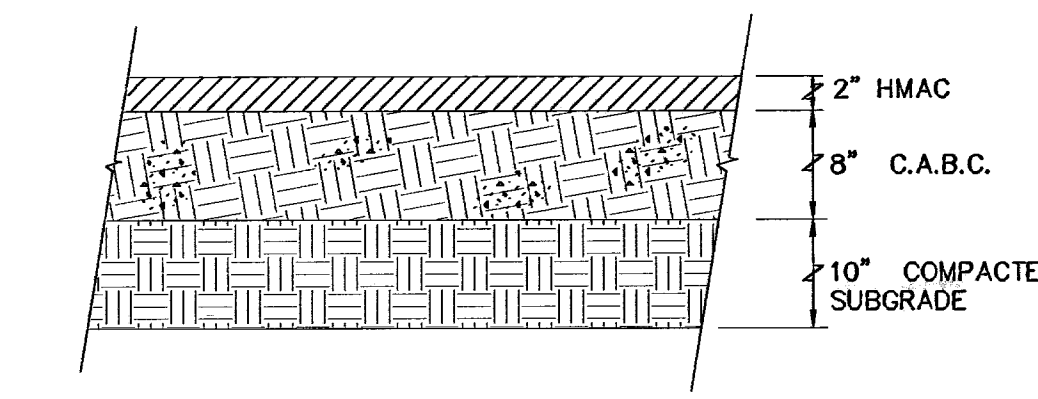


**TYPICAL PAVEMENT SECTION 64' COLLECTOR ARTERIAL STREETS**  
NOT TO SCALE

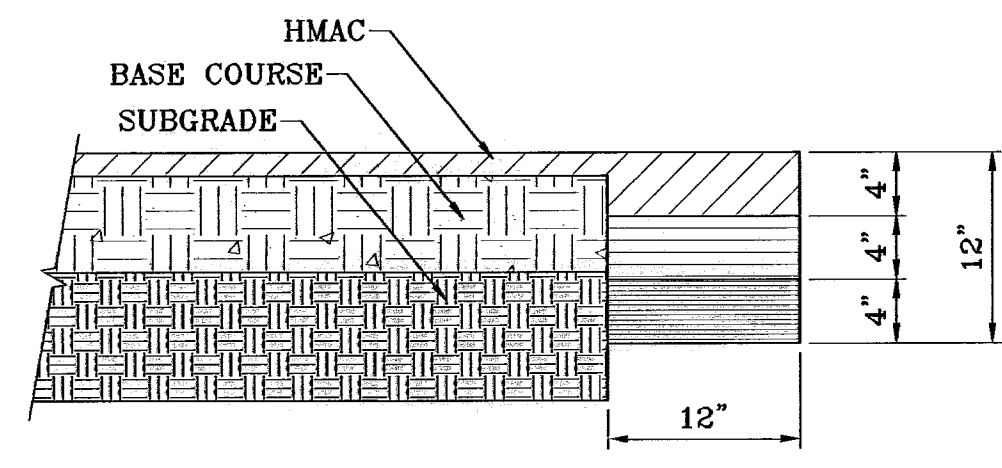


**PAVEMENT TERMINUS**  
SCALE: 1"=1'

**NOTE:**  
THICKENED EDGE SHALL BE CONSTRUCTED IN COURSED NOT OVER 4" IN THICKNESS, EACH COURSE THOROUGHLY COMPACTED BEFORE PLACING NEXT COURSE, FINAL COURSE. FINAL COURSE TO BE PLACED MONOLITHIC WITH PAVEMENT.

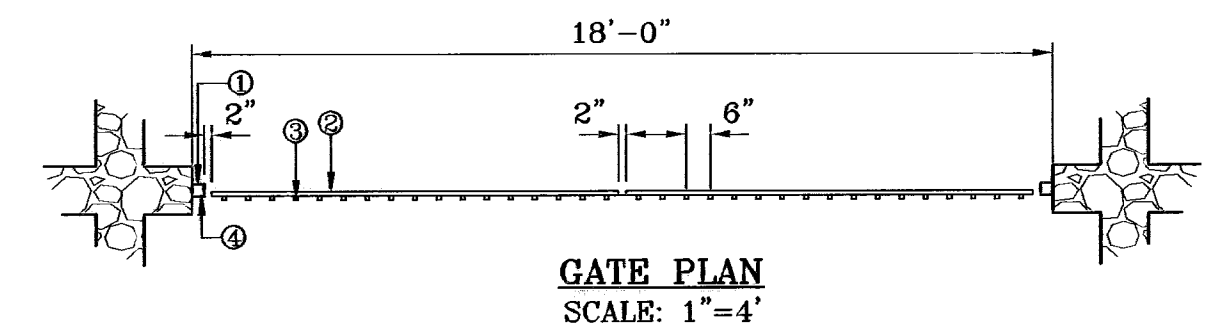


**GATE PLAN**  
SCALE: 1"=4'

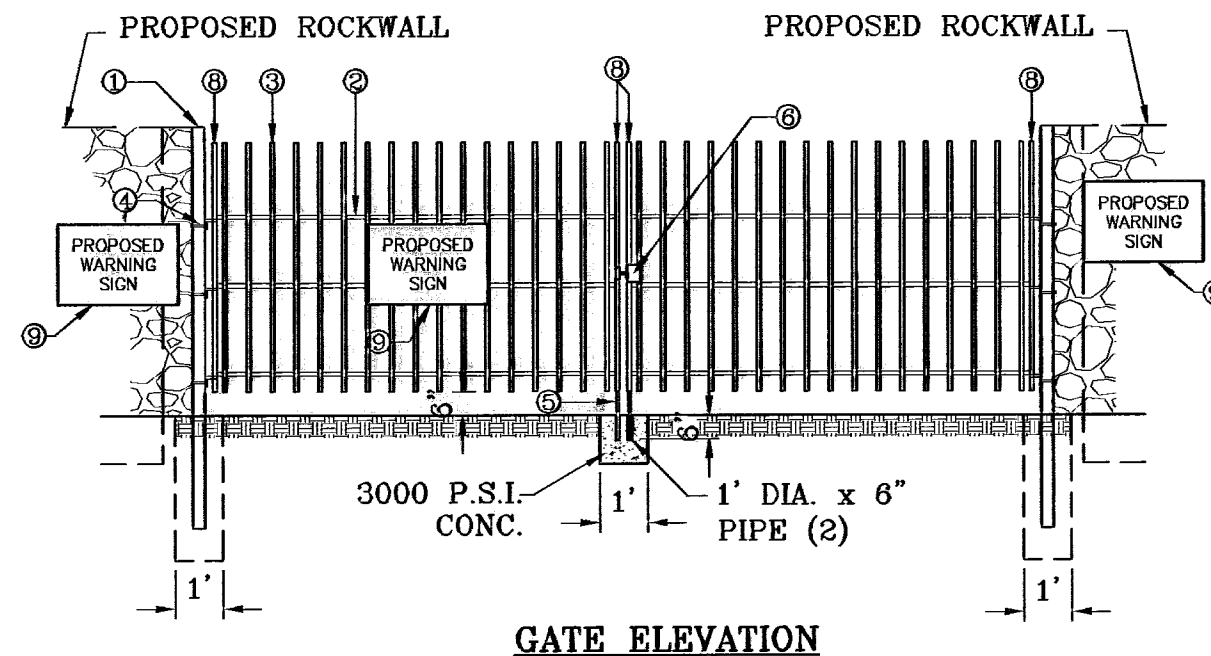

**GATE ELEVATION**  
SCALE: 1"=4'

- ① 3"x3"x3/16" SQUARE STEEL TUBING
- ② 2"x1"x14 GA. RECTANGULAR STEEL TUBING
- ③ 1 1/2"x1/2"x16 GA. RECTANGULAR STEEL TUBING
- ④ BOLT HOOK AND STRAP HINGE
- ⑤ CANE BOLT LATCH W/ KEEPER 5-8"x18" LONG (2 REQUIRED)
- ⑥ DOUBLE GATE HEAVY DUTY INDUSTRIAL LATCH W/ PAD LOCK
- ⑦ FLAT TOP POLYVINYL CAP
- ⑧ 2"x1"x10 GA. RECT. STL. TUBING
- ⑨ ALTERNATE WARNING SIGN LOCATIONS

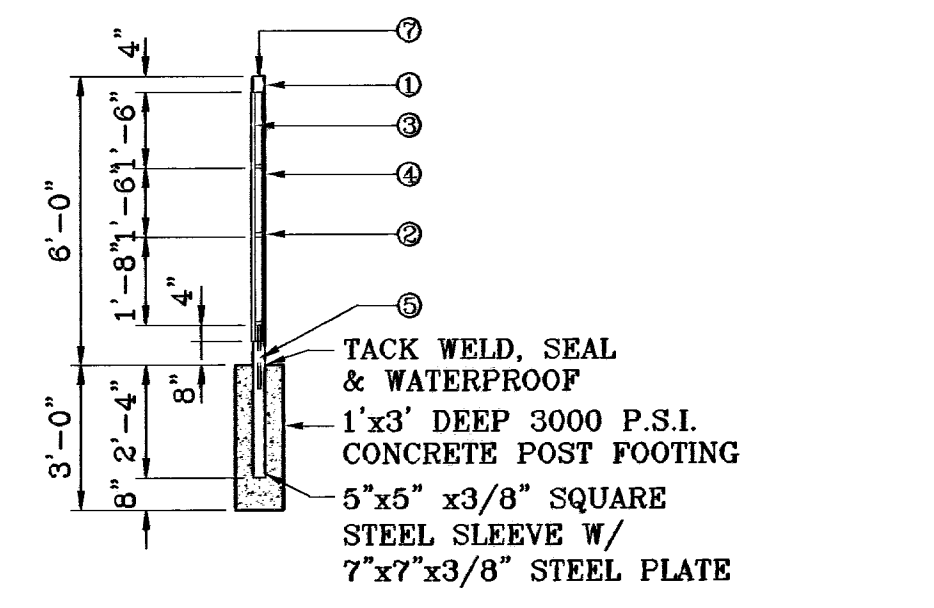

**WROUGHT IRON GATE**  
SCALE: 1"=4'

**PAVEMENT NOTES**

1. SUBGRADE TO BE COMPACTED TO 95% OF MAXIMUM DENSITY AS PER ASTM D1557.
2. BASE TO BE COMPACTED TO NOT LESS THAN 100% DENSITY IN ACCORDANCE WITH ASTM D1557, TYPE A, GRADE 1 OR 2.
3. BITUMINOUS MATERIAL SHALL CONFORM TO AC-10 OR AC-20, TYPE "C" IN ACCORDANCE WITH ASTM D3318.
4. PRIME COAT TO BE 0.25 GAL. PER SQUARE YARD (MINIMUM COVERAGE) MC-70.
5. COMPACTION TESTS WHERE REQUIRED BY THE CITY ENGINEER MUST BE PAID FOR BY THE DEVELOPER.
6. C.B.R. TESTS WILL BE REQUIRED AT 500 FOOT INTERVALS AFTER SUBGRADE IS PLACED AND/OR A MINIMUM OF TWO TESTS IF STREET IS LESS THAN 500 FEET.
7. STRICT VERTICAL CONTROL OF ALL CURB AND GUTTER ELEVATIONS WILL BE MAINTAINED. BLUE TOPPING WILL BE REQUIRED THROUGHOUT.
8. ALL PLANS MUST BE IN ACCORDANCE WITH THE LATEST EDITION OF THE CITY OF EL PASO SUBDIVISION DESIGN AND IMPROVEMENT STANDARDS.
9. H.M.A.C. BASE, SUB BASE WILL BE IN ACCORDANCE WITH THE LATEST CITY OF EL PASO SPECIFICATIONS.
10. MINIMUM PAVEMENT DESIGN DETAILS ARE SHOWN. ACTUAL PAVEMENT DESIGN WILL BE DETERMINED BY: C.B.R.

**TRENCHING**


ALL TRENCHING SHALL BE DONE IN STRICT ACCORDANCE WITH OSHA-2226.

NGS MARKER: COPPER-CLAD STEEL ROD DESIGNATED 'X 1118' PID 'CE0141' ELEVATION : 3967.12	REVISIONS	DATE	CITY REVISIONS	LOT REVISIONS
		12/05/08	06/08/09	

**TERRA DEL ESTE UNIT FIFTY NINE**  
BEING A PORTION OF SECTION 38, BLOCK 79, TOWNSHIP 2, TEXAS AND PACIFIC RAILROAD COMPANY SURVEYS, CITY OF EL PASO, EL PASO COUNTY, TEXAS, CONTAINING 26.969 ACRES.



ENGINEER'S SEAL	SCALE	PROJECT NAME
ENGINEER'S SEAL NOT REQUIRED. THIS SEAL IS FOR THE SUBDIVISION DESIGN STANDARDS.	HORIZ: AS NOTED	TERRA DEL ESTE UNIT FIFTY NINE
	VERT: ---	
	DATE: MAY 2008	
	DESIGN BY: Y.C.	
	INITIATED BY: O.M.	
	CHECKED BY: Y.C.	
	JOB NO.: 608-23	

**CONDE INC.**  
ENGINEERING / PLANNING  
SURVEYING / GPS  
1790 LEE TREVINO STE 400  
EL PASO, TEXAS 79936

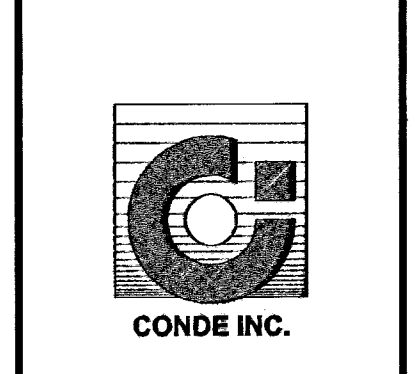


SHEET TITLE



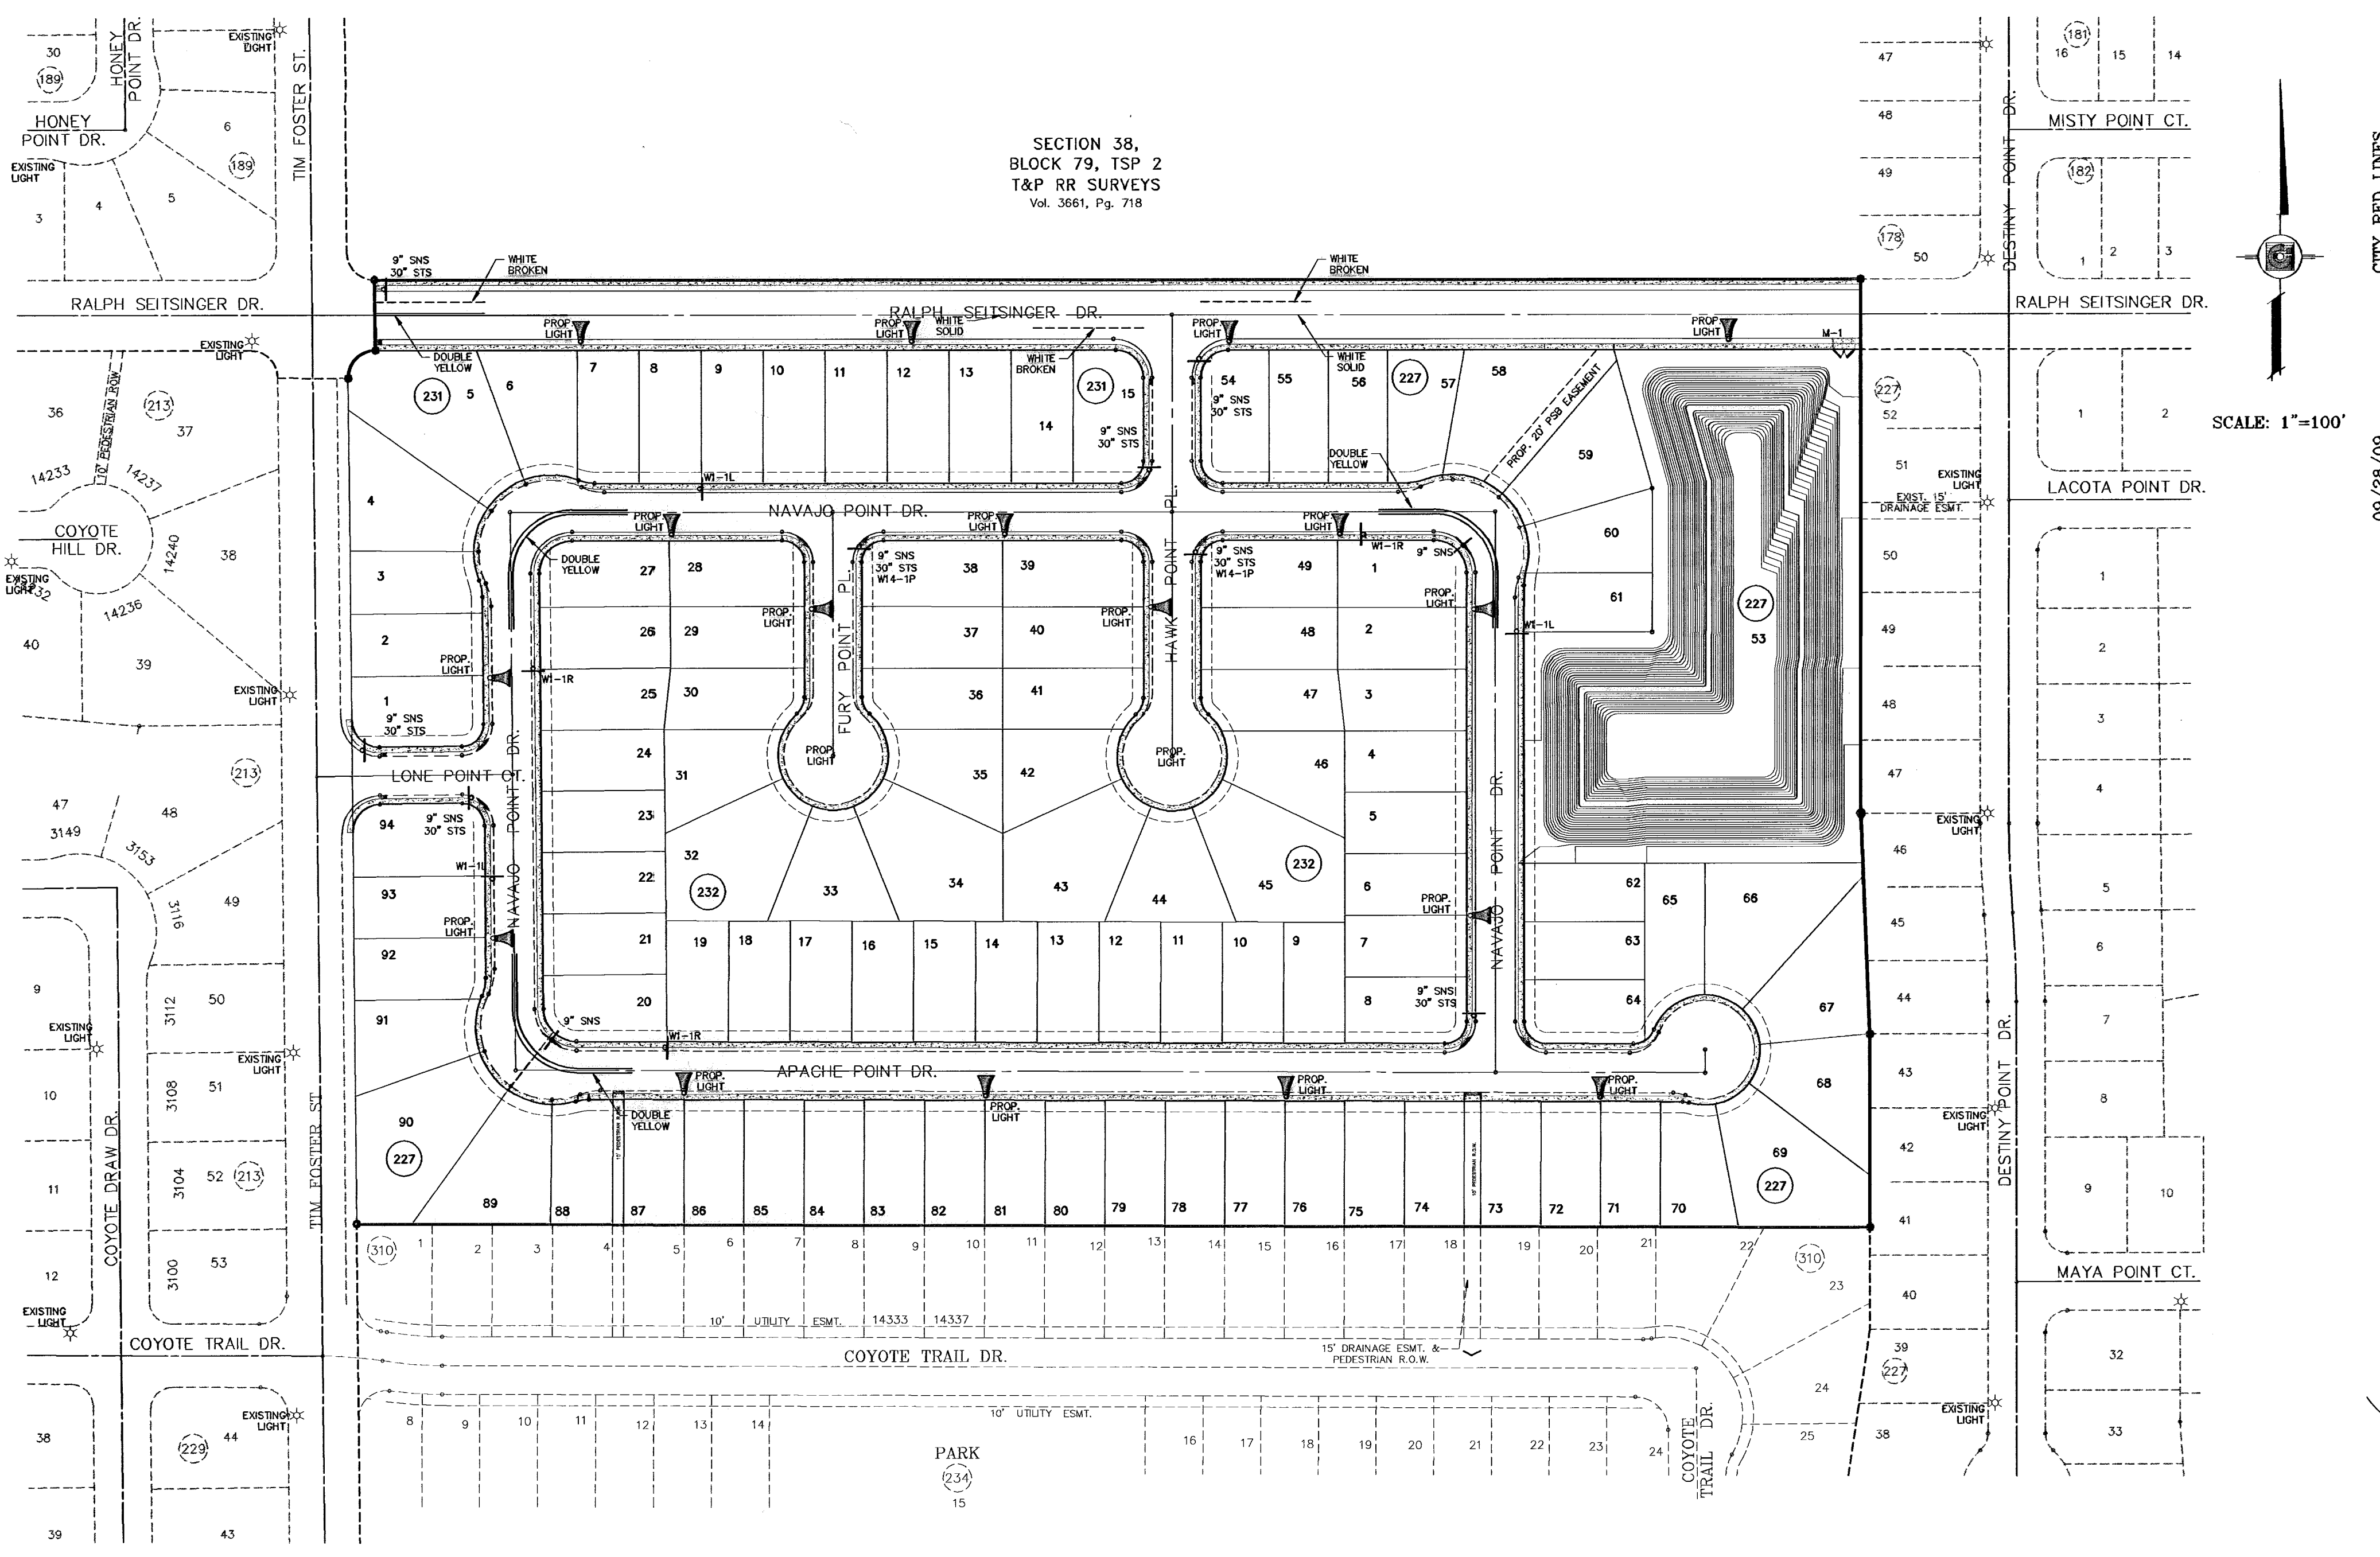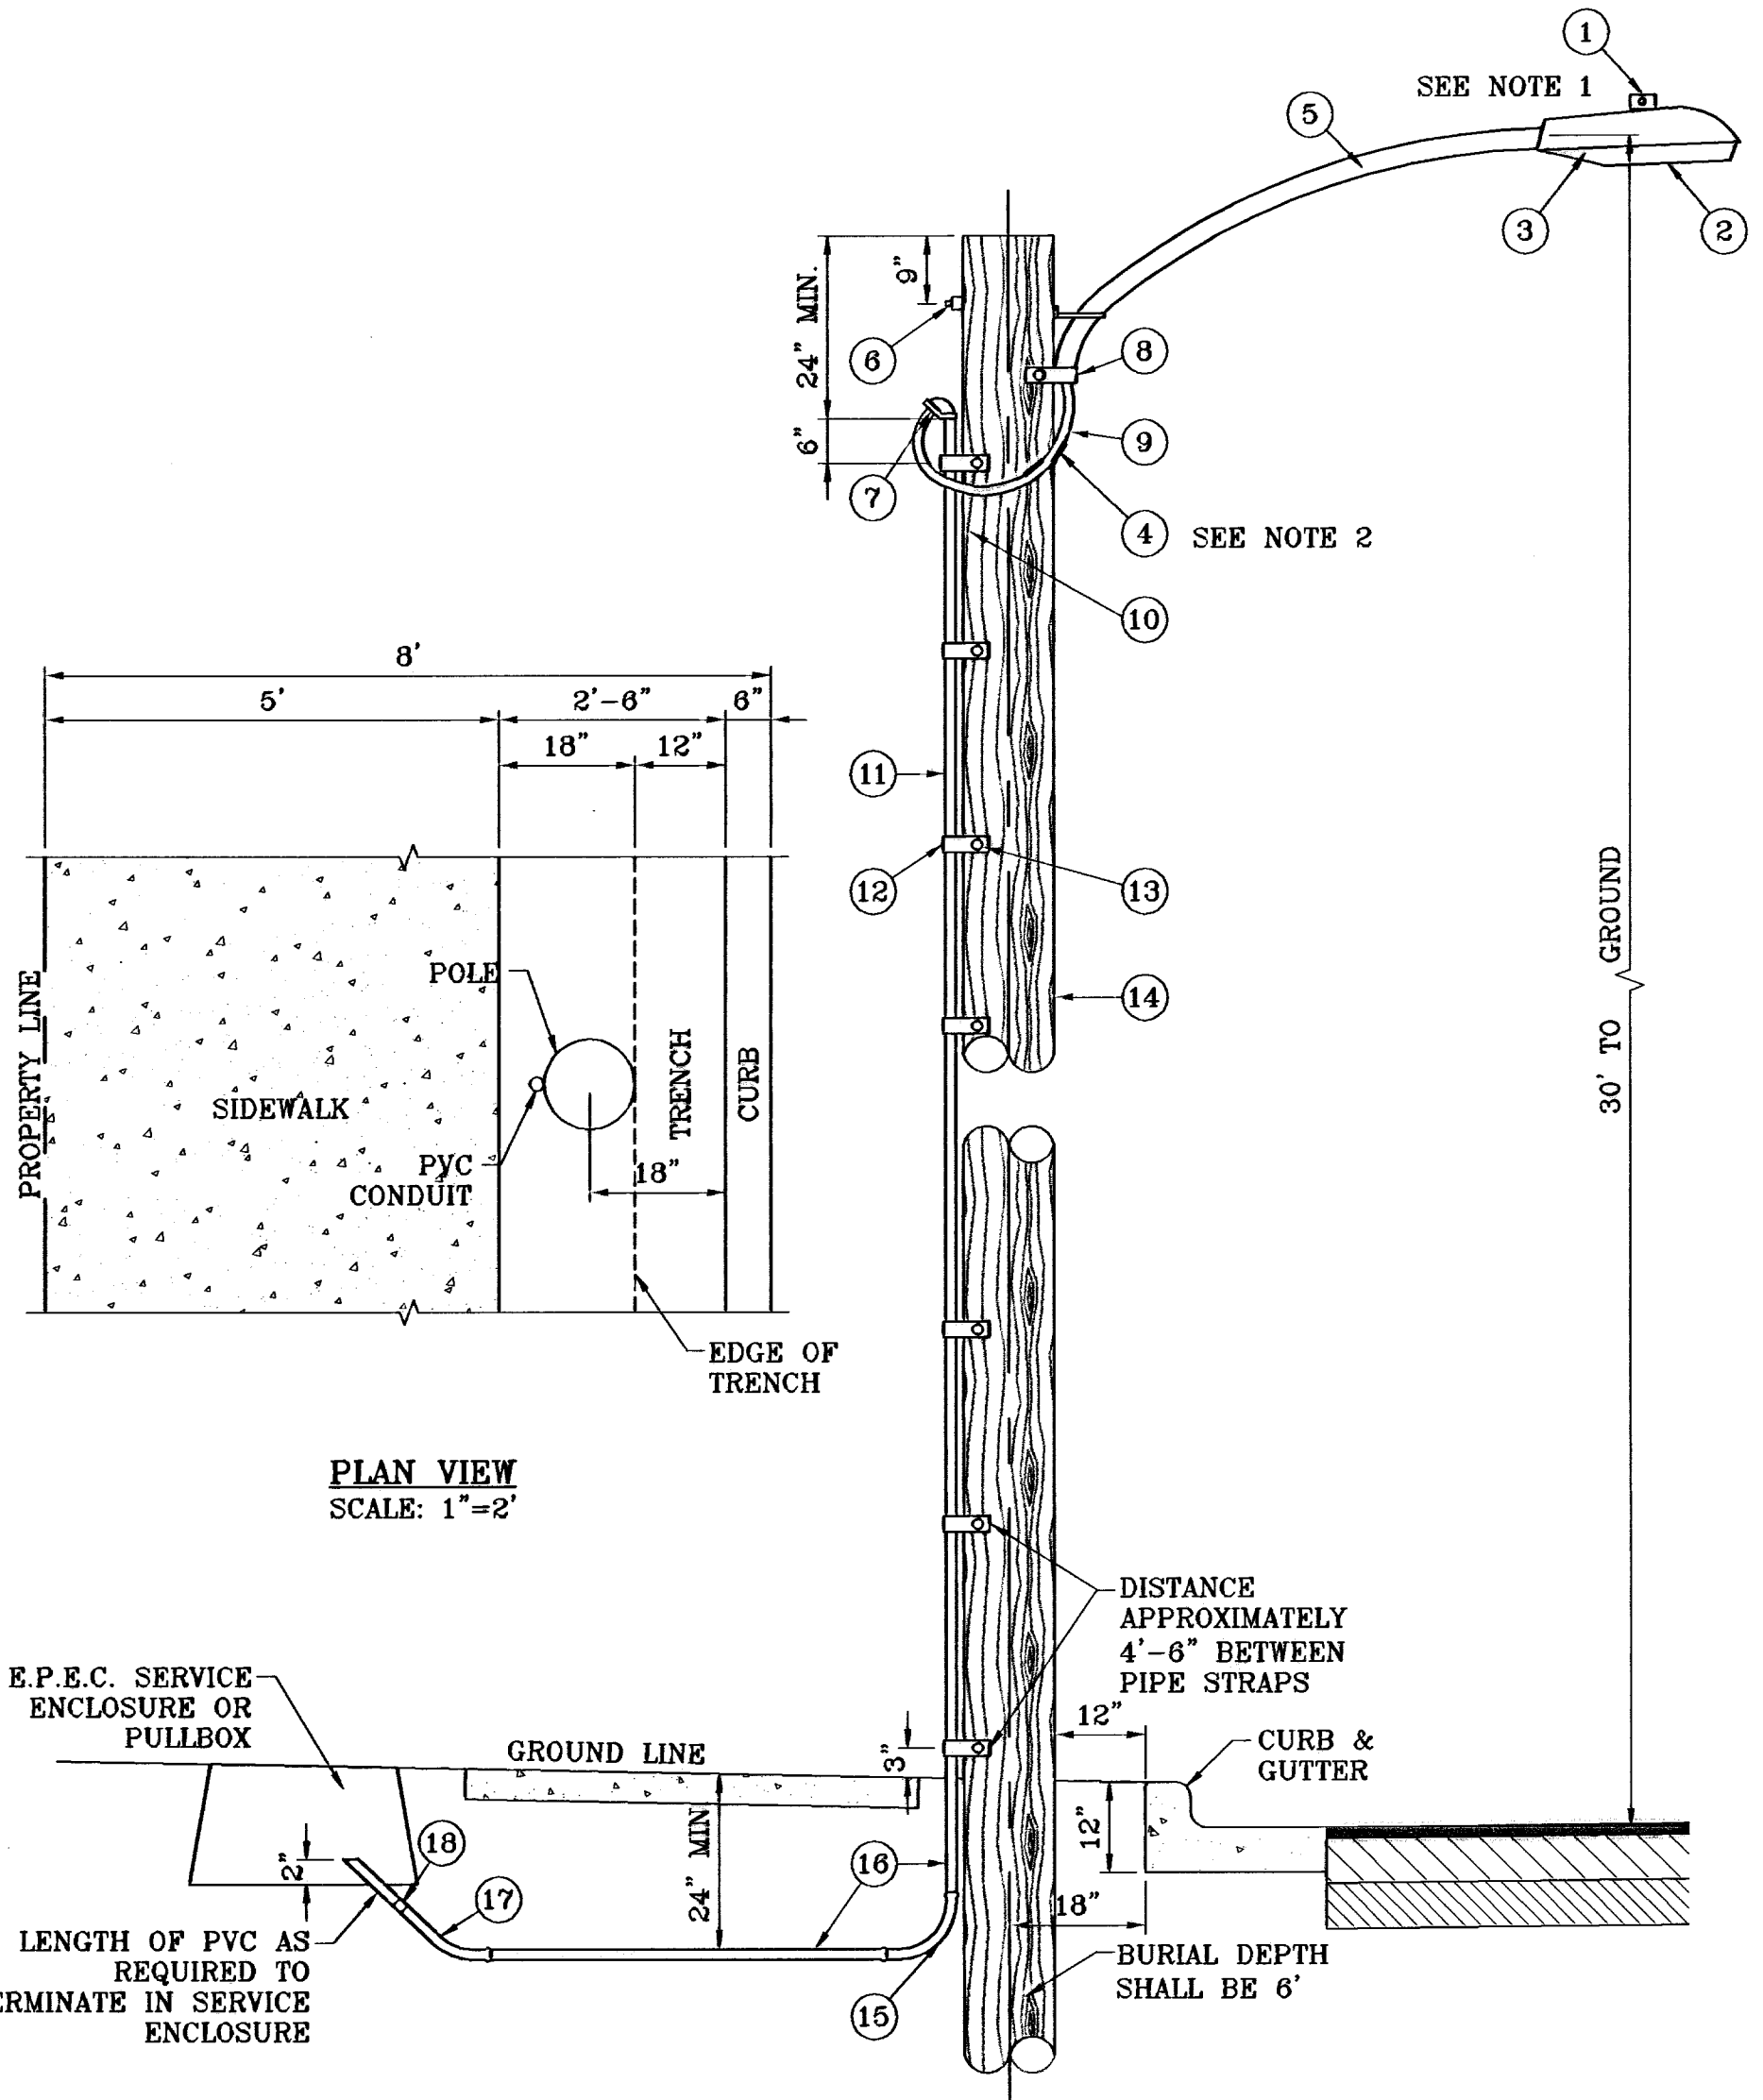

- 1 MOUNT SO THAT PHOTO CELL IS FACING NORTH.
- 2 ITEM #9 SHALL NOT BE SPLICED INSIDE ITEM #5.
- 3 INSTALLATION MUST COMPLY WITH LOCAL CODE REQUIREMENTS.
- 4 FOR ANY CLARIFICATION, EXCEPTIONS OR QUESTIONS REGARDING THIS STANDARD, CALL THE EL PASO ELECTRIC COMPANY DISTRIBUTION DESIGN DEPARTMENT.

ITEM	No.	DESCRIPTION	STOCK\DSU No.	QTY.	C\U CODE	MACRO CODE
1		PHOTOCELL, 240 V-SEE NOTE 1	21-225	1		LCOBRAUG
2		HPS LAMP 100 W	21-085	1	LCOBRAHD	
3		LUMINAIRE, 100 W HPS	21-335	1		
4		SLEEVES, #12-10	05-140	2		
5		MAST ARM, 6' x 1 1/4"	21-200	1	LBRKT1*6	
6		MACHINE BOLT, 5/8" x 12"	02-470	1		
		SQUARE GALV. WASHER, 2 1/4"x2 1/4"	02-760	1	LMB5/812	
		COIL SPRING WASHER, 5/8"	02-788	1		
		LOCK NUT, 5/8"	02-706	1		
7		SERVICE ENTRANCE CAP FOR 1" PVC CONDUIT	17-281	1	LSVCCAP1	
8		LAG BOLT, 1/2" x 3"	02-343	2	LLAG12*3	
9		CABLE #10, 2 CONDUCTOR, 600V, UP	13-600	8'	L2C#10S	
10		COPPER CBL, #12, 19 SOLID, 600V BLUE	13-702	60'	LC#12CU	
11		SCHEDULE 80 1" PVC CONDUIT	17-280	30'	LSCH801	
12		PIPE STRAP FOR 1" PVC CONDUIT 2 HOLE	17-283	7	LPVCSTRP	
13		NAIL, STAINLESS STEEL SCREW 2.5"	14-427	.25#	LNAL14*2	
14		POLE, 35' CLASS 4	09-035	1	L354UG	
15		1" PVC 90 DEGREE ELBOW	17-297	1	LEL901	
16		1" PVC CONDUIT	17-299	AS REQ'D	LPVC1	
17		1" PVC 45 DEGREE ELBOW	17-298	1	LEL451	
18		1" PVC COUPLING	17-296	1	LCPLG1	

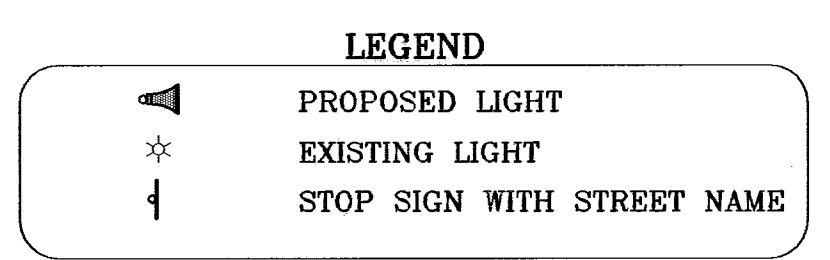

**NOTE:** STREET LIGHTING TO BE IN ACCORDANCE WITH EL PASO DESIGN STANDARDS, SECTION VIII

**NOTE:** INSTALL TRAFFIC CONTROL DEVICES AS SHOWN AND IN ACCORDANCE WITH CITY OF EL PASO DESIGN STANDARDS, SECTION VII

PROJECT NAME: TIERRA DEL ESTE UNIT FIFTY NINE

SCALE: HORIZ. 1"=100', VERT. ---

DATE: MAY 2008

DESIGN BY: Y.C.

INITIATED BY: O.M.

CHECKED BY: Y.C.

JOB NO.: 608-23

CONDE INC. ENGINEERING / PLANNING SURVEYING / GPS

1790 LEE TREVINO STE 400 EL PASO, TEXAS 79936

ILLUMINATION AND TRAFFIC CONTROL PLAN

SHT 24 OF 24