



TUSCANY AT RIDGEVIEW

STREET IMPROVEMENTS

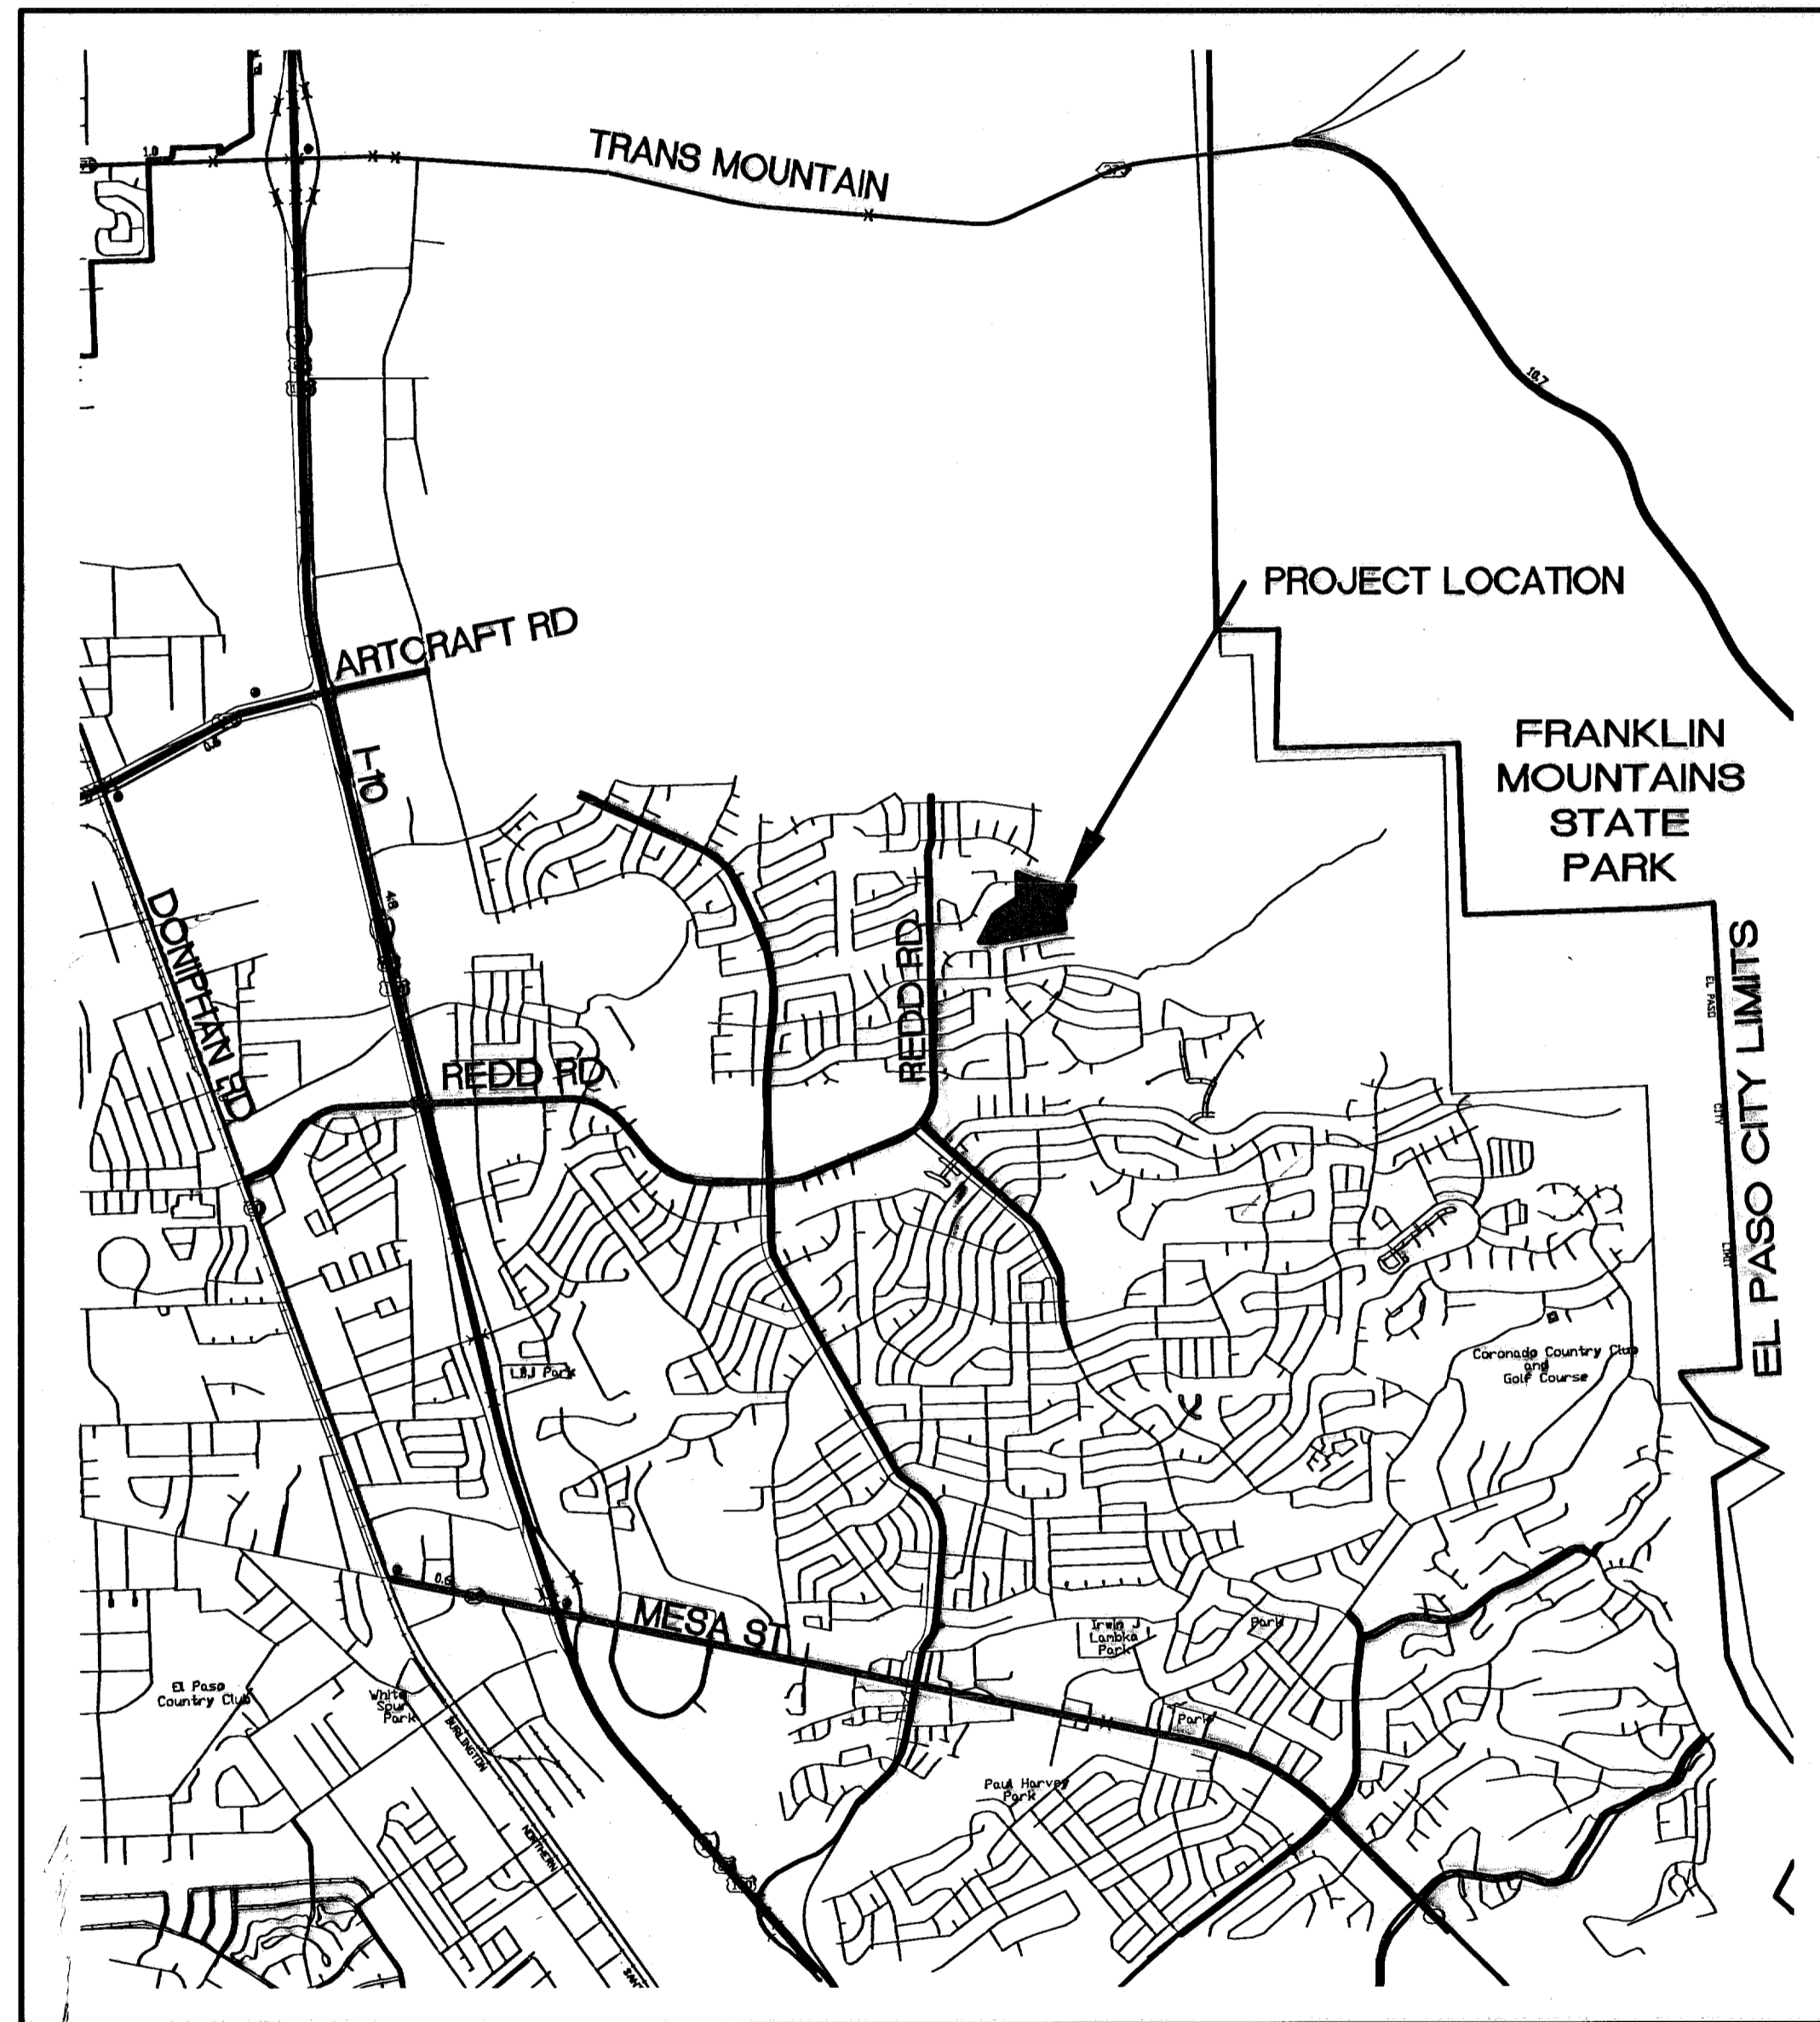

VICINITY MAP

N. T. S.

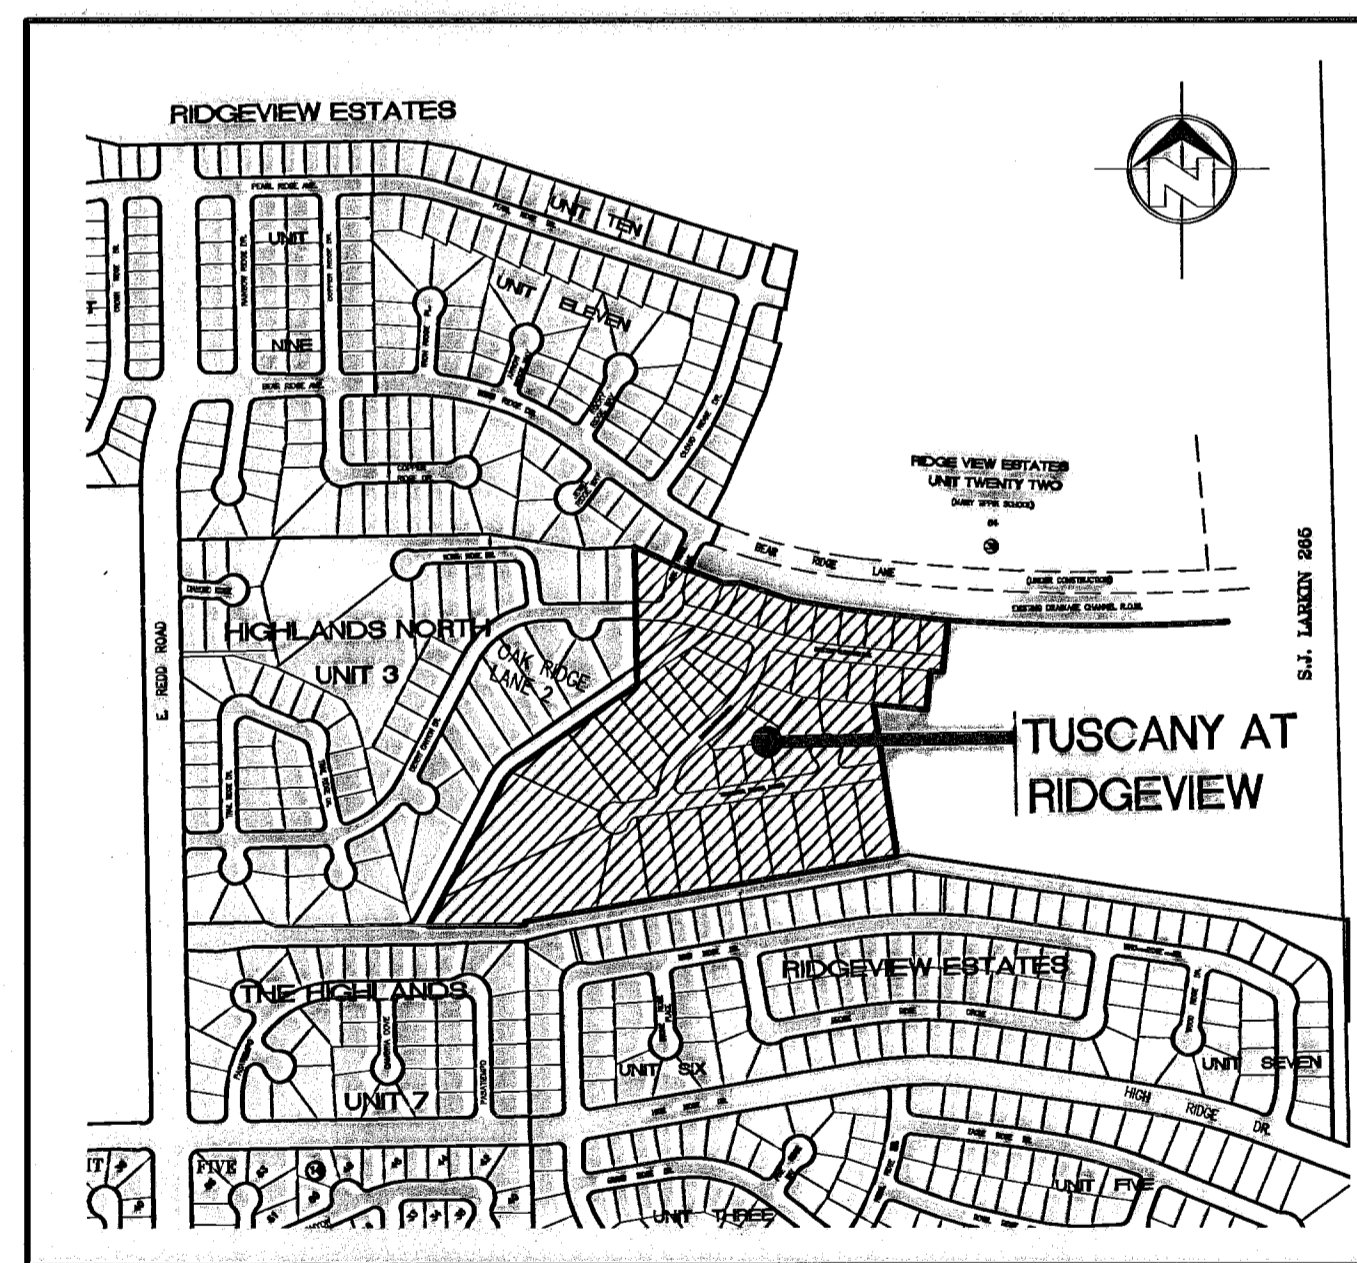


LOCATION MAP

SCALE: 1" = 600'

INDEX OF SHEETS

- | | | |
|-----|------------------------|--------------------------------------|
| 1. | _____ | COVER SHEET |
| 2. | _____ | SUBDIVISION PLAT |
| 3. | _____ | TYPICAL SECTIONS |
| 4. | (PLAN & PROFILE) _____ | CYPRESS RIDGE DR. AND OAK RIDGE LANE |
| 5. | (PLAN & PROFILE) _____ | TUSCANY RIDGE DR. |
| 6. | (PLAN & PROFILE) _____ | CONTESSA RIDGE DR. |
| 7. | _____ | GRADING PLAN |
| 8. | _____ | DRAINAGE PLAN |
| 9. | _____ | EROSION CONTROL PLAN |
| 10. | (PLAN & PROFILE) _____ | STORM DRAIN |
| 11. | _____ | DRAINAGE STRUCTURE DETAILS |
| 12. | _____ | BOX CULVERT DETAILS |
| 13. | _____ | ILLUMINATION PLAN |

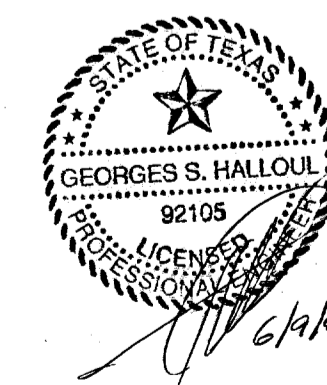

AS-BUILTS


SHEET 1 OF 13

600830

SLI ENGINEERING, INC.
CIVIL ENGINEERS LAND SURVEYORS LAND PLANNERS
6600 WESTWIND EL PASO, TEXAS (915) 584-4457

TUSCANY AT RIDGEVIEW CORRECTION PLAT

A PORTION OF TRACT 1A,
S. J. LARKIN SURVEY NO. 265,
CITY OF EL PASO, EL PASO COUNTY, TEXAS
CONTAINING: 24.994 ACRES

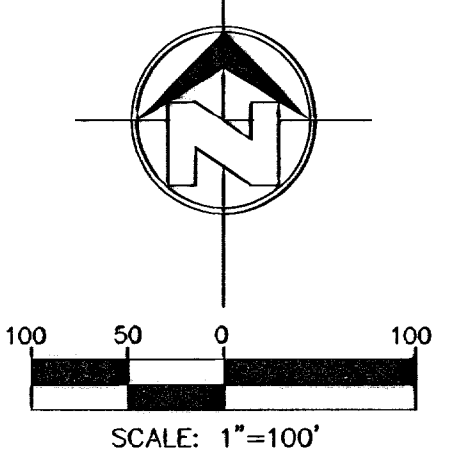

- LEGEND**
- PROPOSED CITY MONUMENT
 - EXISTING CITY MONUMENT
 - BLOCK NUMBER
 - LOT NUMBER
 - NEIGHBORHOOD DISTRIBUTION COLLECTION BOX UNITS (NDCBU)

LOT AREAS

BLOCK 6
LOT 23 14,752 SQ. FT.

BLOCK 41
LOT 1 13,369 SQ. FT.
LOT 2 14,249 SQ. FT.
LOT 3 18,574 SQ. FT.
LOT 4 18,155 SQ. FT.
LOT 5 22,620 SQ. FT.
LOT 6 27,458 SQ. FT.
LOT 7 32,679 SQ. FT.
LOT 8 39,440 SQ. FT.
LOT 9 80,683 SQ. FT.
LOT 10 100,059 SQ. FT.
LOT 11 30,409 SQ. FT.
LOT 12 28,405 SQ. FT.
LOT 13 26,228 SQ. FT.
LOT 14 26,050 SQ. FT.
LOT 15 29,973 SQ. FT.
LOT 16 25,695 SQ. FT.
LOT 17 23,518 SQ. FT.
LOT 18 23,341 SQ. FT.
LOT 19 25,163 SQ. FT.


BLOCK 42
LOT 1 11,368 SQ. FT.
LOT 2 11,097 SQ. FT.
LOT 3 10,890 SQ. FT.
LOT 4 10,540 SQ. FT.
LOT 5 10,540 SQ. FT.
LOT 6 10,540 SQ. FT.
LOT 7 14,049 SQ. FT.
LOT 8 16,631 SQ. FT.
LOT 9 14,748 SQ. FT.
LOT 10 10,800 SQ. FT.
LOT 11 10,800 SQ. FT.
LOT 12 15,285 SQ. FT.
LOT 13 14,267 SQ. FT.
LOT 14 15,830 SQ. FT.
LOT 15 14,846 SQ. FT.

BLOCK 43
LOT 1 11,006 SQ. FT.
LOT 2 9,839 SQ. FT.
LOT 3 9,752 SQ. FT.
LOT 4 9,772 SQ. FT.
LOT 5 9,709 SQ. FT.
LOT 6 9,711 SQ. FT.
LOT 7 9,690 SQ. FT.
LOT 8 9,690 SQ. FT.

BLOCK 44
LOT 1 12,012 SQ. FT.

BLOCK 45
LOT 1 16,065 SQ. FT.

DRAINAGE CHANNEL ROW
18,741 SQ. FT.

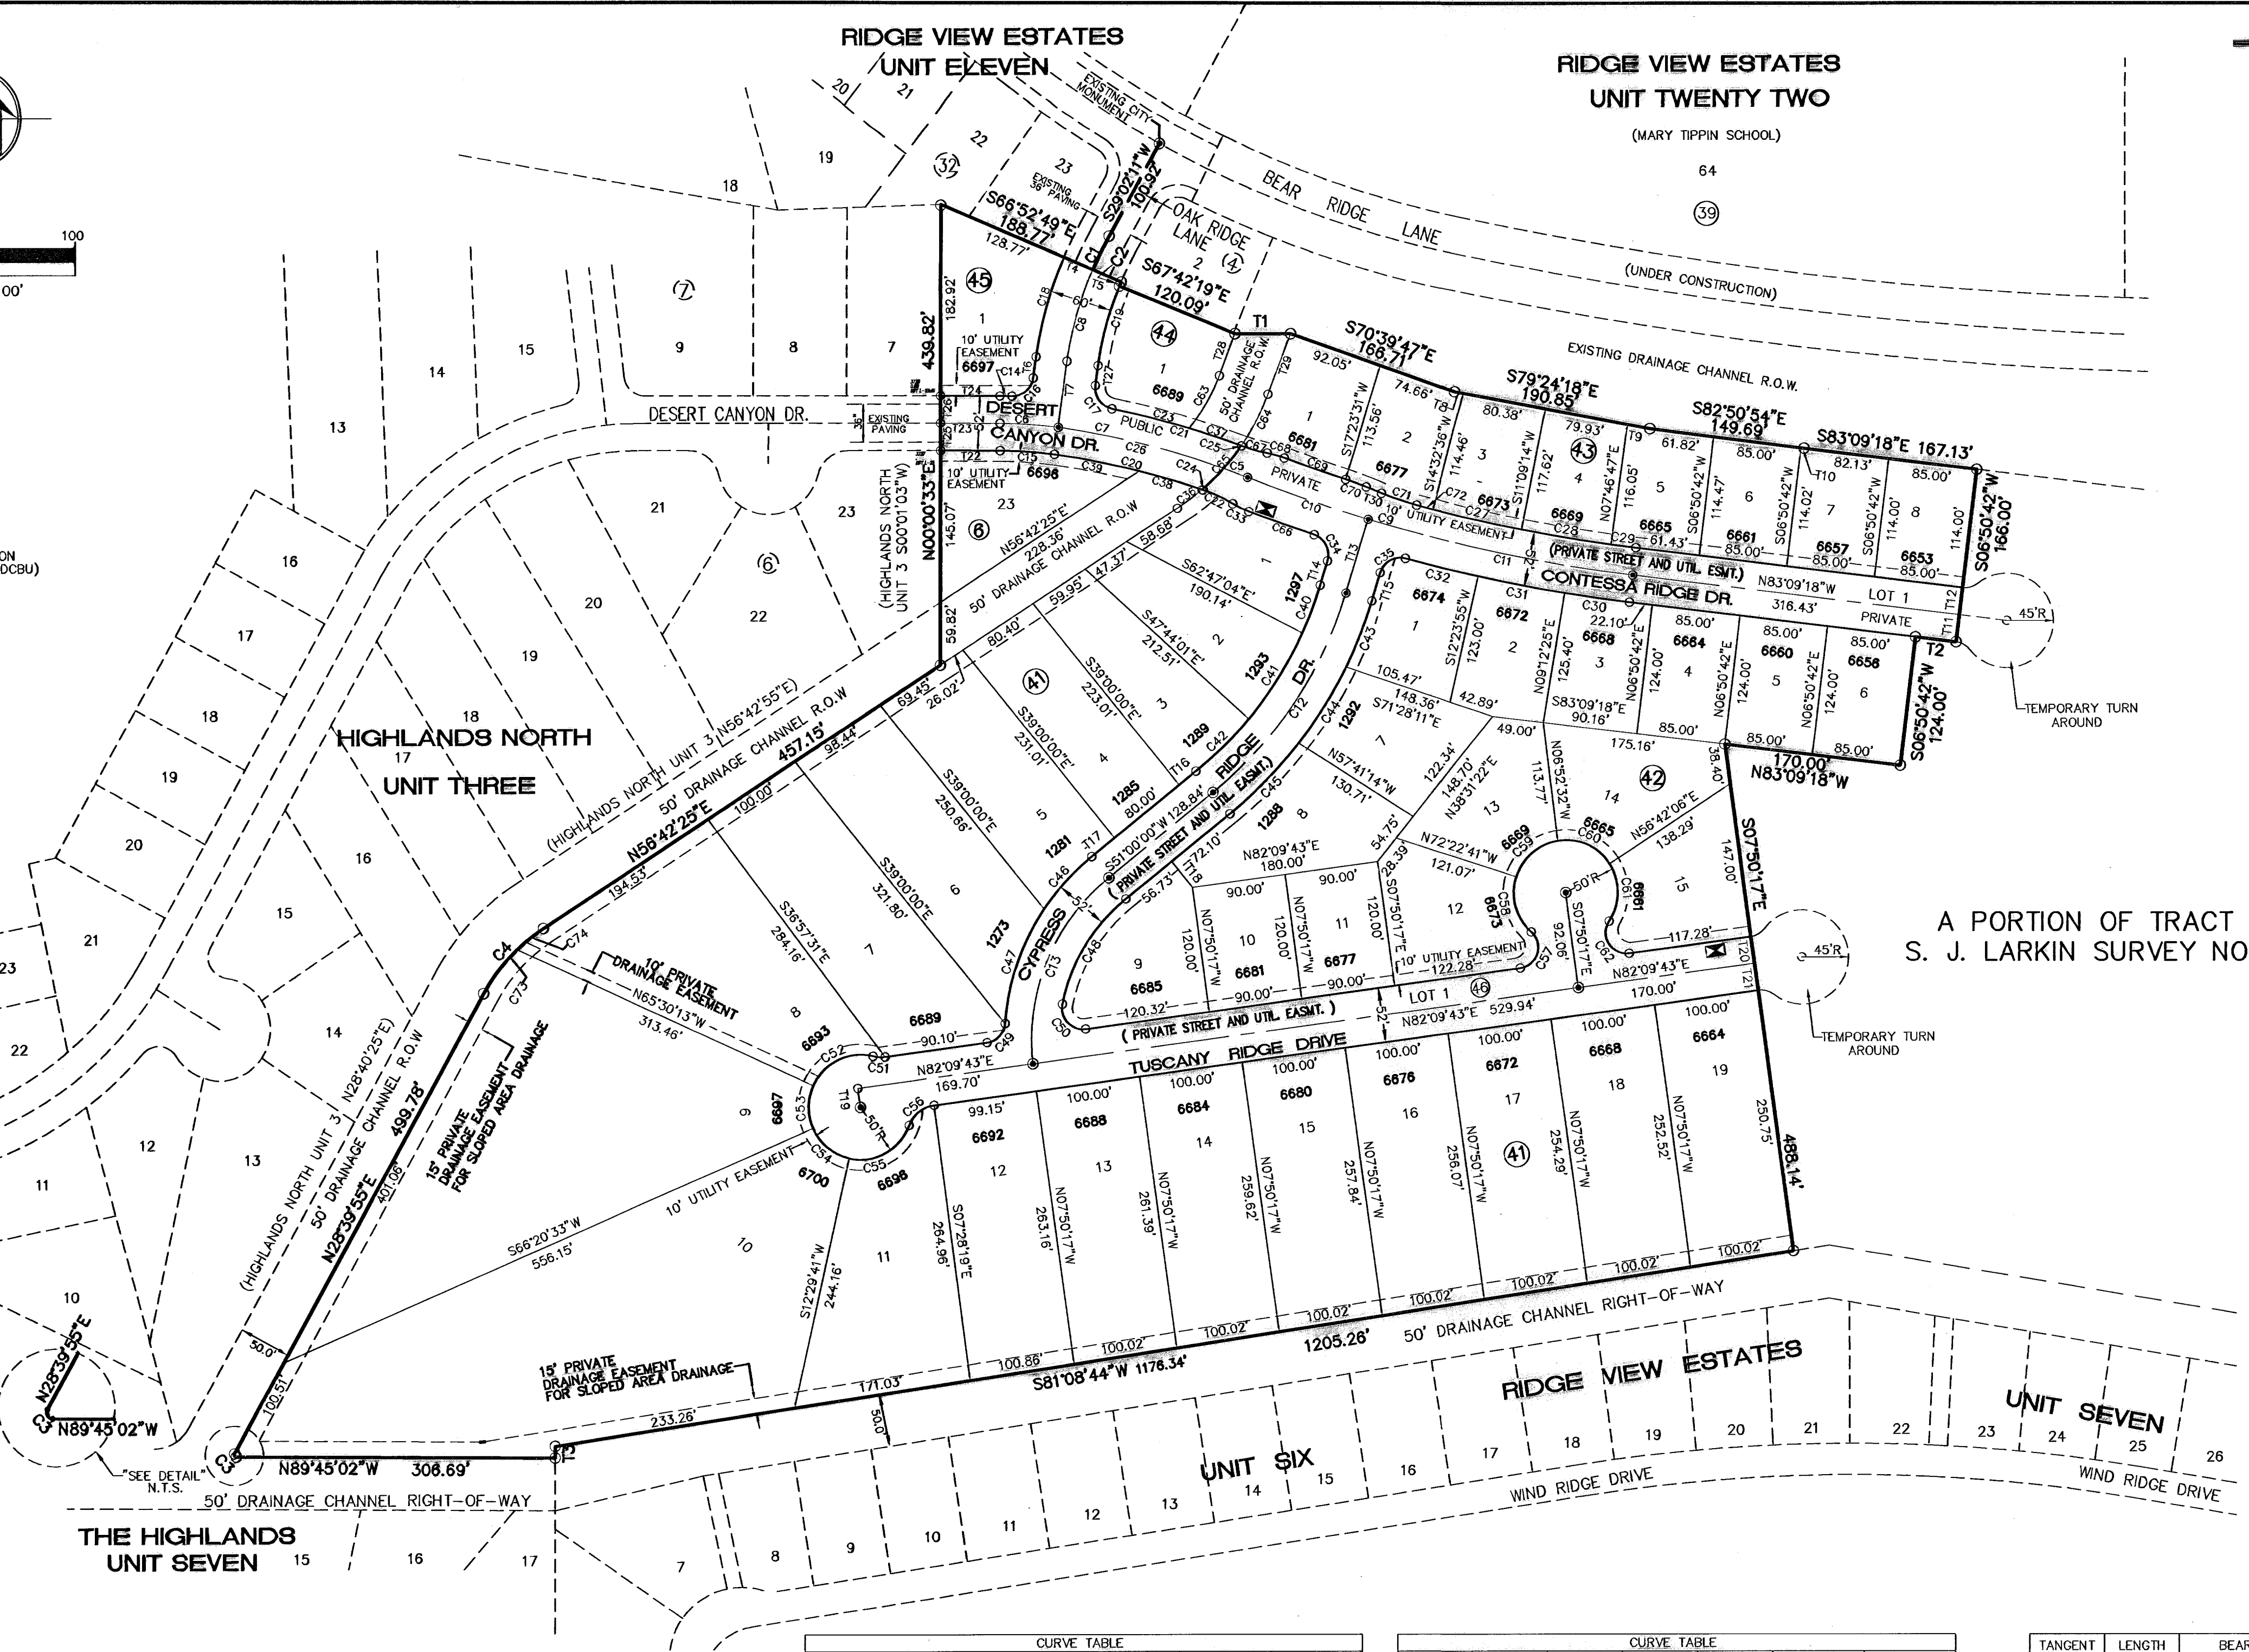

A PORTION OF TRACT 1A,
S. J. LARKIN SURVEY NO. 265,

DEDICATION

THE STATE OF TEXAS
COUNTY OF EL PASO

ACRO DEVELOPERS II LIMITED PARTNERSHIP, OWNER OF THIS LAND, HEREBY PRESENT THIS MAP AND DEDICATES TO THE USE OF THE PUBLIC THE STREET RIGHT-OF-WAY, DRAINAGE RIGHT-OF-WAY AND UTILITY EASEMENTS AS HEREON LAID DOWN AND DESIGNATED, INCLUDING OVERHEAD EASEMENTS AS SHOWN ON THE PLAT AND EASEMENTS FOR BURIED SERVICE WIRES, CONDUITS AND PIPES FOR UNDERGROUND UTILITIES AND THE RIGHT TO INGRESS AND EGRESS FOR SERVICE AND CONSTRUCTION AND THE RIGHT TO TRIM INTERFERING TREES AND SHRUBS.

ACRO DEVELOPERS II LIMITED PARTNERSHIP

BY: DAN J. O'LEARY, PRESIDENT
T & D DEVELOPERS, INC., GENERAL PARTNER

ACKNOWLEDGMENT

THE STATE OF TEXAS
COUNTY OF EL PASO

THIS INSTRUMENT WAS ACKNOWLEDGED BEFORE ME ON _____ BY
DAN J. O'LEARY, AS PRESIDENT OF T & D DEVELOPERS, INC. GENERAL PARTNER OF ACRO DEVELOPERS II LIMITED PARTNERSHIP, ON BEHALF OF THE SAME.

NOTARY PUBLIC, STATE OF TEXAS
MY COMMISSION EXPIRES _____

CITY PLAN COMMISSION

THIS SUBDIVISION IS HEREBY APPROVED AS TO THE PLATTING AND AS TO THE CONDITIONS OF THE DEDICATION IN ACCORDANCE WITH CHAPTER 212 OF THE LOCAL GOVERNMENT CODE OF TEXAS THIS _____ DAY OF _____, 2005 A.D.

EXECUTIVE SECRETARY _____ CHAIRPERSON _____

APPROVED FOR FILING THIS _____ DAY OF _____, 2005, A.D.

DEPUTY DIRECTOR FOR ENGINEERING _____

FILED AND RECORDED IN THE OFFICE OF THE COUNTY CLERK OF EL PASO COUNTY, TEXAS, THIS _____ DAY OF _____, 2005, A.D., IN VOLUME _____ OF THE PLAT RECORD, PAGE _____ FILE NO. _____

COUNTY CLERK _____ BY DEPUTY _____

CURVE TABLE

CURVE	LENGTH	RADIUS	TANGENT	CHORD	BEARING	DELTA
C1	35.63'	345.00'	17.83'	35.61'	S26°04'41"W	05°55'00"
C2	4.54'	315.00'	2.87'	4.54'	S22°42'25"W	00°49'30"
C3	4.13'	2.00'	3.36'	3.44'	S30°23'54"E	118°24'57"
C4	85.65'	175.00'	43.70'	84.80'	S42°41'10"W	28°02'30"
C5	24.52'	800.00'	12.26'	24.52'	N69°25'00"W	01°45'23"
C6	55.83'	409.23'	27.94'	55.79'	S85°57'20"E	07°49'00"
C7	164.09'	800.00'	82.34'	163.81'	S76°10'16"E	11°48'08"
C8	91.33'	345.00'	45.93'	91.08'	N15°32'11"E	15°10'01"
C9	382.65'	1500.00'	192.37'	381.62'	S75°50'48"E	14°36'59"
C10	122.89'	1500.00'	61.48'	122.86'	S70°53'08"E	04°41'39"
C11	259.76'	1500.00'	130.21'	259.44'	S78°11'38"E	09°55'20"
C12	233.01'	390.00'	120.10'	229.56'	S33°53'01"W	34°13'58"
C13	200.40'	200.00'	109.52'	192.12'	N22°17'41"E	57°24'37"
C14	11.48'	435.23'	5.74'	11.48'	N89°06'30"W	01°30'39"
C15	52.28'	383.23'	26.18'	52.24'	S85°57'20"E	07°49'00"
C16	29.22'	20.00'	17.92'	26.69'	S49°48'00"W	82°41'39"
C17	30.23'	20.00'	18.85'	27.44'	S35°21'11"E	86°36'42"
C18	99.27'	375.00'	49.93'	98.98'	N15°32'11"E	15°10'01"
C19	78.85'	315.00'	39.83'	78.64'	N15°07'26"E	14°20'31"
C20	146.18'	774.00'	73.30'	145.94'	S75°38'15"E	10°49'09"
C21	129.31'	826.00'	64.79'	129.18'	S74°10'27"E	08°58'11"
C22	31.22'	150.00'	15.67'	31.16'	S65°10'07"E	11°55'25"
C23	76.54'	826.00'	38.30'	76.51'	N76°00'16"W	15°18'32"
C24	1.32'	774.00'	0.66'	1.32'	S71°10'45"E	00°09'51"
C25	0.57'	826.00'	0.28'	0.57'	S89°01'11"W	00°02'21"
C26	188.62'	800.00'	94.75'	188.18'	S75°17'34"E	13°30'31"
C27	87.20'	1474.00'	43.61'	87.18'	S70°50'55"E	3°23'22"
C28	86.81'	1474.00'	43.42'	86.80'	S80°32'00"E	3°22'28"
C29	24.04'	1474.00'	12.02'	24.04'	S82°41'16"E	00°56'05"
C30	62.90'	1526.00'	31.46'	62.47'	S81°58'27"E	02°21'43"
C31	84.48'	1526.00'	42.25'	84.47'	S79°12'07"E	03°10'19"
C32	71.47'	1526.00'	35.74'	71.46'	S76°16'48"E	2°41'00"
C33	17.15'	100.00'	8.60'	17.13'	N64°07'10"W	09°49'32"
C34	30.82'	20.00'	19.42'	27.86'	N27°22'57"W	88°17'58"
C35	30.82'	20.00'	19.41'	27.86'	N60°54'53"E	88°17'42"
C36	29.59'	225.00'	14.81'	29.56'	S52°56'24"W	07°32'02"
C37	52.78'	826.00'	26.40'	52.77'	N71°31'11"W	03°39'39"

CURVE TABLE

CURVE	LENGTH	RADIUS	TANGENT	CHORD	BEARING	DELTA
C38	62.99'	774.00'	31.52'	62.98'	N73°33'35"W	04°39'49"
C39	83.16'	774.00'	41.62'	83.12'	N78°58'10"W	06°09'21"
C40	48.89'	364.00'	24.48'	48.85'	N20°36'54"E	7°41'44"
C41	97.08'	364.00'	48.82'	96.77'	N32°06'05"E	15°19'37"
C42	71.53'	364.00'	35.88'	71.42'	N45°22'12"E	11°15'36"
C43	67.87'	416.00'	34.01'	67.79'	S21°26'28"W	9°20'51"
C44	86.38'	416.00'	43.34'	86.22'	S32°03'47"W	11°53'48"
C45	94.30'	416.00'	47.35'	94.10'	S44°30'20"W	12°59'19"
C46	68.03'	228.00'	34.27'	67.77'	S42°22'37"W	1°14'46"
C47	116.88'	228.00'	59.78'	115.58'	S16°56'18"W	29°37'51"
C48	119.97'	174.00'	62.48'	117.61'	S31°14'51"W	39°50'18"
C49	27.24'	20.00'	16.21'	25.18'	N43°08'33"E	78°02'20"
C50	38.16'	20.00'	22.31'	32.63'	S43°10'18"E	109°19'59"
C51	11.54'	30.00'	5.84'	11.47'	S86°49'09"E	22°02'17"
C52	69.55'	50.00'	41.74'	64.08'	S64°20'54"W	79°42'13"
C53	42.02'	50.00'	22.34'	40.80'	S00°25'10"W	48°09'44"
C54	46.99'	50.00'	25.39'	45.28'	S50°34'53"E	53°50'52"
C55	71.65'	50.00'	43.54'	65.67'	N61°26'42"E	82°05'58"
C56	32.34'	30.00'	17.94'	30.80'	N51°16'43"E	61°45'59"
C57	45.78'	20.00'	44.03'	36.42'	N16°35'27"E	131°08'32"
C58	58.12'	50.00'	32.85'	54.90'	S15°40'45"E	66°36'09"
C59	54.97'	50.00'	30.64'	52.25'	N49°07'08"E	6°25'39"
C60	57.67'	50.00'	32.52'	54.53'	S66°20'29"E	66°05'10"
C61	58.12'	50.00'	32.85'	54.90'	S00°00'11"W	66°36'09"
C62	45.78'	20.00'	44.03'	36.42'	N32°16'01"W	131°08'32"
C63	58.08'	175.00'	29.31'	57.82'	N30°09'20"E	19°01'00"
C64	55.62'	225.00'	27.95'	55.47'	S27°43'42"W	14°09'44"
C65	56.41'	225.00'	28.35'	56.26'	N41°59'29"E	14°21'50"
C66	66.75'	1530.00'	33.38'	66.75'	N70°16'56"W	02°29'59"
C67	25.38'	150.00'	12.72'	25.35'	N74°29'48"W	09°41'37"
C68	17.08'	100.00'	8.56'	17.06'	N74°27'03"W	09°47'01"
C69	62.54'	1470.00'	31.27'	62.53'	S70°46'37"E	02°26'15"
C70	20.96'	300.00'	10.48'	20.95'	N69°59'40"W	04°00'08"
C71	35.73'	300.00'	17.89'	35.71'	S71°24'19"E	06°49'26"
C72	16.45'	1474.00'	8.23'	16.45'	S75°08'13"E	00°38'22"
C73	53.07'	175.00'	26.74'	52.87'	N37°21'13"E	17°22'35"
C74	32.58'	175.00'	16.34'	32.53'	S51°22'28"E	10°39'55"

TANGENT

TANGENT	LENGTH	BEARING
T1	53.42'	S89°54'36"E
T2	39.33'	S83°09'18"E
T3	11.04'	S00°03'24"W
T4	30.00'	S66°52'49"E
T5	30.00'	S66°52'49"E
T6	20.86'	N07°57'10"E
T7	63.53'	N07°57'10"E
T8	8.73'	S79°24'18"E
T9	21.81'	S79°24'18"E
T10	2.87'	N82°50'54"W
T11	26.00'	N06°50'42"E
T12	25.00'	N06°50'42"E
T13	73.35'	N16°46'02"E
T14	24.03'	S16°46'02"W
T15	28.04'	N16°46'02"E
T16	20.84'	N51°00'00"E
T17	28.00'	N51°00'00"E
T18	31.87'	N39°00'00"W
T19	18.16'	S07°50'17"E
T20	26.00'	S07°50'17"E
T21	26.00'	S07°50'17"E
T22	57.16'	S89°51'50"E
T23	57.22'	S89°51'50"E
T24	57.28'	S89°51'50"E
T25	26.00'	S00°00'33"W
T26	26.00'	S00°00'33"W
T27	19.01'	N07°57'10"E
T28	42.83'	N20°38'50"E
T29	61.56'	S20°38'50"W
T30	15.95'	N67°59'36"W


IMPROVEMENT PLANS PREPARED BY AND UNDER THE SUPERVISION OF GUILLERMO LICON, P.E.

SUBDIVISION PLAT PREPARED BY AND UNDER THE SUPERVISION OF GUILLERMO LICON, R.P.L.S.


GUILLERMO LICON, P.E.
PROFESSIONAL ENGINEER
TEXAS LICENSE NO. 25896

GUILLERMO LICON, R.P.L.S.
REGISTERED PROFESSIONAL LAND SURVEYOR
TEXAS LICENSE NO. 2998

"RESTRICTIVE COVENANTS FOR THIS SUBDIVISION ARE FILED IN THE OFFICE OF THE COUNTY CLERK, DEED AND RECORD SECTION, INSTRUMENT NO. _____ BOOK _____ PAGE _____ DATE _____"

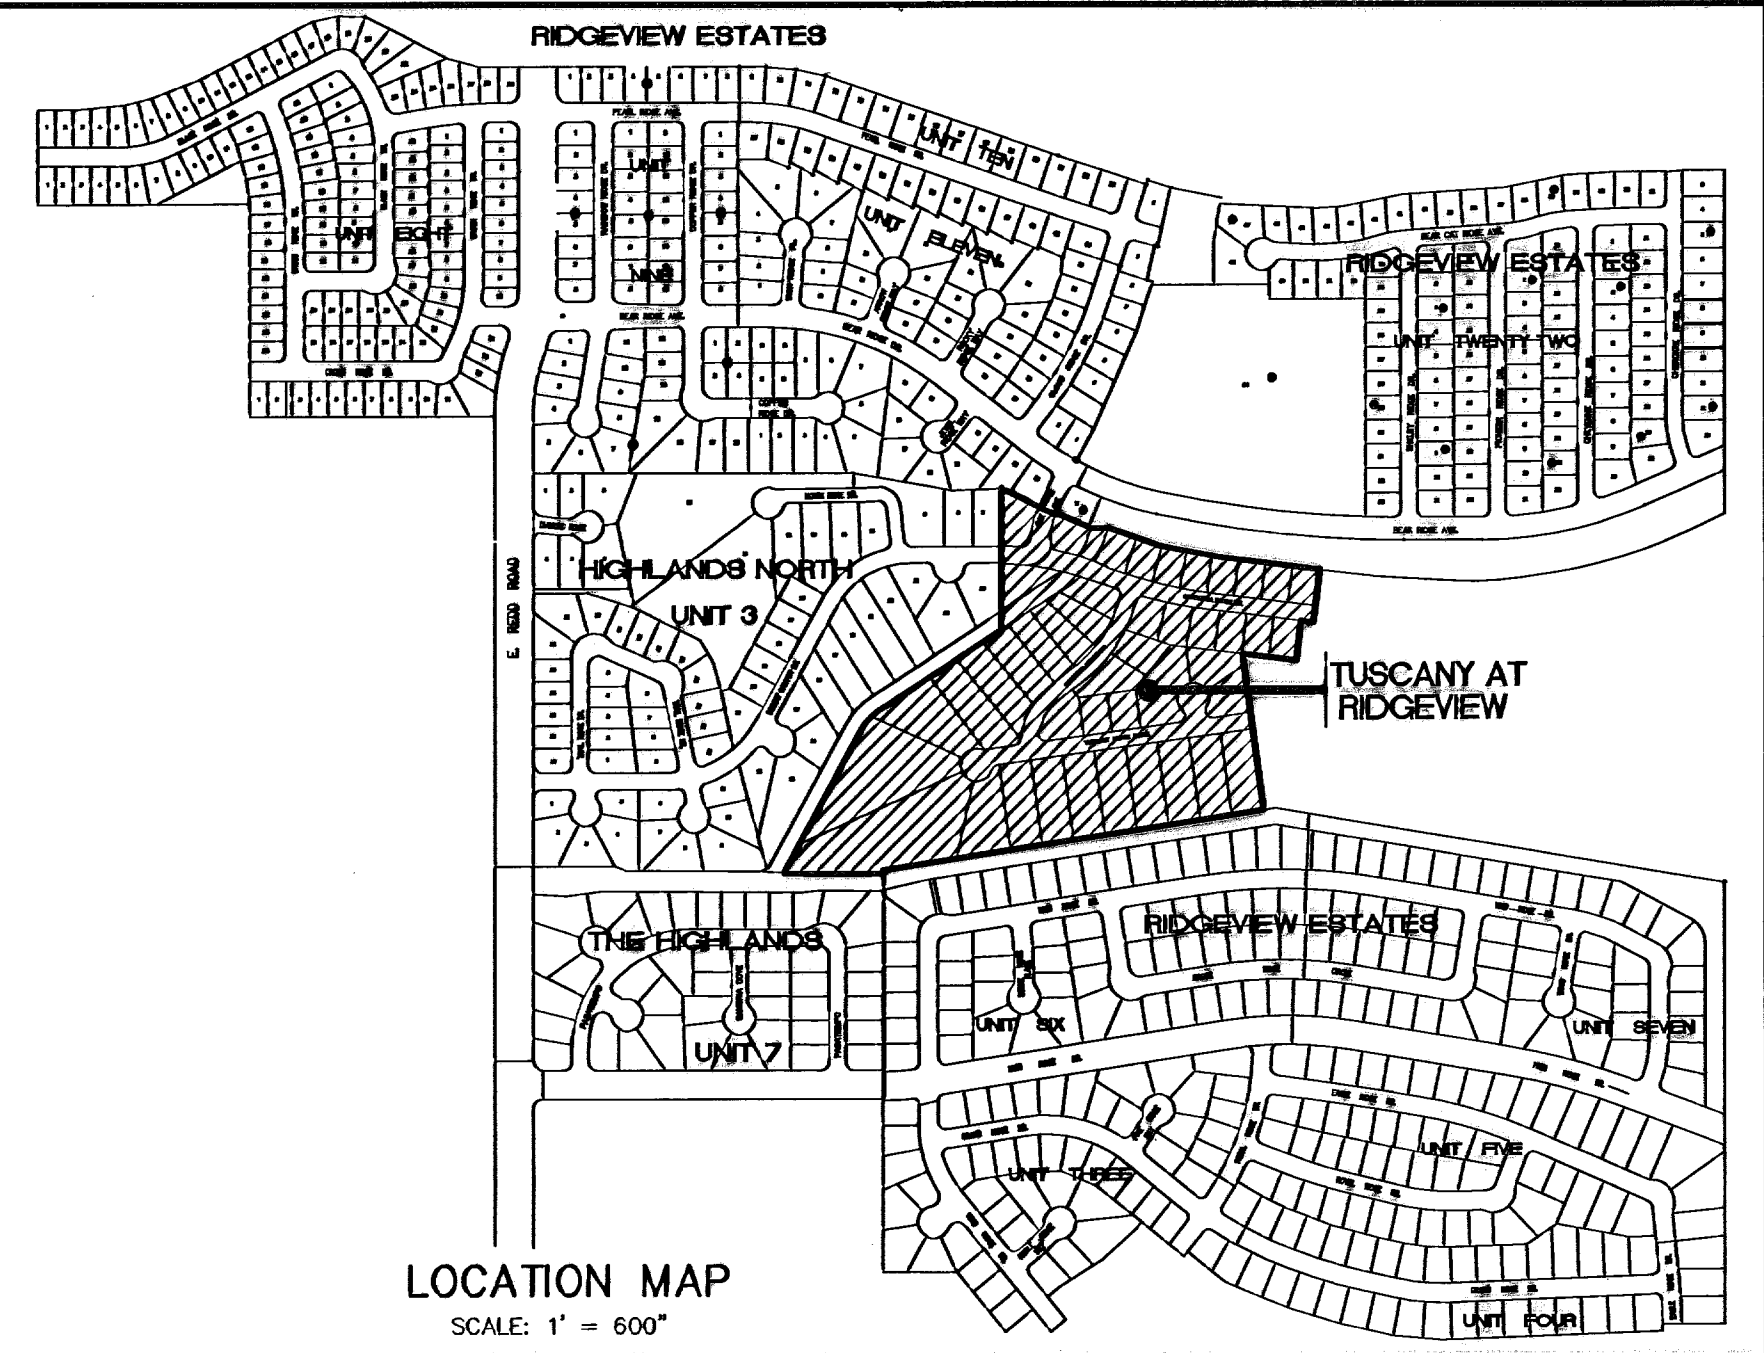

LOCATION MAP
SCALE: 1" = 600'

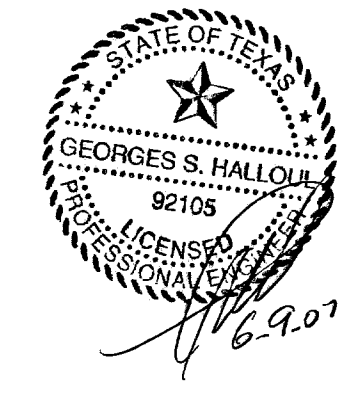

AS-BUILT












SLI ENGINEERING, INC.
CIVIL ENGINEERS - LAND SURVEYORS
LAND PLANNERS - CONSTRUCTION MANAGEMENT
6600 WESTWIND DR. - EL PASO, TEXAS - 79912 - (915) 584-4457

600830

F:\PROJECTS\NRVE-14\REV1-FINALS\TUSC-plat-CDRR.dwg 1/9/2006 10:06:15 AM MST



NOTES : (APPLICABLE TO ALL STREETS)

1. BASE TO BE COMPACTED TO 100% DENSITY (ASTM D-1557).
2. SUBGRADE TO BE COMPACTED TO 95% DENSITY (ASTM D-1557).
3. PRIME COAT SHALL CONSIST OF CATIONIC ASPHALT EMULSION SLOW SETTING TYPE, GRADE CSS-1H, APPLIED AT THE RATE OF 0.20 TO 0.30 GALLONS PER SQUARE YARD.
4. SUBGRADE UNDER CURB MUST BE FORMED AND COMPACTED AS SHOWN OR EXCESS CUT MUST BE BACKFILLED WITH CONCRETE.
5. STRICT VERTICAL CONTROL OF ALL CURB AND GUTTER ELEVATIONS WILL BE MAINTAINED THROUGHOUT.
6. COMPACTION TESTS, WHERE REQUIRED BY THE CITY ENGINEER, MUST BE PAID BY THE DEVELOPER. THIS INCLUDES BUT IS NOT LIMITED TO BASE AND SUBGRADE.
7. H.M.A.C. SHALL CONFORM TO ITEM K3305 (PLANT MIX BITUMINOUS PAVEMENTS), GRADE "C", OF THE CITY OF EL PASO TECHNICAL SPECIFICATIONS.
8. FLEXIBLE BASE COURSE SHALL CONFORM TO ITEM 247 (CRUSHED AGGREGATE BASE COURSE), TYPE A, GRADE 3, TxDOT.
9. CBR TESTS ARE REQUIRED EVERY 500 FT. OR AS DETERMINED BY THE CITY ENGINEER.
10. ALL ELEVATIONS ON PLANS ARE BASED ON CITY DATUM AND ALL PLANS MUST BE IN ACCORDANCE WITH THE LATEST EDITION OF THE CITY OF EL PASO SUBDIVISION DESIGN AND IMPROVEMENT STANDARDS OR NEW SPECIFICATIONS.

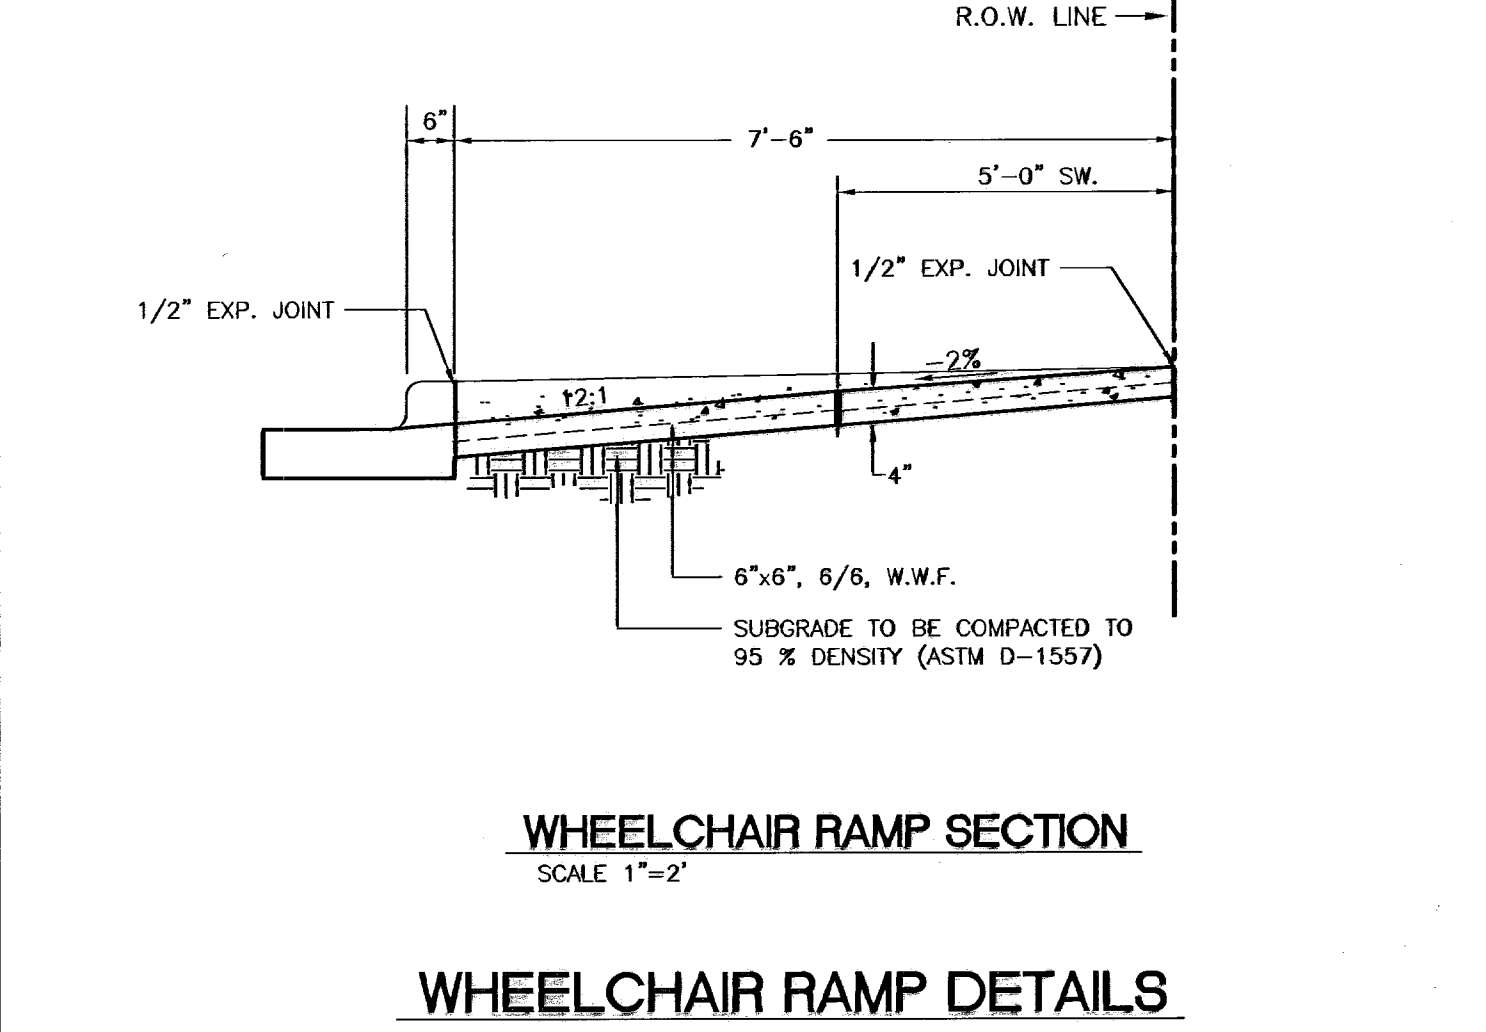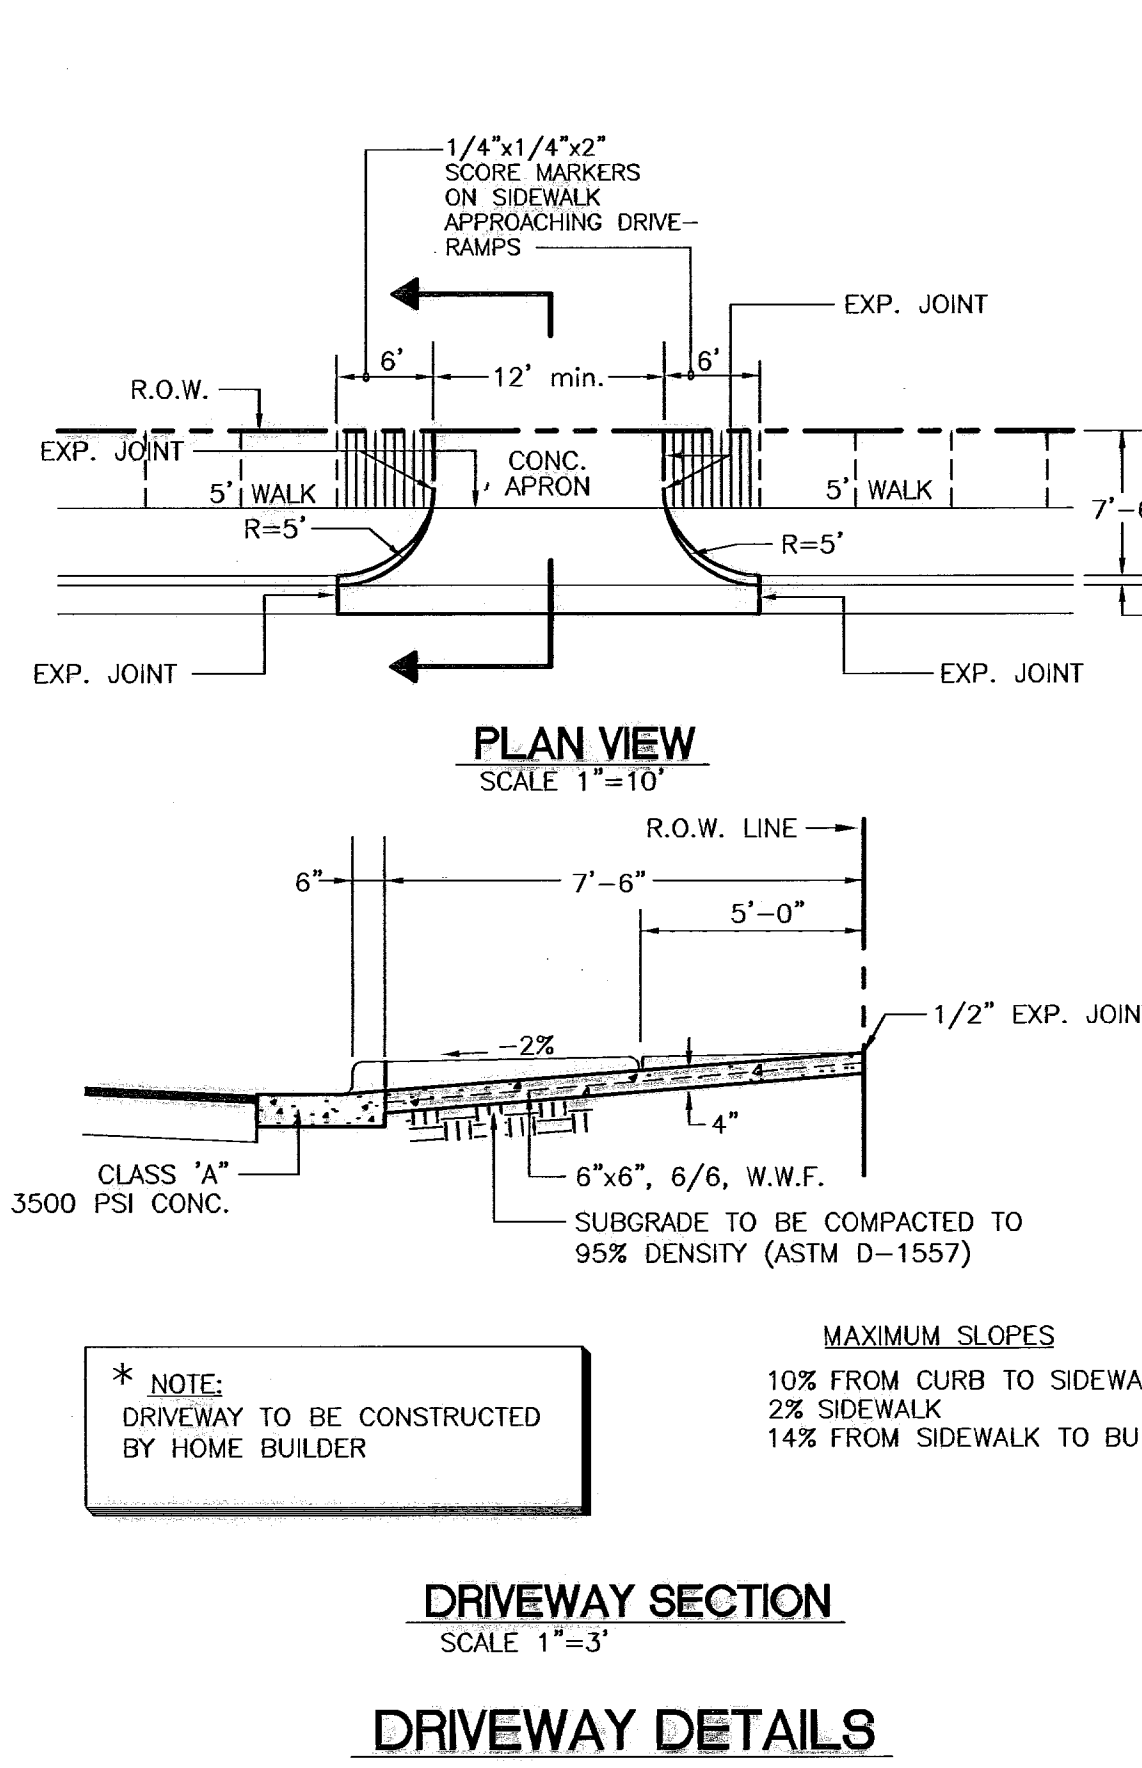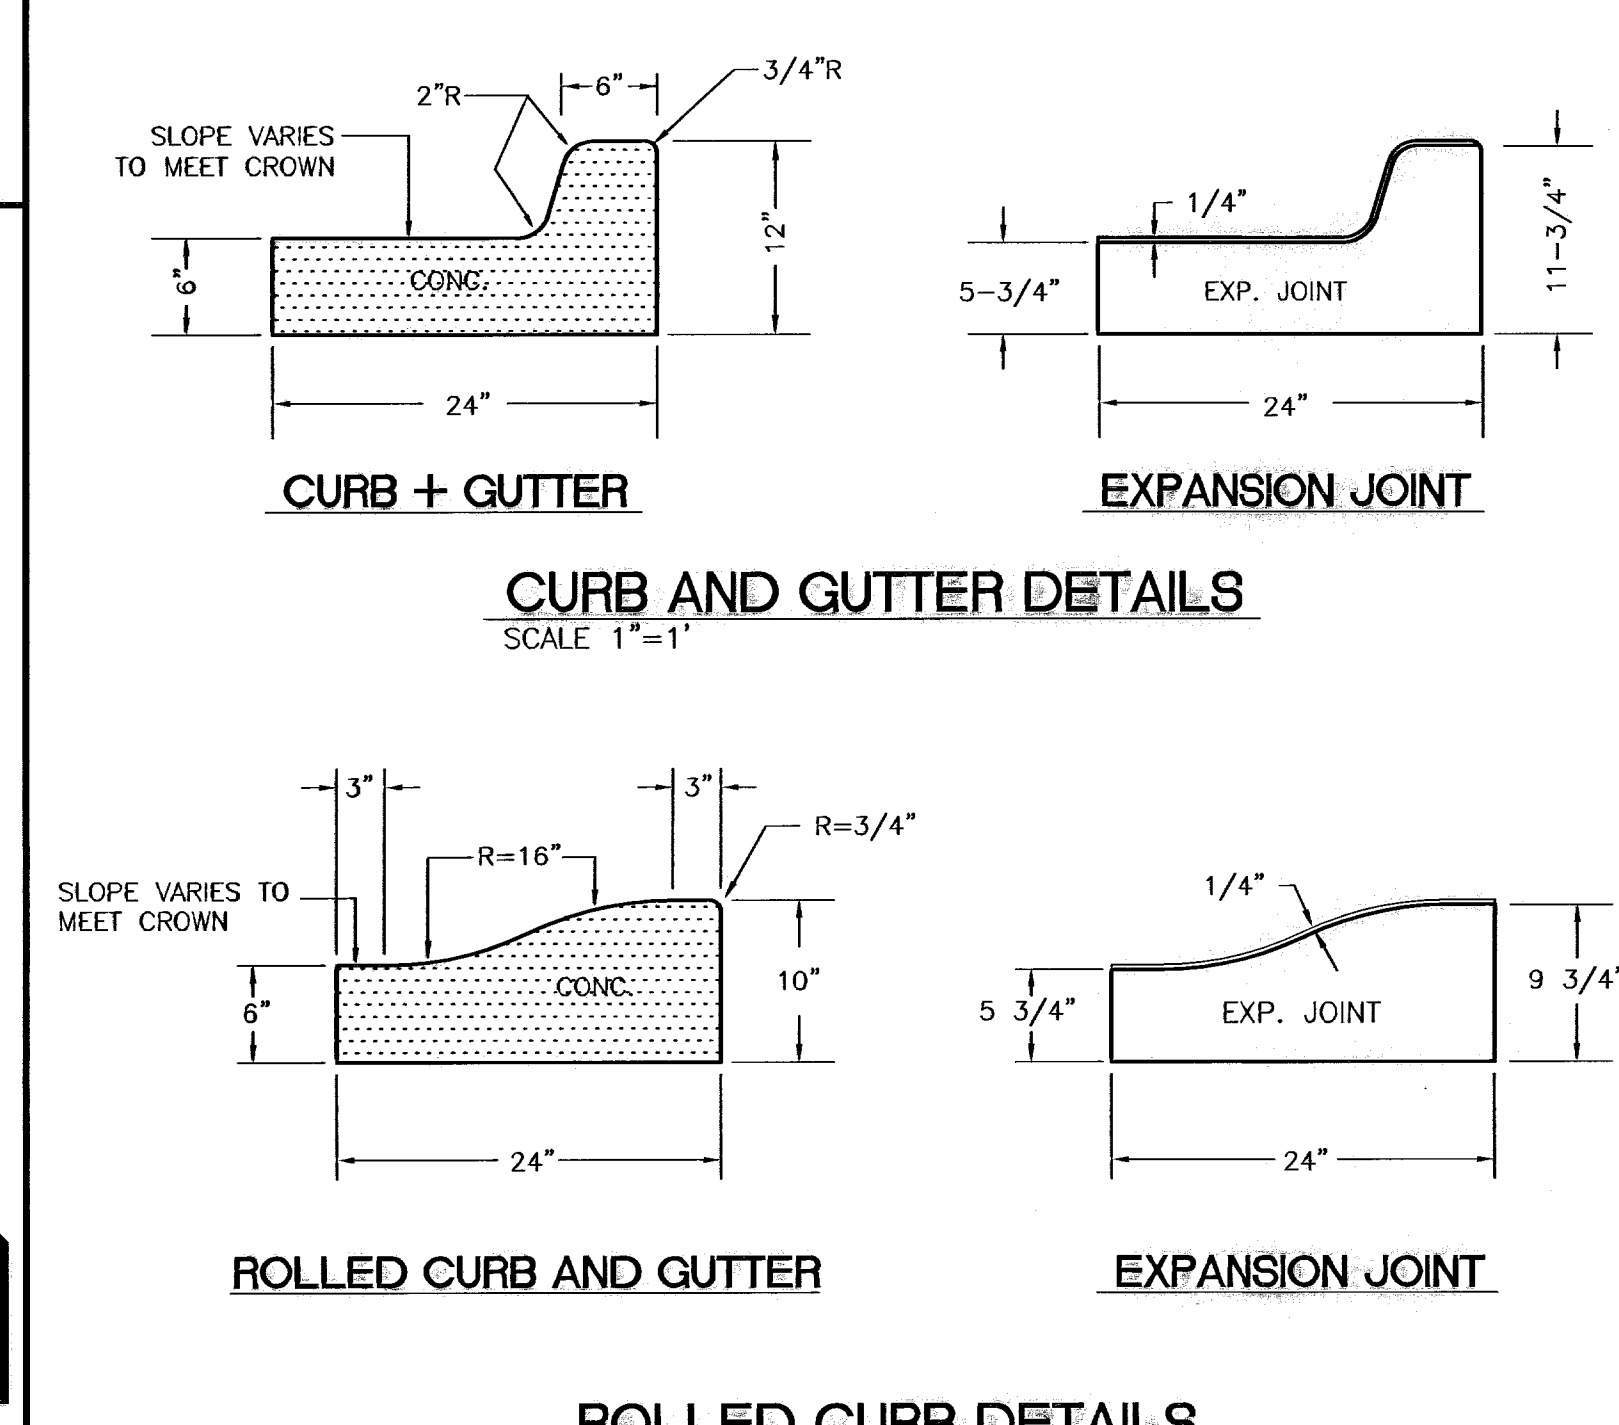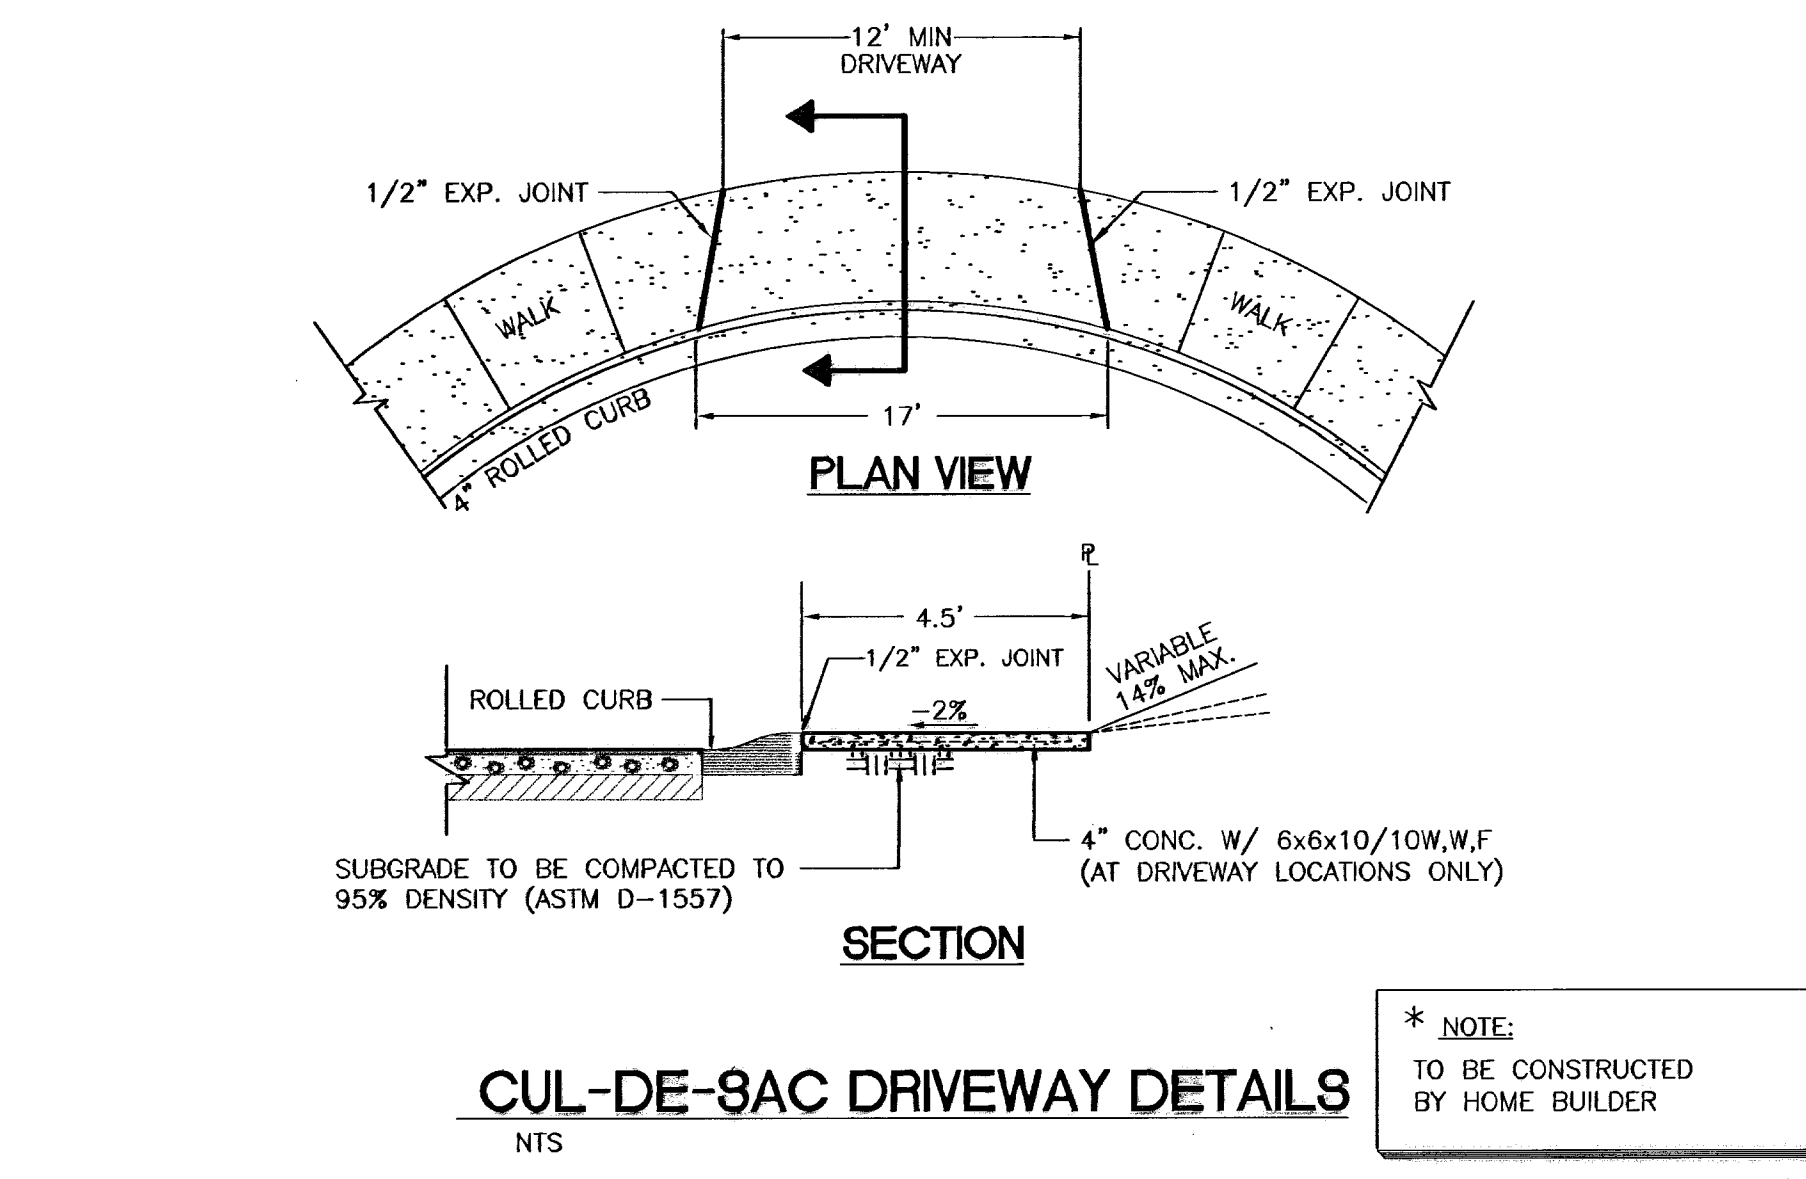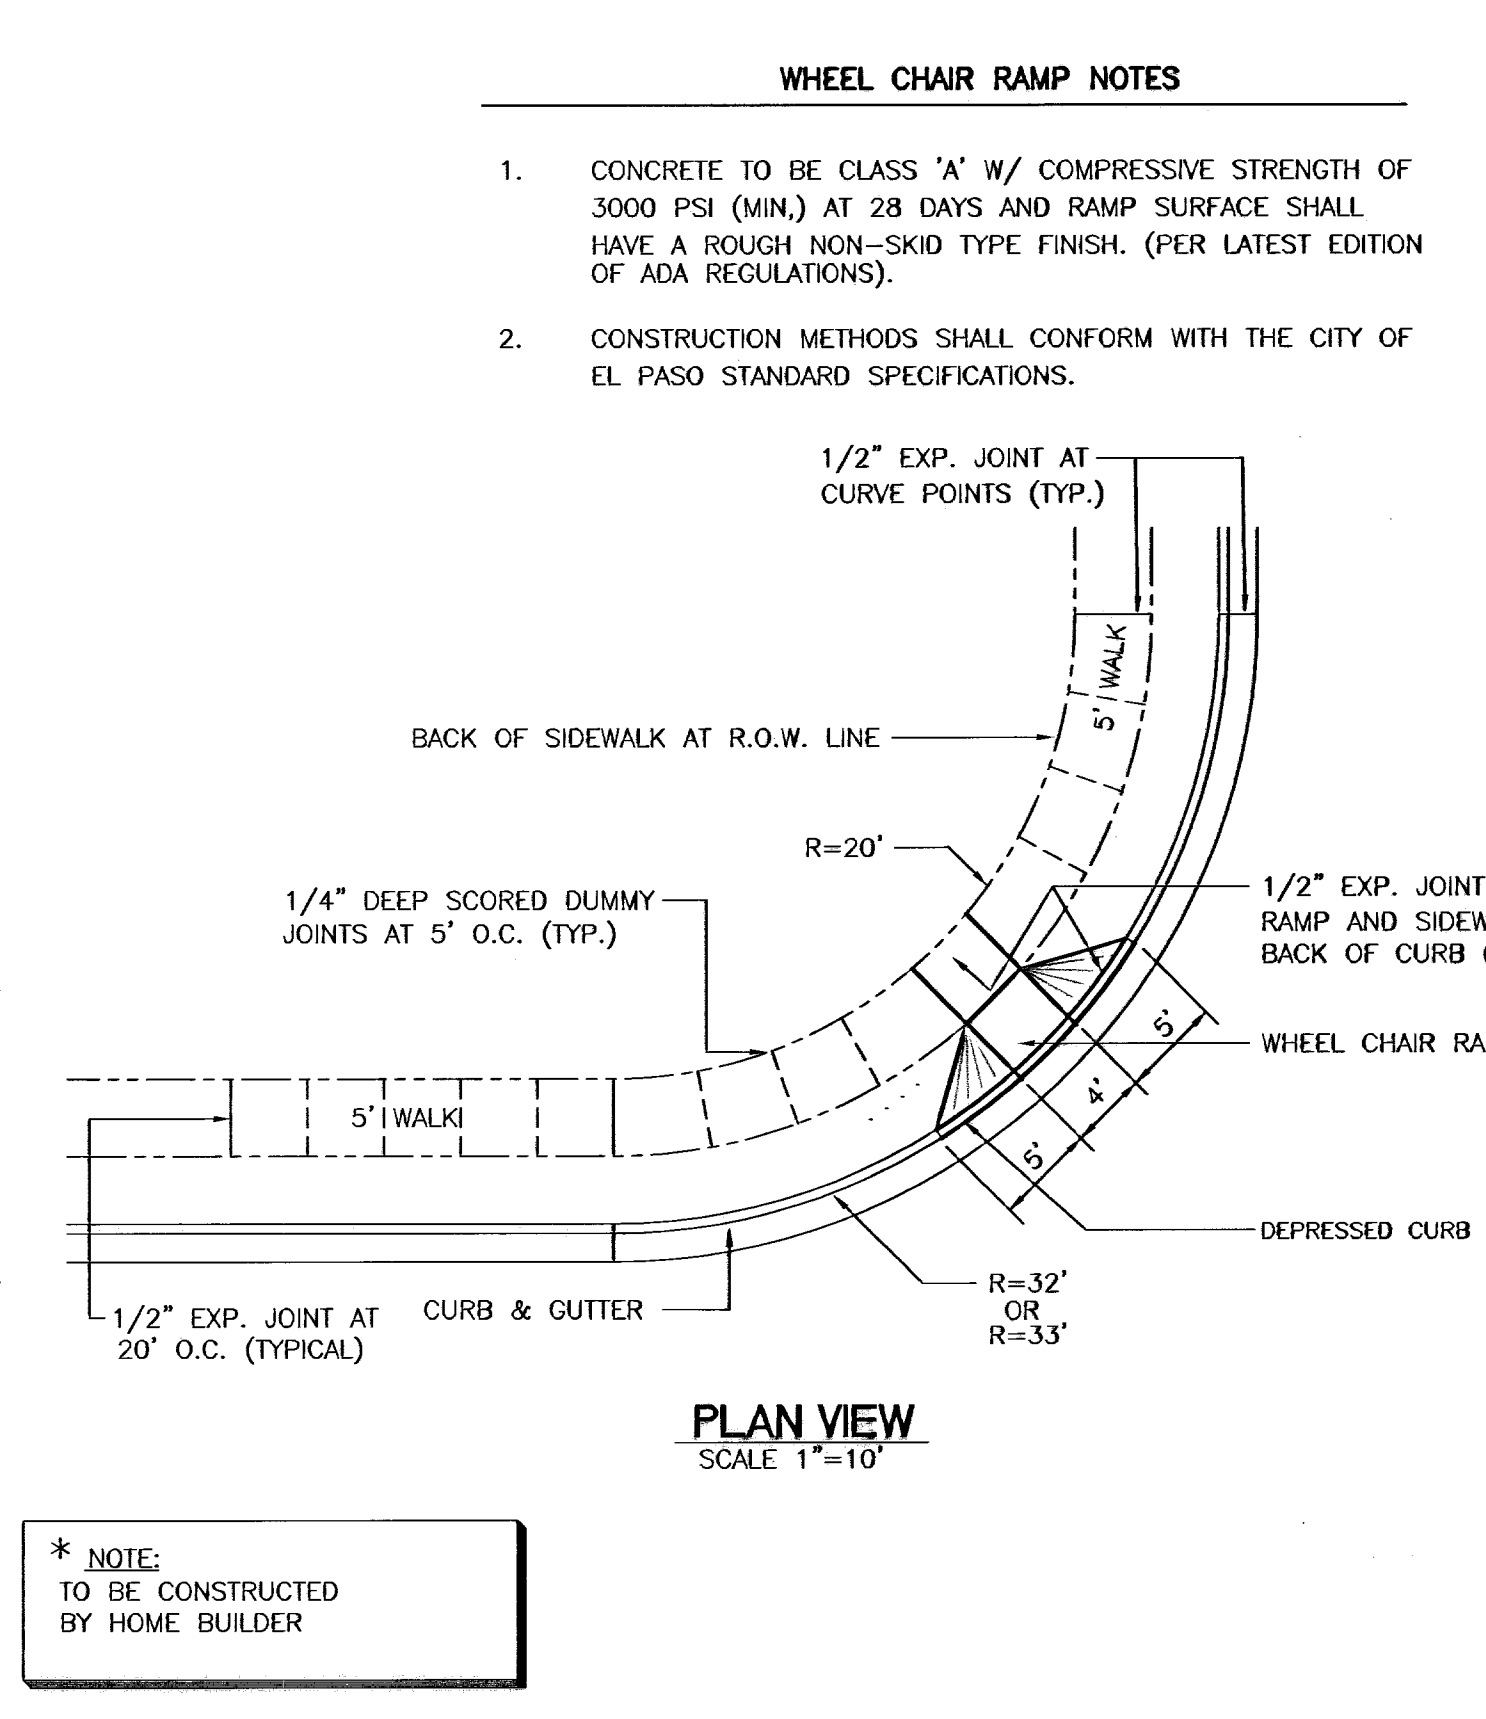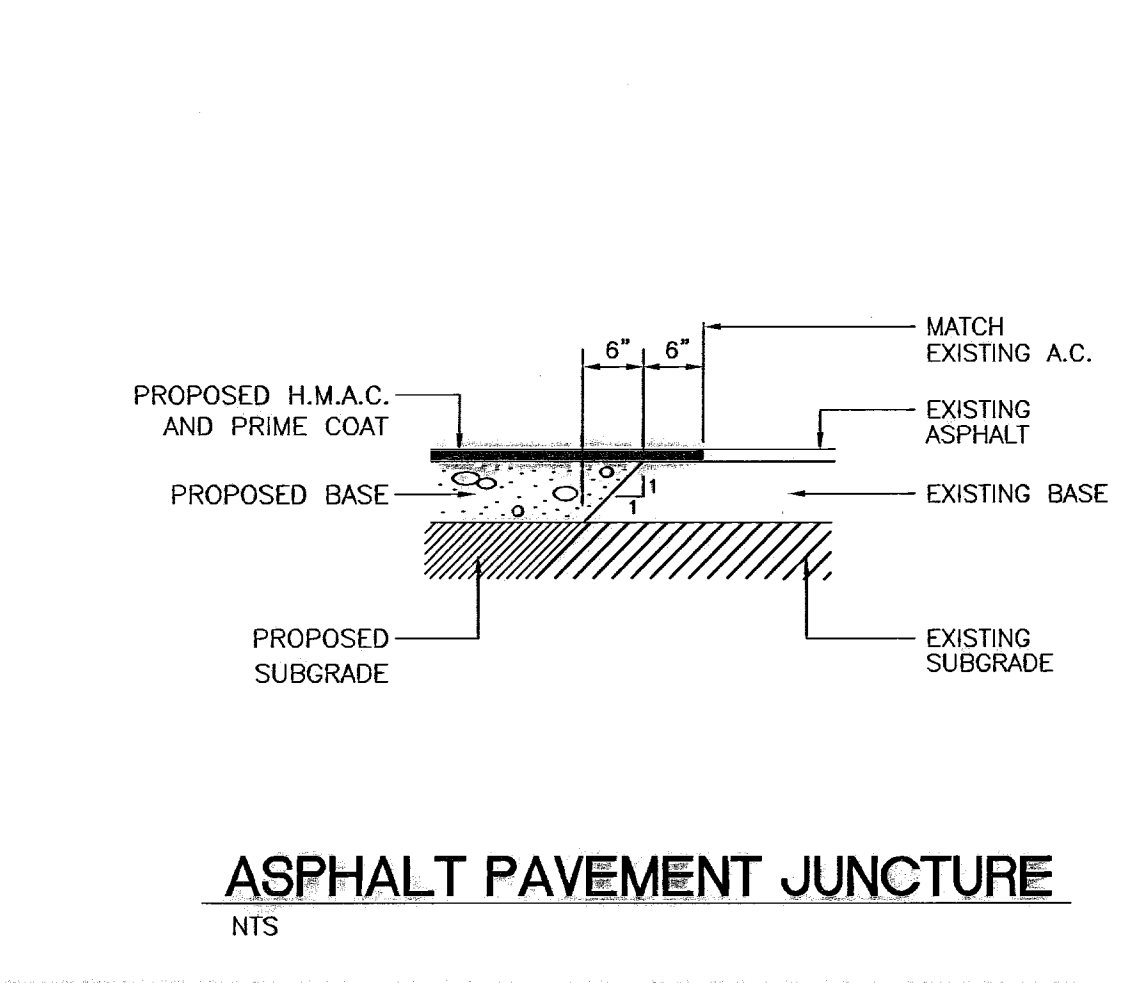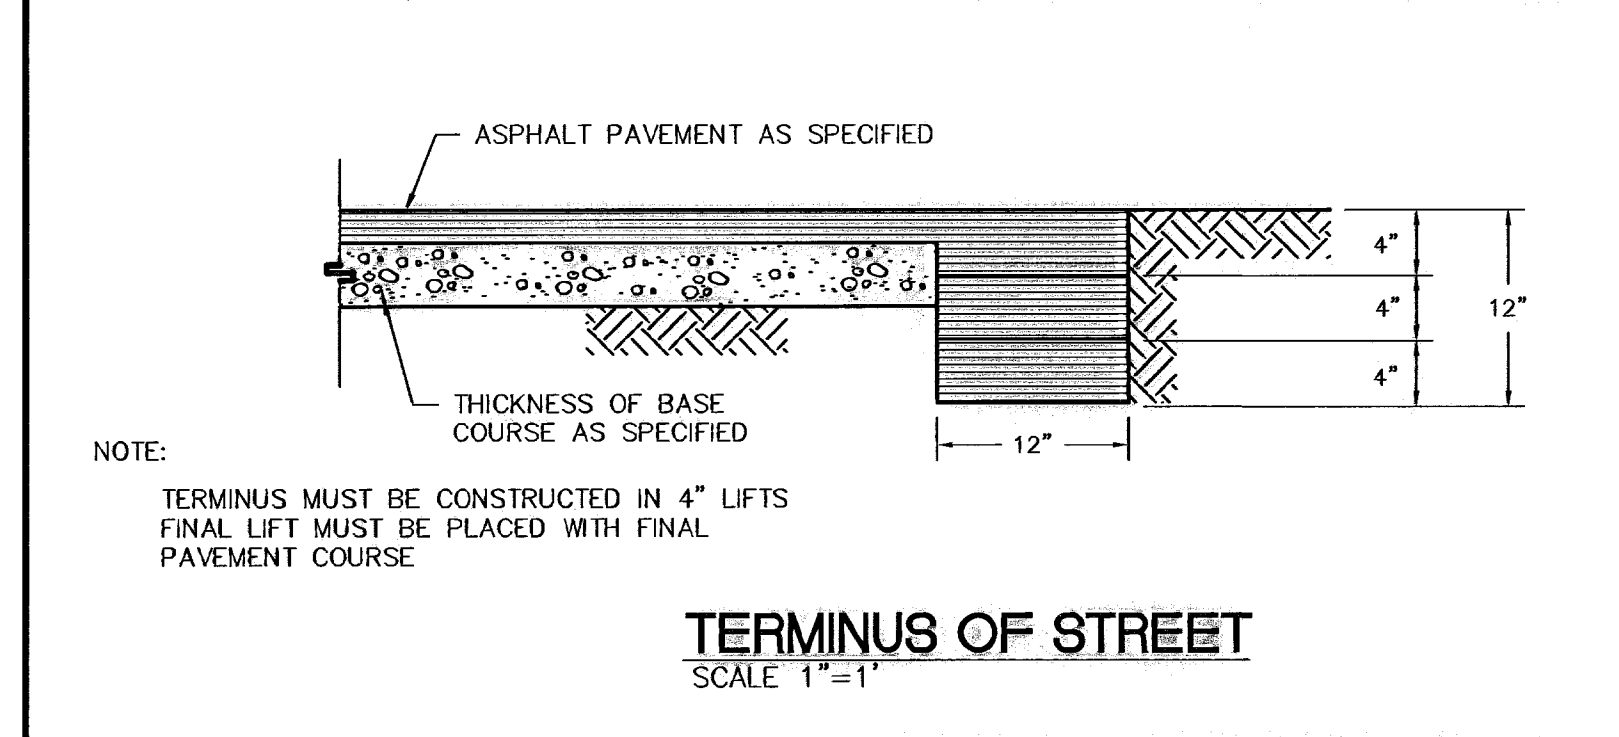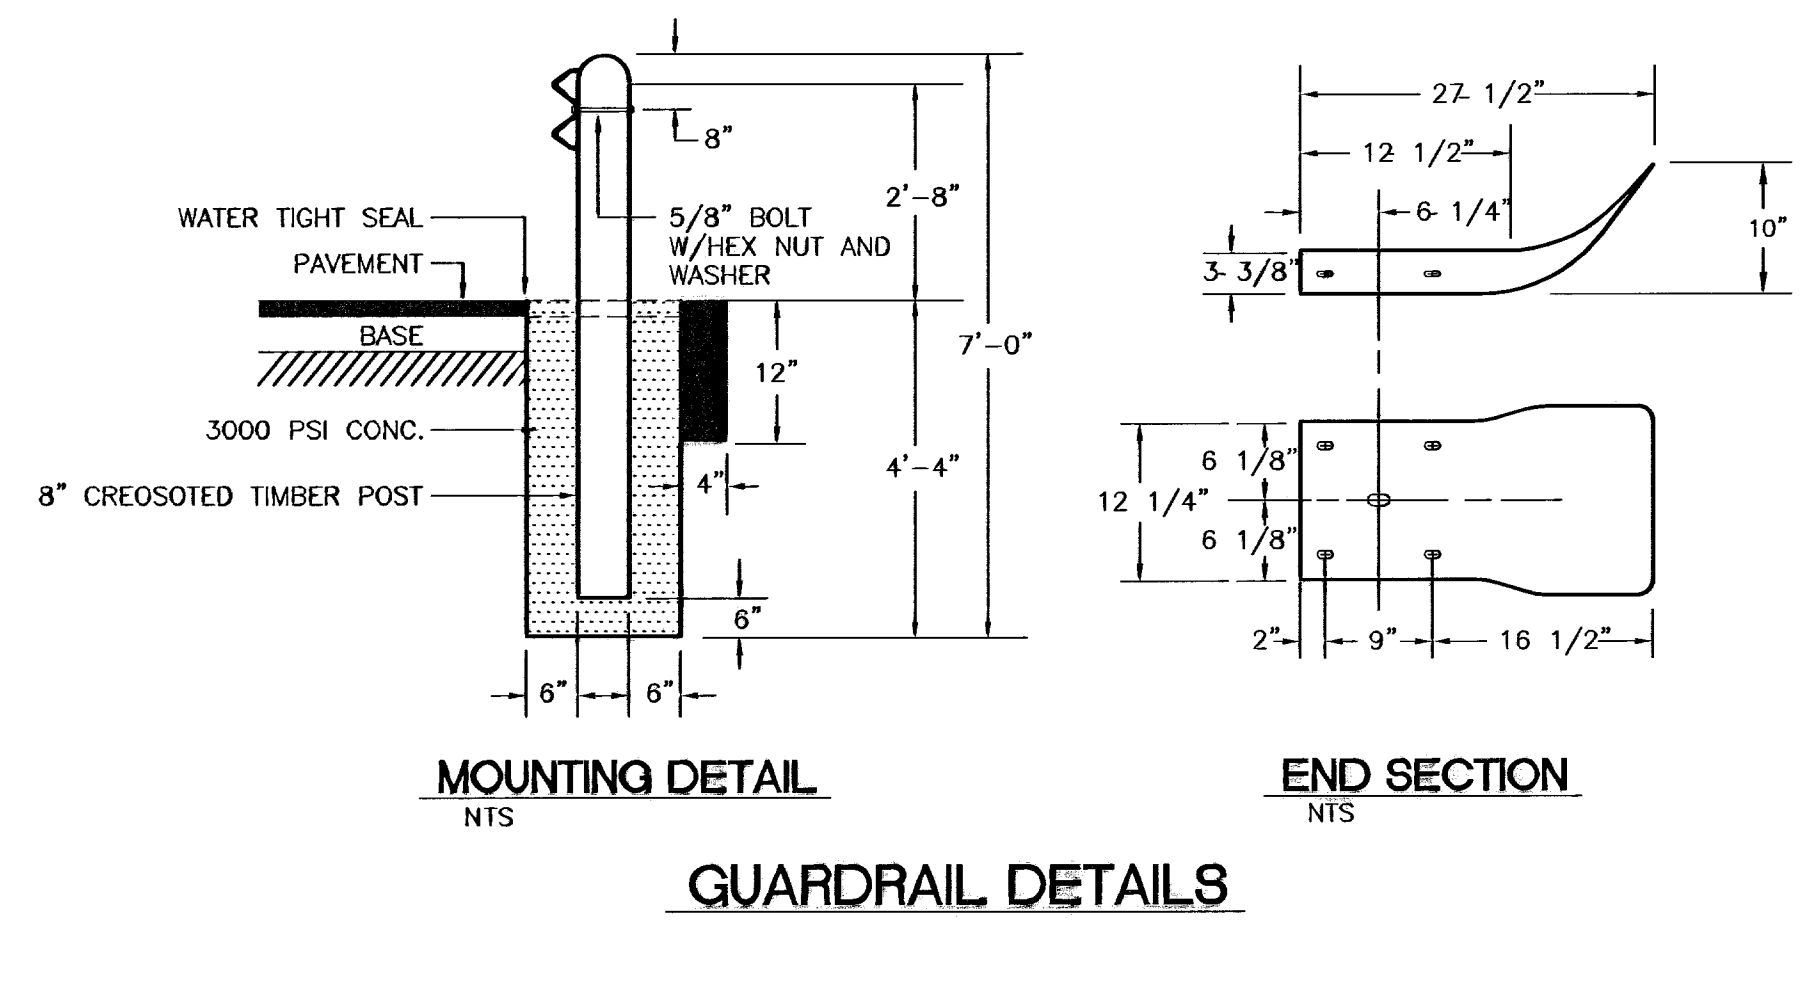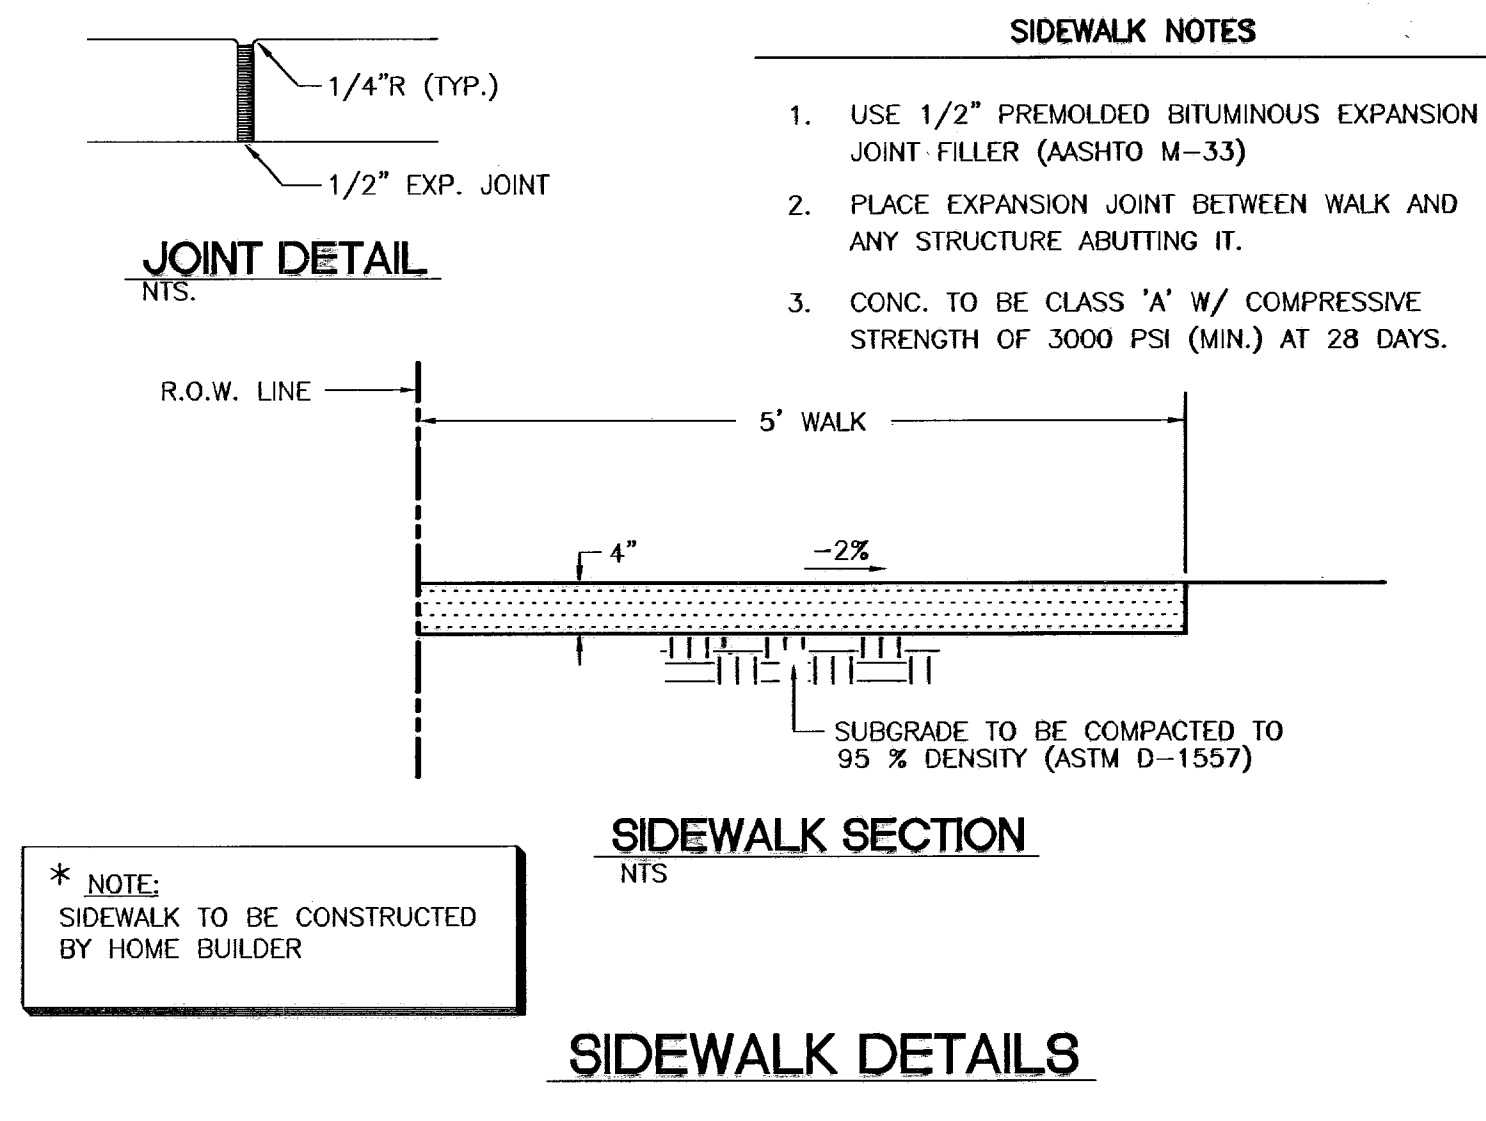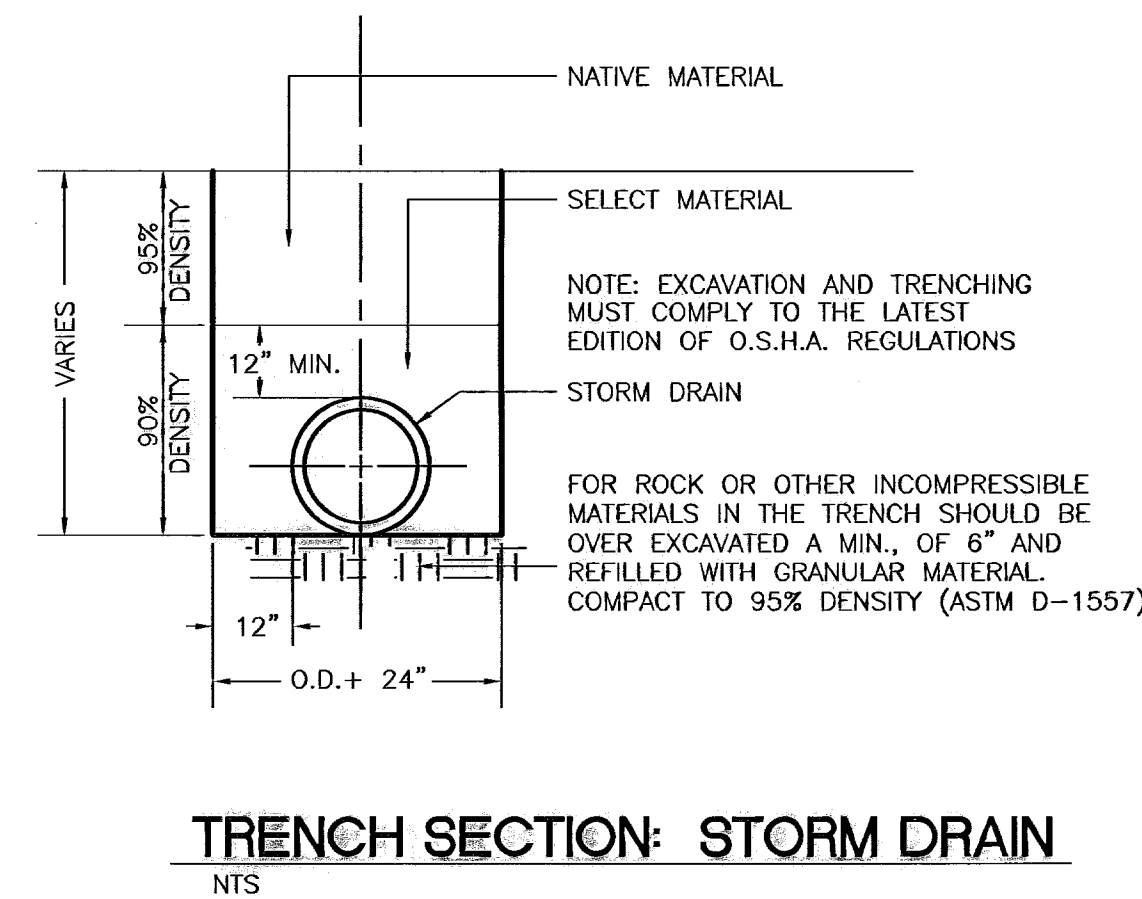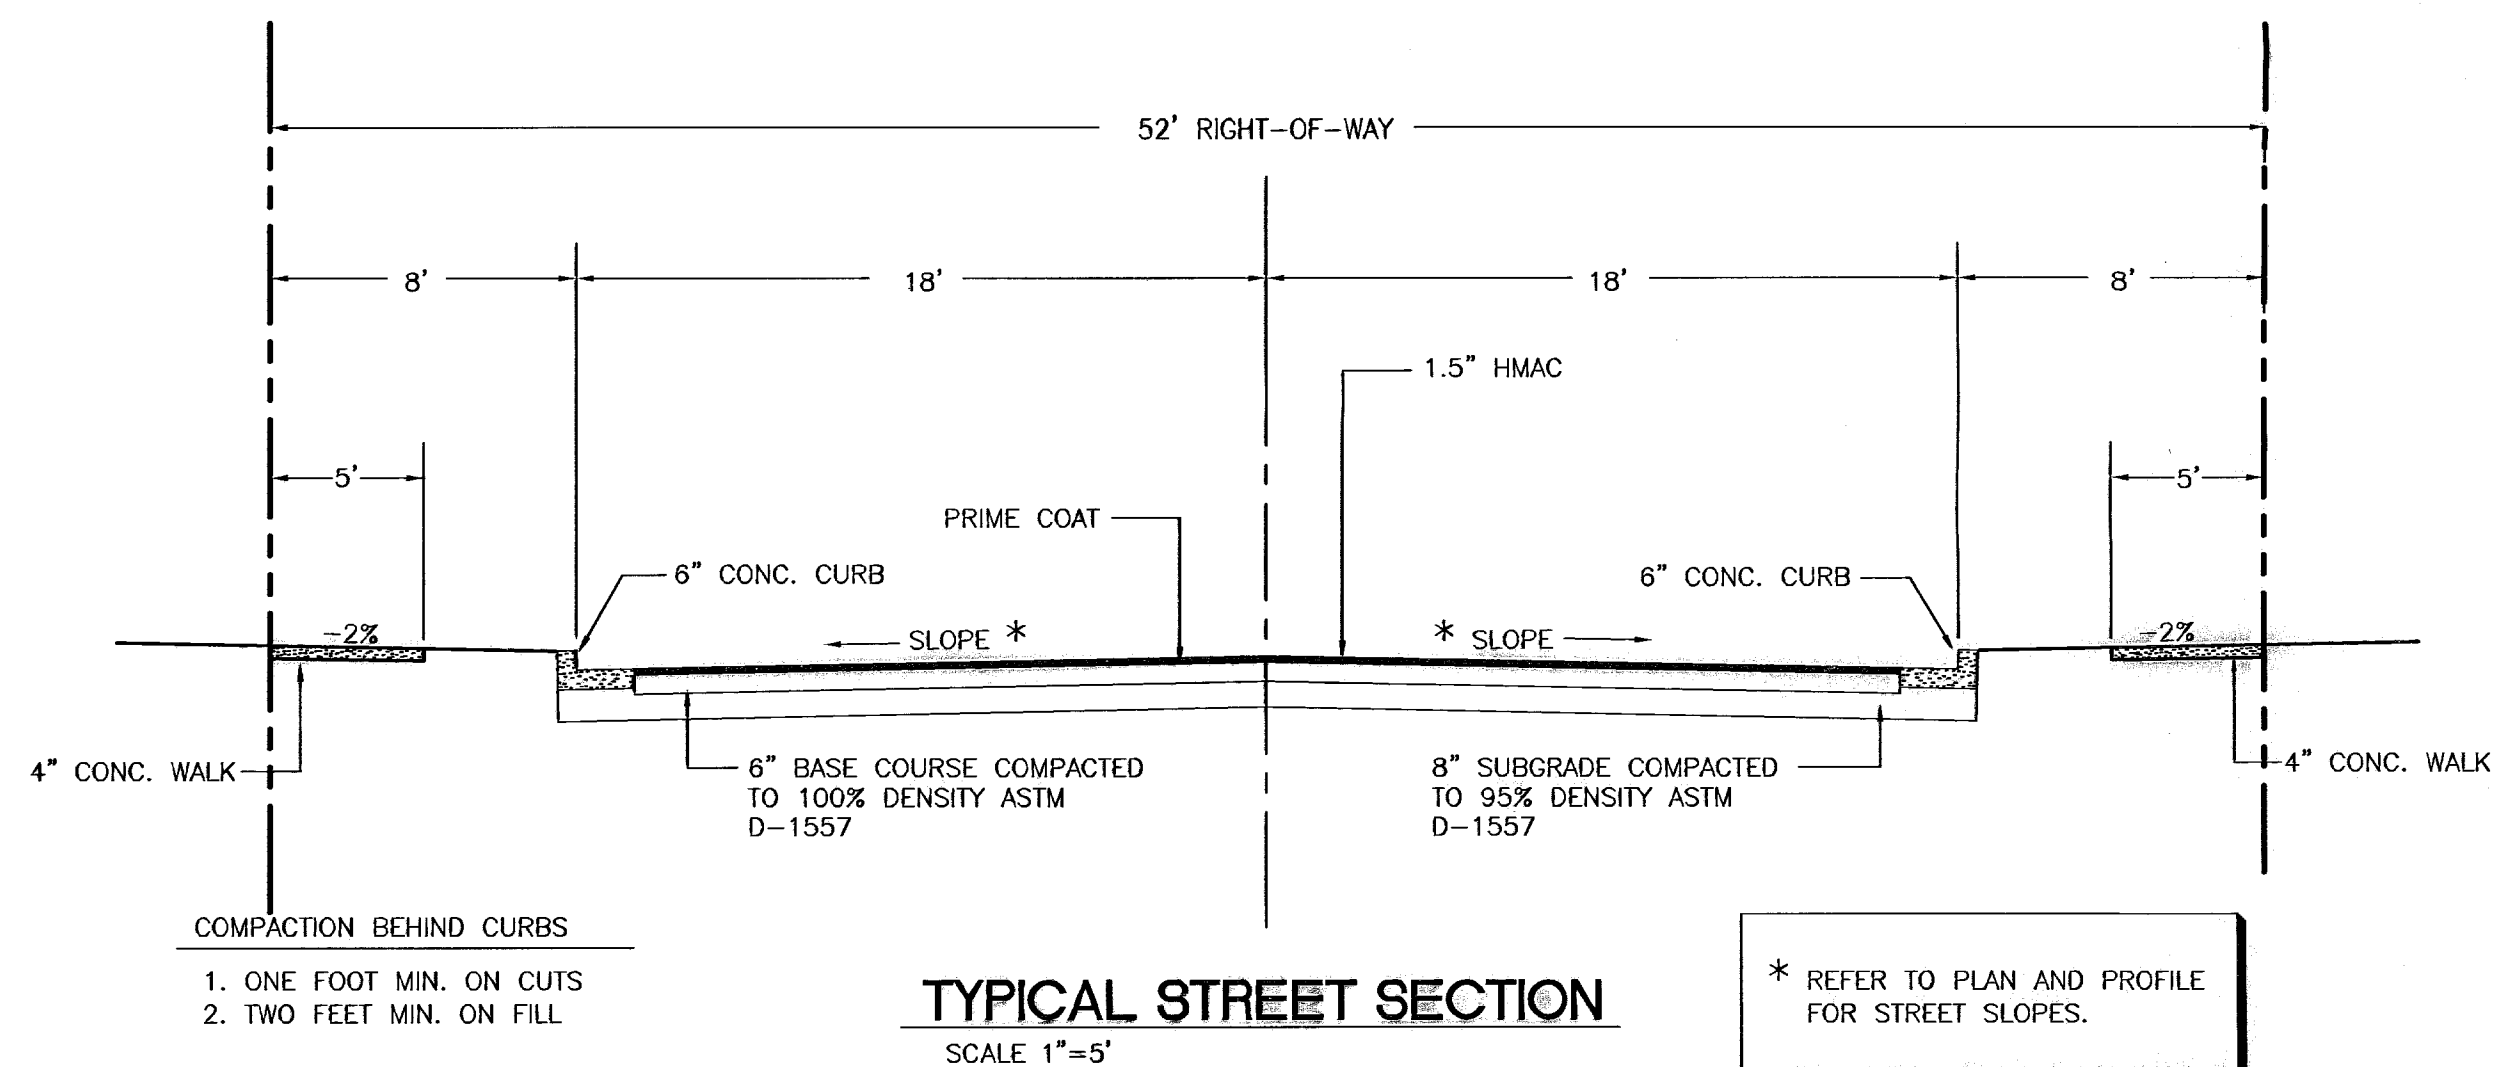

GENERAL NOTES FOR ROLLED CURB AND CURB & GUTTER



1. PROVIDE 1/2" PREMOLDED ASPHALT IMPREGNATED EXPANSION JOINT AT ALL CURVE POINTS AND WHERE THE NEW CURB WILL ABUT ANY EXISTING CURB. EXPANSION JOINT IS REQUIRED BETWEEN BACK OF CURB AND ANY STRUCTURE ABUTTING DIRECTLY AGAINST IT, AND SHALL BE PLACED IN ACCORDANCE WITH STANDARD SPECIFICATIONS.
2. TRIM EXPANSION JOINT MATERIAL 1/4" LESS THAN THE NEAT CURB AND GUTTER DIMENSION.
3. SUBGRADE UNDER CURB MUST BE FORMED AND COMPACTED. (95% ASTM D-1557)
4. CONCRETE SHALL BE CLASS 'A', AND HAVE A COMPRESSIVE STRENGTH OF 3000 PSI (MIN) AT 28 DAYS. (MACHINE LAID CURB AND GUTTER)
5. EXPANSION JOINTS FOR CURBS ARE TO BE PROVIDED AT CHANGES OF DIRECTIONS, AT ALL CURB RETURNS, AND WHERE CURB ABUTS OTHER MASONRY STRUCTURES.
6. ONE-INCH MINIMUM SCORED CONSTRUCTION JOINTS ARE TO BE PROVIDED EVERY 10 FEET FOR CURB AND GUTTER, AND EVERY 5 FEET FOR SIDEWALKS.
7. REJECTED DEFECTIVE CURB MUST BE REPLACED IN 10.0 LONG SECTIONS, MINIMUM.

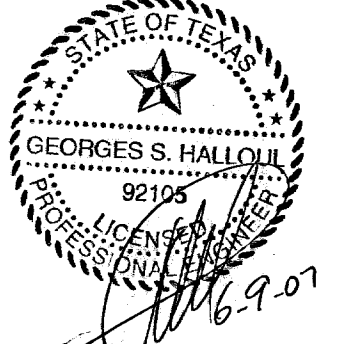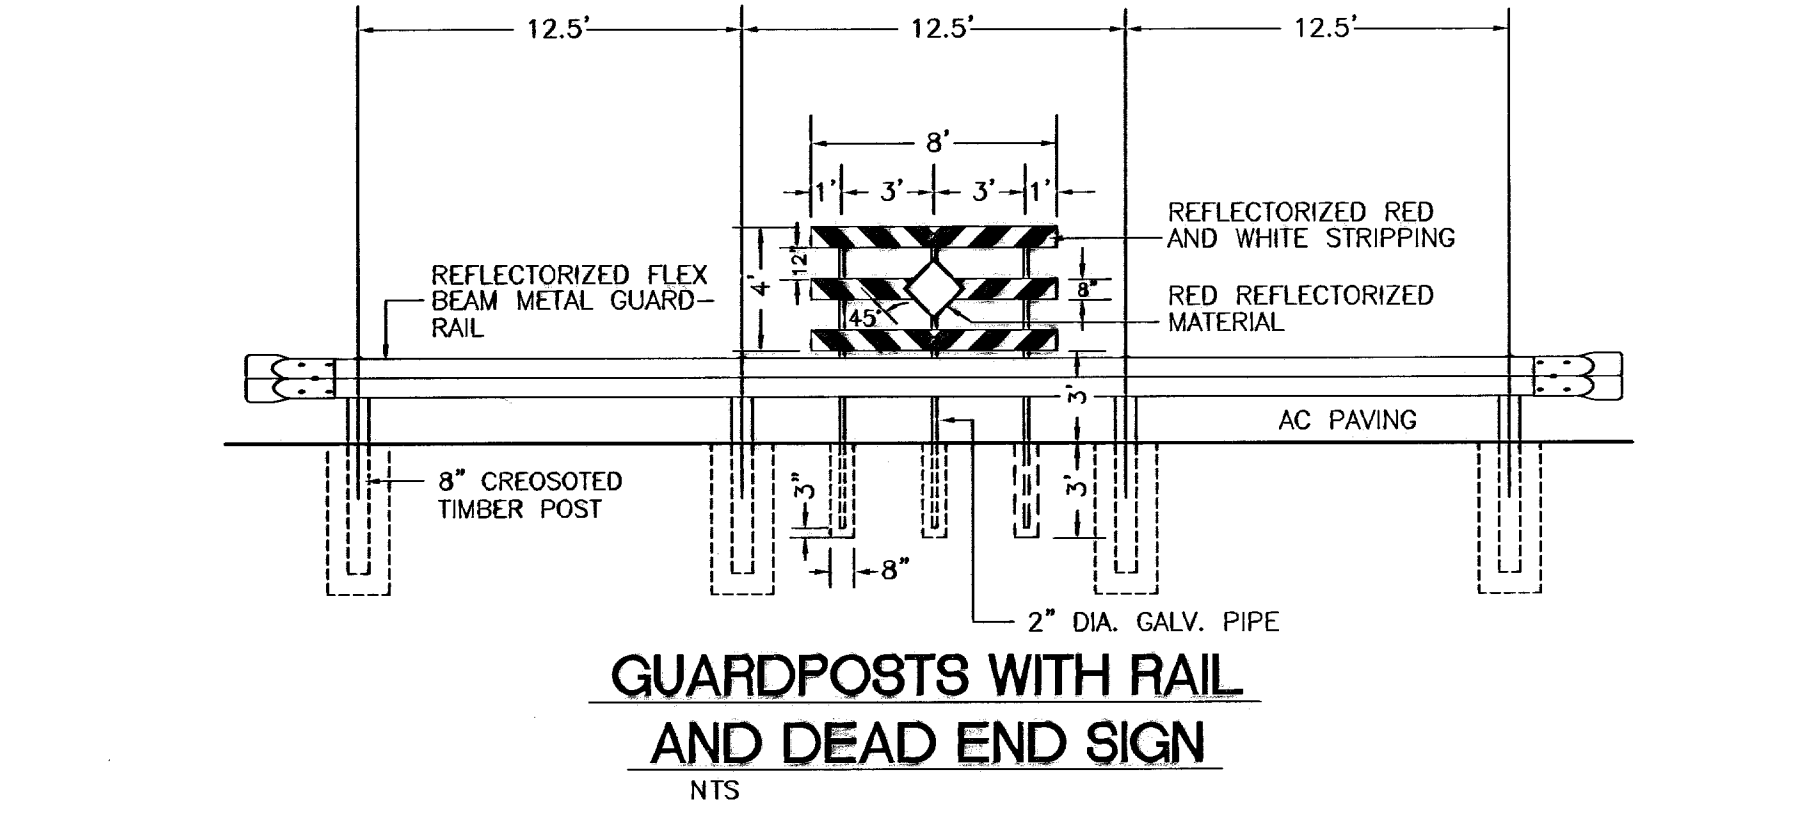



DATE	REVISION	DESCRIPTION	BY

SCALE: AS NOTED
JOB No. 09-04-2170
FIELD BOOK
DESIGNED BY: ET
COMP. BY: ET
DRAWN BY: ET
CHECKED BY: ET
DATE: 08/02/05


TUSCANY AT RIDGEVIEW
EL PASO, EL PASO COUNTY, TEXAS
TYPICAL SECTIONS
AS-BUILT
SLI ENGINEERING, INC.
CIVIL ENGINEERS * LAND SURVEYORS * LAND PLANNERS
6600 WESTWIND DR. - EL PASO, TEXAS - 79912 - (915) 584-4457

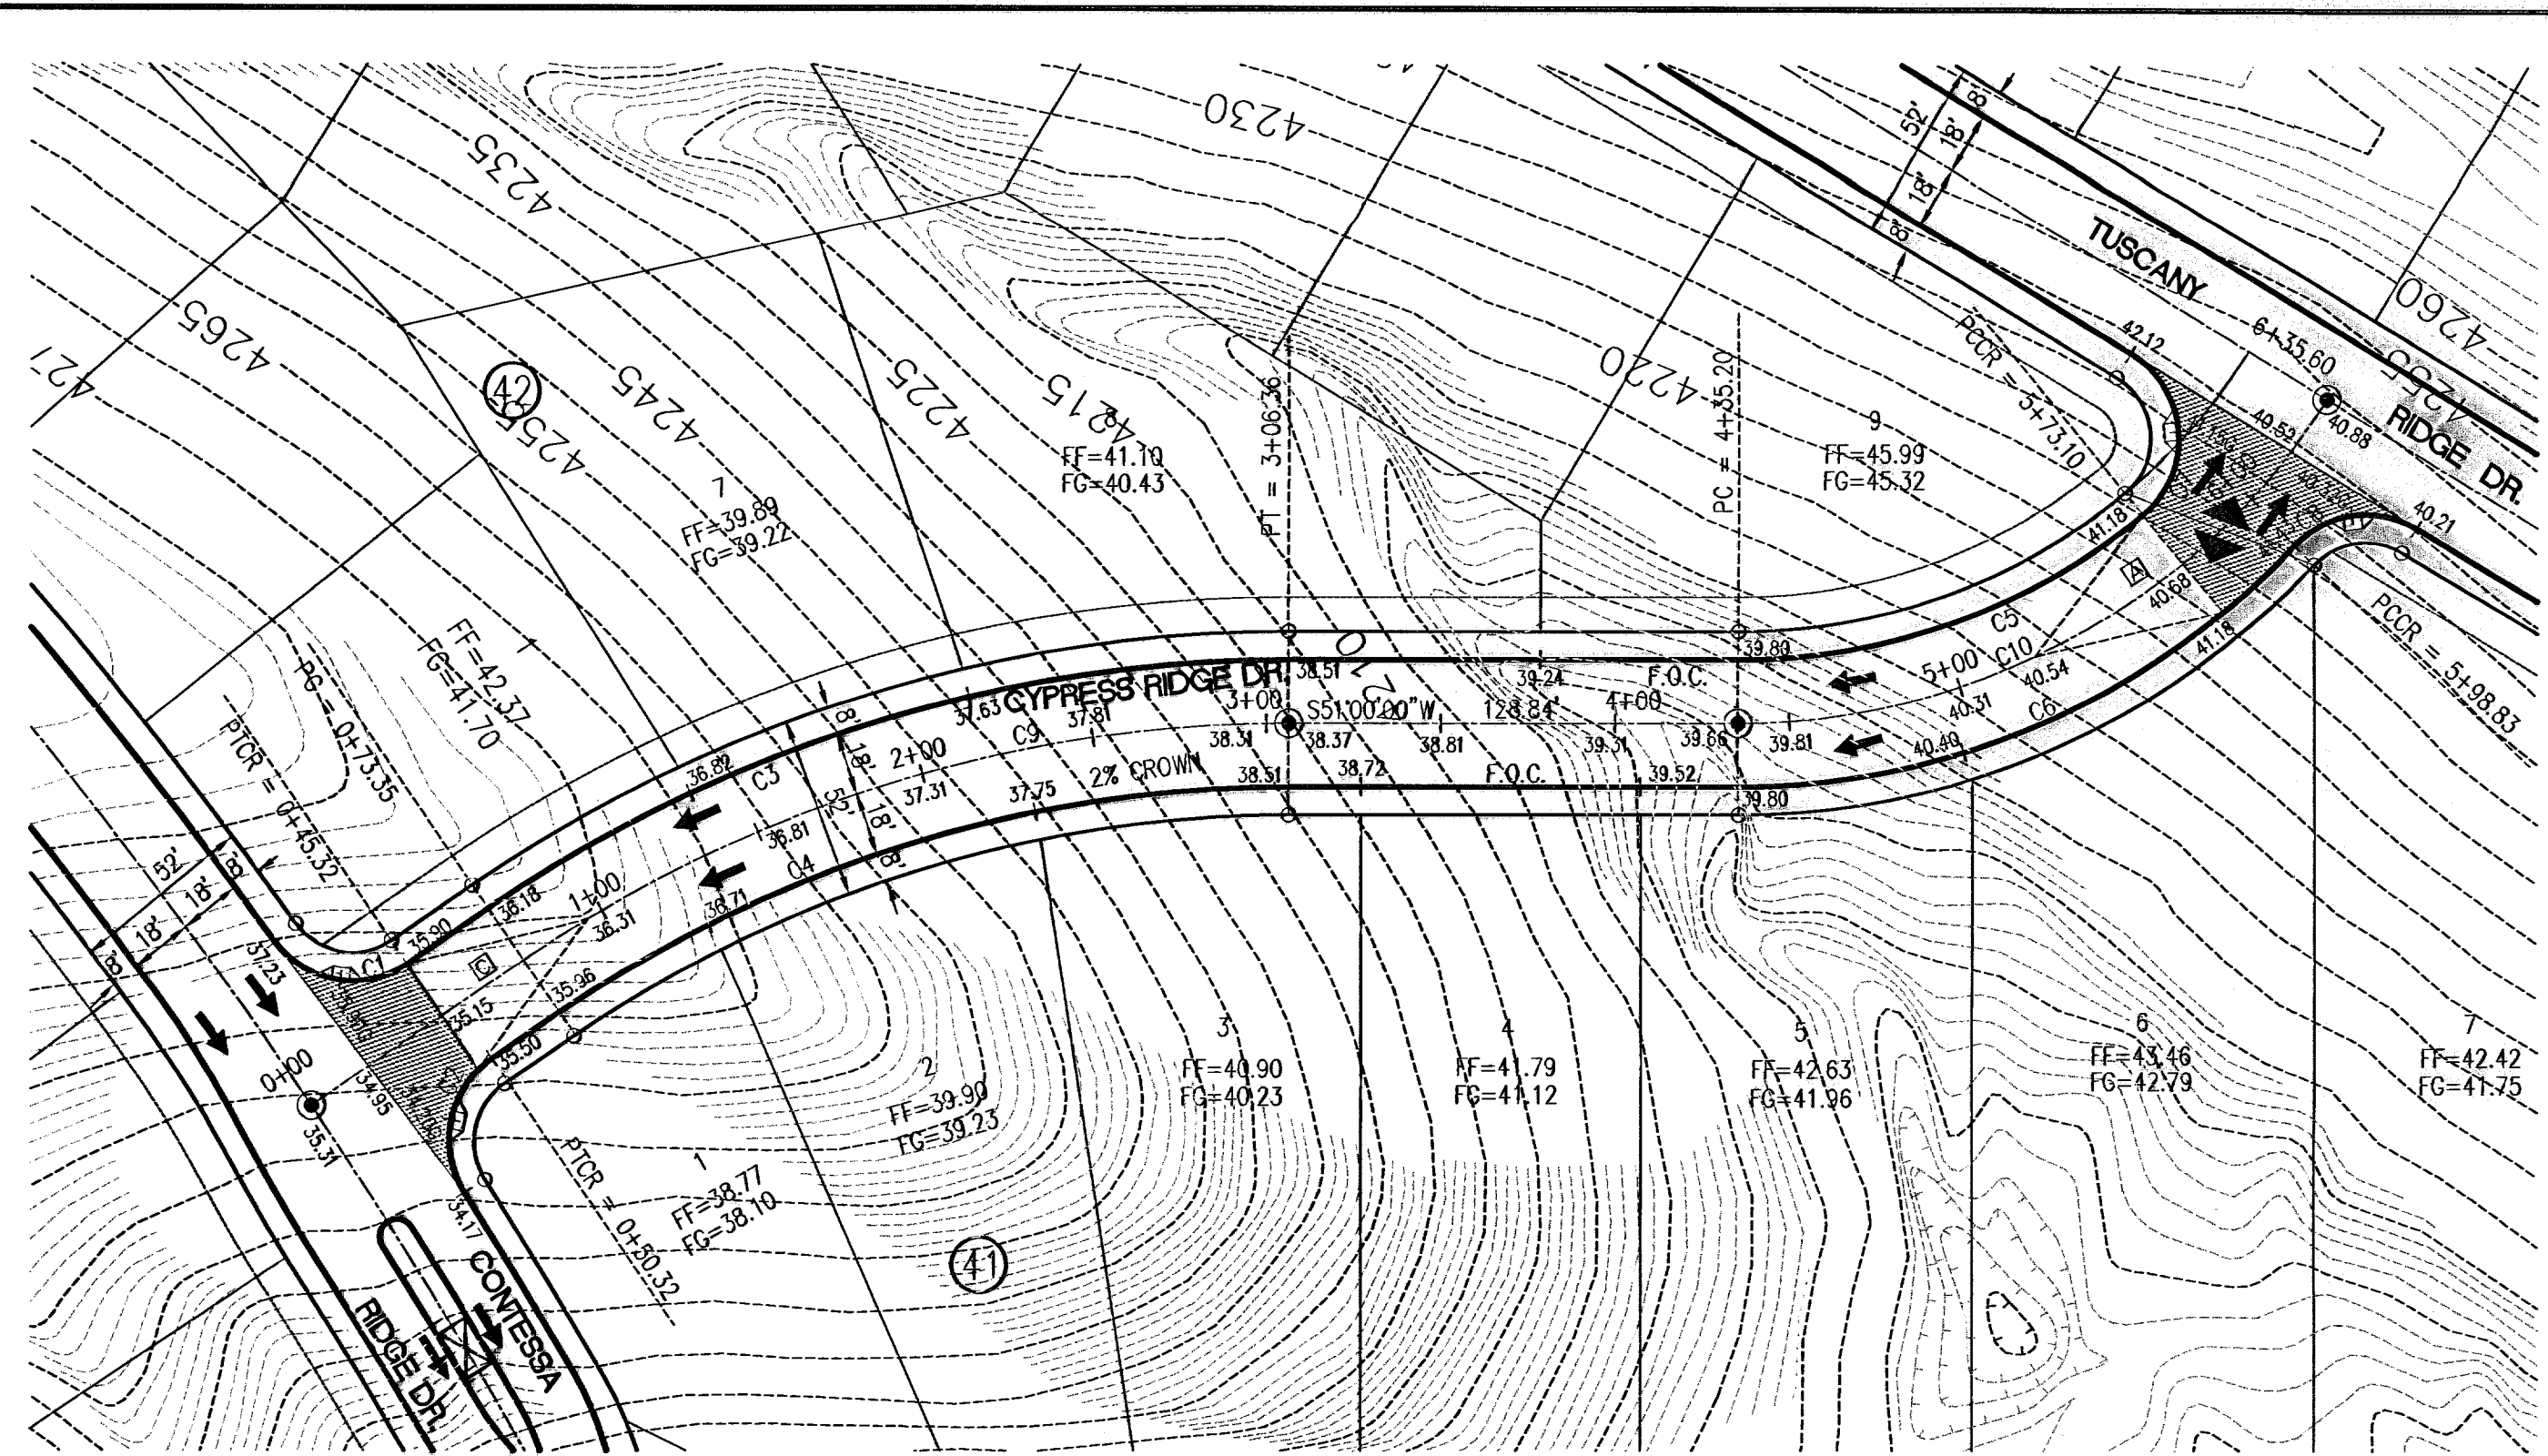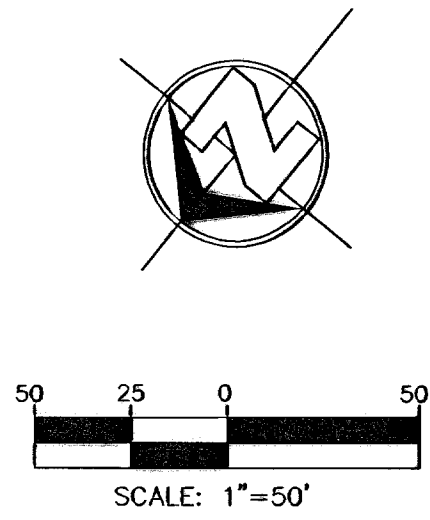

CURVE	RADIUS	LENGTH	TANGENT	CHORD	BEARING	DELTA
C1	28.00'	43.15'	27.18'	39.00'	S60°54'53"W	88°17'42"
C2	28.00'	43.15'	27.18'	39.00'	S27°22'59"E	88°18'02"
C3	408.00'	243.77'	125.64'	240.16'	S33°53'01"W	34°13'58"
C4	372.00'	222.26'	114.56'	218.97'	S33°53'01"W	34°13'58"
C5	182.00'	125.49'	65.35'	123.02'	S31°14'51"W	39°30'18"
C6	218.00'	178.36'	94.51'	173.43'	S27°33'14"W	46°52'17"
C7	28.00'	53.43'	39.50'	45.68'	S43°10'18"E	109°19'59"
C8	28.00'	38.14'	22.69'	35.28'	S43°08'33"W	78°02'20"
C9	390.00'	233.01'	120.10'	229.56'	S33°53'01"W	34°13'58"
C10	200.00'	200.40'	109.52'	192.12'	S22°17'41"W	57°24'37"

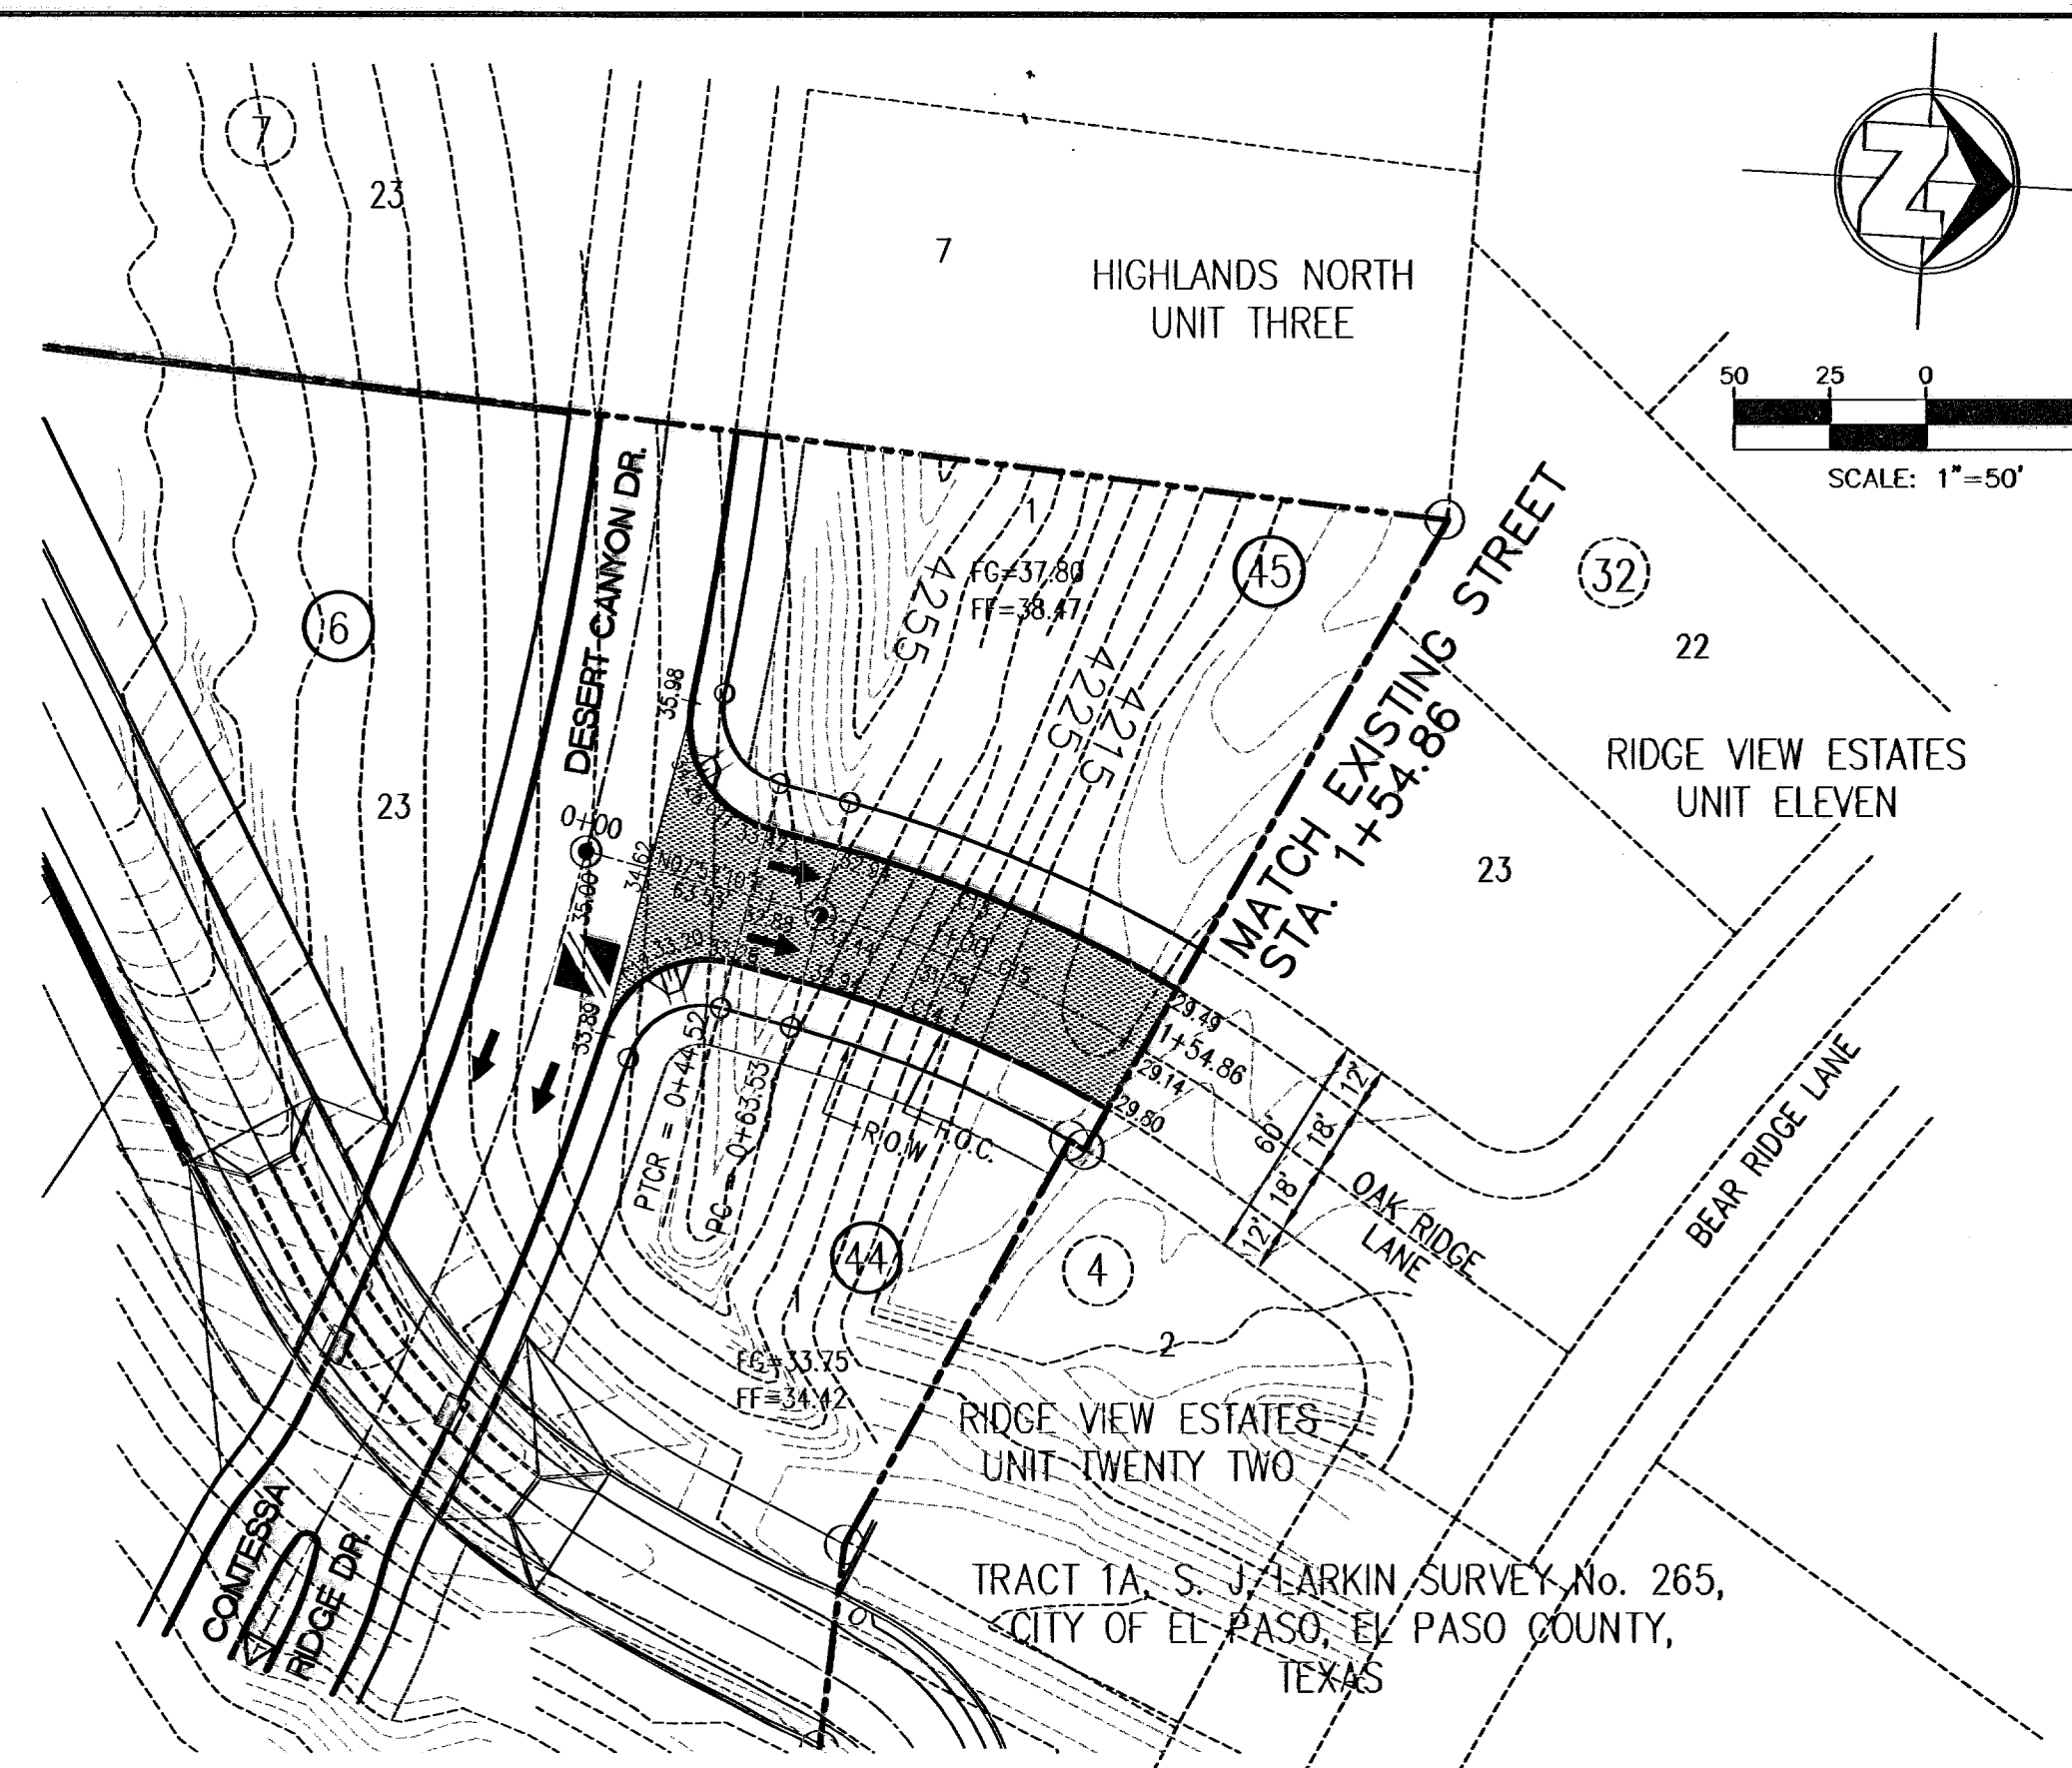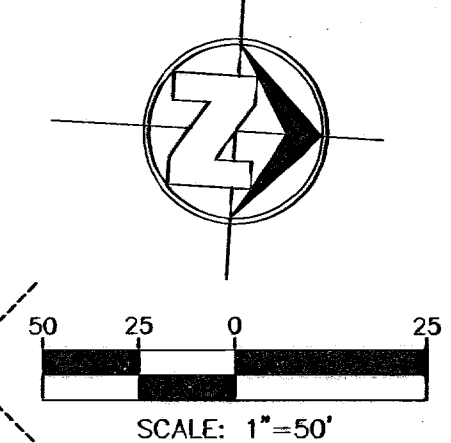

CURVE	RADIUS	LENGTH	TANGENT	CHORD	BEARING	DELTA
C11	28.00'	42.46'	26.52'	38.51'	N61°23'40"E	86°52'59"
C12	28.00'	42.46'	26.52'	38.51'	S35°29'20"E	86°52'59"
C13	363.00'	96.09'	48.33'	95.81'	S15°32'11"W	15°10'01"
C14	327.00'	86.56'	43.54'	86.31'	S15°32'11"W	15°10'01"
C15	345.00'	91.33'	45.93'	91.06'	S15°32'11"W	15°10'01"

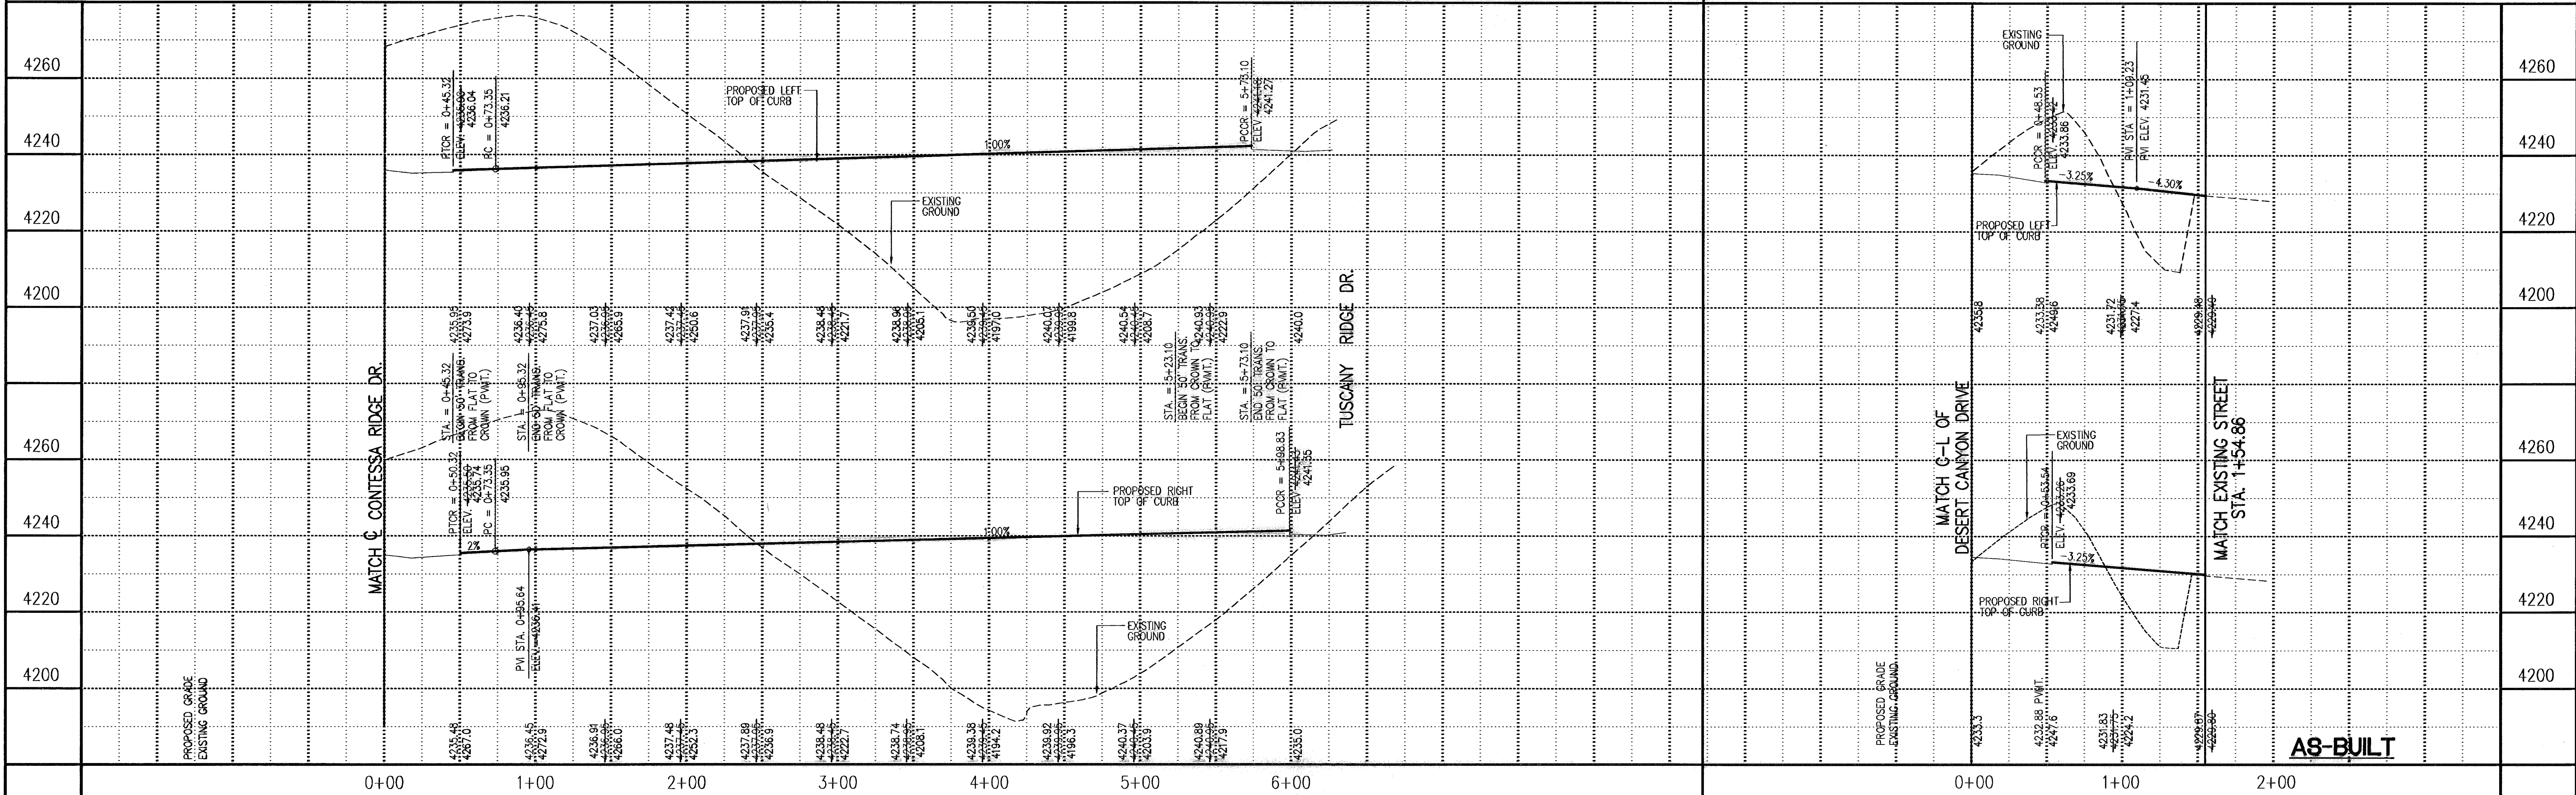

PLAN

PAVEMENT TRANSITIONS

- [A] = TRANSITION FROM CROWN TO FLAT
- [B] = TRANSITION FROM CROWN TO INVERT CROWN
- [C] = TRANSITION FROM FLAT TO CROWN
- [D] = TRANSITION FROM FLAT TO INVERT CROWN
- [E] = TRANSITION FROM INVERT TO CROWN
- [F] = TRANSITION FROM INVERT TO FLAT

LEGEND

- [Symbol] = R.O.W. = RIGHT-OF-WAY
- [Symbol] = PROPOSED CITY MONUMENT
- [Symbol] = PROPOSED WATER FLOW
- [Symbol] = FLAT AREA
- [Symbol] = F.O.C. = FACE OF CURB
- [Symbol] = HIGH POINT ON STREET
- [Symbol] = LOW POINT ON STREET

PROFILE


- [Symbol] = EXISTING GROUND PROFILE
- [Symbol] = PROPOSED FINISHED GRADE PROFILE

NOTES

- ALL STREET HAS A 2% CROWN SECTION UNLESS OTHERWISE INDICATED.
- ALL CURB IS 6" STANDARD CURB AND GUTTER UNLESS OTHERWISE INDICATED.
- REFER TO SHEET 3 OF 13 FOR TYPICAL STREET SECTIONS AND DETAILS.

BENCHMARK

EXISTING CITY MONUMENT AT CENTERLINE INTERSECTION OF MAJESTIC RIDGE DR. AND EAGLE RIDGE DR. ELEVATION 4213.08 (CITY DATUM)

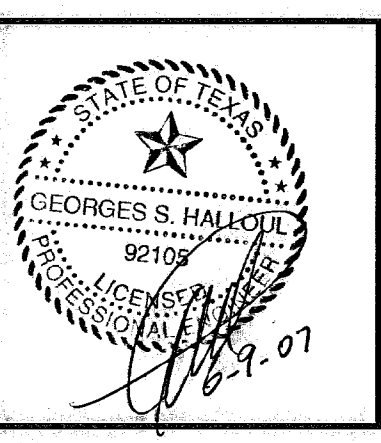

SCALE

HOR. 1" = 50'

VER. 1" = 20'

DATE	REVISION	DESCRIPTION	BY

TUSCANY AT RIDGE VIEW
EL PASO, EL PASO COUNTY, TEXAS

CYPRESS RIDGE DR. AND OAK RIDGE LANE




SLI ENGINEERING, INC.
CIVIL ENGINEERS • LAND SURVEYORS • LAND PLANNERS
6600 WESTWIND DR. - EL PASO, TEXAS - 79912 - (915) 584-4457

SLI


SHEET **4** OF 13

F:\PROJECTS\14\AS-BUILT\15\PCYPDR.dwg 6/6/2007 8:51:04 AM MDT


600830

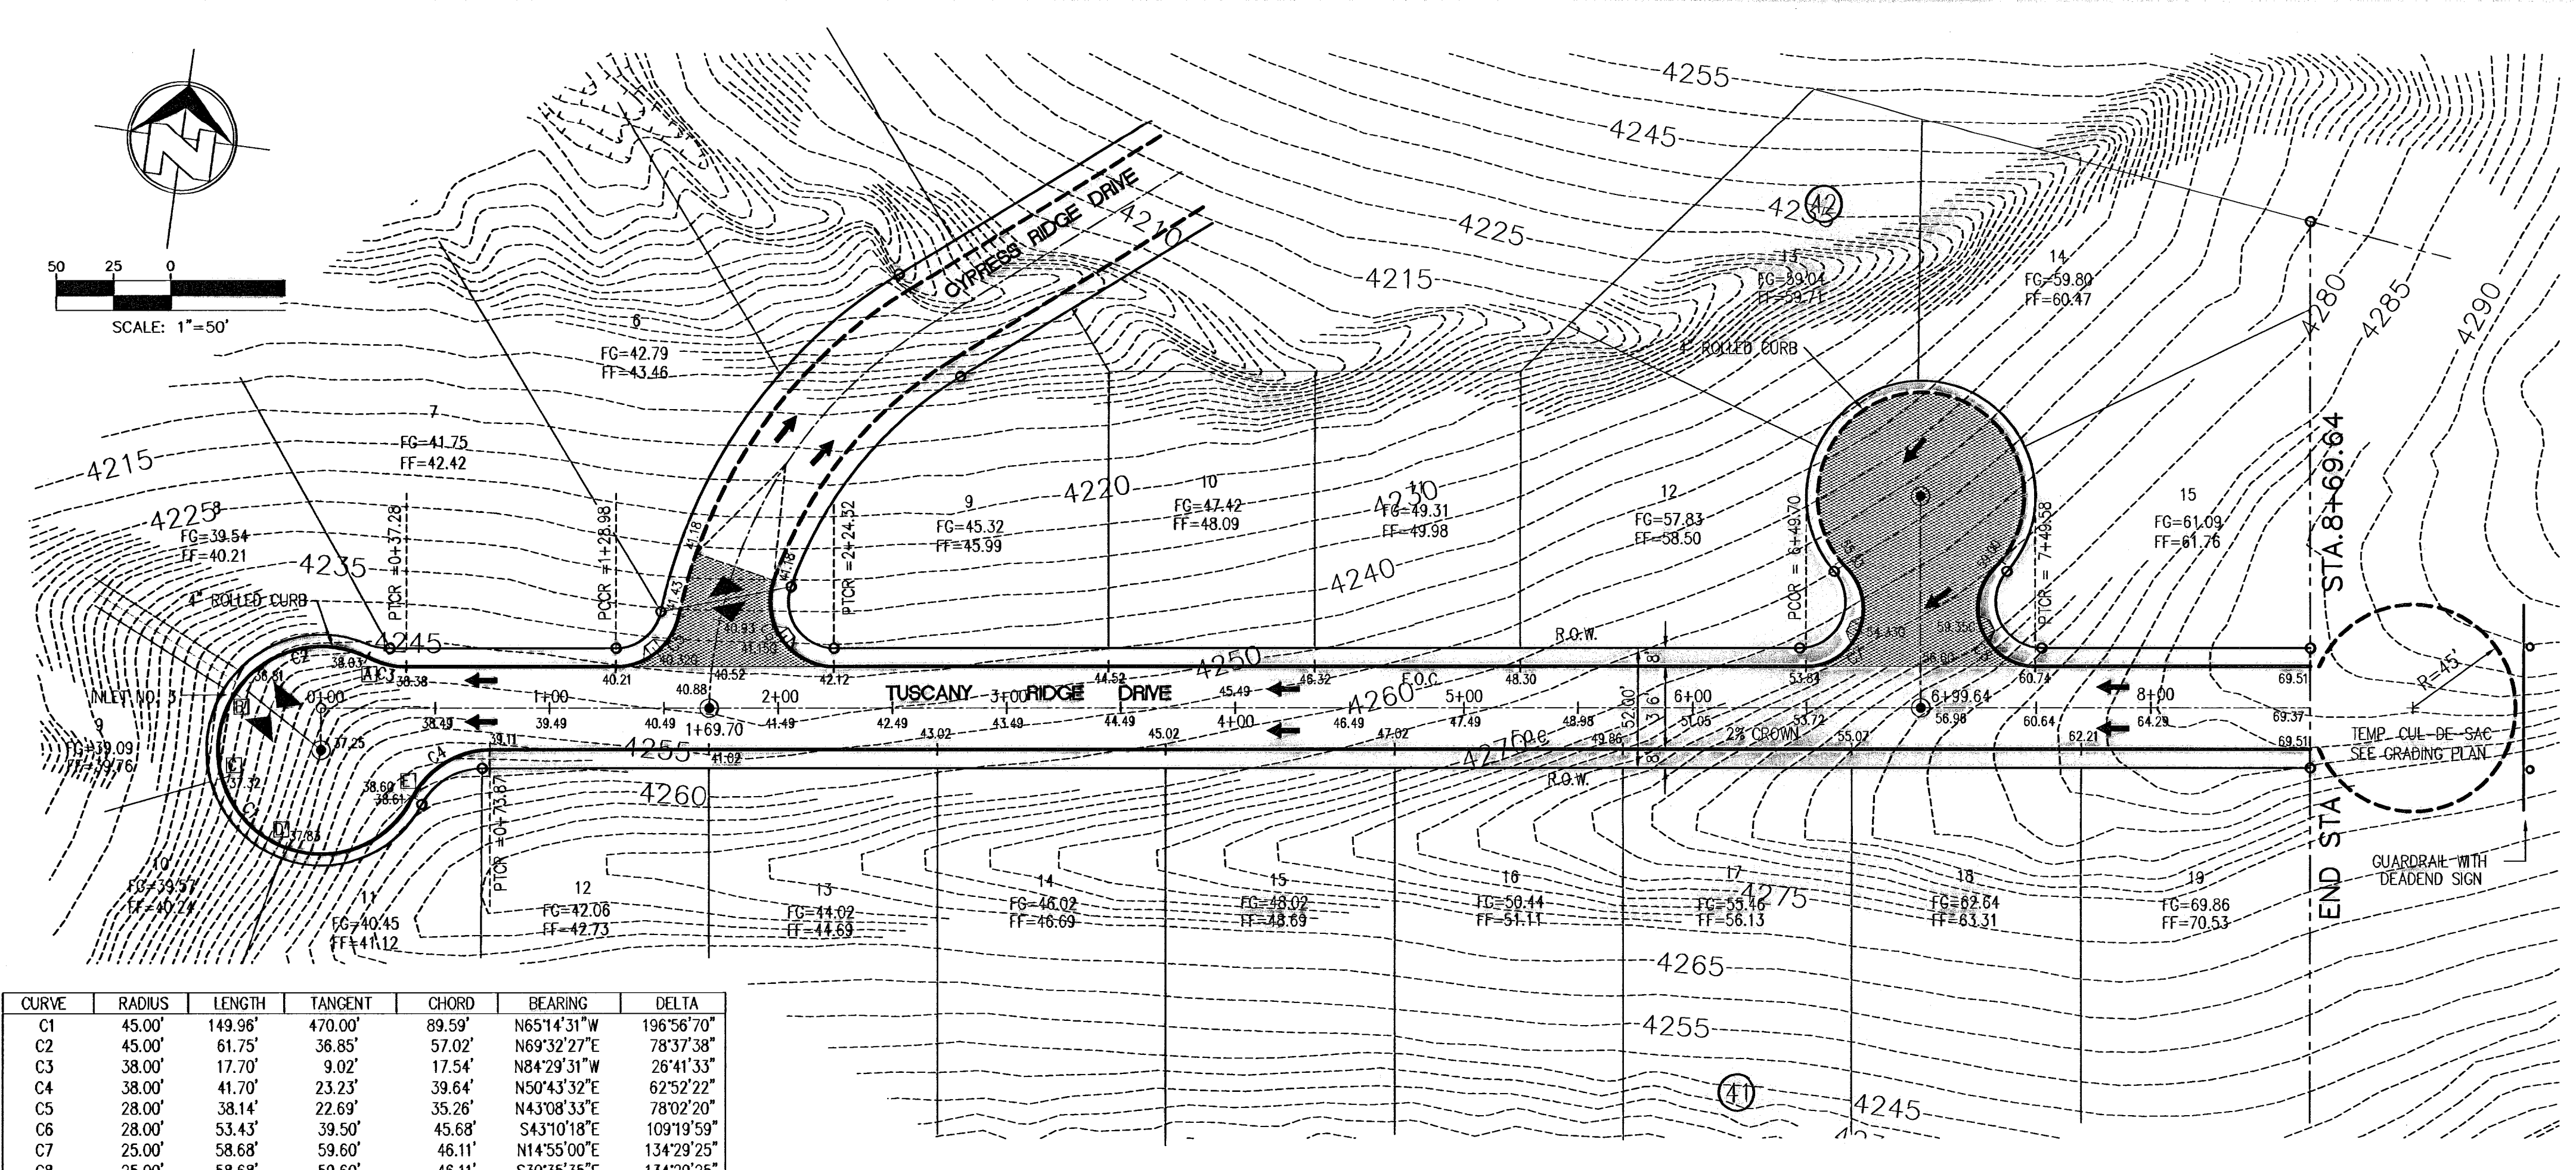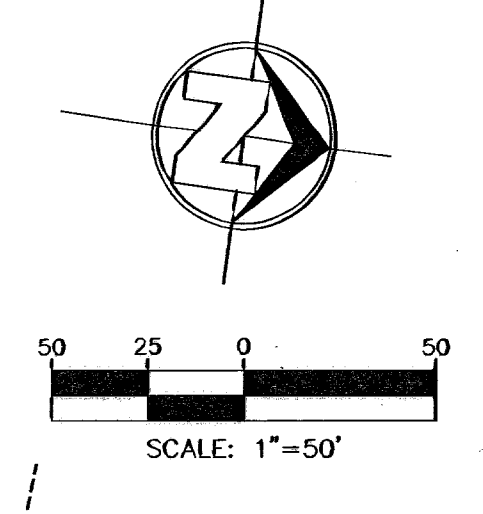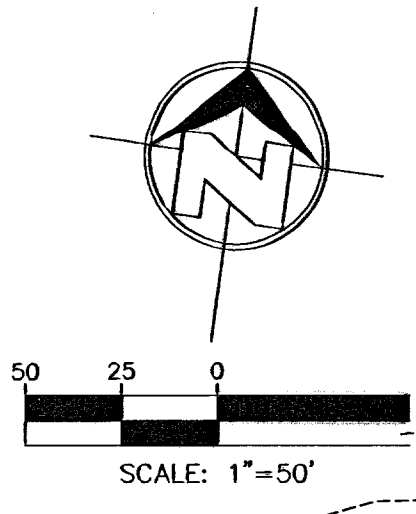

CURVE	RADIUS	LENGTH	TANGENT	CHORD	BEARING	DELTA
C1	45.00'	149.96'	470.00'	89.59'	N65°14'31"W	196°56'70"
C2	45.00'	61.75'	36.85'	57.02'	N69°32'27"E	78°37'38"
C3	38.00'	17.70'	9.02'	17.54'	N84°23'51"W	29°41'33"
C4	38.00'	41.70'	23.23'	39.64'	N50°43'32"E	62°52'22"
C5	28.00'	38.14'	22.69'	35.28'	N43°08'33"E	78°02'20"
C6	28.00'	53.43'	39.50'	45.68'	S43°10'18"E	109°19'59"
C7	25.00'	58.68'	59.60'	46.11'	N14°55'00"E	134°29'25"
C8	25.00'	58.68'	59.60'	46.11'	S30°35'35"E	134°29'25"

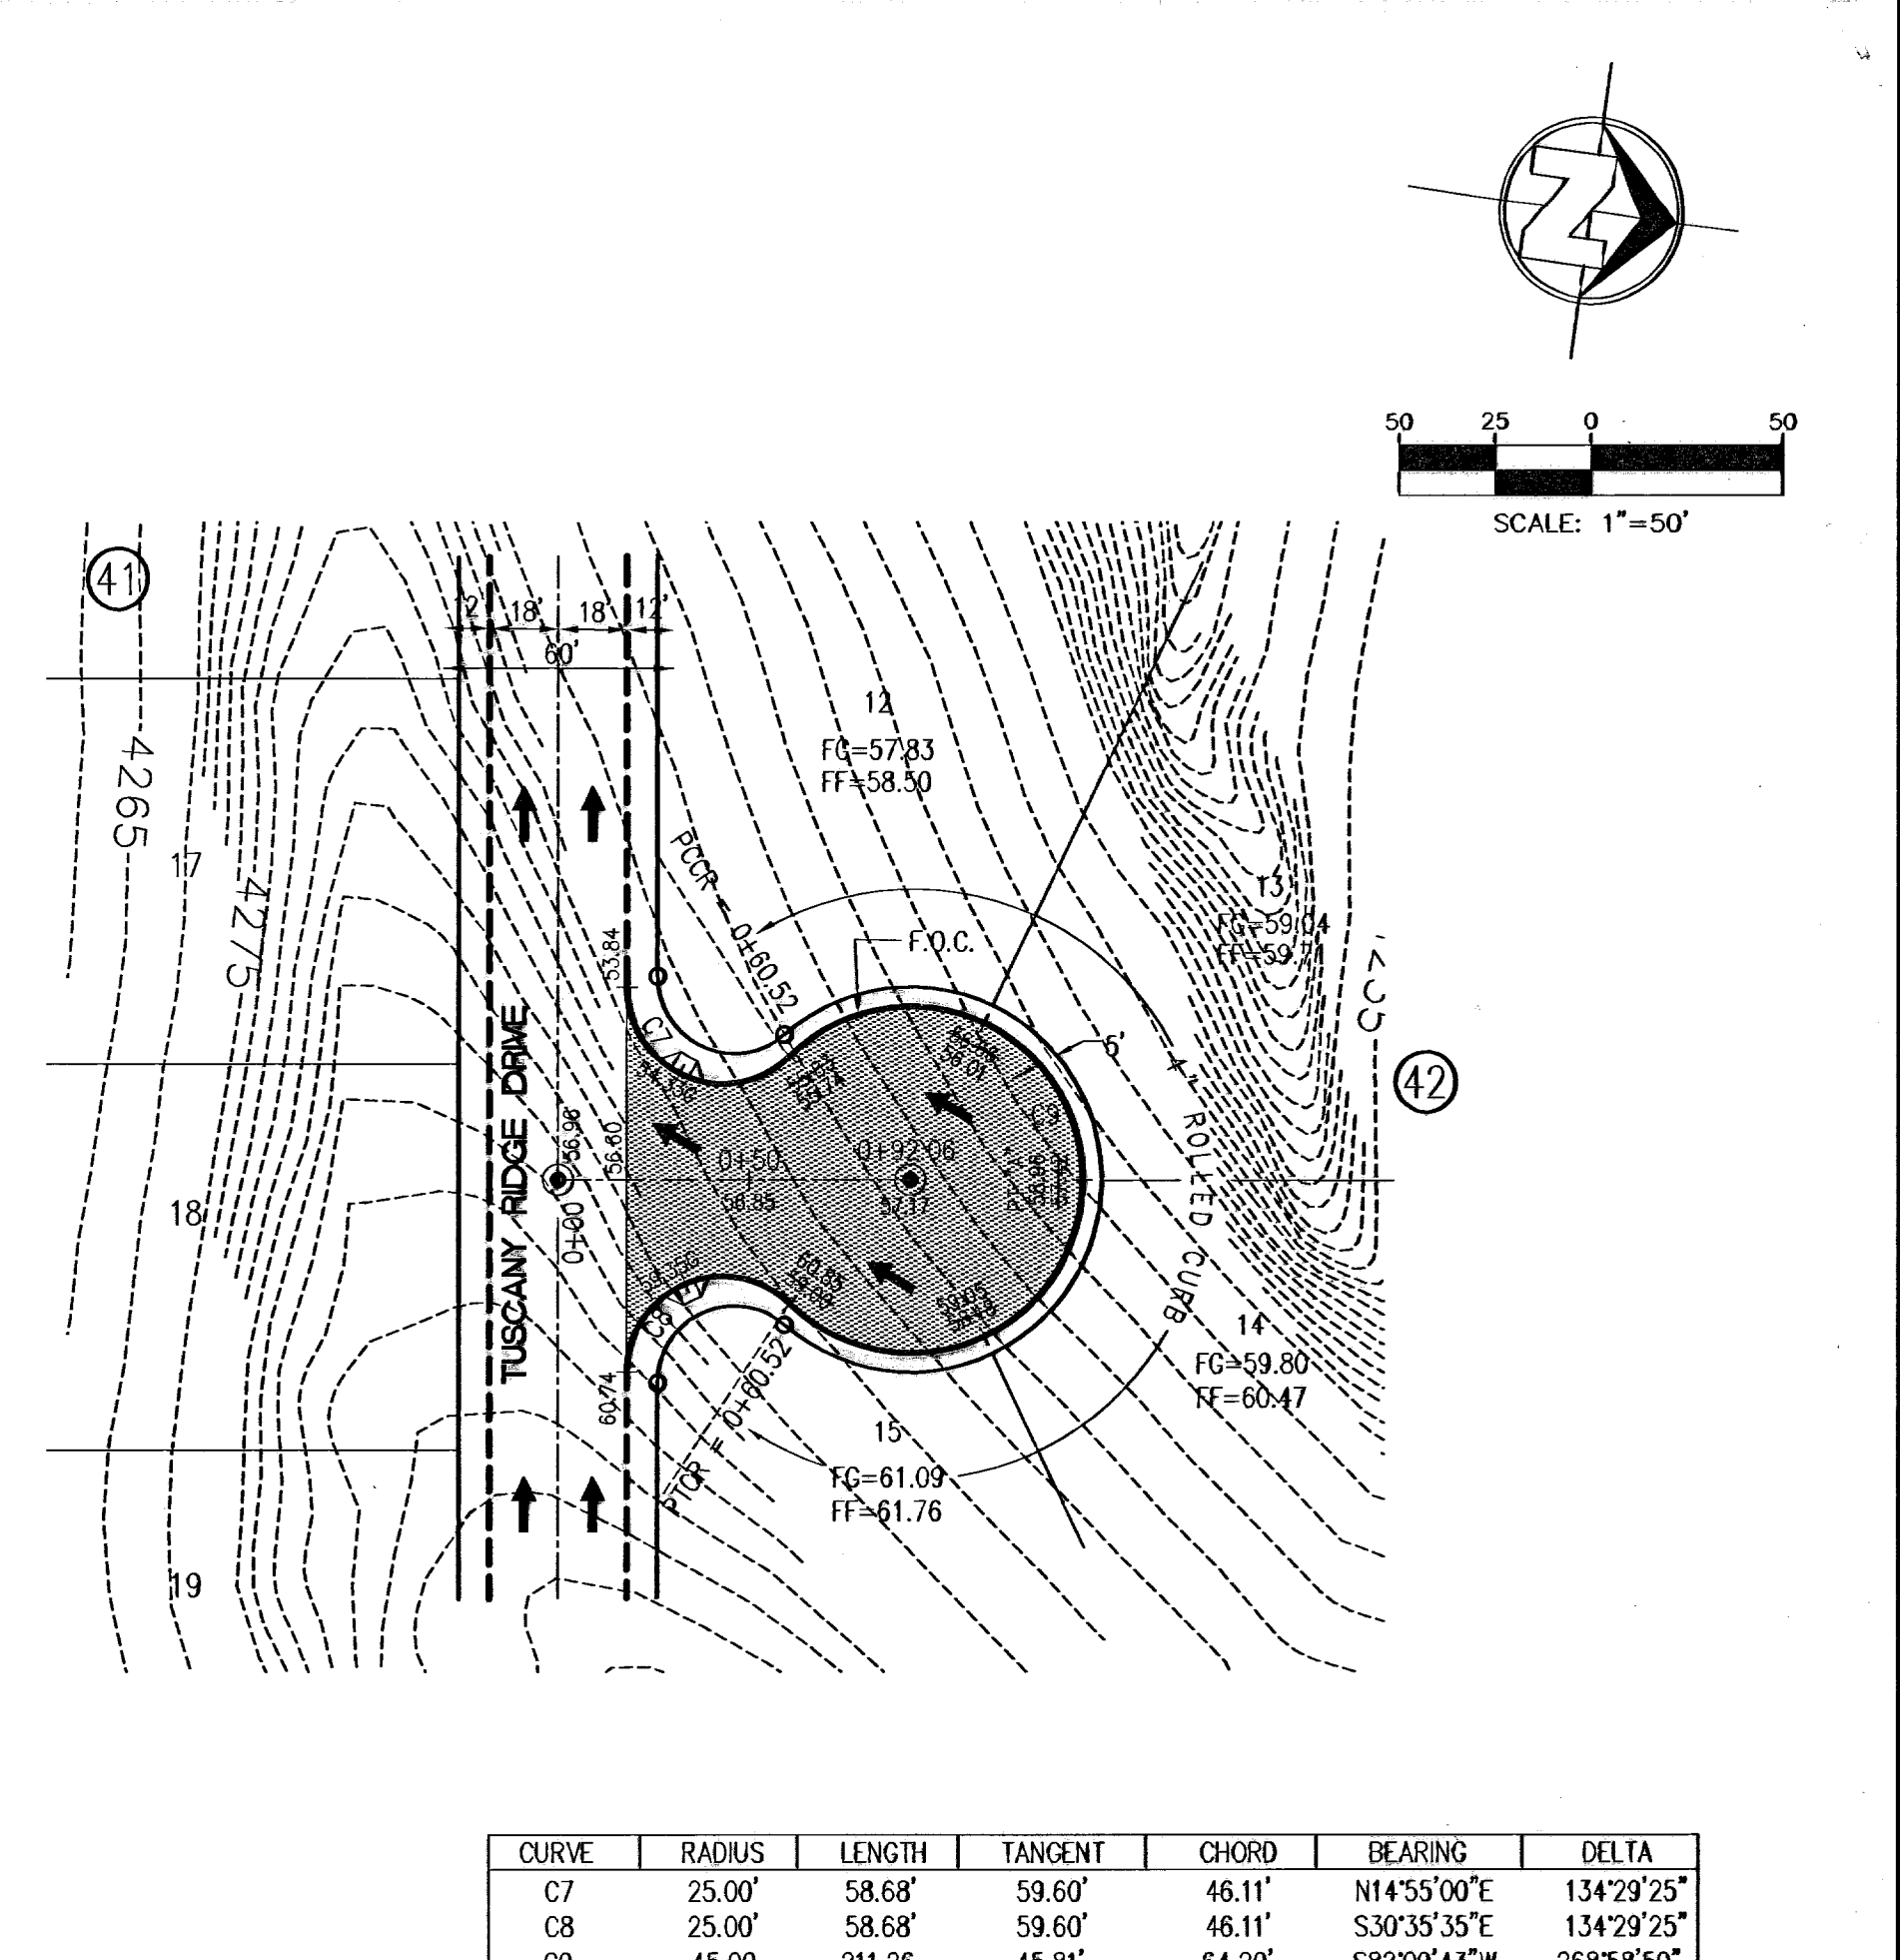

CURVE	RADIUS	LENGTH	TANGENT	CHORD	BEARING	DELTA
C7	25.00'	58.68'	59.60'	46.11'	N14°55'00"E	134°29'25"
C8	25.00'	58.68'	59.60'	46.11'	S30°35'35"E	134°29'25"
C9	45.00'	211.26'	45.81'	64.20'	S82°09'43"W	268°58'50"

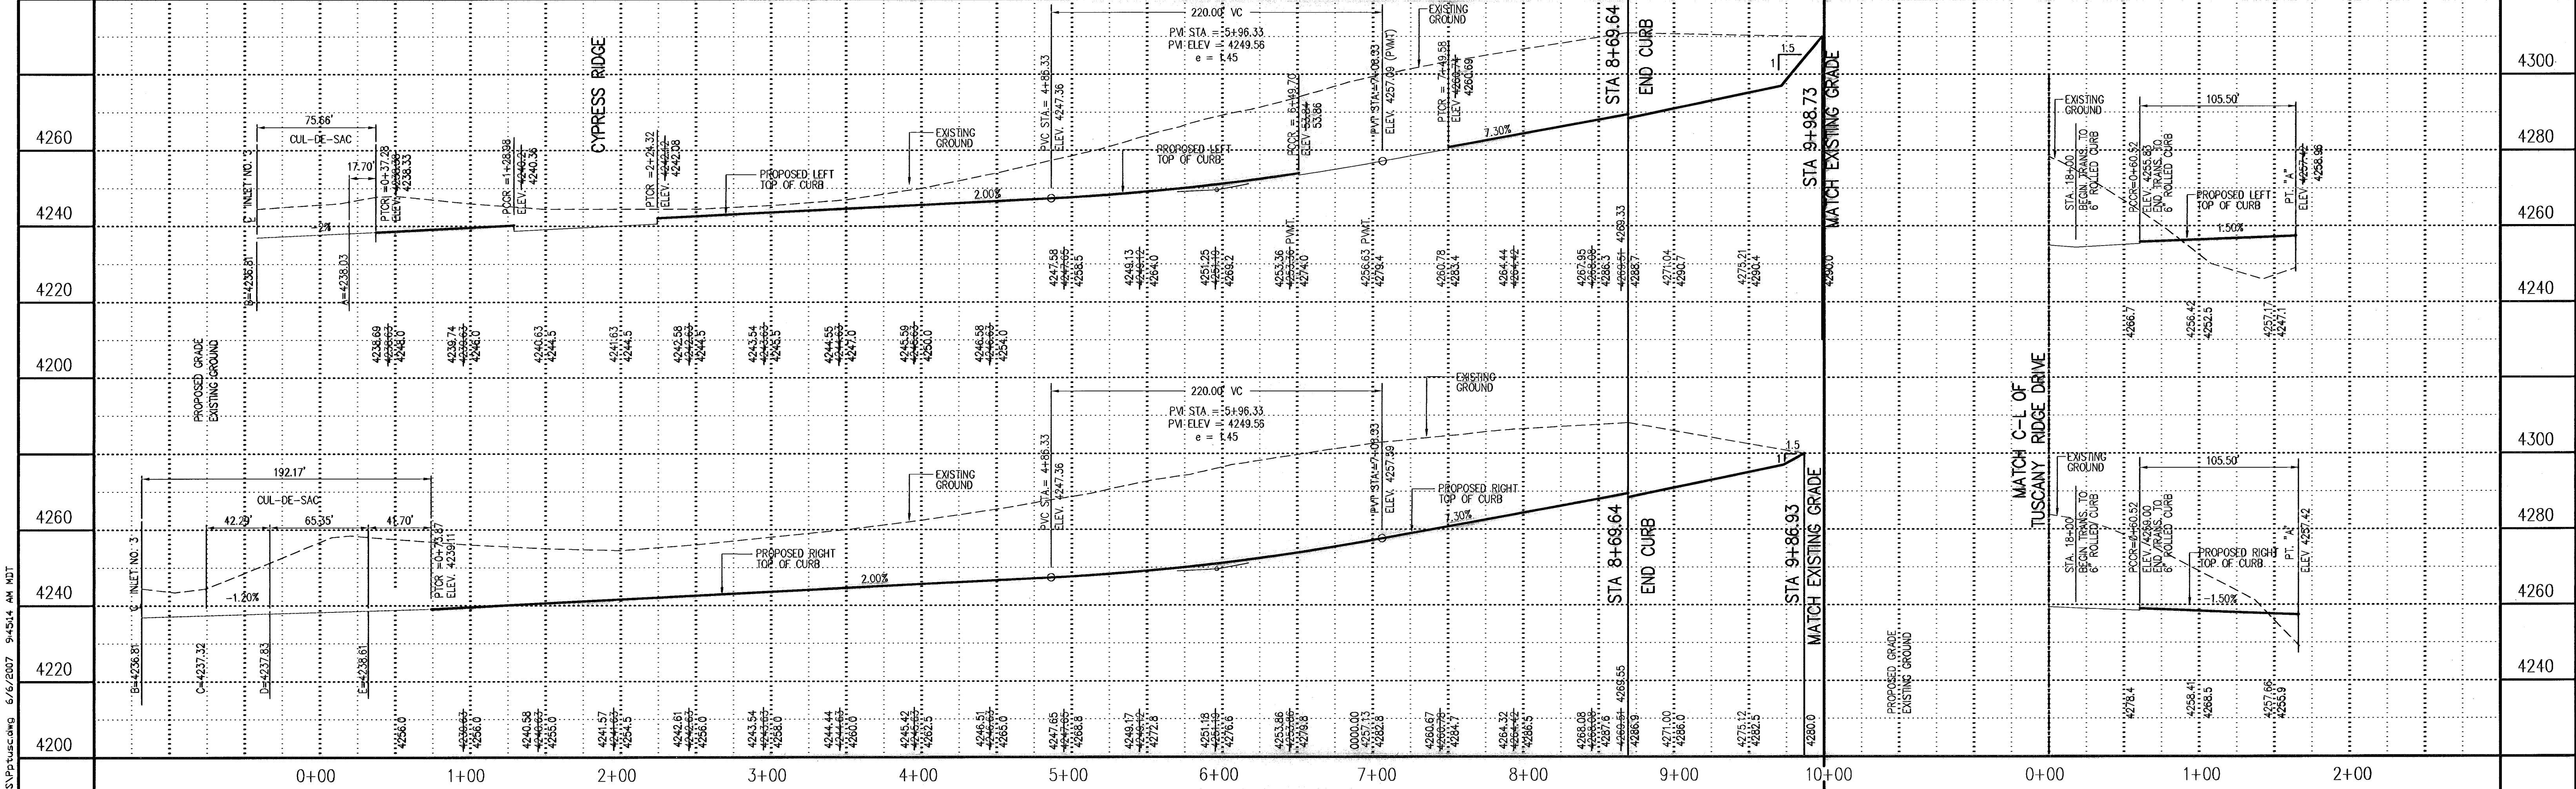


PLAN PROJECT SURVEY - HANS-BULL.DWG 6/6/2007 9:45:54 AM DWT

PLAN Pavement Transitions: [A] = Transition from Crown to Flat [B] = Transition from Crown to Invert Crown [C] = Transition from Flat to Crown [D] = Transition from Flat to Invert Crown [E] = Transition from Invert to Crown [F] = Transition from Invert to Flat	LEGEND R.O.W. = Right-of-Way [Symbol] = Proposed City Monument [Symbol] = Proposed Water Flow [Symbol] = Flat Area F.O.C. = Face of Curb [Symbol] = High Point on Street [Symbol] = Low Point on Street	PROFILE [Symbol] = Existing Ground Profile [Symbol] = Proposed Finished Grade Profile	NOTES 1. ALL STREET HAS A 2% CROWN SECTION UNLESS OTHERWISE INDICATED. 2. ALL CURB IS 6" STANDARD CURB AND GUTTER UNLESS OTHERWISE INDICATED. 3. REFER TO SHEET 3 OF 13 FOR TYPICAL STREET SECTIONS AND DETAILS.	BENCHMARK: EXISTING CITY MONUMENT AT CENTERLINE INTERSECTION OF MAJESTIC RIDGE DR. AND EAGLE RIDGE DR. ELEVATION = 4213.08 (QTY DATUM)	SCALE HOR. 1" = 50' VER. 1" = 20'	<table border="1" style="width: 100%; border-collapse: collapse;"> <thead> <tr> <th>DATE</th> <th>REVISION</th> <th>DESCRIPTION</th> <th>BY</th> </tr> </thead> <tbody> <tr> <td> </td> <td> </td> <td> </td> <td> </td> </tr> </tbody> </table>	DATE	REVISION	DESCRIPTION	BY					<table border="1" style="width: 100%; border-collapse: collapse;"> <tr> <td>SCALE:</td> <td>AS NOTED</td> </tr> <tr> <td>JOB NO.:</td> <td>09-04-2170</td> </tr> <tr> <td>FIELD BOOK:</td> <td> </td> </tr> <tr> <td>DESIGNED BY:</td> <td>ET</td> </tr> <tr> <td>COMP. BY:</td> <td>ET</td> </tr> <tr> <td>DRAWN BY:</td> <td>FC</td> </tr> <tr> <td>CHECKED BY:</td> <td>ET</td> </tr> <tr> <td>DATE:</td> <td>08/02/05</td> </tr> </table>	SCALE:	AS NOTED	JOB NO.:	09-04-2170	FIELD BOOK:		DESIGNED BY:	ET	COMP. BY:	ET	DRAWN BY:	FC	CHECKED BY:	ET	DATE:	08/02/05	TUSCANY AT RIDGEVIEW EL PASO, EL PASO COUNTY, TEXAS TUSCANY RIDGE DRIVE AS-BUILT SLI ENGINEERING, INC. CIVIL ENGINEERS * LAND SURVEYORS * LAND PLANNERS 6600 WESTWIND DR. - EL PASO, TEXAS - 79912 - (915) 584-4457	 5 of 13
DATE	REVISION	DESCRIPTION	BY																														
SCALE:	AS NOTED																																
JOB NO.:	09-04-2170																																
FIELD BOOK:																																	
DESIGNED BY:	ET																																
COMP. BY:	ET																																
DRAWN BY:	FC																																
CHECKED BY:	ET																																
DATE:	08/02/05																																

600830



TRACT 1A, S. J. LARKIN SURVEY No. 265
CITY OF EL PASO, EL PASO COUNTY
TEXAS

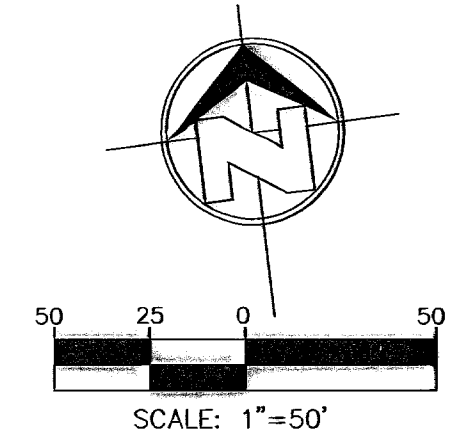


CURVE TABLE						
CURVE	LENGTH	RADIUS	TANGENT	CHORD	BEARING	DELTA
C1	68.91	818.00	34.48	68.89	N87°34'39"W	4°49'56"
C2	266.01	782.00	134.30	264.73	N80°14'45"W	19°29'25"
C3	42.46	28.00	26.52	38.51	N51°23'40"E	86°52'59"
C4	42.46	28.00	26.52	38.51	S35°29'20"E	86°52'59"
C5	110.91	800.00	55.55	110.83	N86°01'08"W	7°56'37"
C6	188.62	800.00	94.75	188.18	N75°17'34"W	13°30'31"
C7	132.80	818.00	66.55	132.66	N74°16'46"W	9°18'07"
C8	21.84	100.00	10.96	21.80	S75°53'08"E	12°30'51"
C9	25.03	100.00	12.58	24.96	N63°19'50"W	14°20'25"
C10	20.43	93.00	10.25	20.39	N75°51'01"W	12°35'04"
C11	21.26	93.00	10.68	21.22	S62°42'38"E	13°06'02"
C12	62.83	1477.00	31.42	62.83	S70°46'37"E	2°26'15"
C13	60.40	1523.00	30.21	60.40	S70°23'49"E	2°16'21"
C14	43.15	28.00	27.18	39.01	N27°22'59"W	88°18'02"
C15	43.15	28.00	27.18	39.00	S60°54'53"W	88°17'42"
C16	20.47	293.00	10.24	20.46	N69°59'40"W	4°00'08"
C17	37.69	300.00	18.87	37.67	S71°35'35"E	7°11'54"
C18	205.97	1482.00	103.15	205.81	S79°10'24"E	7°57'47"
C19	217.71	1518.00	109.04	217.52	S79°02'47"E	8°13'02"
C20	132.54	1500.00	66.31	132.50	S71°04'12"E	5°03'46"
C21	250.11	1500.00	125.35	249.82	S78°22'41"E	9°35'13"

LINE TABLE		
LINE	LENGTH	BEARING
T1	24.57'	S67°59'36"E










STAMPED CONCRETE NOTE:
8" THICK CONCRETE WITH #5 BARS AT 12 IN. E.W.
CONCRETE PATTERN AND COLOR TO BE DETERMINED BY DEVELOPER.

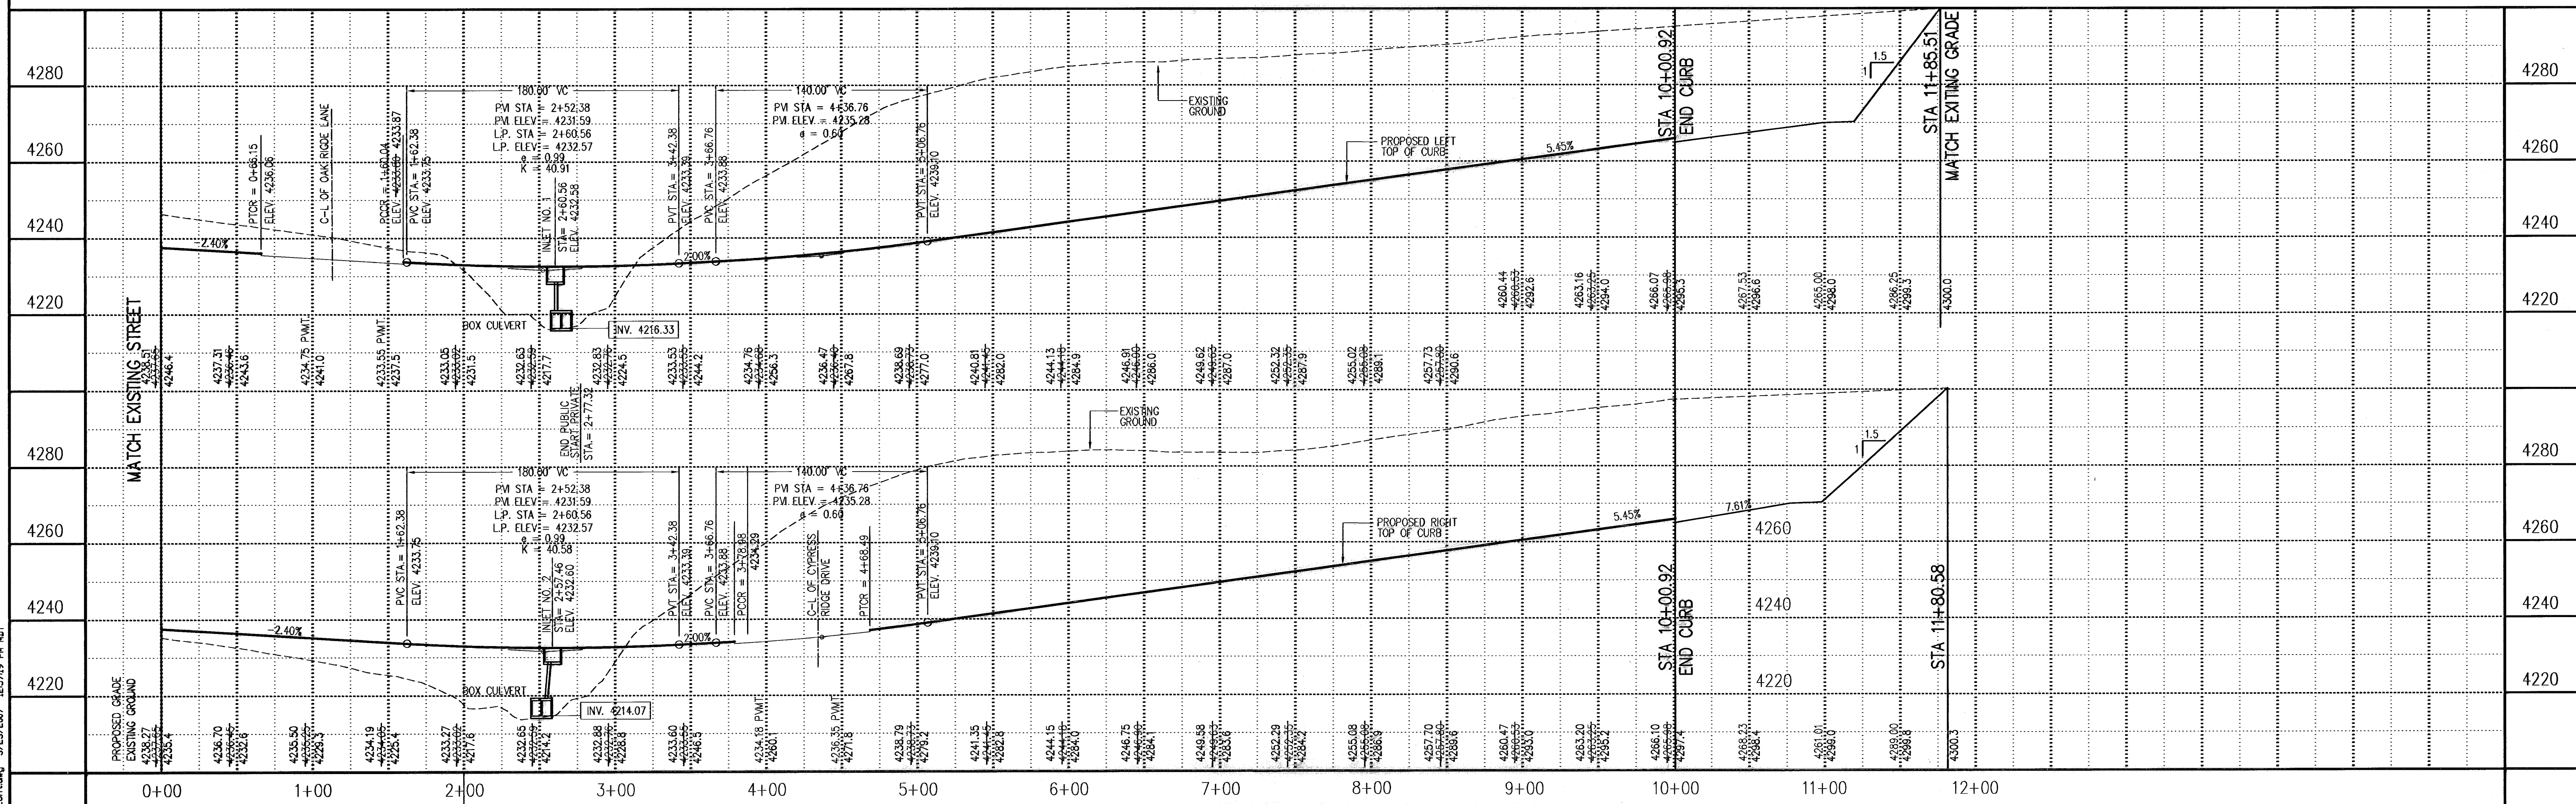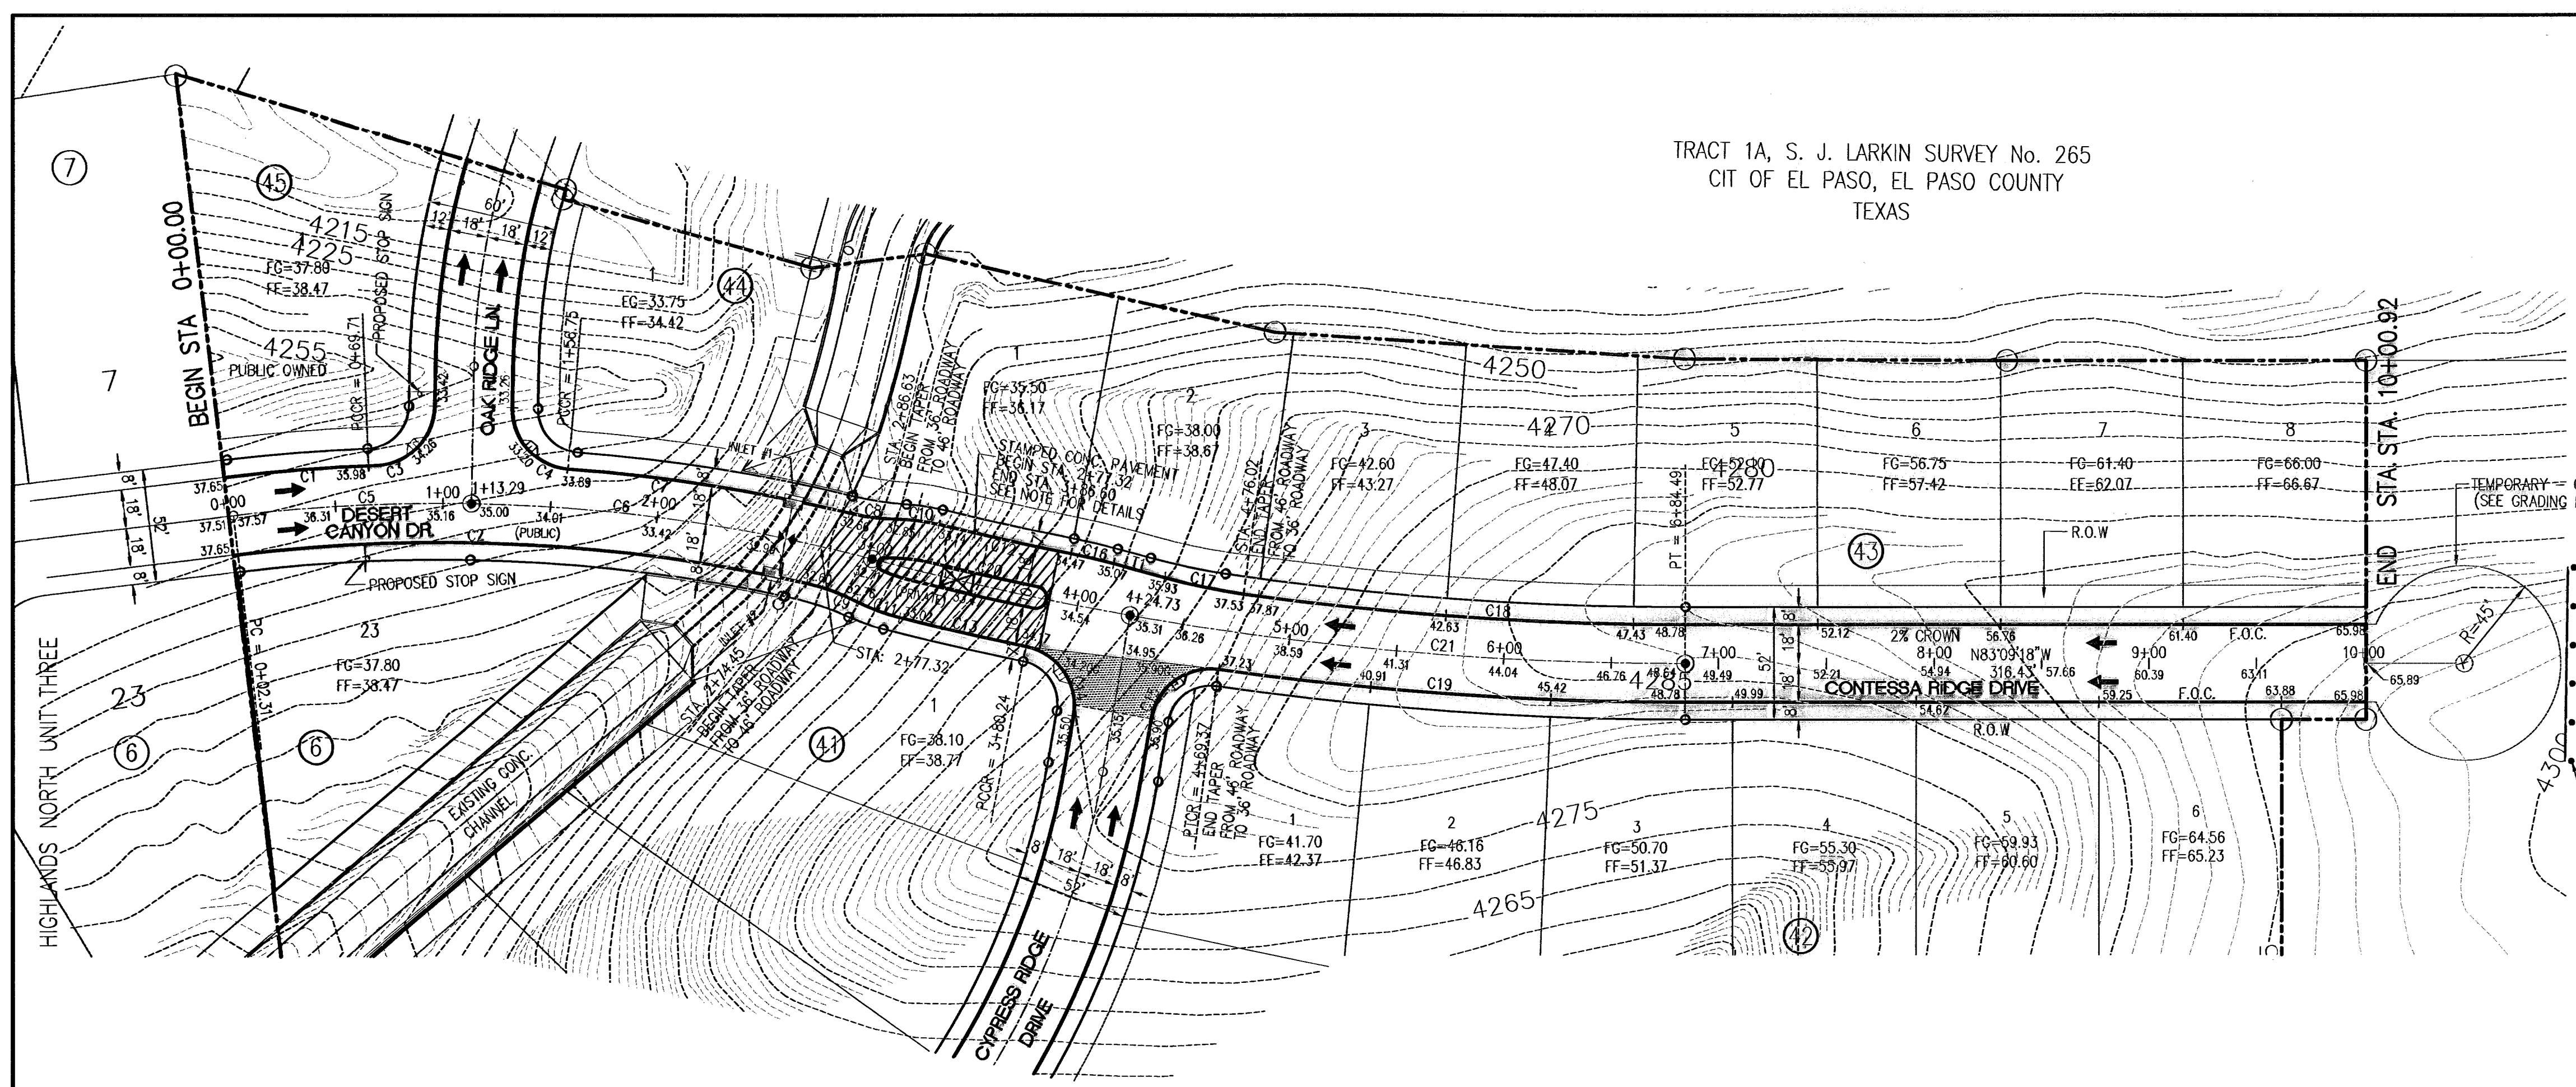

<p>PLAN</p> <p>PAVEMENT TRANSITIONS</p> <ul style="list-style-type: none"> [A] = TRANSITION FROM CROWN TO FLAT [B] = TRANSITION FROM CROWN TO INVERT CROWN [C] = TRANSITION FROM FLAT TO CROWN [D] = TRANSITION FROM FLAT TO INVERT CROWN [E] = TRANSITION FROM INVERT TO CROWN [F] = TRANSITION FROM INVERT TO FLAT 	<p>LEGEND</p> <ul style="list-style-type: none"> R.O.W. = RIGHT-OF-WAY [Symbol] = PROPOSED CITY MONUMENT [Symbol] = PROPOSED WATER FLOW [Symbol] = FLAT AREA F.O.C. = FACE OF CURB [Symbol] = HIGH POINT ON STREET [Symbol] = LOW POINT ON STREET 	<p>PROFILE</p> <ul style="list-style-type: none"> [Symbol] = EXISTING GROUND PROFILE [Symbol] = PROPOSED FINISHED GRADE PROFILE 	<p>NOTES</p> <ol style="list-style-type: none"> ALL STREET HAS A 2% CROWN SECTION UNLESS OTHERWISE INDICATED. ALL CURB IS 8" STANDARD CURB AND GUTTER UNLESS OTHERWISE INDICATED. REFER TO SHEET 3 OF 13 FOR TYPICAL STREET SECTIONS AND DETAILS. 	<p>BENCHMARK</p> <p>EXISTING CITY MONUMENT AT CENTERLINE INTERSECTION OF MAJESTIC RIDGE DR. AND EAGLE RIDGE DR. ELEVATION = 4213.08 (CITY DATUM)</p>	<p>SCALE</p> <p>HOR. 1" = 50'</p> <p>VER. 1" = 20'</p>	<p>DATE</p> <p>REVISION DESCRIPTION</p> <p>BY</p>	<p>SCALE: AS NOTED</p> <p>JOB NO. 09-04-2170</p> <p>FIELD BOOK</p> <p>DESIGNED BY: ET</p> <p>COMP. BY: FC</p> <p>DRAWN BY: ET</p> <p>CHECKED BY: ET</p> <p>DATE: 08/17/05</p>	<p>TUSCANY AT RIDGE VIEW</p> <p>EL PASO, EL PASO COUNTY, TEXAS</p> <p>CONTESSA RIDGE DRIVE</p> <p>AS-BUILT</p> <p>SLI ENGINEERING, INC.</p> <p>CIVIL ENGINEERS * LAND SURVEYORS * LAND PLANNERS</p> <p>6600 WESTWIND DR. - EL PASO, TEXAS - 79912 - (915) 884-4457</p>	
---	---	--	---	---	---	--	---	--	--

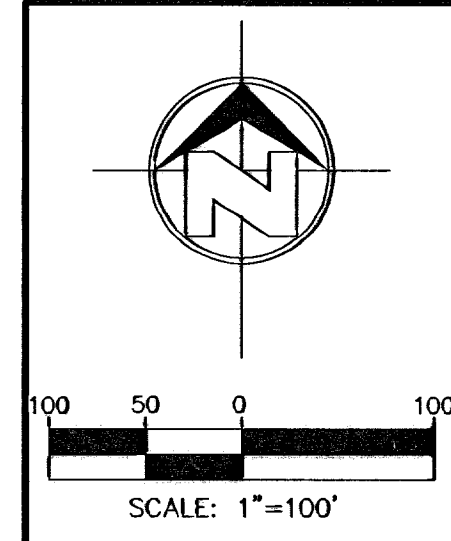


CURVE TABLE						
CURVE	LENGTH	RADIUS	TANGENT	CHORD	BEARING	DELTA
C1	35.63'	345.00'	17.83'	35.61'	S26°04'41"W	05°55'00"

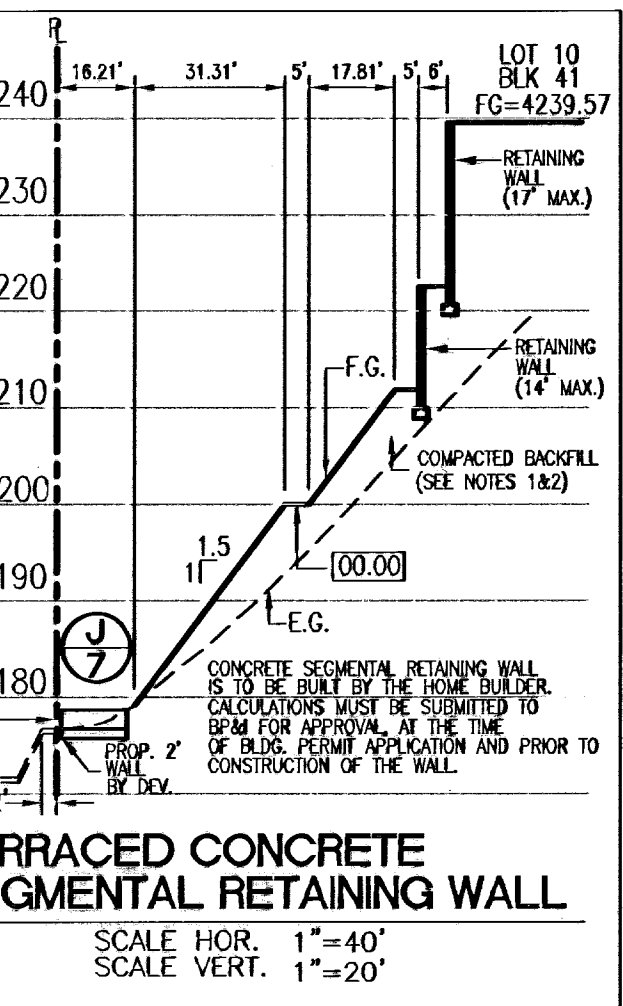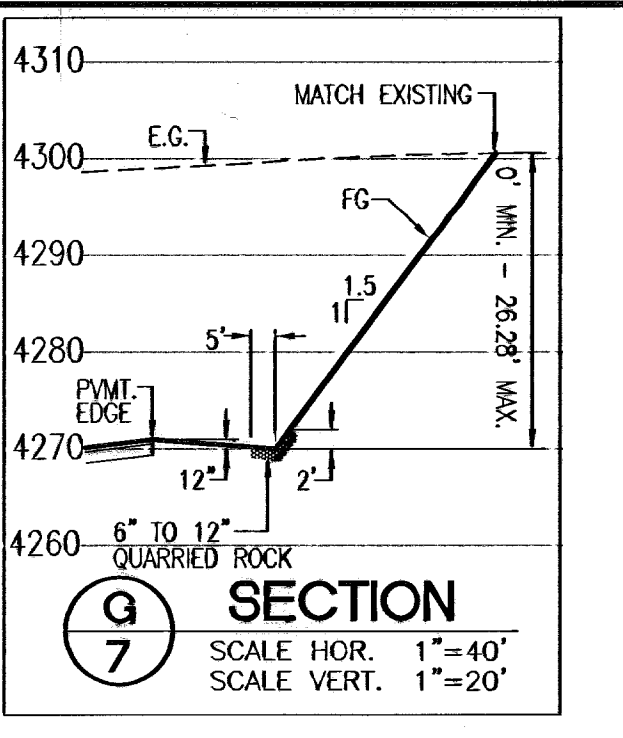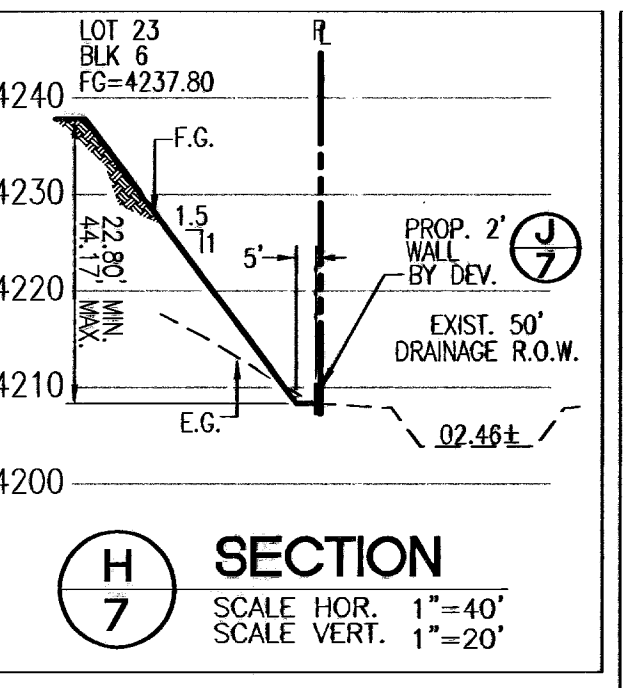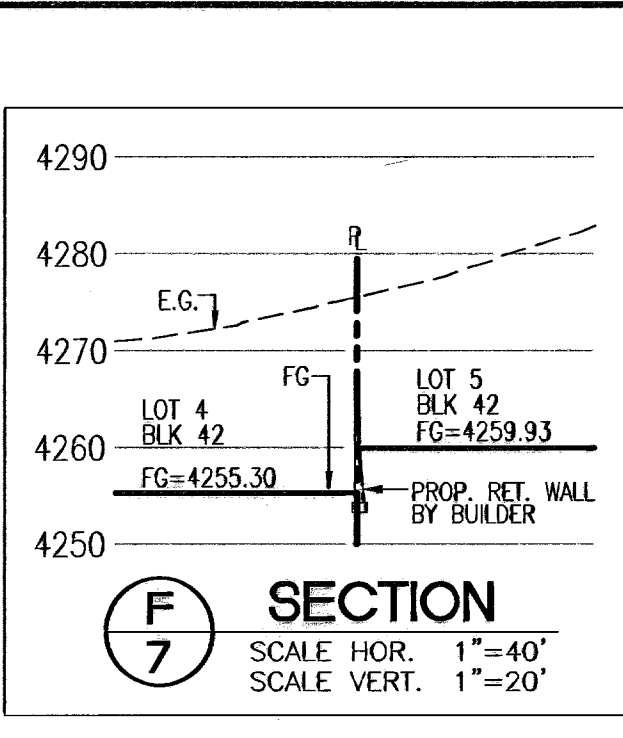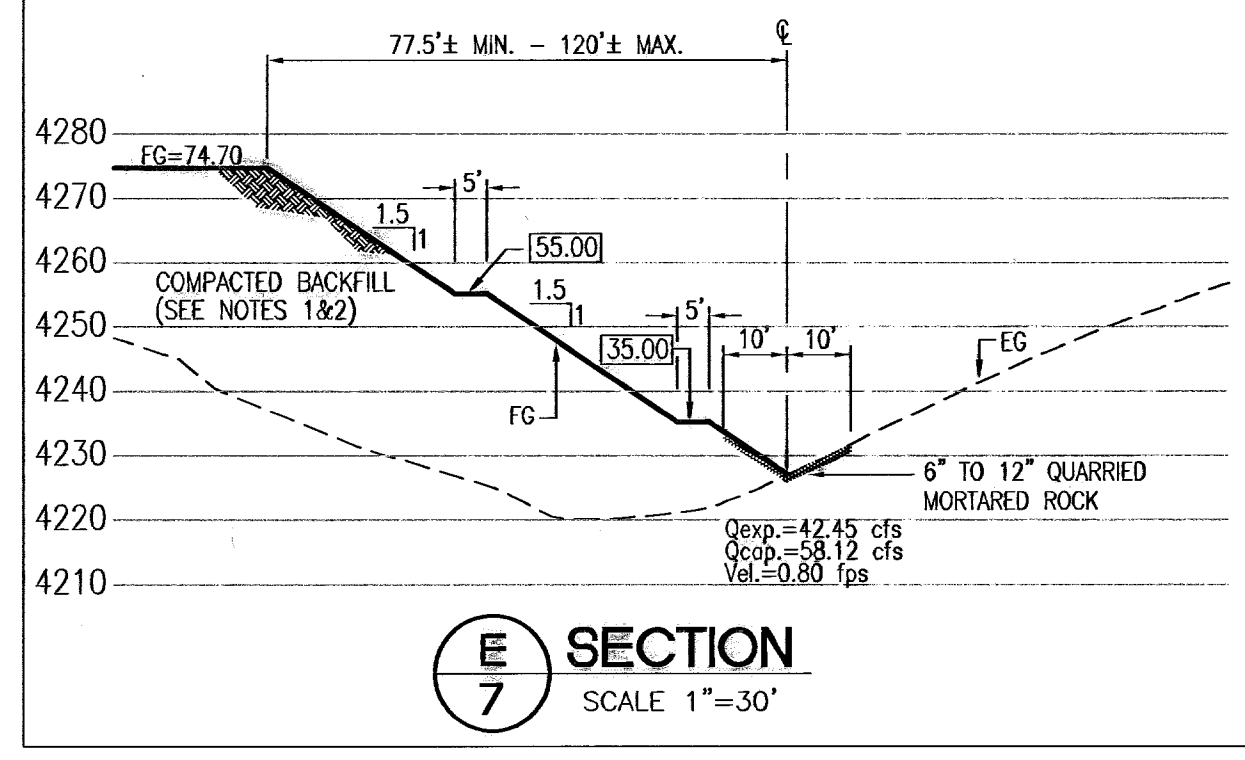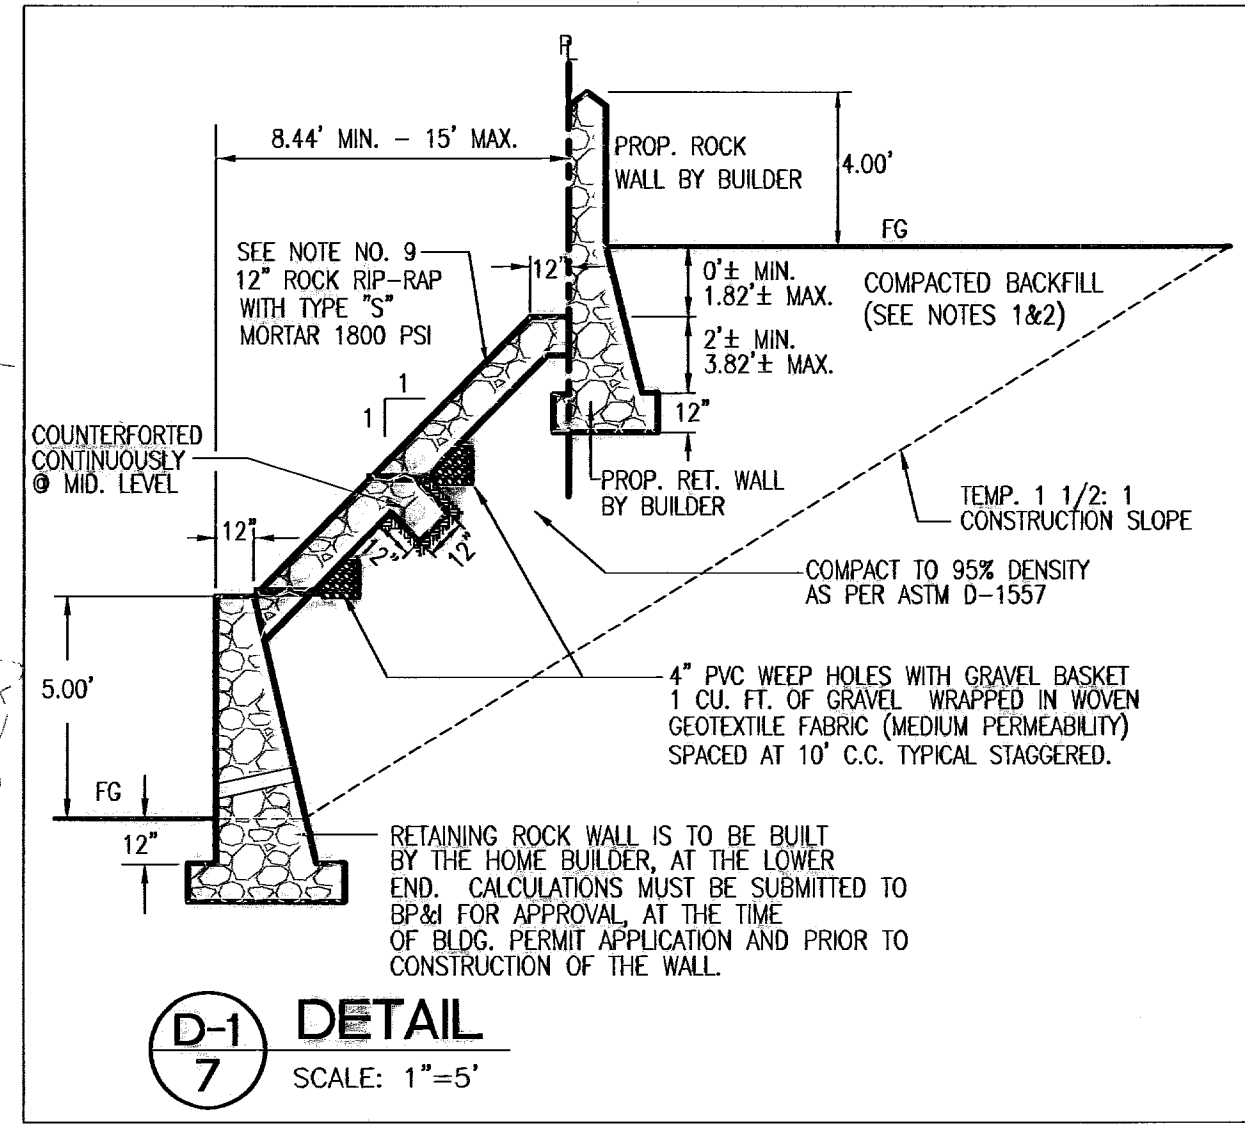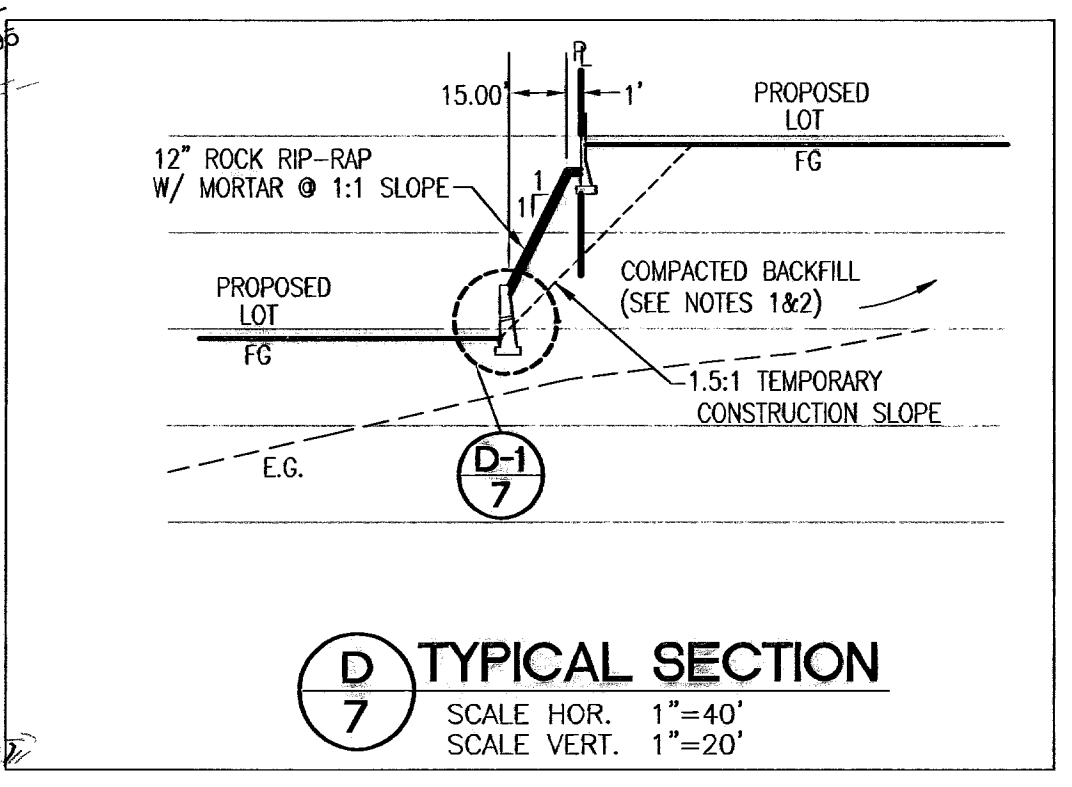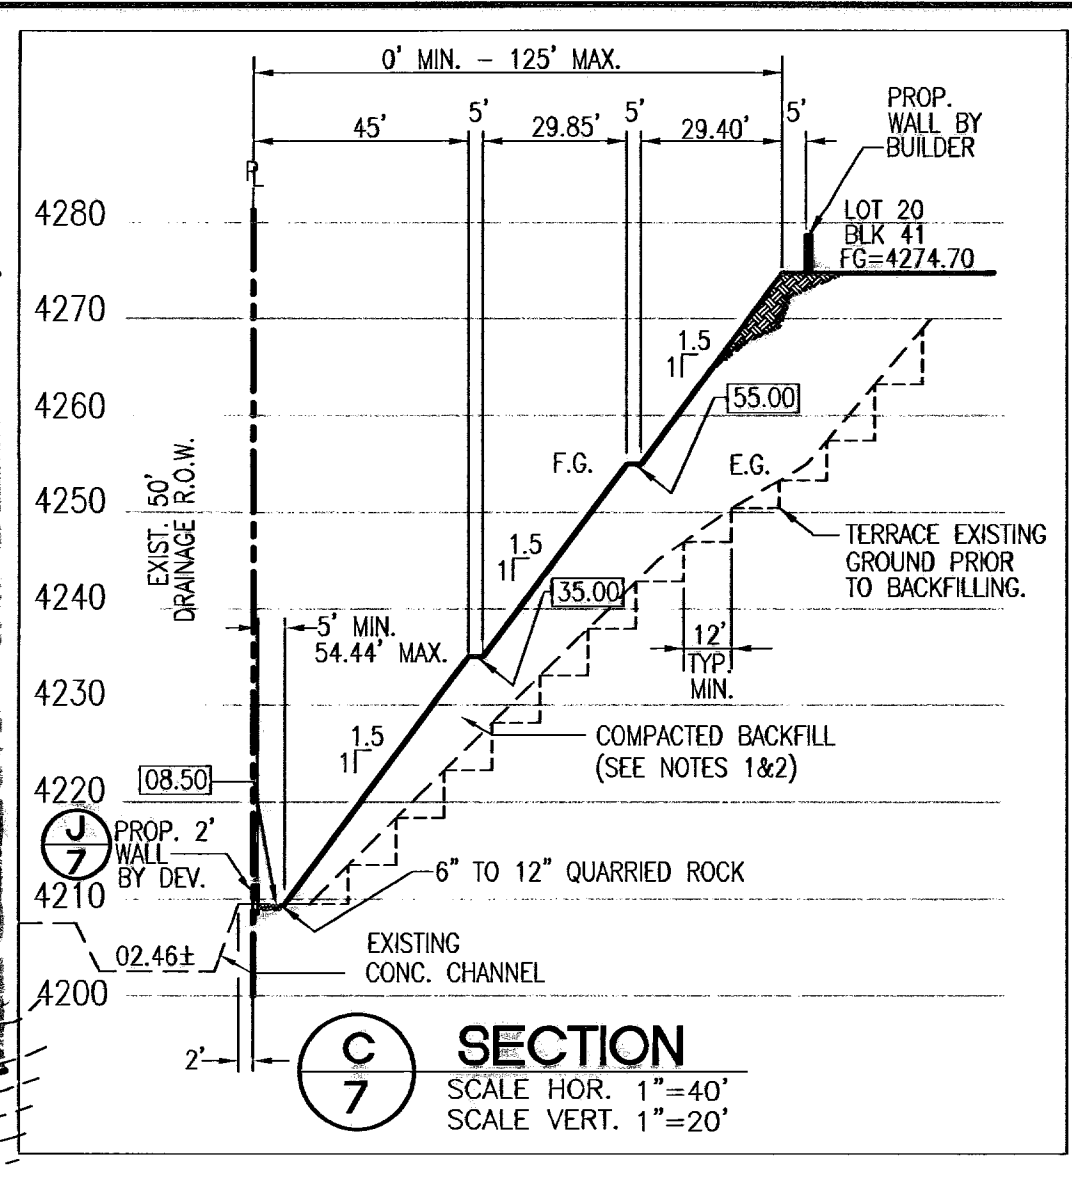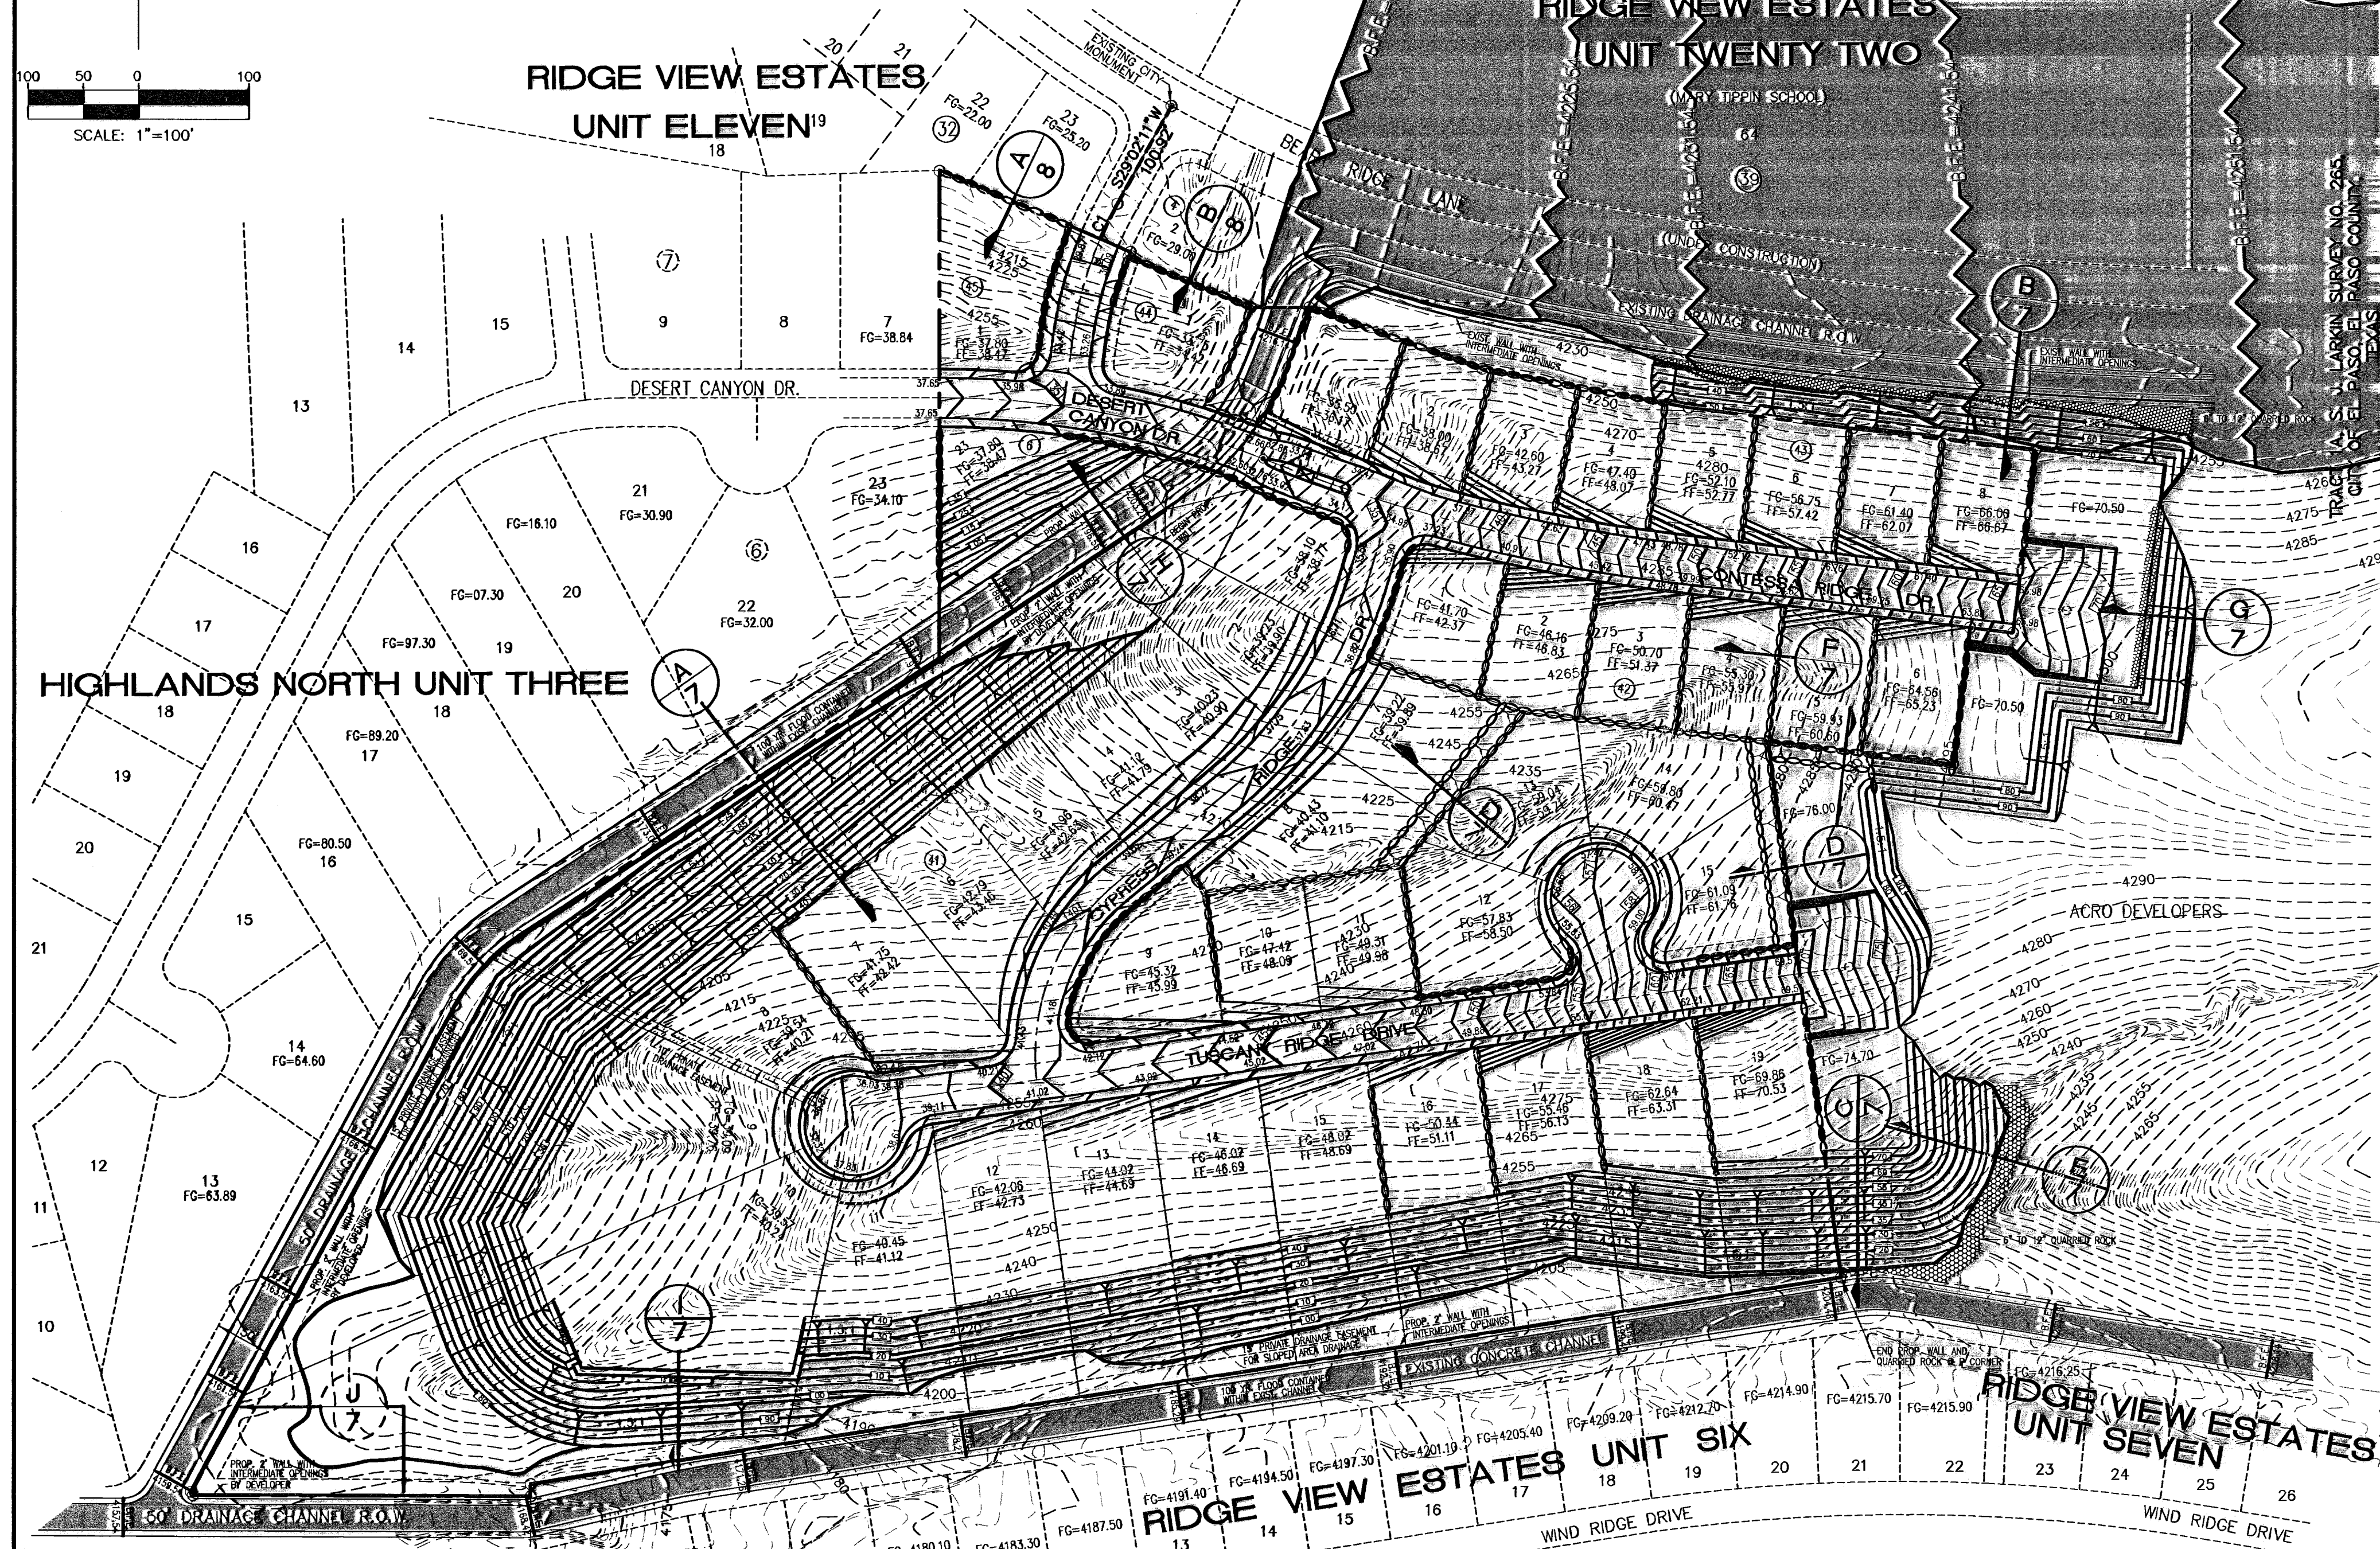

NOTE: EXTEND ROCKWALL & LOT LINES TO MEET SLOPED AREAS

ROCKWALL NOTES:
STONE FOR ROCK WALLS SHALL BE AS NEARLY UNIFORM IN SECTION AS IS PRACTICABLE. THE STONE SHALL BE DENSE AND RESISTANT TO THE ACTION OF AIR AND WATER. STONE SHALL BE THOROUGHLY SOAKED BEFORE BEING PLACED. (NO RIVER ROCK IS ALLOWED FOR ROCK WALLS.)
MORTAR FOR ROCK WALL SHALL BE A.S.T.M. TYPE "S": USE ONE PART PORTLAND CEMENT, 1/4 TO 1/2 PARTS HYDRATED LIME AND 3 PARTS SAND (2 1/4 TO 3 TIMES THE SUM OF THE VOLUMES OF CEMENT AND LIME COMBINED) SEE CITY BUILDING CODE, PP. 14-3 AND 14-4.
FILL ALL VOIDS WITH SMALLER STONE OR MORTAR. JOINTS IN WALL SHALL NOT EXCEED 1"
THE BACKFILL SHALL BE SIMILAR TO THE EXISTING SOIL AND SHALL BE WELL COMPACTED AND FREE DRAINING (COARSE GRILL TYPE)

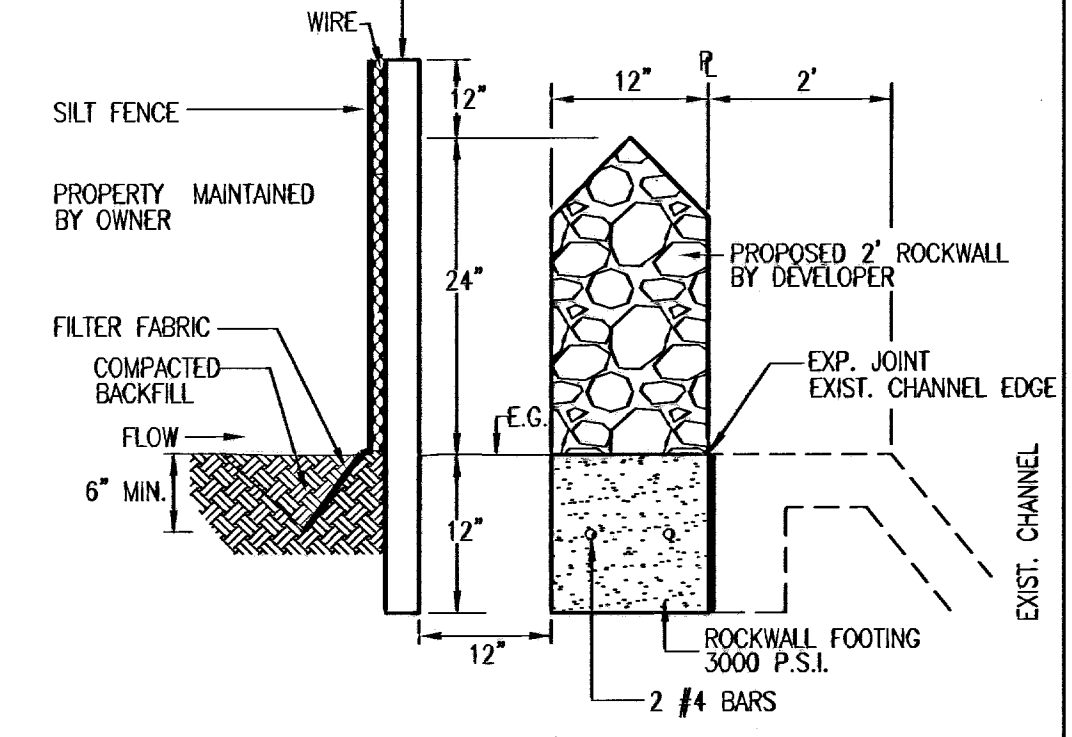



THE HIGHLANDS UNIT SEVEN

GENERAL NOTES:

- ALL CONSTRUCTION SHALL BE DONE IN ACCORDANCE WITH THE "1993 STANDARD SPECIFICATIONS FOR CONSTRUCTION OF HIGHWAYS, STREETS AND BRIDGES." (APPLICABLE ITEMS ONLY) AND WITH THE LATEST EDITION OF THE CITY OF EL PASO "GRADING ORDINANCE".
- ALL FILL AREAS SHALL BE COMPACTED TO 95% DENSITY PER ASTM D-1557.
- REFER TO THE CITY OF EL PASO GRADING ORDINANCE CHAPTER 18.44 FOR SITE GRADING SPECIFICATIONS. APPROVED GRADING PERMIT MUST BE AVAILABLE AT THE JOB SITE UPON COMMENCEMENT OF WORK.
- POSITIVE DRAINAGE SHALL BE PROVIDED BY THE CONTRACTOR DURING ALL PHASES OF GRADING AND CONSTRUCTION.
- CONTRACTOR IS RESPONSIBLE FOR THE PROTECTION OF EXISTING UTILITY LINES (SHOWN OR NOT SHOWN) WITHIN THE SCOPE OF CONSTRUCTION. THE CONTRACTOR MUST NOTIFY THE RESPECTIVE AGENCIES PRIOR TO MOVING ON SITE, SO THAT THE EXISTING UTILITY LINES CAN BE FIELD VERIFIED. IF ANY LINES ARE DAMAGED DURING CONSTRUCTION, THE CONTRACTOR SHALL REPLACE THEM AT HIS OWN EXPENSE.
- THE CONTRACTOR IS RESPONSIBLE FOR VERIFYING ALL DIMENSIONS ON SITE AND SHALL CONTACT THE DESIGN ENGINEER AND REPORT ANY DISCREPANCIES, OMISSIONS AND ERRORS ON PLANS PRIOR TO COMMENCING OR CONTINUING WORK.
- 4" GARDEN WALL SHOWN SHALL BE BUILT BY THE HOME BUILDER ON THE UPPER LOT, OR OTHERWISE SHOWN.
- 4" REAR RETAINING ROCKWALL WITH 4" WEEP HOLES SPACED AT 10' O.C. AND 12" ABOVE F.G. SHALL BE CONSTRUCTED BY THE HOME BUILDER. THE DESIGN AND CALCULATIONS FOR THIS WALL SHALL BE SUBMITTED TO CITY ENGINEERING, FOR APPROVAL, AT THE TIME OF BUILDING PERMIT APPLICATION AND PRIOR TO CONSTRUCTION OF WALL.
- 12" ROCK RIP RAP WITH MORTAR SLOPED AT 1:1 SHALL BE CONSTRUCTED BY HOME BUILDER AT THE UPPER END. THE RET. ROCK WALL SHALL BE BUILT BY THE HOME BUILDER AT THE LOWER END. (SEE SECTION D-1). THE CALCULATIONS FOR THIS WALL SHALL BE SUBMITTED TO BPEM, FOR APPROVAL, AT THE TIME OF THE BUILDING PERMIT APPLICATION AND PRIOR TO CONSTRUCTING THE WALL.


NOTES:
SLOPED AREAS SHALL BE MAINTAINED BY LOT OWNER
RETAINING WALL SHALL BE CONSTRUCTED FOR VERTICAL GRADES GREATER THAN 2'.
SLOPED AND SWALE AREAS SHALL BE MAINTAINED BY THE PROPERTY OWNER.
EACH INDIVIDUAL LOT OWNER IS RESPONSIBLE FOR THE DRAINAGE OF ALL STORM WATER RUNOFF FROM THE BACK OF THE LOT TO THE FRONT OF THE LOT. THIS INCLUDES ALL RUNOFF FROM CONTRIBUTING SLOPES ONTO THE LOT. SEE LOT DRAINAGE DETAIL ON SHEET B.
OFF SITE SLOPES, SWALES AND DESILTING BASINS SHALL BE MAINTAINED BY THE DEVELOPER.
FOR SLOPES HIGHER THAN 30', A BENCH TERRACE AT MID-HIGHT SHALL BE REQUIRED.

BENCHMARK
CITY MONUMENT AT THE CENTERLINE INTERSECTION OF MAJESTIC RIDGE DR. AND EAGLE RIDGE DR.
ELEVATION 4213.08 (CITY DATUM)

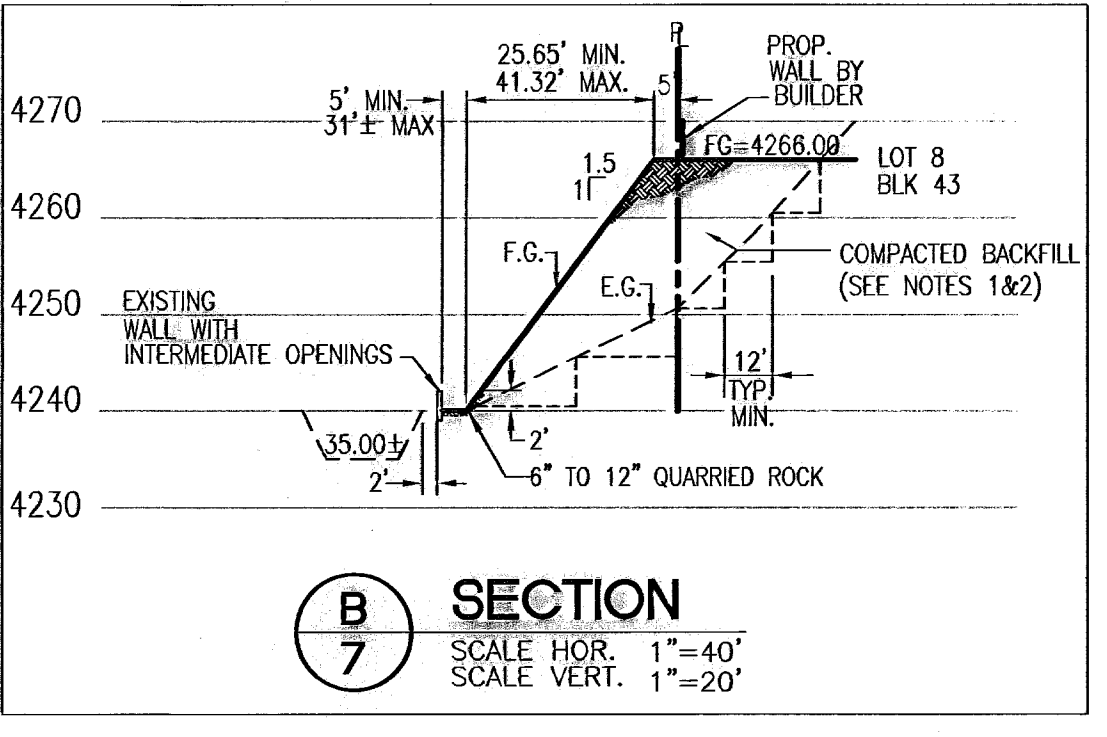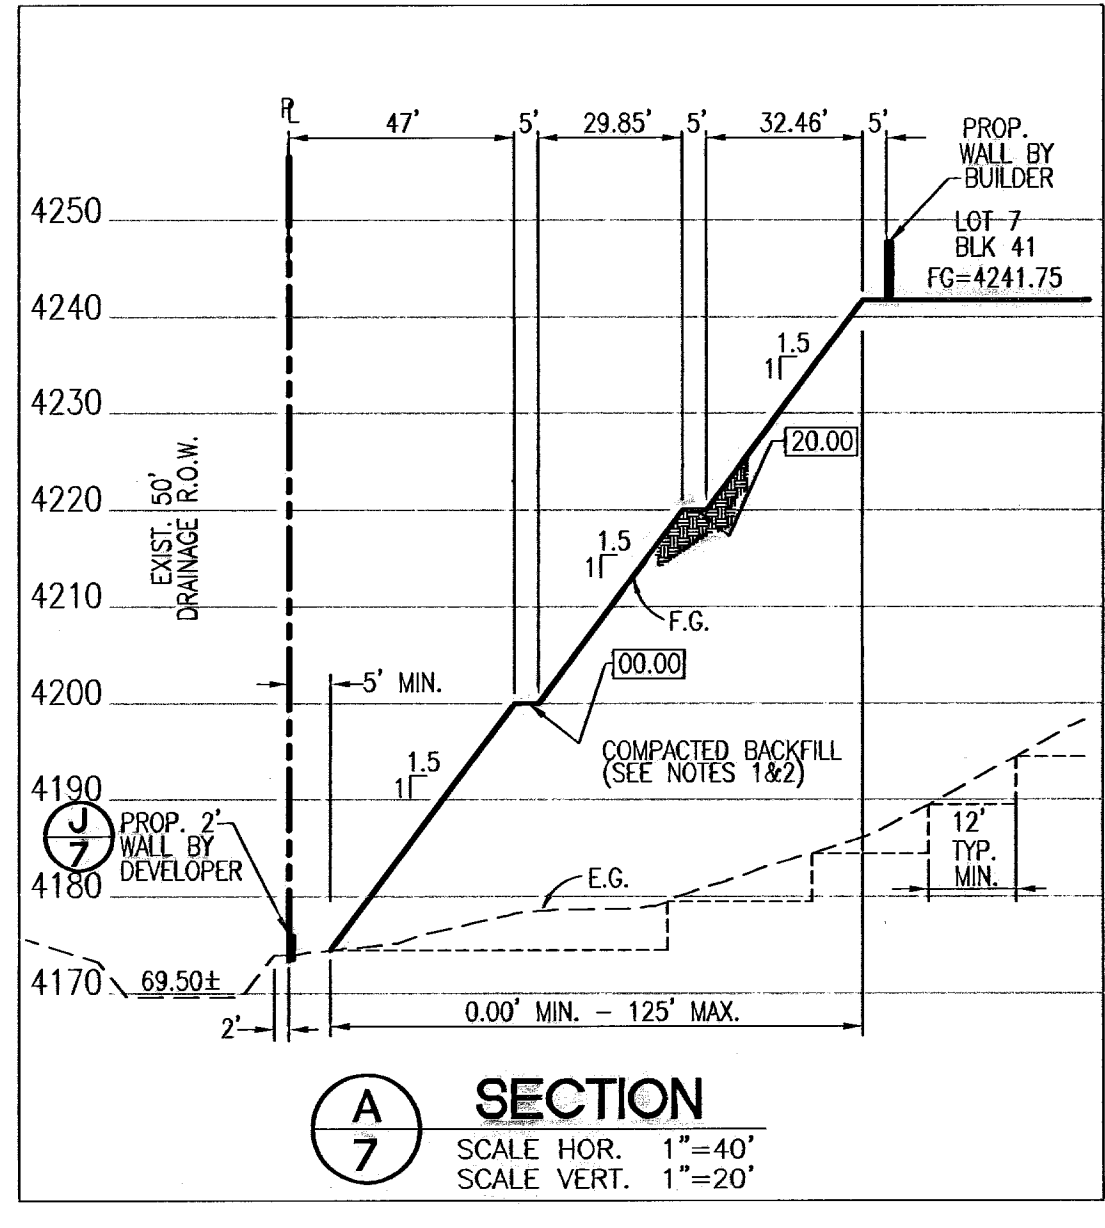

NOTE: TUSCANY AT RIDGEVIEW IS WITHIN FLOOD ZONE G AND A2 COMMUNITY PANEL # 480214 0022 E DATED JANUARY 3, 1997

LEGEND
ROCK RETAINING WALL REQUIRED

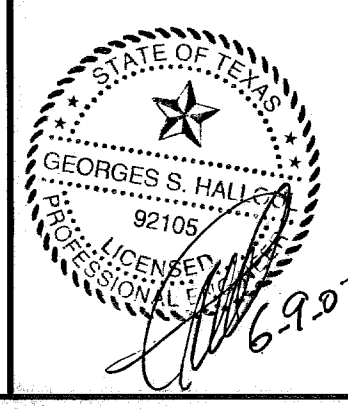


DATE	REVISION	DESCRIPTION	BY

TUSCANY AT RIDGEVIEW
EL PASO, EL PASO COUNTY, TEXAS
GRADING PLAN
AS-BUILT
SLI ENGINEERING, INC.
CIVIL ENGINEERS * LAND SURVEYORS * LAND PLANNERS
6600 WESTWIND DR. - EL PASO, TEXAS - 79912 - (915) 584-4457

SCALE: 1" = 100'
JOB No. 01-02-1968
FIELD BOOK
DESIGNED BY: ET
COMP. BY: ET
DRAWN BY: SRJ
CHECKED BY: ET
DATE: 08/24/05

SLI ENGINEERING, INC.


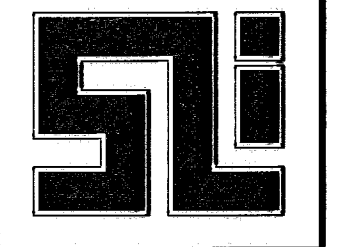


**RIDGE VIEW ESTATES
UNIT TWENTY TWO**

(MARY TIPPIN SCHOOL)

64

LEGEND	
	PROPOSED RUNOFF
	PROPOSED LOW POINT
	PROPOSED HIGH POINT
	PROPOSED WATERSHED BOUNDARY
	PROPOSED DRAINAGE FLOW
	EXISTING DRAINAGE FLOW
	EXISTING CONTOURS

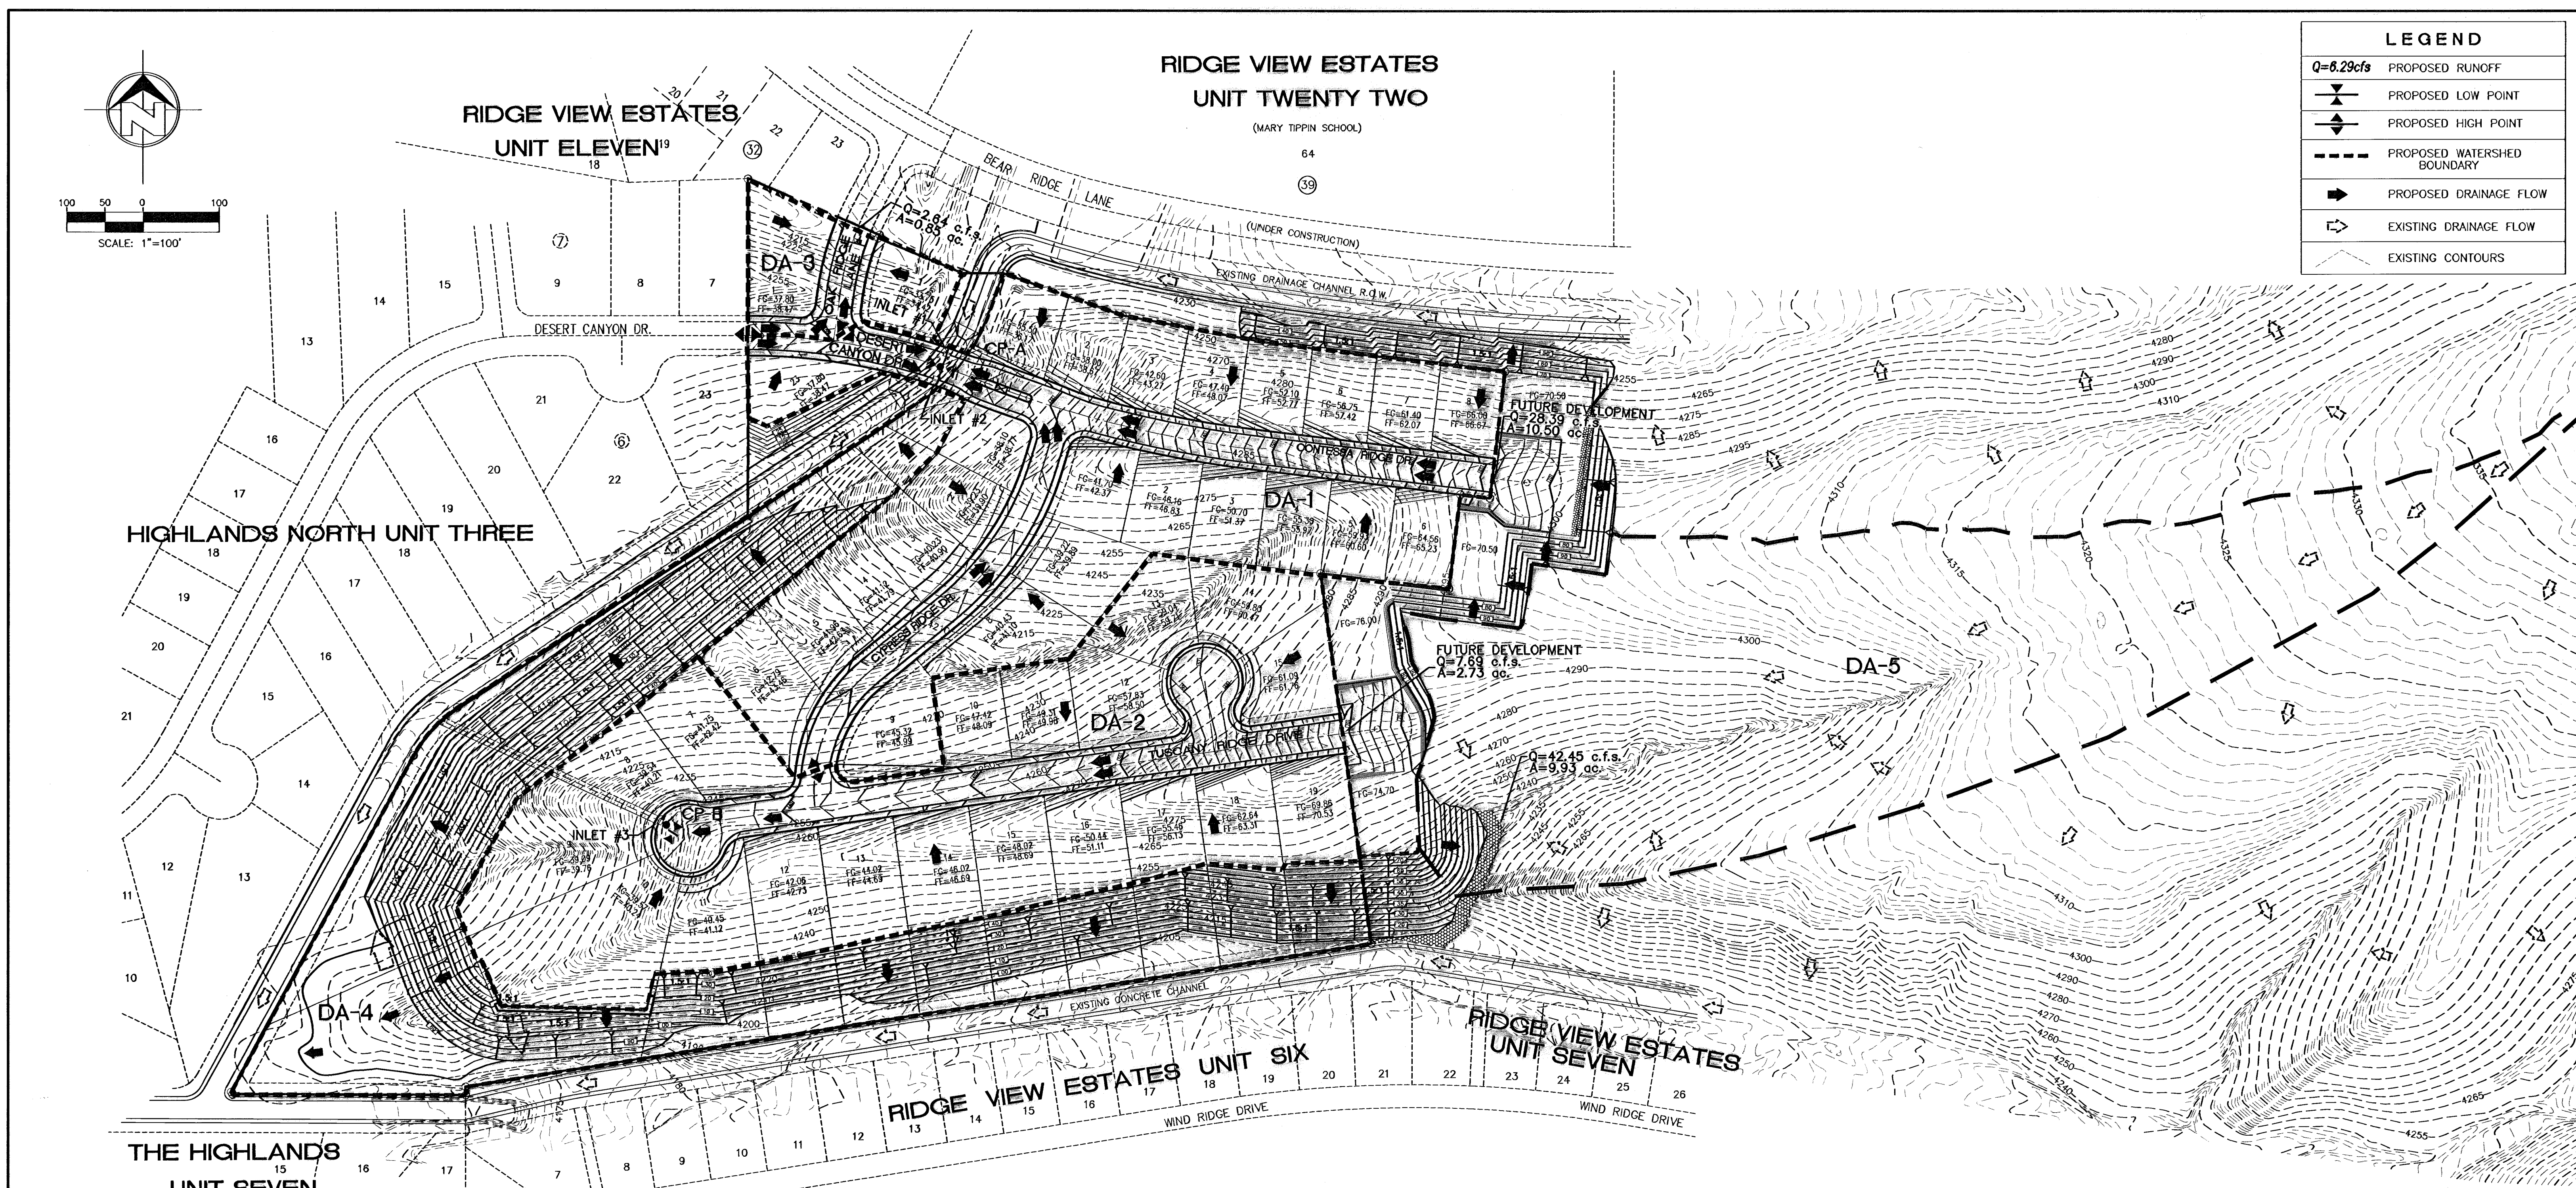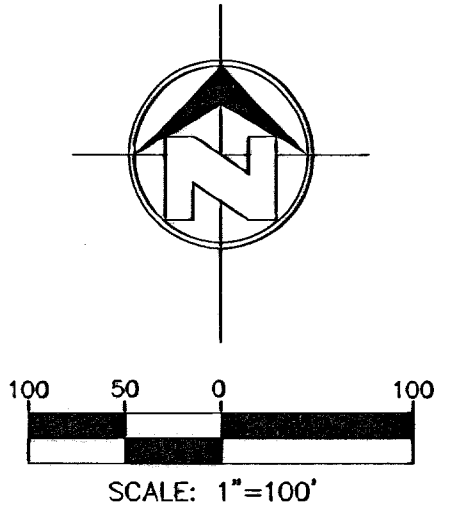

SUMMARY OF INLETS (25 YEAR STORM)

INLET NO.	EXP. "Q"	INLET TYPE	NO. OF GRATES	INLET CAPACITY	FLOW BYPASS
1	22.79 cfs.	1	4	36.00 cfs.	0
2	22.79 cfs.	1	4	36.00 cfs.	0
3	30.57 cfs.	1	4	36.00 cfs.	0


- (1) LOCATION
- (2) DEPTH
- (3) VELOCITY
- (4) PRODUCT NUMBER = DEPTH X VELOCITY

MOMENTUM COMPUTATION (25 YEAR STORM)


LOCATION @ INLET (1)	DEPTH (2)	VELOCITY (3)	PRODUCT NUMBER (4)
1	0.48'	5.40 f.p.s.	2.59
2	0.48'	5.40 f.p.s.	2.59
3	0.38'	4.30 f.p.s.	1.63

RATIONAL METHOD: Q=CIA


D.A. #	AREA (acres)	Tc (min)	C (avg)	I(25 yr) (in/hr)	Q(25 yr) (cfs)	Q(100 yr) (cfs)
1	8.04	9.68	0.65	4.49	23.46	29.68
2	8.52	10.52	0.65	4.34	24.03	26.32
3	0.86	8.10	0.65	4.78	2.67	3.37
4	7.02	5.00	0.85	5.50	32.82	38.06
5	9.89	6.84	0.85	5.05	42.45	48.51
CP-A	18.70	14.78	0.65	3.75	45.58	56.40
CP-B	11.25	11.54	0.65	4.18	30.57	34.39

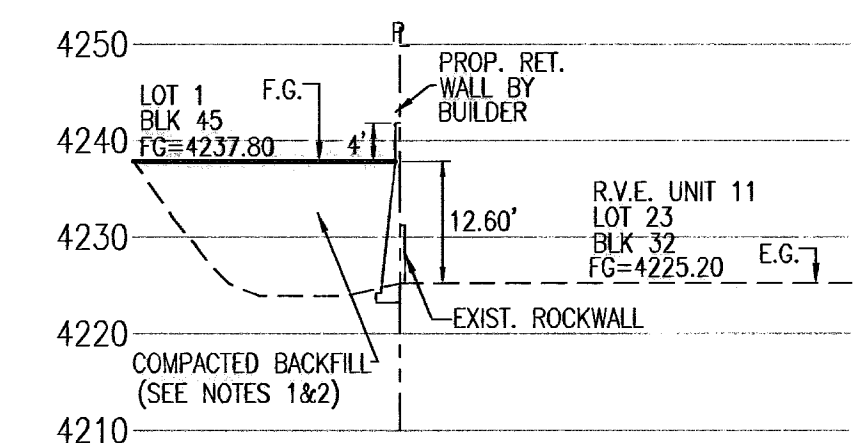


A SECTION
SCALE HOR. 1"=40'
SCALE VERT. 1"=20'

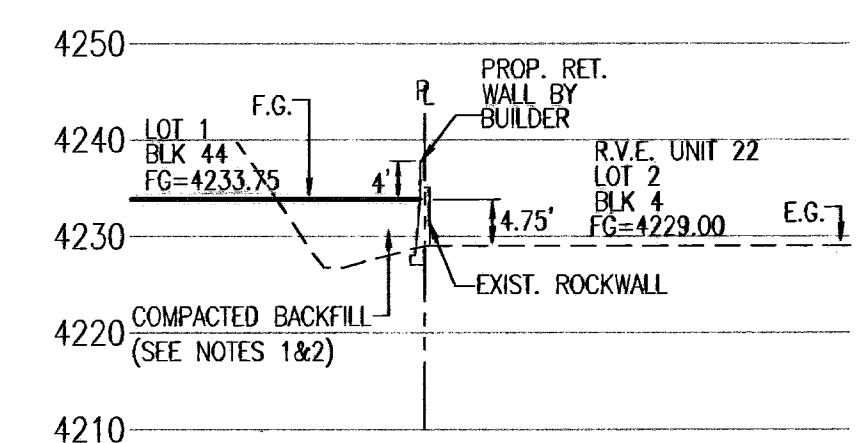

B SECTION
SCALE HOR. 1"=40'
SCALE VERT. 1"=20'

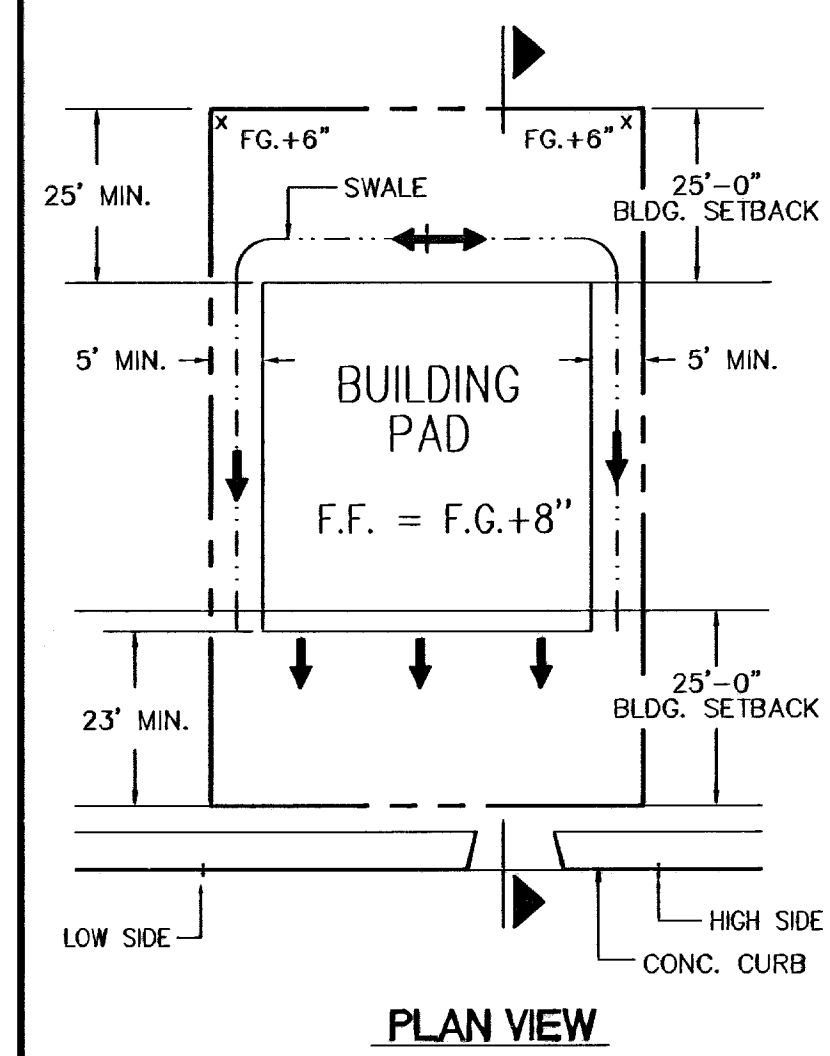


NOTE: EACH INDIVIDUAL LOT OWNER IS RESPONSIBLE FOR THE DRAINAGE OF ALL STORM WATER RUNOFF FROM THE BACK OF THE LOT TO THE FRONT OF THE LOT. THIS INCLUDES ALL RUNOFF FROM CONTRIBUTING SLOPES ONTO THE LOT. SEE LOT DRAINAGE DETAIL ON THIS SHEET.

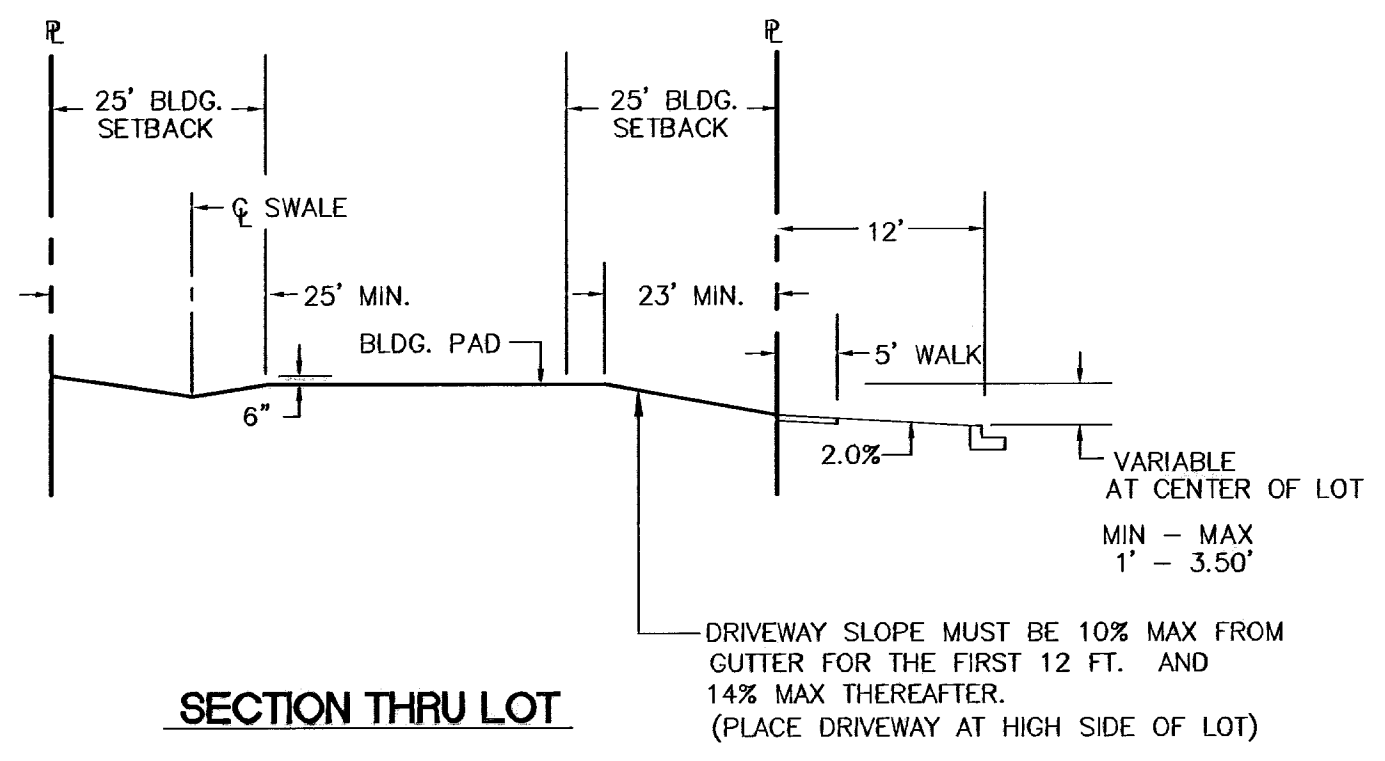


TYPICAL LOT DRAINAGE
NOT TO SCALE





BENCHMARK:
EXISTING CITY MONUMENT AT CENTERLINE INTERSECTION OF MARSHIC RIDGE DR. AND EAGLE RIDGE DR. ELEVATION = 4213.08 (CITY DATUM)

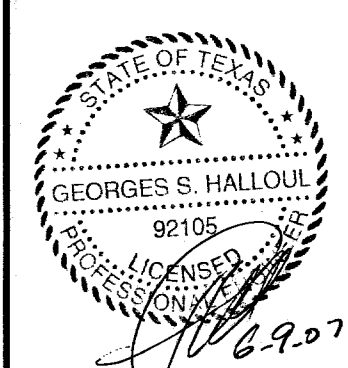

DATE	REVISION	DESCRIPTION	BY


TUSCANY AT RIDGEVIEW
EL PASO, EL PASO COUNTY, TEXAS
DRAINAGE PLAN
AS-BUILT
SLI ENGINEERING, INC.
CIVIL ENGINEERS * LAND SURVEYORS * LAND PLANNERS
6600 WESTWIND DR. - EL PASO, TEXAS - 79912 - (915) 584-4457

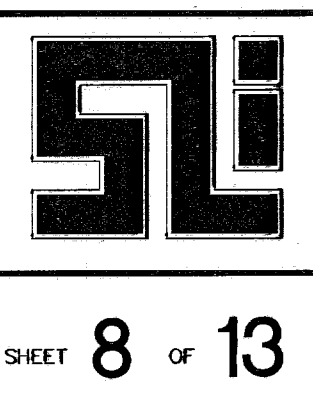

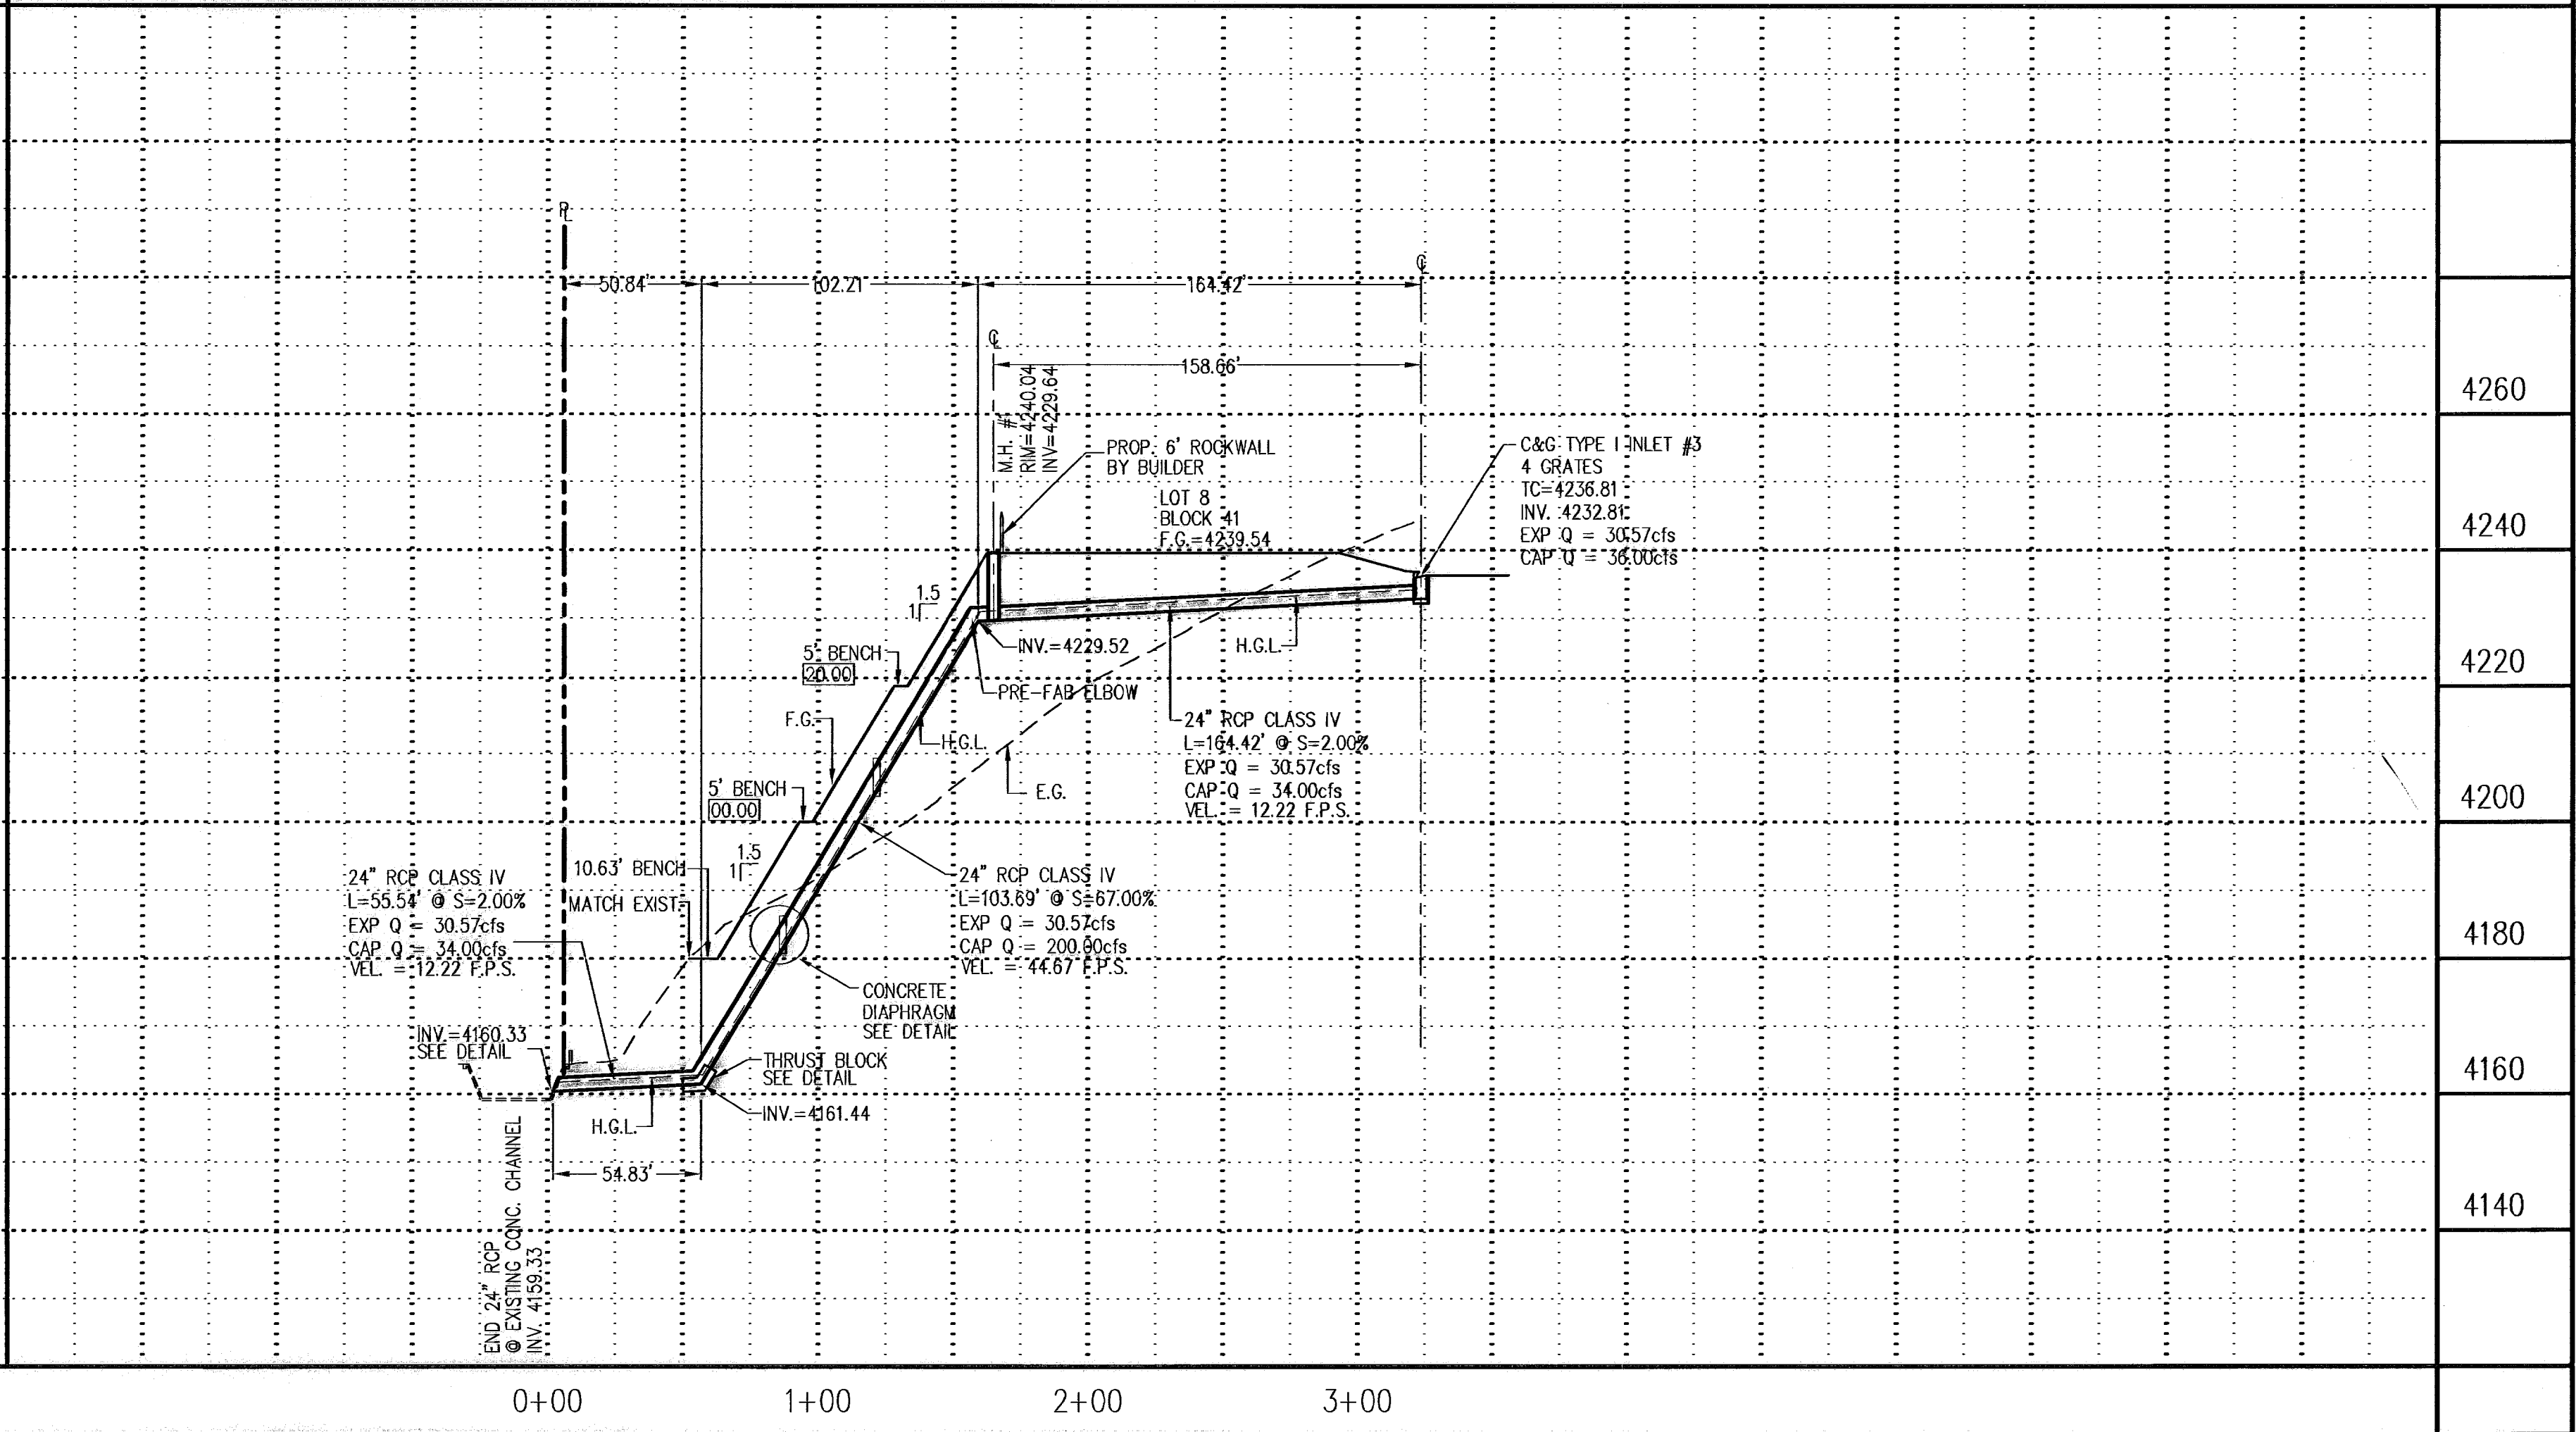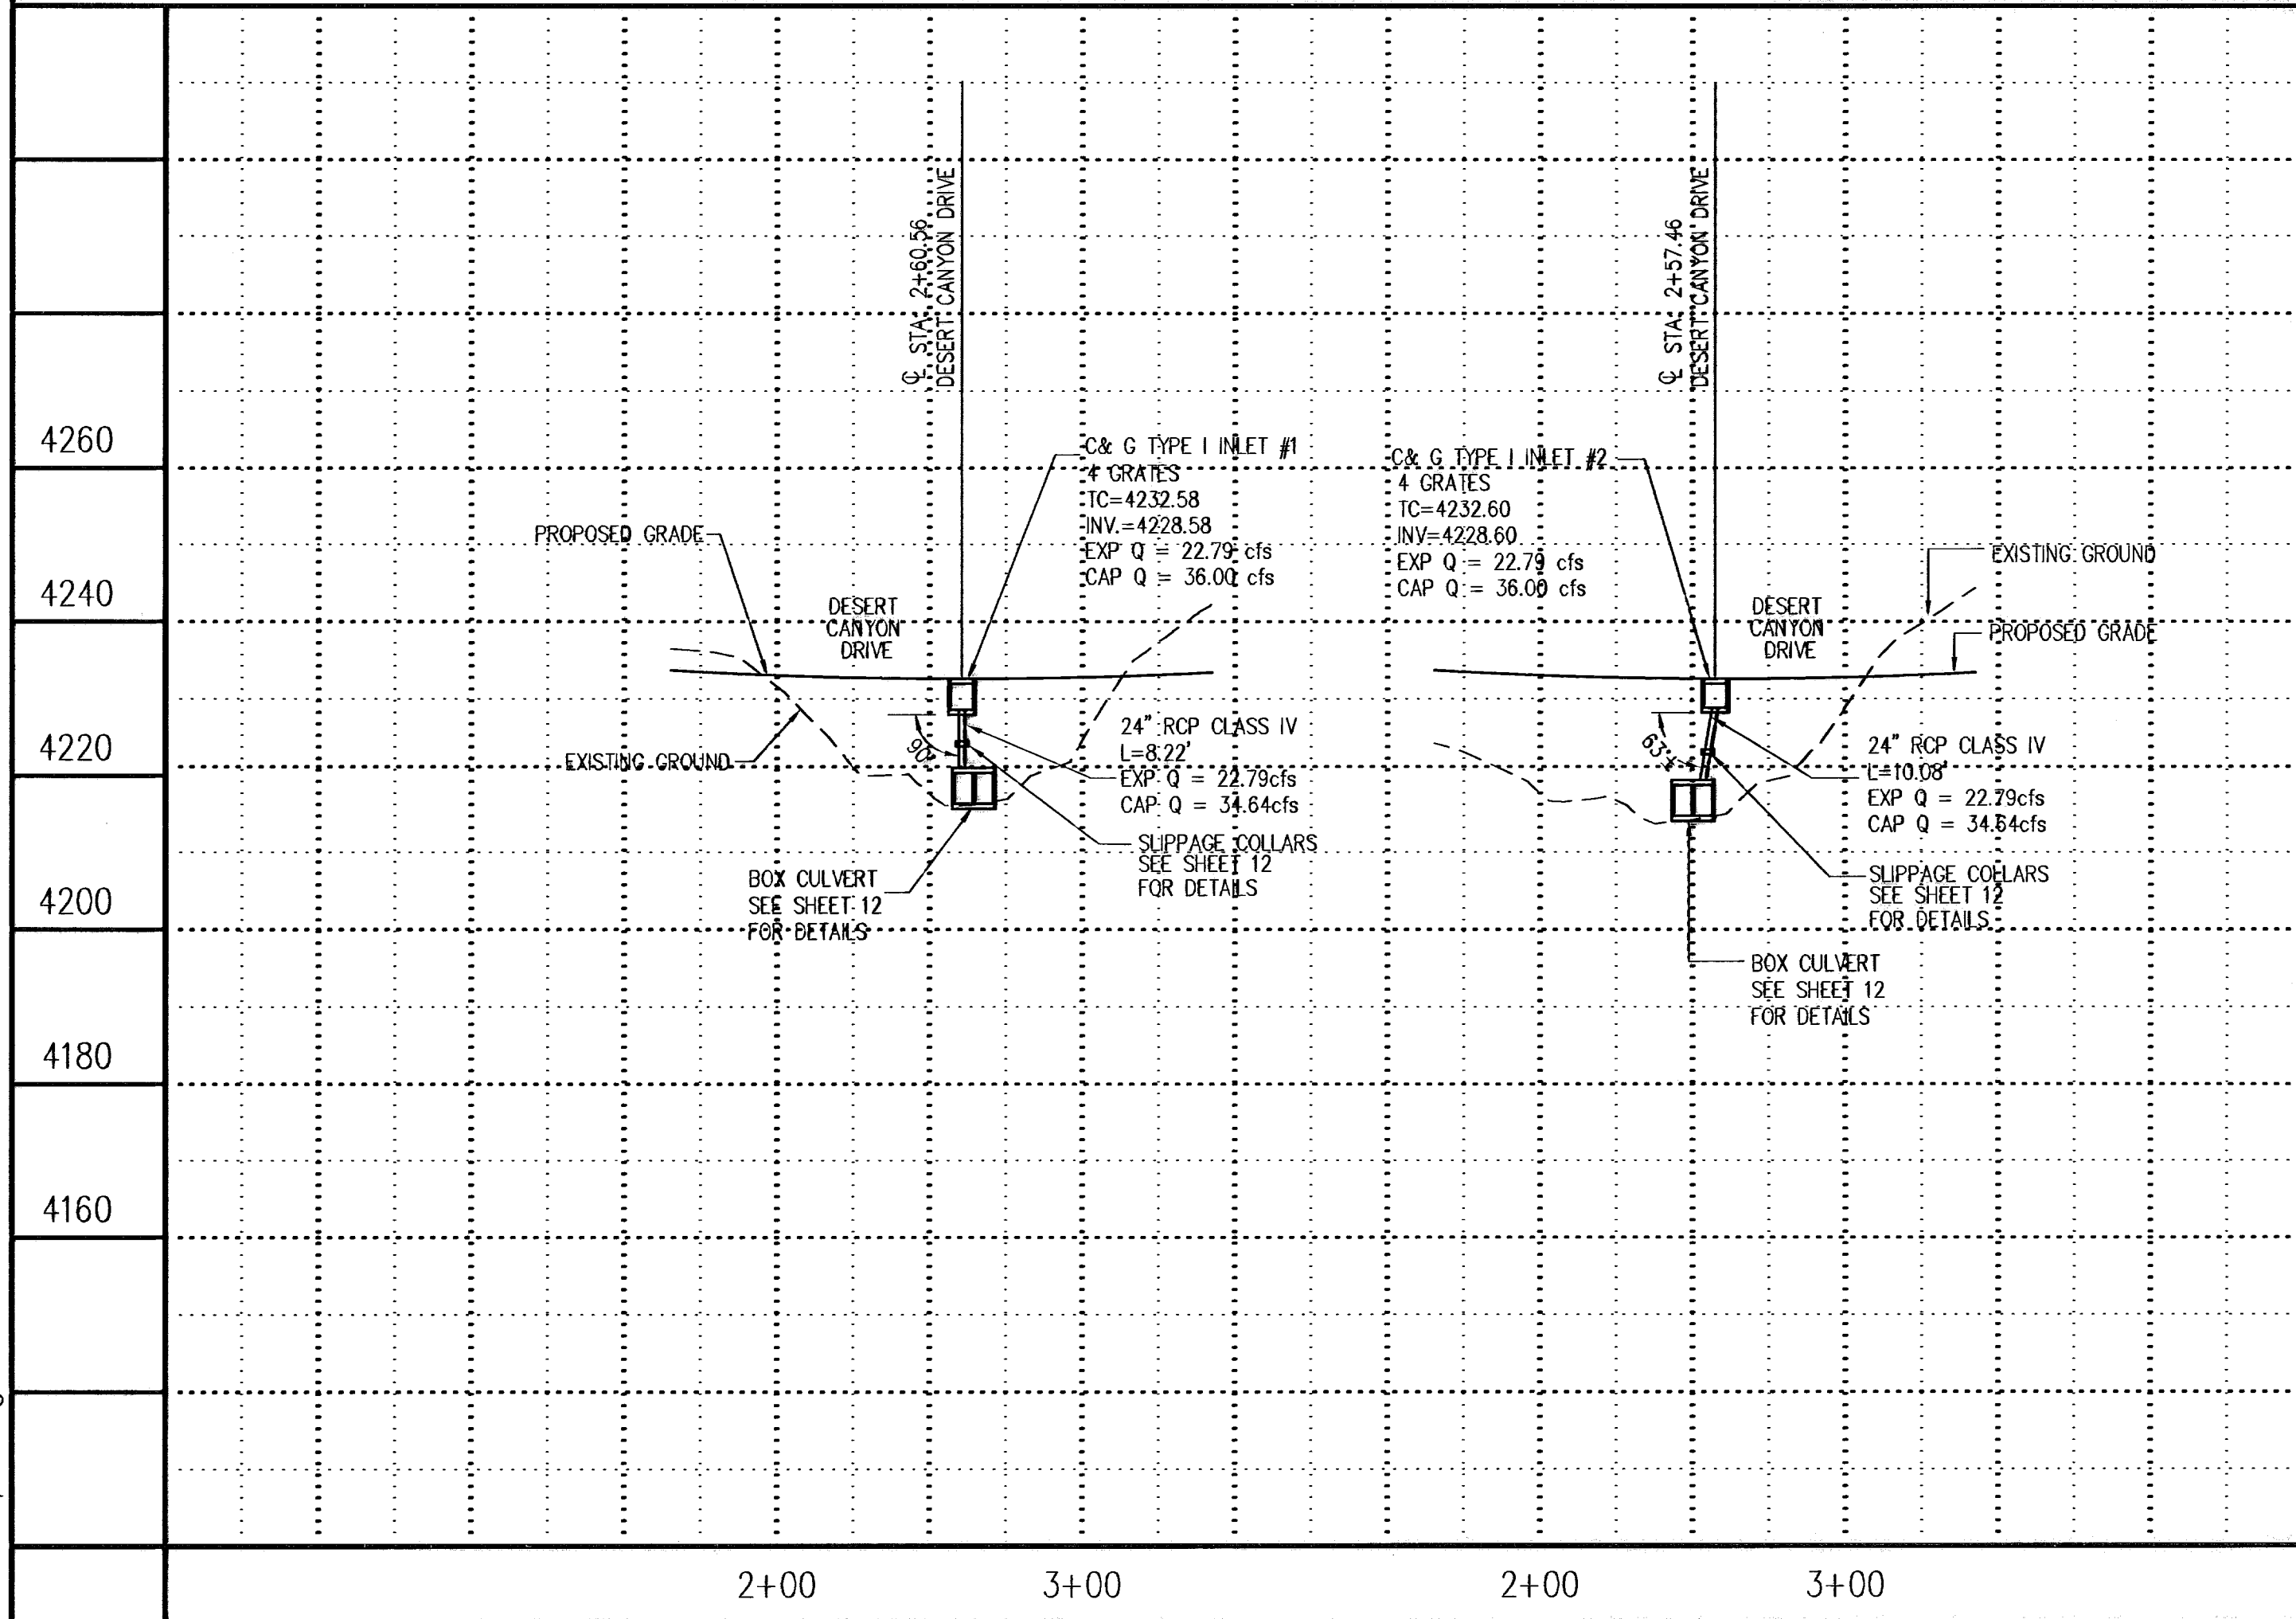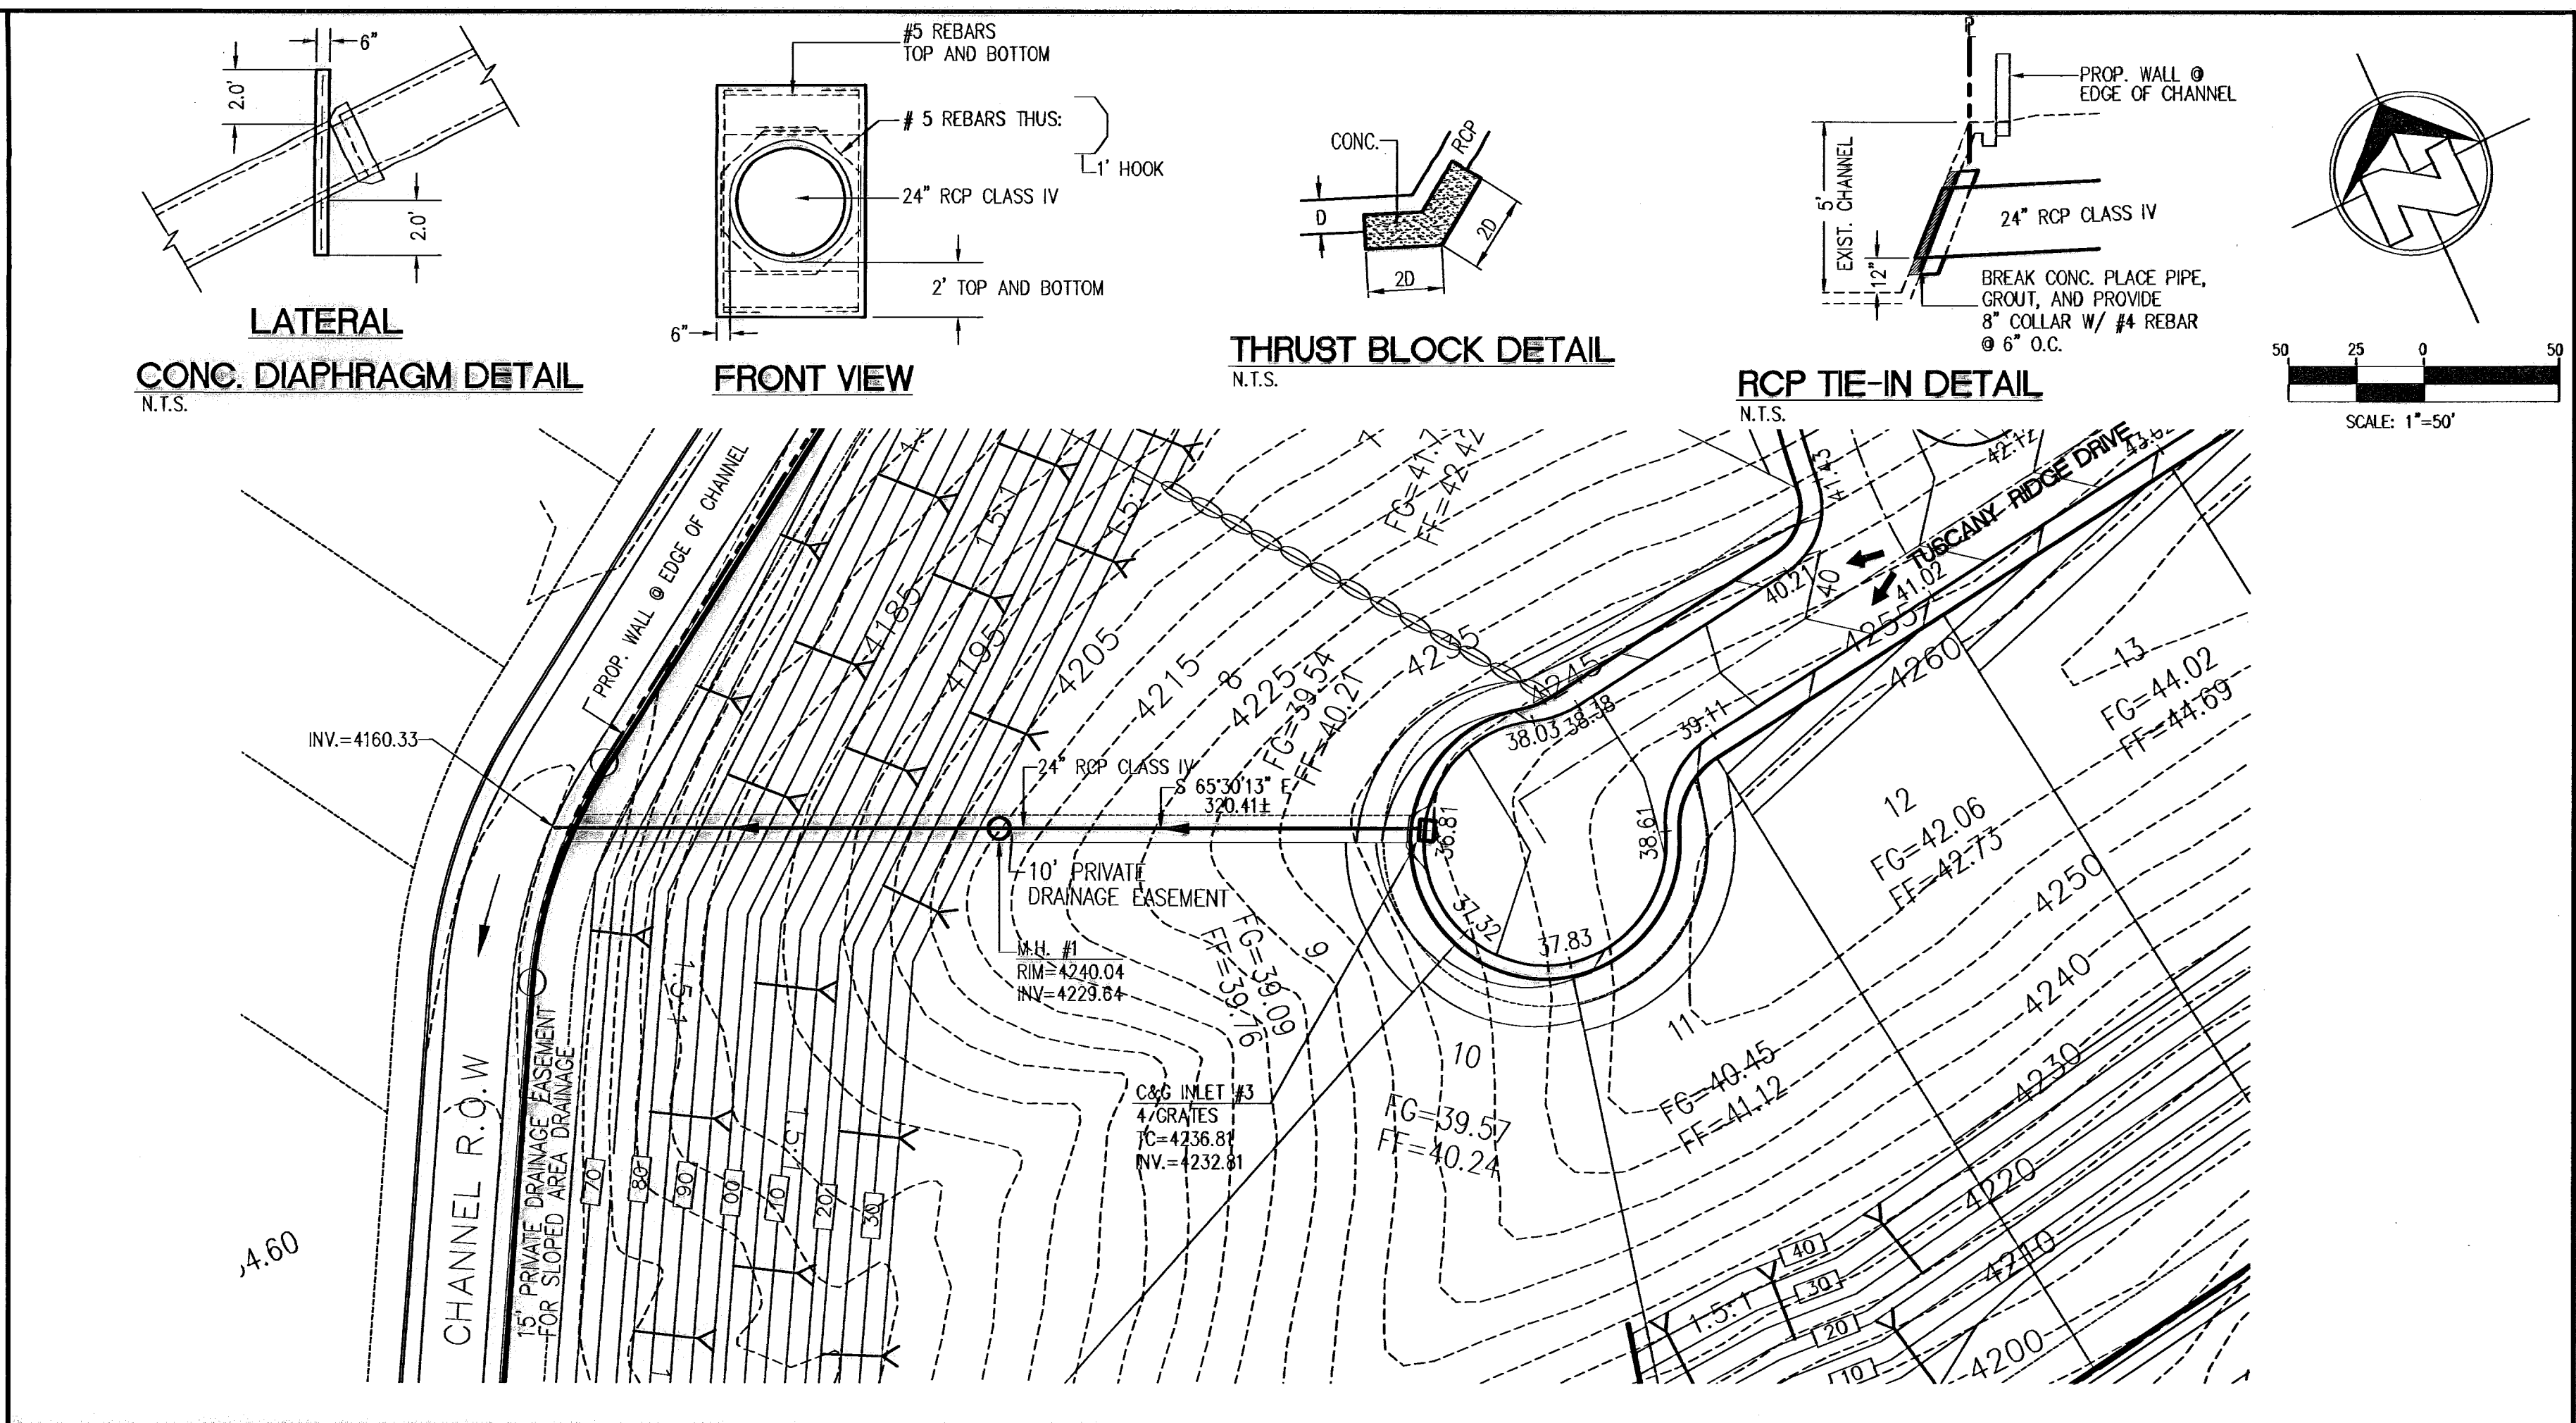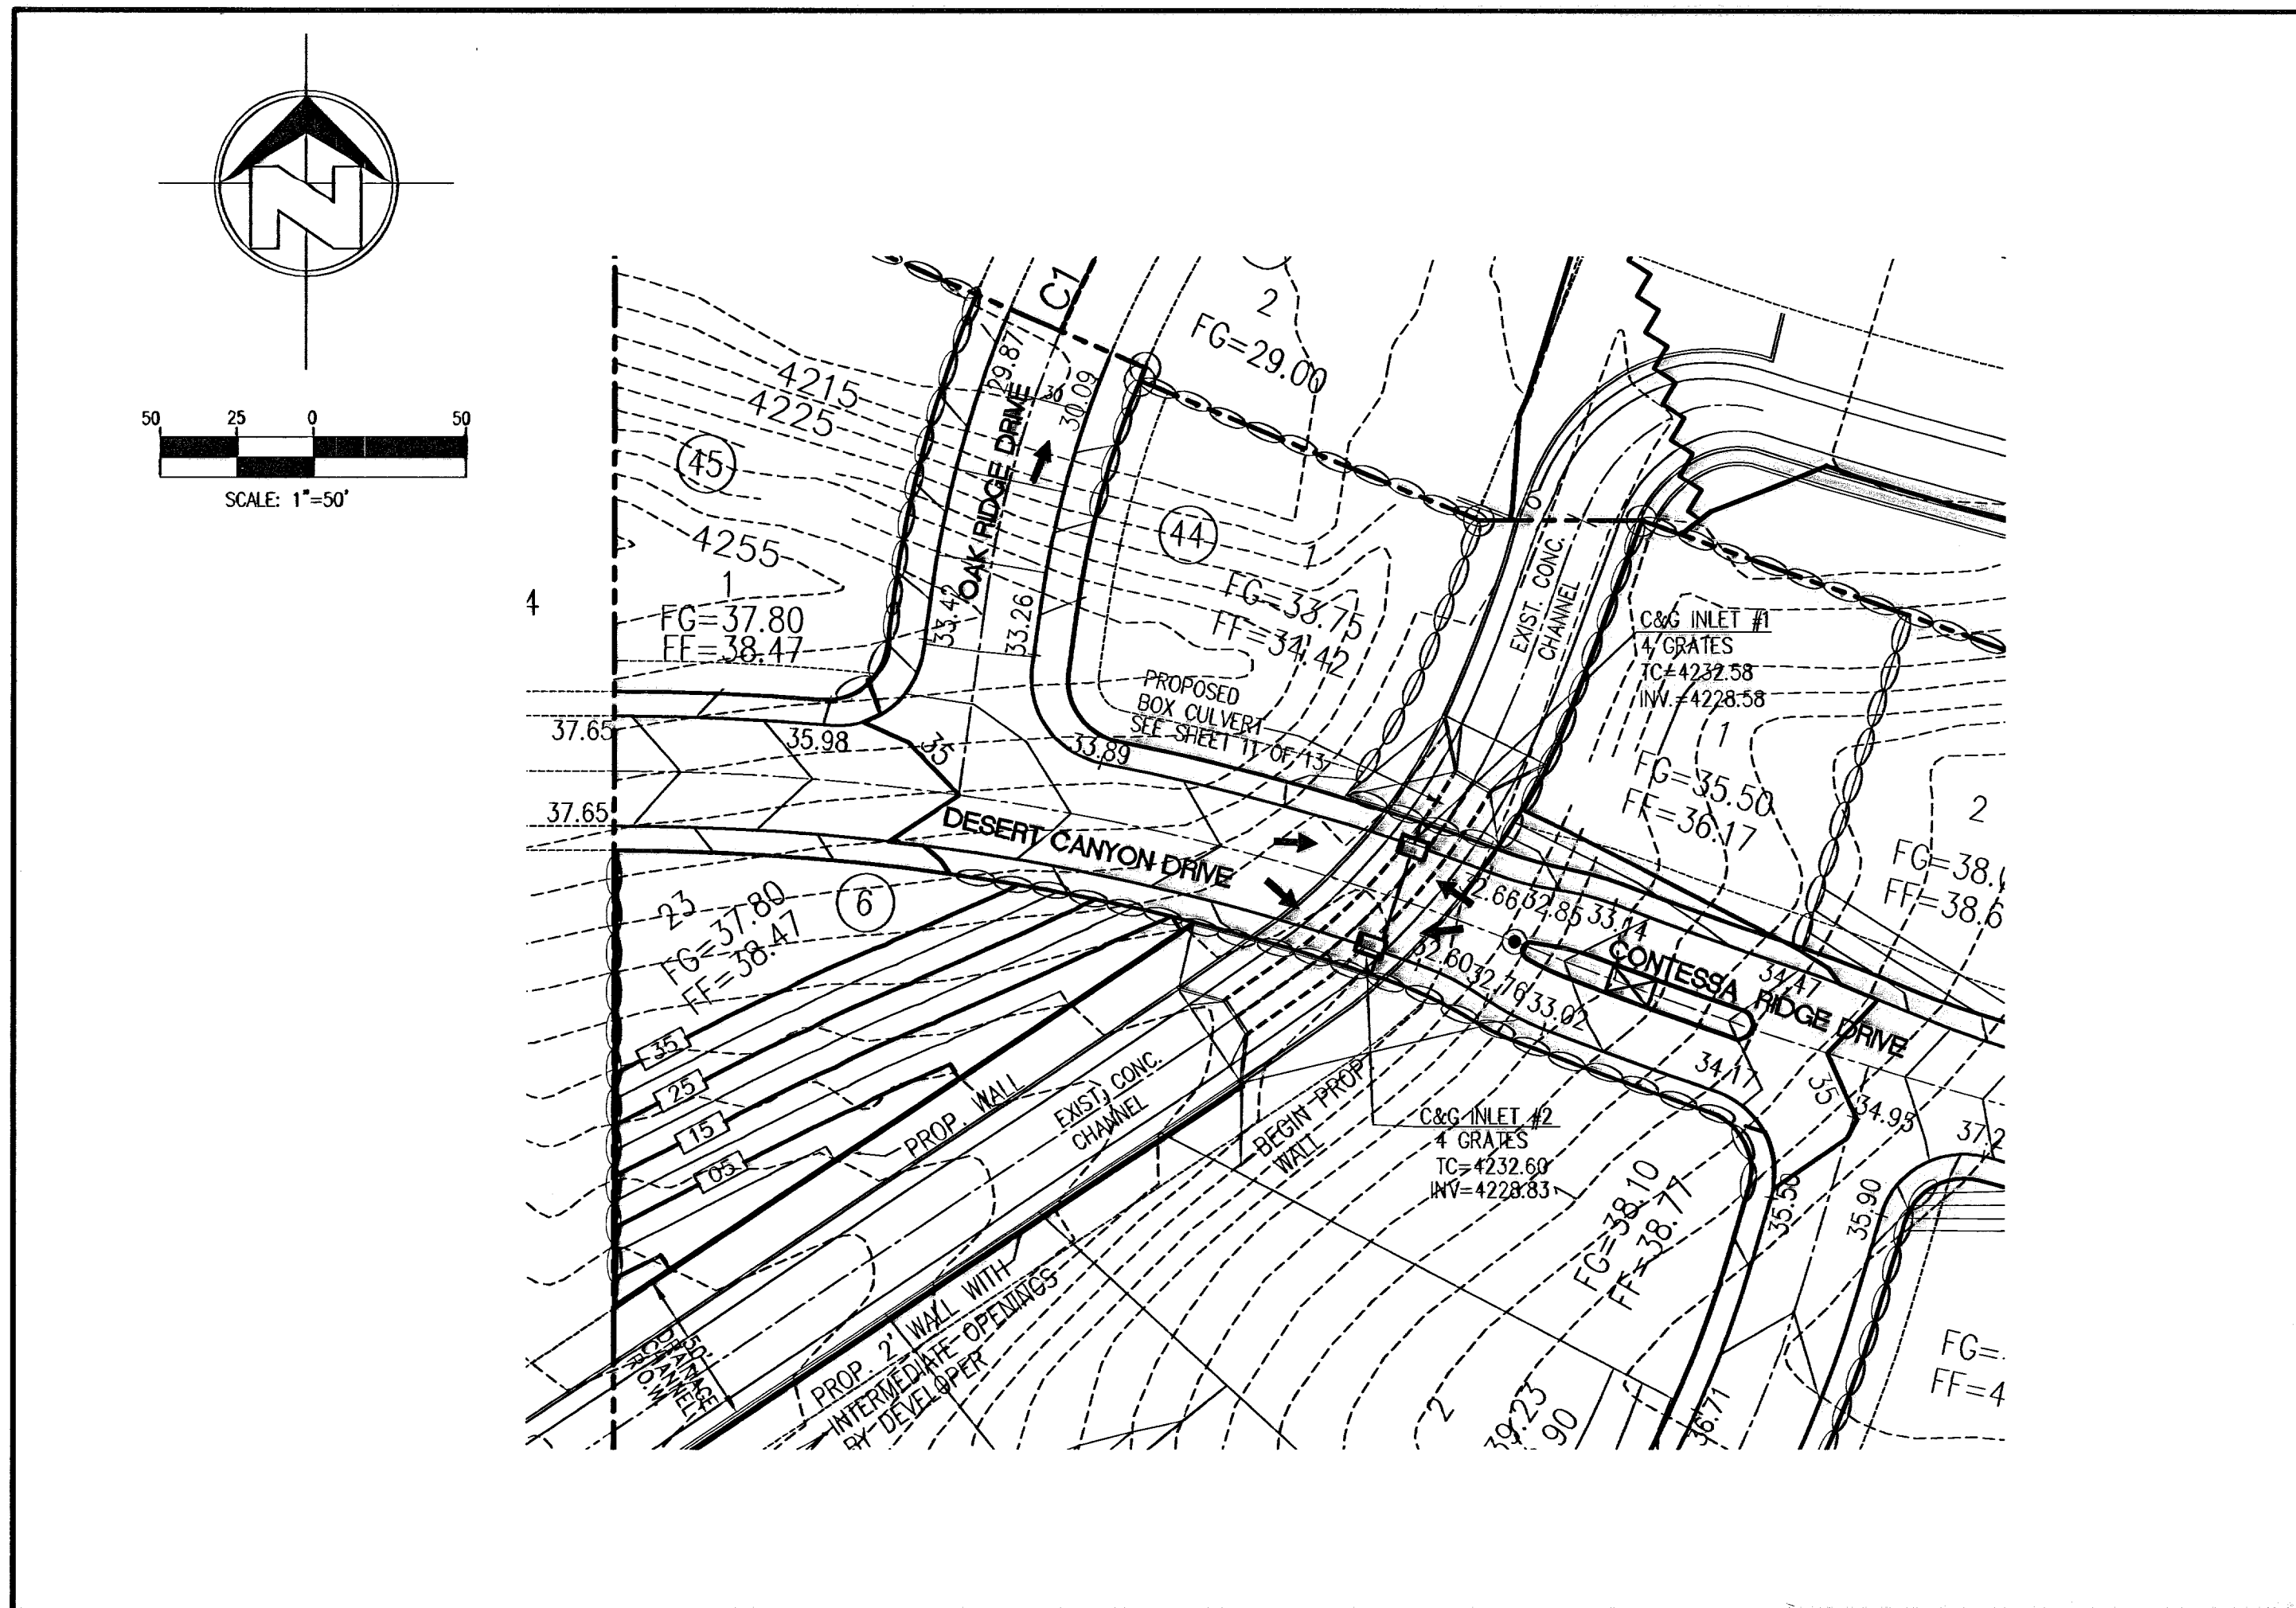

F:\PROJECTS\RYE-4\NAS-BUILD\TS\pp-sadawg 6/6/2007 12:26:23 PM MDT

BENCHMARK:
EXISTING CITY MONUMENT AT CENTERLINE INTERSECTION OF MAJESTIC RIDGE DR. AND EAGLE RIDGE DR. ELEVATION = 4213.08 (CITY DATUM)

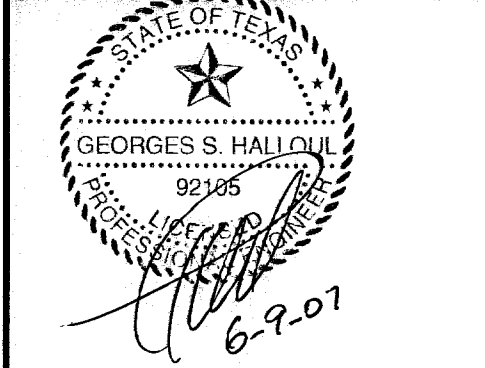

SCALE
HOR. 1" = 50'
VER. 1" = 20'

DATE	REVISION	DESCRIPTION	BY

SCALE: AS NOTED
JOB NO. 01-95-1172
FIELD BOOK
DESIGNED BY: SRJ
COMP. BY: SRJ
DRAWN BY: SRJ
CHECKED BY: E.T.
DATE: 08/17/05


TUSCANY AT RIDGEVIEW
EL PASO, EL PASO COUNTY, TEXAS
STORM DRAIN AS-BUILT
SLI ENGINEERING, INC.
CIVIL ENGINEERS * LAND SURVEYORS * LAND PLANNERS
6600 WESTWIND DR. - EL PASO, TEXAS - 79912 - (915) 584-4457

SLI
SHEET 10 OF 13


600830

CURB AND GRATE


C & G	NO. OF GRATES	LENGTH (L)	DEPTH (D)	BEAM SIZE	BEAM LENGTH	T.C.1	T.C.2	INVERT	Q (EXP.) CFS	INLET CAP. CFS
1	4	8'-9 7/8"	4.00	W9x18	8'-3 7/8"	4232.58	4232.58	4228.58	22.79	36.00
2	4	8'-9 7/8"	4.00	W9x18	8'-3 7/8"	4232.60	4232.60	4228.60	22.79	36.00
3	4	8'-9 7/8"	4.00	W9x18	8'-3 7/8"	4236.81	4236.81	4232.81	30.57	36.00

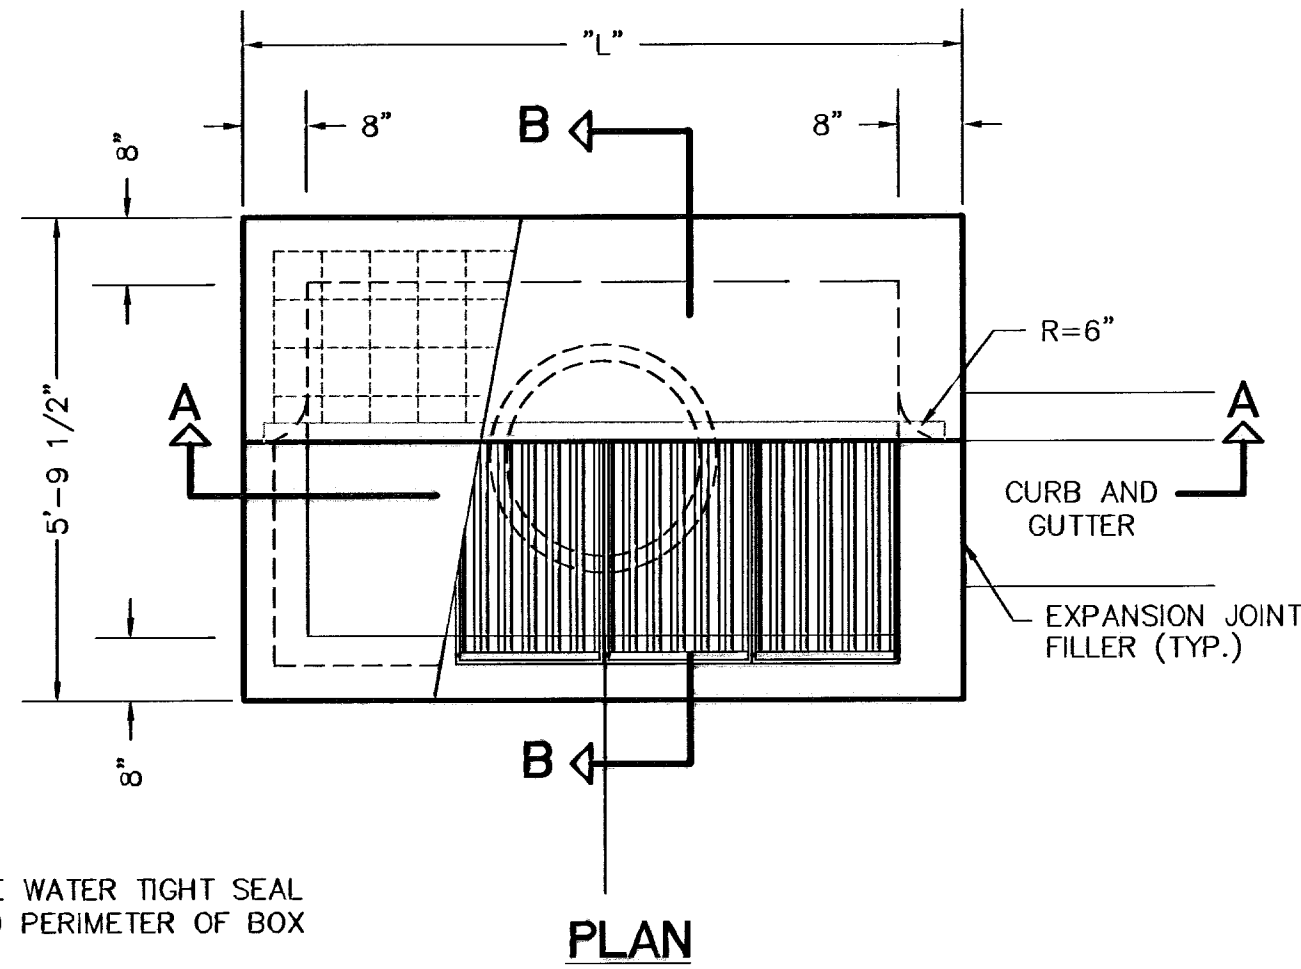

PROVIDE WATER TIGHT SEAL AROUND PERIMETER OF BOX

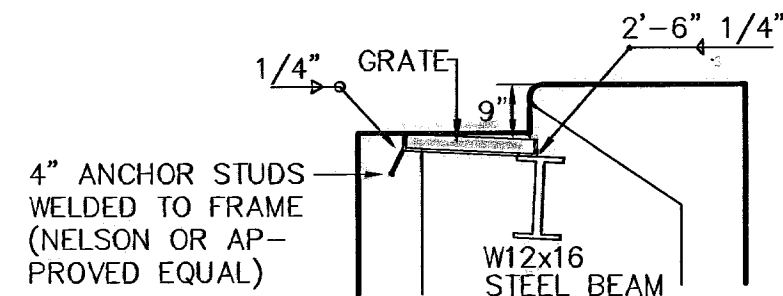

STUD AND BEAM DETAIL

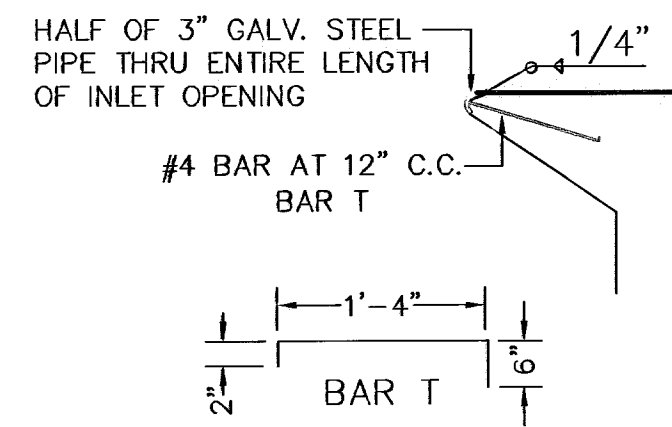


NOSE DETAIL


- WELDED STEEL OR CAST GRATES AS DETAILED ARE ALL ACCEPTABLE GRATES. MIXING OF ALTERNATE TYPES OF GRATES ON THE SAME PROJECT WILL BE PERMITTED WITH THE APPROVAL OF THE CITY ENGINEER.
- ALL CONSTRUCTION AND MATERIALS SHALL BE IN ACCORDANCE WITH CURRENT STANDARD SPECIFICATIONS.
- SHARP EDGES RESULTING FROM FABRICATION SHALL BE DULLED BY ANY ACCEPTABLE METHOD FOR SAFETY IN HANDLING.
- WELDED GRATES SHALL BE STRUCTURAL STEEL CONFORMING TO THE REQUIREMENTS OF AASHTO M-183 OR OF CORROSION RESISTANT STRUCTURAL STEEL CONFORMING TO THE REQUIREMENTS OF AASHTO M-161 OR M-222 OR BE MADE OF OTHER APPROVED STEELS OF EQUAL QUALITY. MIXING GRADES OF STEEL ON THE SAME GRATE WILL NOT BE PERMITTED.
- GRATES MADE OF M-183 STEEL SHALL BE GALVANIZED IN ACCORDANCE WITH AASHTO M-111 SPECIFICATIONS OR SHALL BE PAINTED WITH INORGANIC ZINC PAINTS, MEETING THE REQUIREMENTS OF CURRENT STANDARD SPECIFICATIONS.
- ALL WELDS SHALL BE A MINIMUM OF 1/4" FILLET AND SHALL CONFORM TO THE SPECIFICATIONS FOR HIGHWAY CONSTRUCTION AND TO THE AWS STRUCTURAL WELDING CODE. ELECTRODES SHALL BE COMPATIBLE TO THE DIFFERENT GRADES OF STEEL THAT COMPRISE THE GRATE MEMBERS.
- CAST GRATES SHALL BE CAST STEEL CONFORMING TO THE REQUIREMENTS OF AASHTO M-103, GRADE 65-35 OR OF DUCTILE IRON CONFORMING TO THE REQUIREMENTS OF ASTM A-536, SPECIAL GRADE 60-45, OR OF GRAY IRON CONFORMING TO THE REQUIREMENTS OF ASTM A-48 CLASS 350 OR ASTM A-48 CLASS 350. THE SPECIFICATIONS OF GENERAL APPLICATION FOR CAST STEEL GRATES SHALL BE AASHTO M-103 SCOPE 1.2.1, GRADE N-1.
- FERROUS CASTINGS SHALL BE OF UNIFORM QUALITY, FREE OF BLOWHOLES, POROSITY, HARD SPOTS, SHRINKAGE DISTORTION OR OTHER DEFECTS. THEY SHALL BE SMOOTH AND WELL CLEANED BY SHOT BLASTING OR OTHER APPROVED CLEANING METHOD. AFTER CLEANING THEY SHALL BE COATED WITH ASPHALT BASE PAINT RESULTING IN A SMOOTH COATING, TOUGH AND TENACIOUS WHEN COLD, NOT TACKY NOR BRITTLE.
- ALL CASTINGS SHALL BE MANUFACTURED TRUE TO PATTERN. COMPONENT PARTS SHALL FIT TOGETHER IN A SATISFACTORY MANNER.
- ALL CONCRETE TO BE 3000 p.s.i. CHAMFER ALL EXPOSED EDGES 3/4". ALL DIMENSIONS RELATING TO REINFORCING STEEL ARE TO CENTER OF BARS.
- MINIMUM CONCRETE COVER SHALL BE 1-1/2" FOR STEEL REINFORCING.
- EXPANSION MATERIAL TO BE 1/2" BITUMINOUS FIBER AND BE PLACED WHERE PROPOSED CONCRETE COMES IN CONTACT WITH ANY EXISTING OR PROPOSED CONCRETE OR MASONRY STRUCTURE.
- STRUCTURAL STEEL SHALL BE PAINTED IN ACCORDANCE WITH T.H.D. ITEM 446 "PAINT AND PAINTING".
- SURFACE OF ALL EXPOSED CONCRETE SHALL CONFORM IN SLOPE AND GRADE TO EXISTING OR PROPOSED CURB AND WALK ADJACENT TO INLETS.
- ALL REINFORCING BARS TO BE #4 BARS AT 6" O.C. GRADE 60. BEND BARS AROUND PIPE OPENINGS.
- THE GRATES OF ALL INLETS WITHIN THE STREET PAVEMENT MUST BE CONSTRUCTED WITH THE GRATE BARS PERPENDICULAR TO THE CURB.

MANHOLE GENERAL NOTES

- MANHOLES SHALL BE MANUFACTURED IN CONFORMANCE WITH ASTM C-478-93 AND MEETING ALL REQUIREMENTS AND DIMENSIONS.
 - POURED IN PLACE CONCRETE MUST HAVE A MINIMUM ALLOWABLE COMPRESSIVE STRENGTH OF 3000 p.s.i. @ 28 DAYS.
 - MASONRY IF USED, TO BE COMMON BRICK WITH ASTM TYPE "S" MORTAR 1800 p.s.i.
 - ALL PRECAST JOINTS ON MANHOLES MUST BE GROUTED OR SEALED FOR A WATER TIGHT JOINT.
 - MANHOLE COVER MUST BE FLUSH WITH FINISHED PAVEMENT. (SLOPE TO MATCH FIG.)
 - MATCHING SURFACES MARKED "M" TO BE MACHINE FINISHED OF ANY IRREGULARITIES THAT WOULD PREVENT A SNUG FIT.
 - CASTING OF MANHOLES, ETC. TO BE SMOOTH AND VOID OF AIR HOLES.
- JOINTS ARE TONGUE AND GROOVE TYPE.

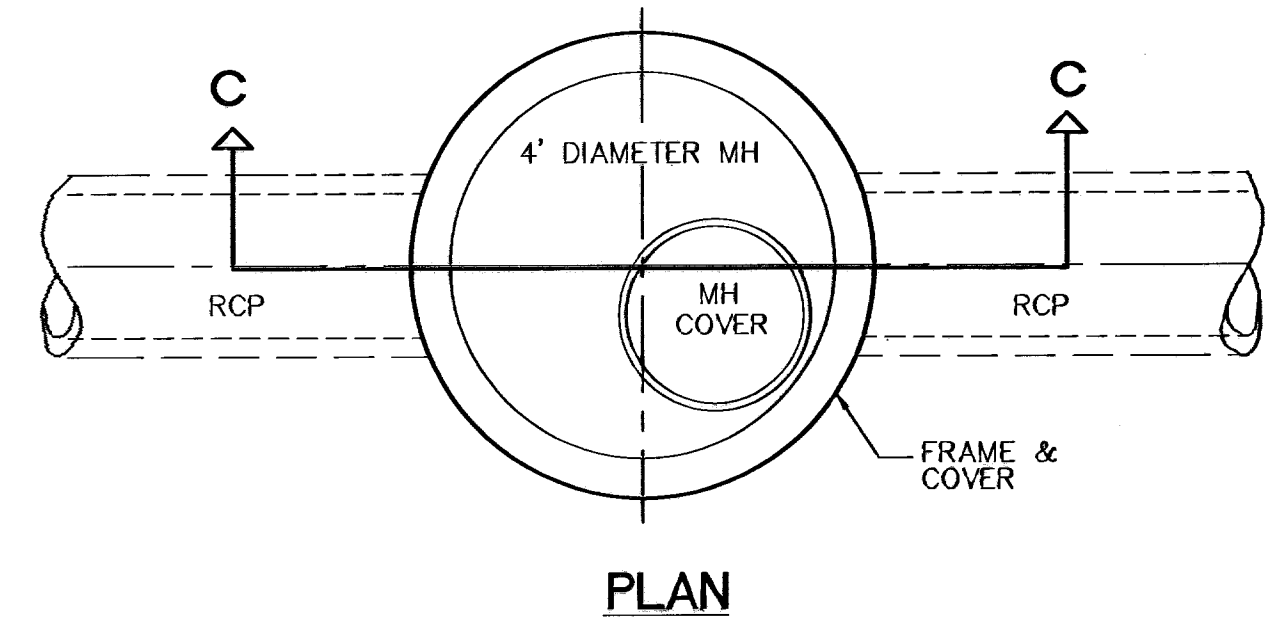


PLAN

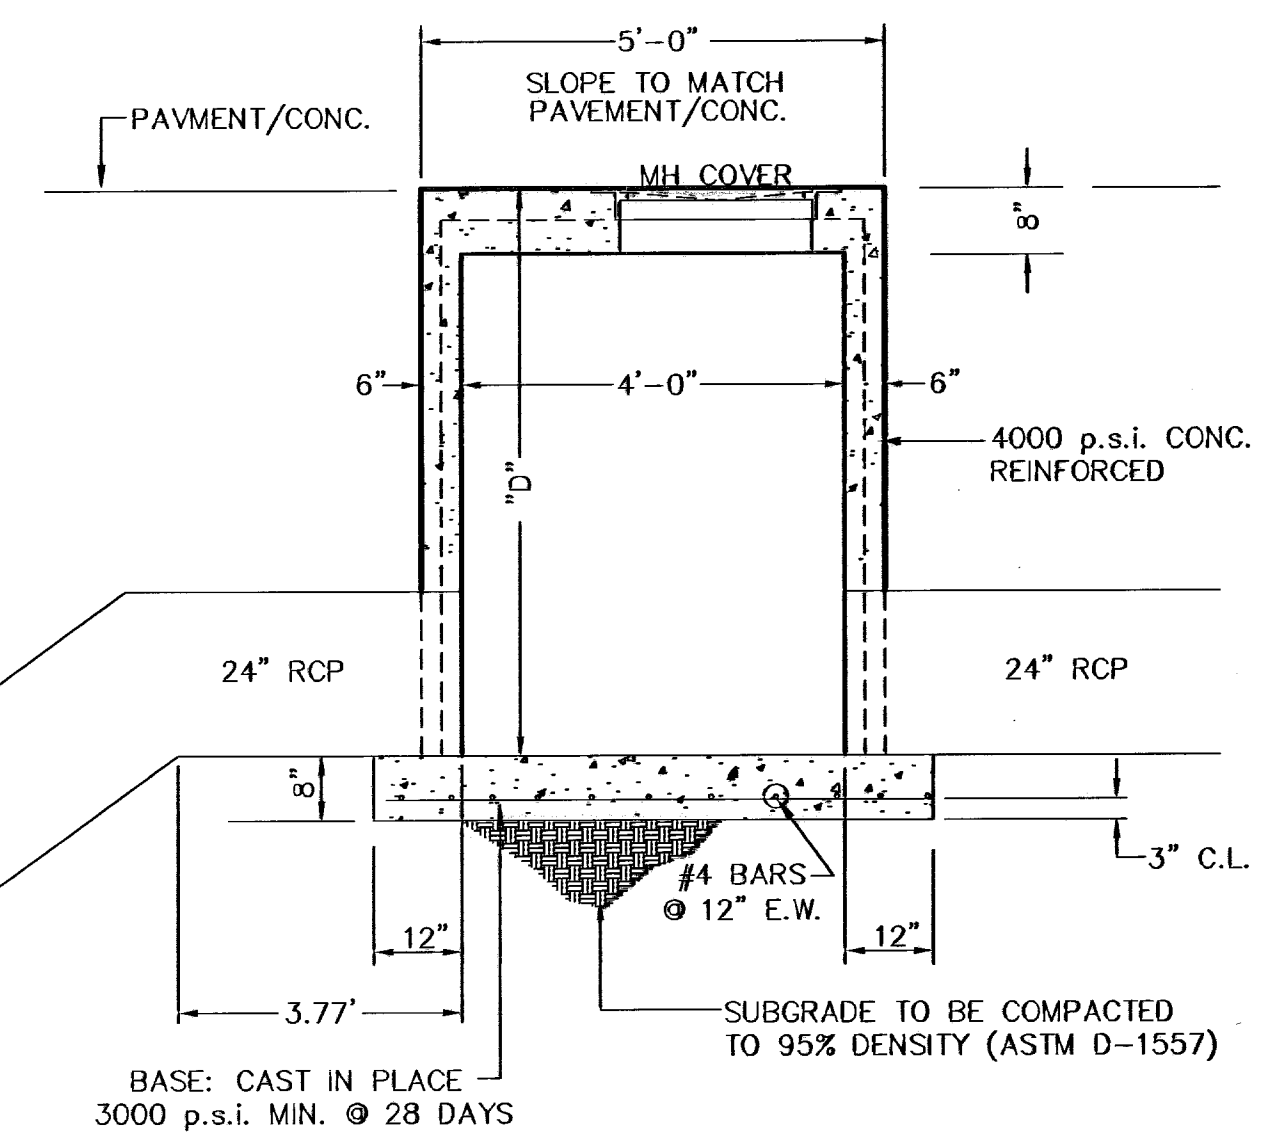


SECTION C-C

MH#	RIM	INVERT	DEPTH (D)	PIPE
1	4240.04	4229.64	10.4'	24" RCP


PRECAST CIRCULAR CONC. MANHOLE DETAILS
N.T.S.

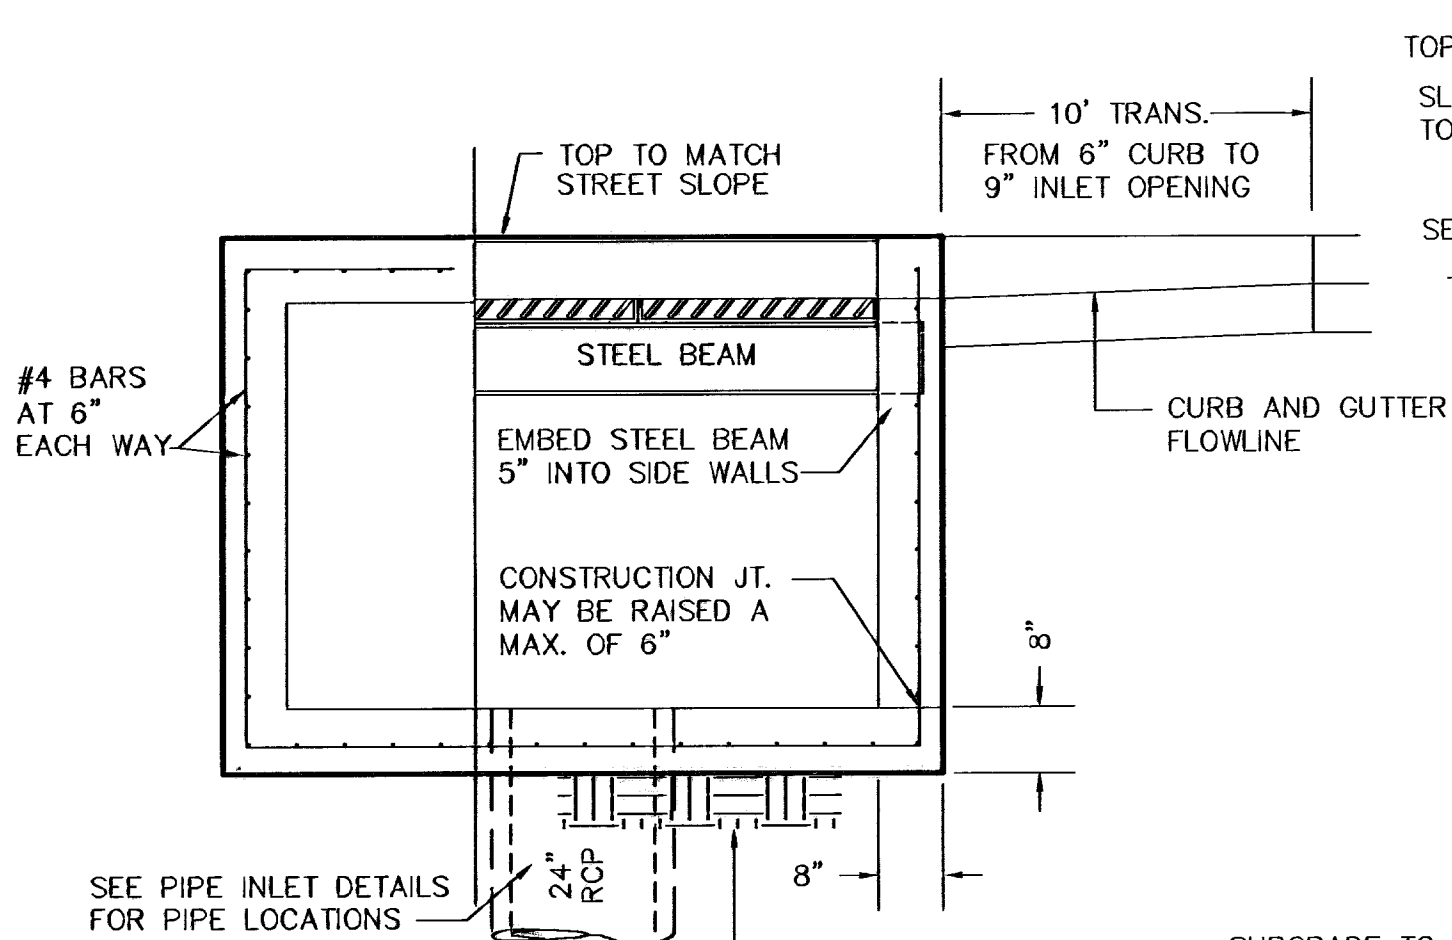


SECTION A-A INLETS 1 AND 2

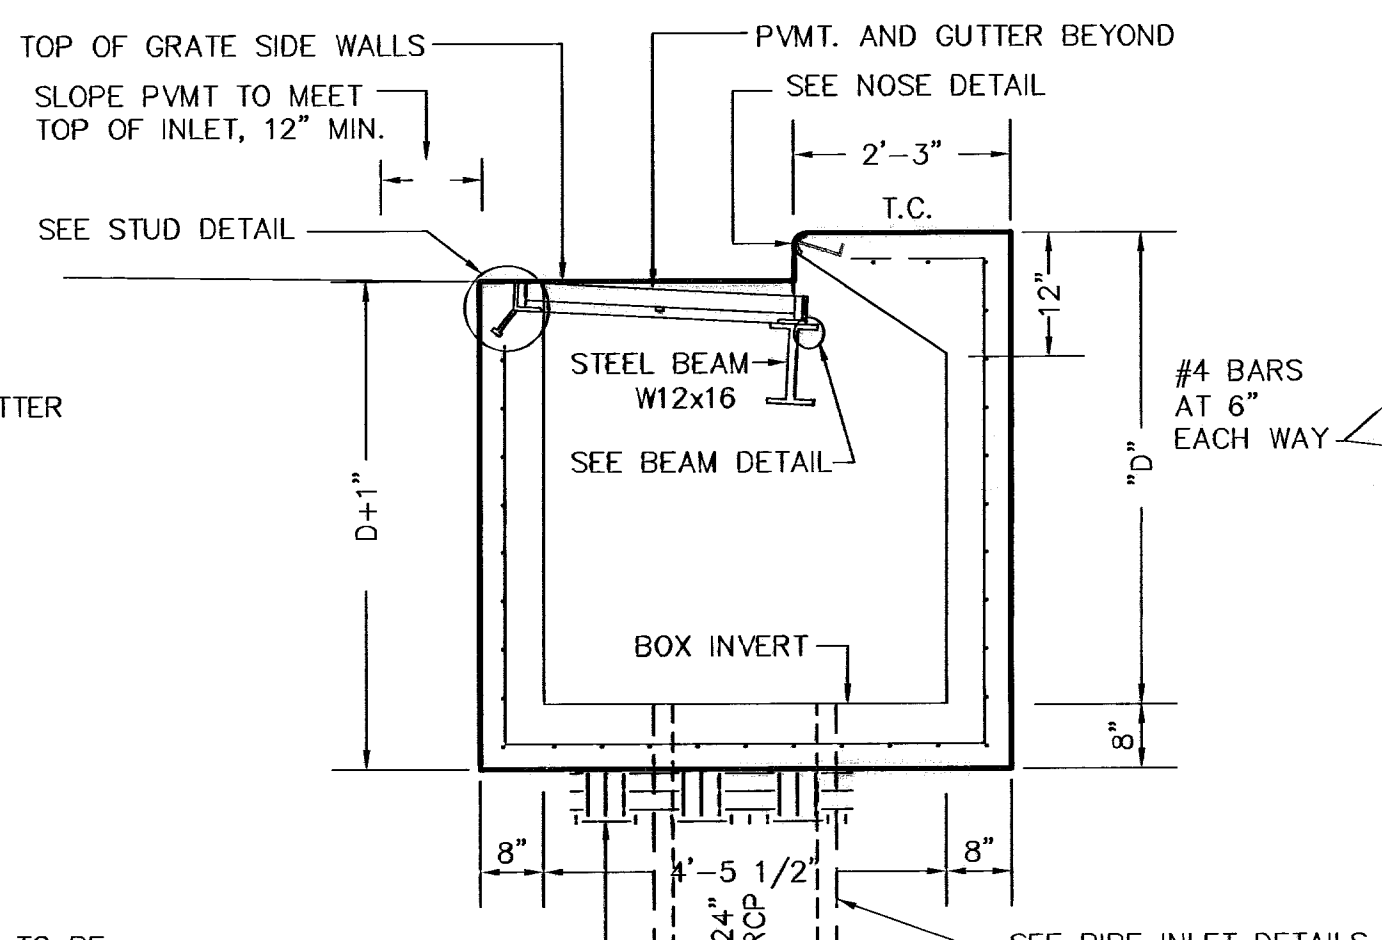

SECTION B-B INLETS 1 AND 2

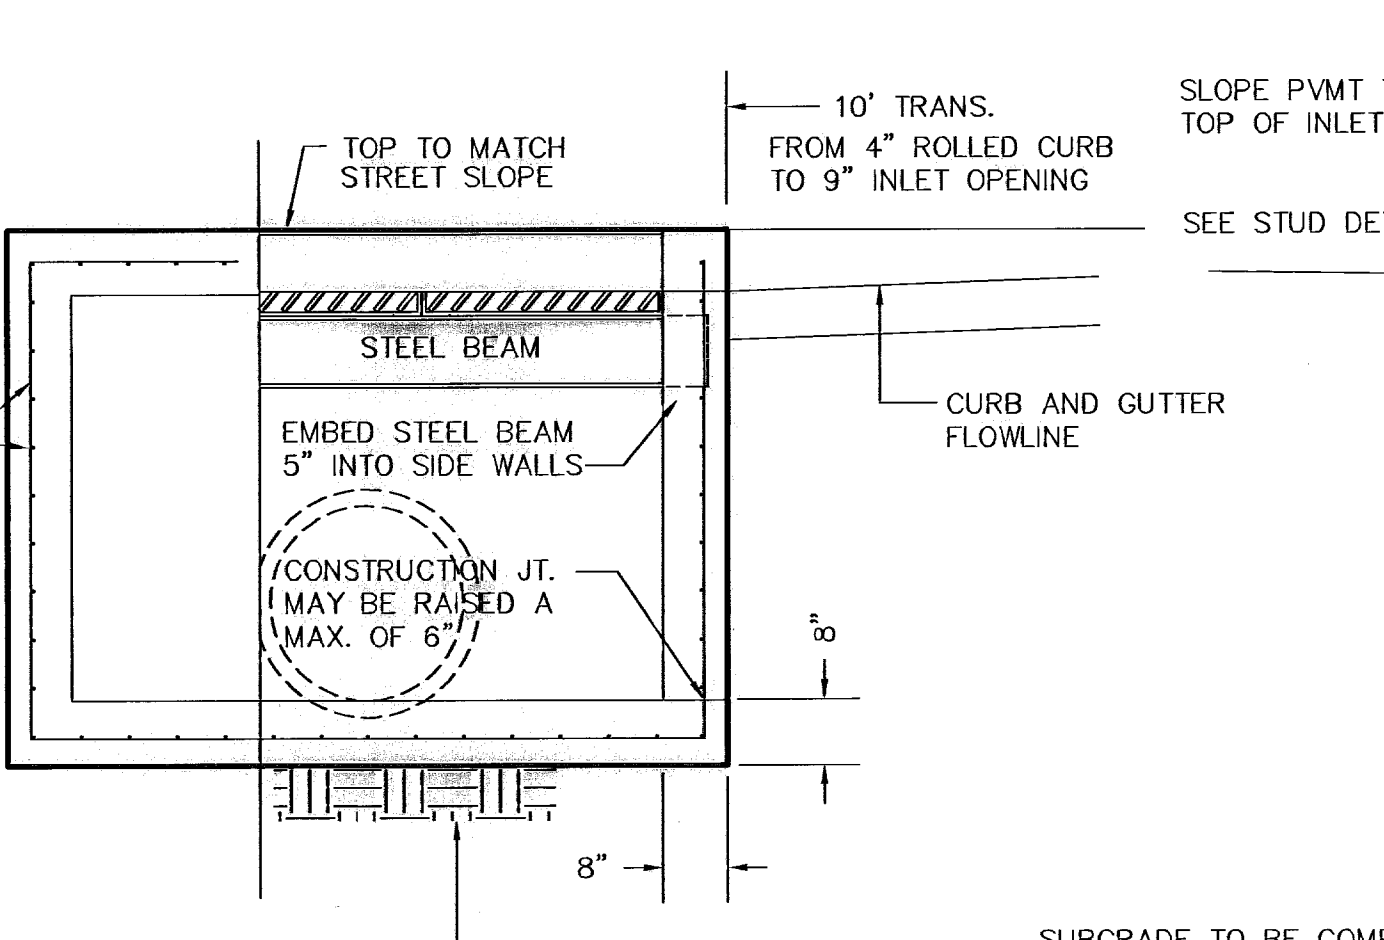


SECTION A-A INLET 3

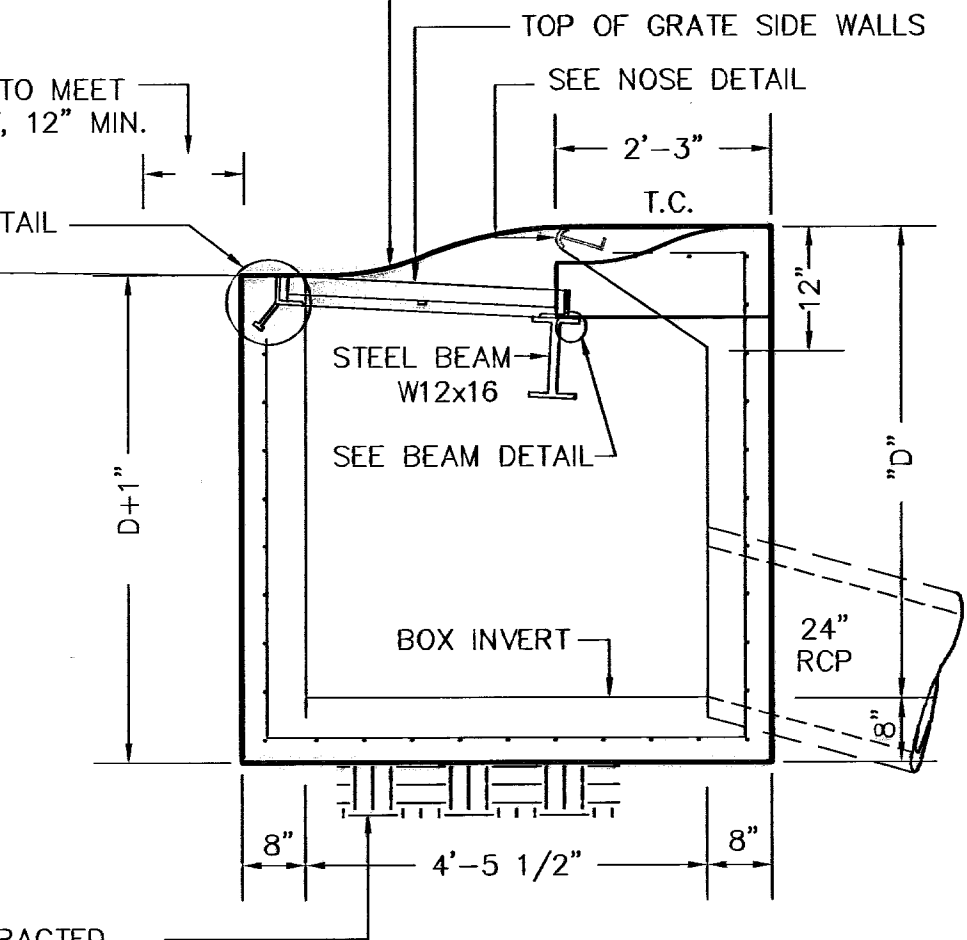

SECTION B-B INLET 3

TYPICAL CAST-IN-PLACE CONC. COMBINATION CURB AND GRATE INLET TYPE I
N.T.S.

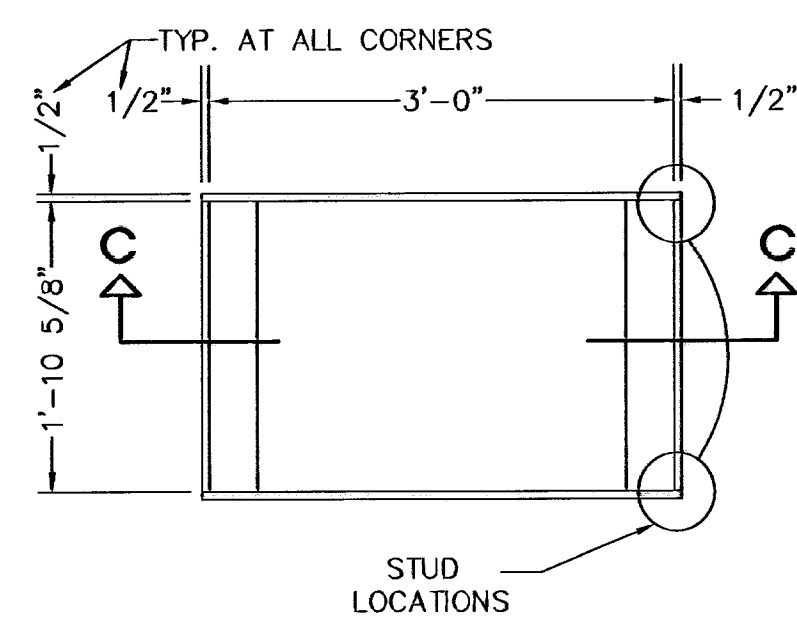


SECTION C-C

CAPACITY PER GRATE
Q = CA √2GH
Q = (0.70)(3.12) √(2)(32.2)(0.5)
Q = (12.39)(0.50) = 6.20 cfs


CAPACITY FOR CURB OPENING (PER GRATE)
Q = 3.087 L (H)^{3/2}
Q = (3.087)(1.88)(0.5)^{3/2} = 2.05 cfs

TOTAL CAPACITY FOR CURB OPENING + PER GRATE
Q = 6.20 + 2.05 = 8.05 cfs

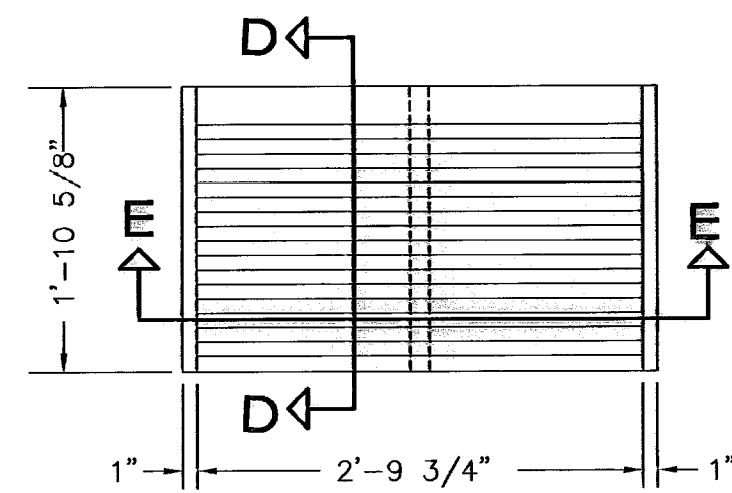



SECTION D-D

FRAME AND GRATE DETAILS
N.T.S.

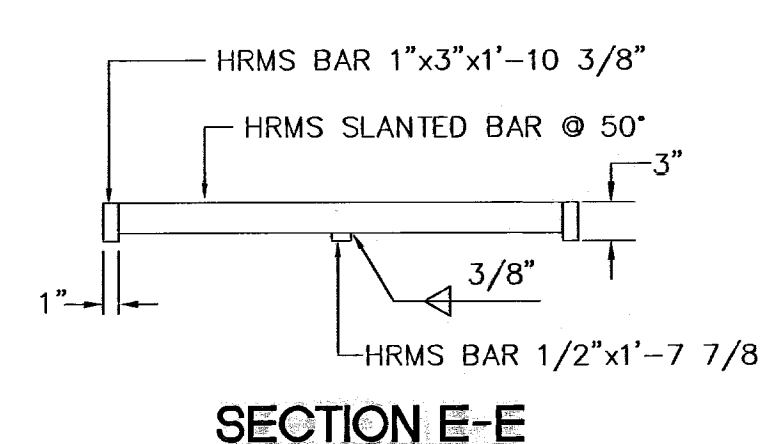


SECTION E-E

SLANTED BAR DETAIL

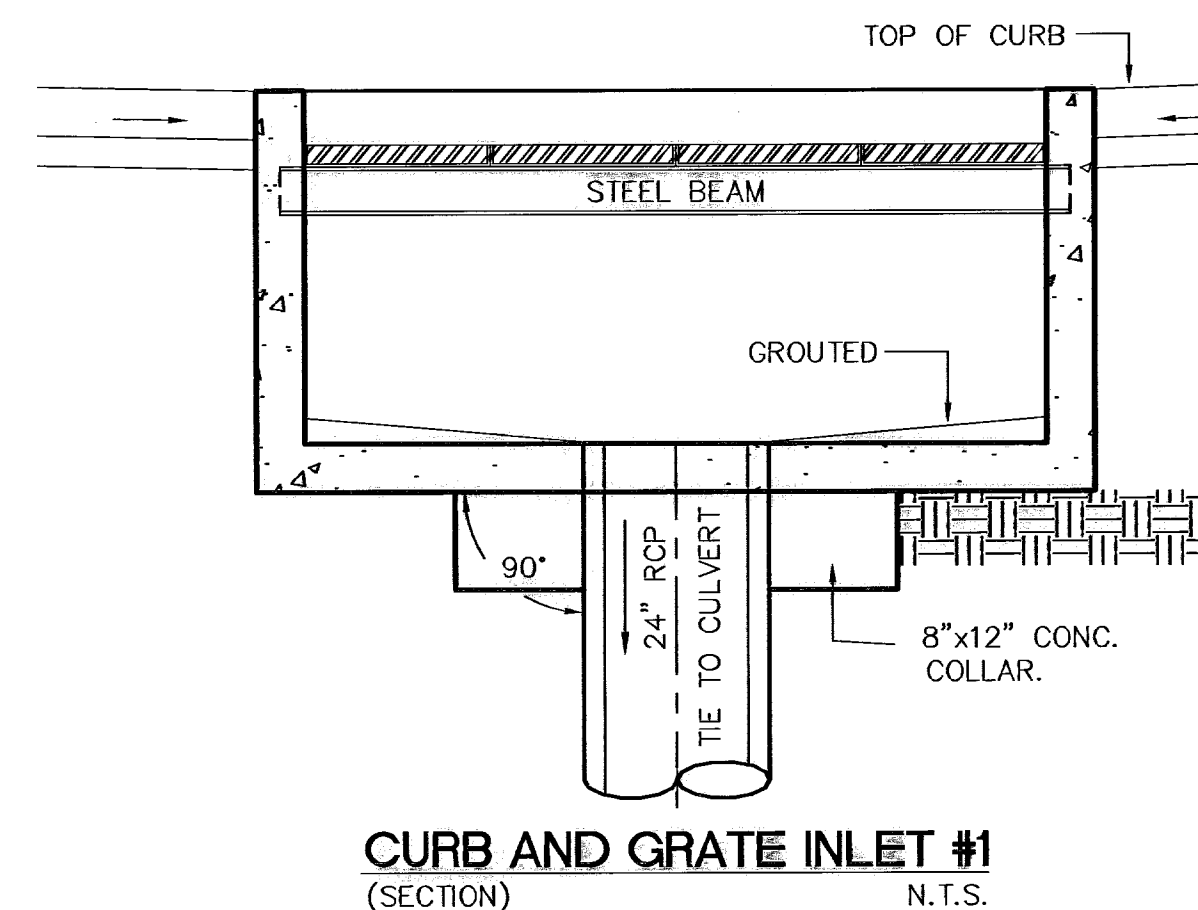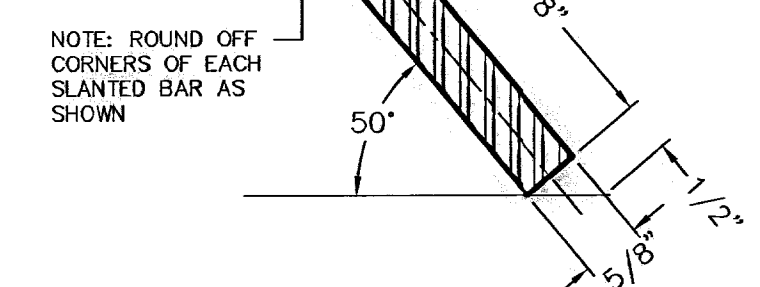

CURB AND GRATE INLET #1 (SECTION)
N.T.S.











PIPE INLET DETAILS
N.T.S.

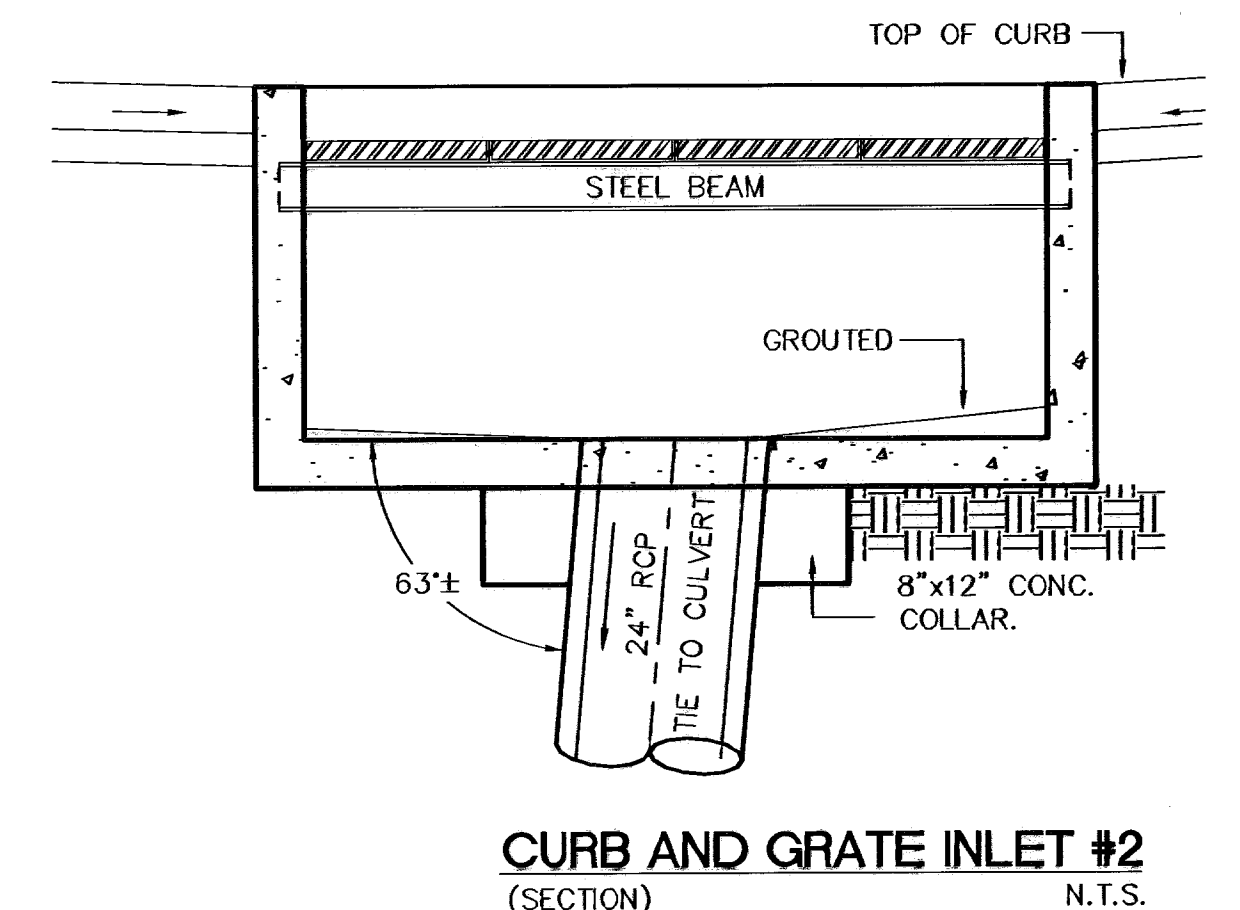

CURB AND GRATE INLET #2 (SECTION)
N.T.S.

F:\PROJECTS\RV-14\AS-BUILT\TUSC-STR1.dwg 6/6/2007 1:49:33 PM DTD


BENCHMARK: EXISTING CITY MONUMENT AT CENTERLINE INTERSECTION OF MAESTRO RIDGE DR. AND EXCEL RIDGE DR. ELEVATION = 4213.08 (GTY DATUM)		DATE	REVISION	DESCRIPTION	BY	SCALE: AS NOTED	TUSCANY AT RIDGEVIEW EL PASO, EL PASO COUNTY, TEXAS DRAINAGE STRUCTURE DETAILS AS-BUILT SLI ENGINEERING, INC. CIVIL ENGINEERS * LAND SURVEYORS * LAND PLANNERS 8600 WESTWIND DR. - EL PASO, TEXAS - 79912 - (915) 584-4457	
		JOB No. 09-04-2170 FIELD BOOK DESIGNED BY: E.T. COMP. BY: E.T. DRAWN BY: SRJ CHECKED BY: E.T. DATE: 08/02/05						

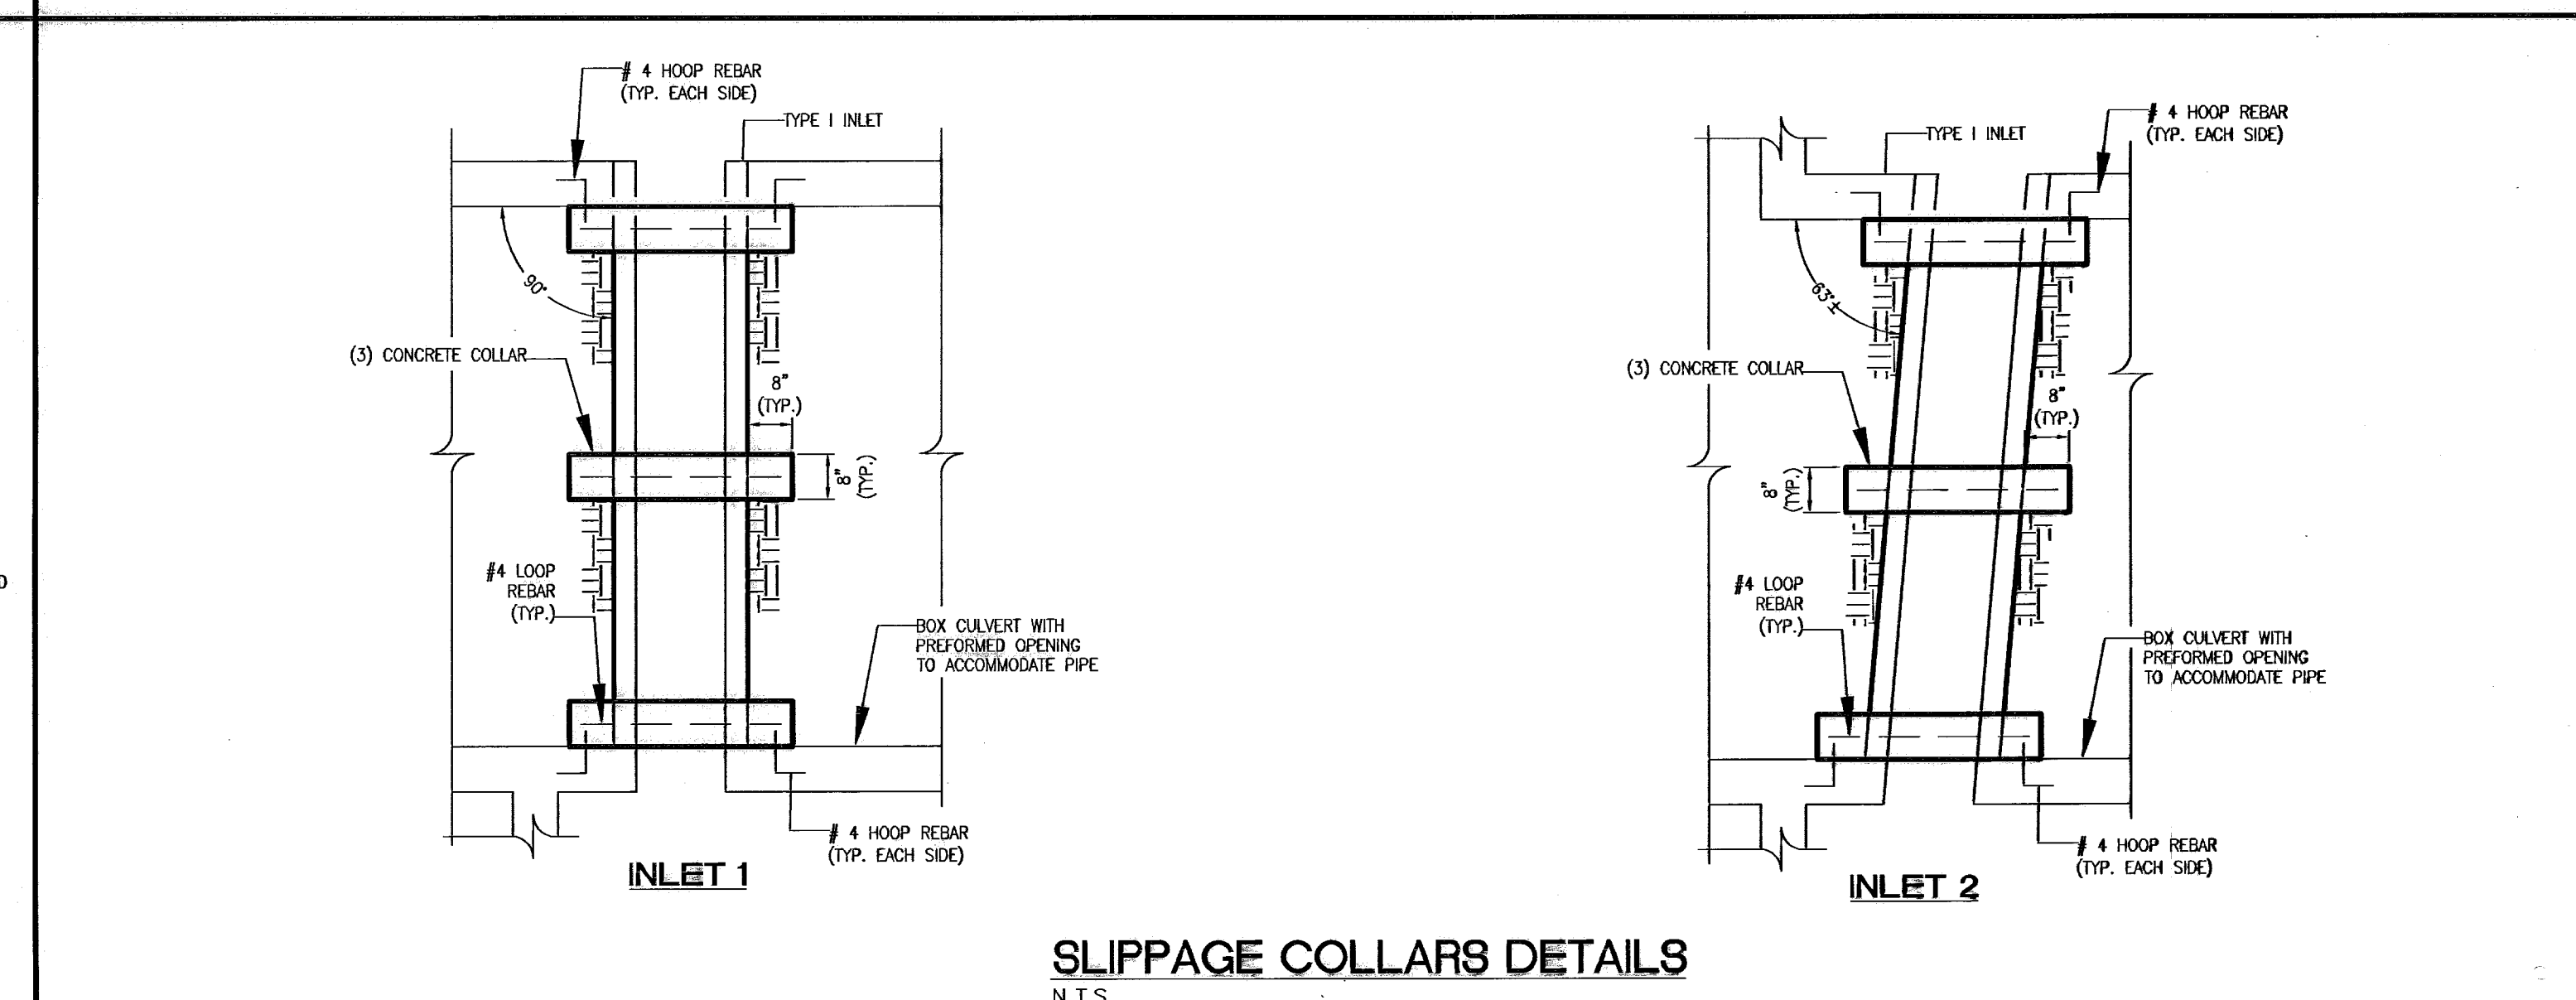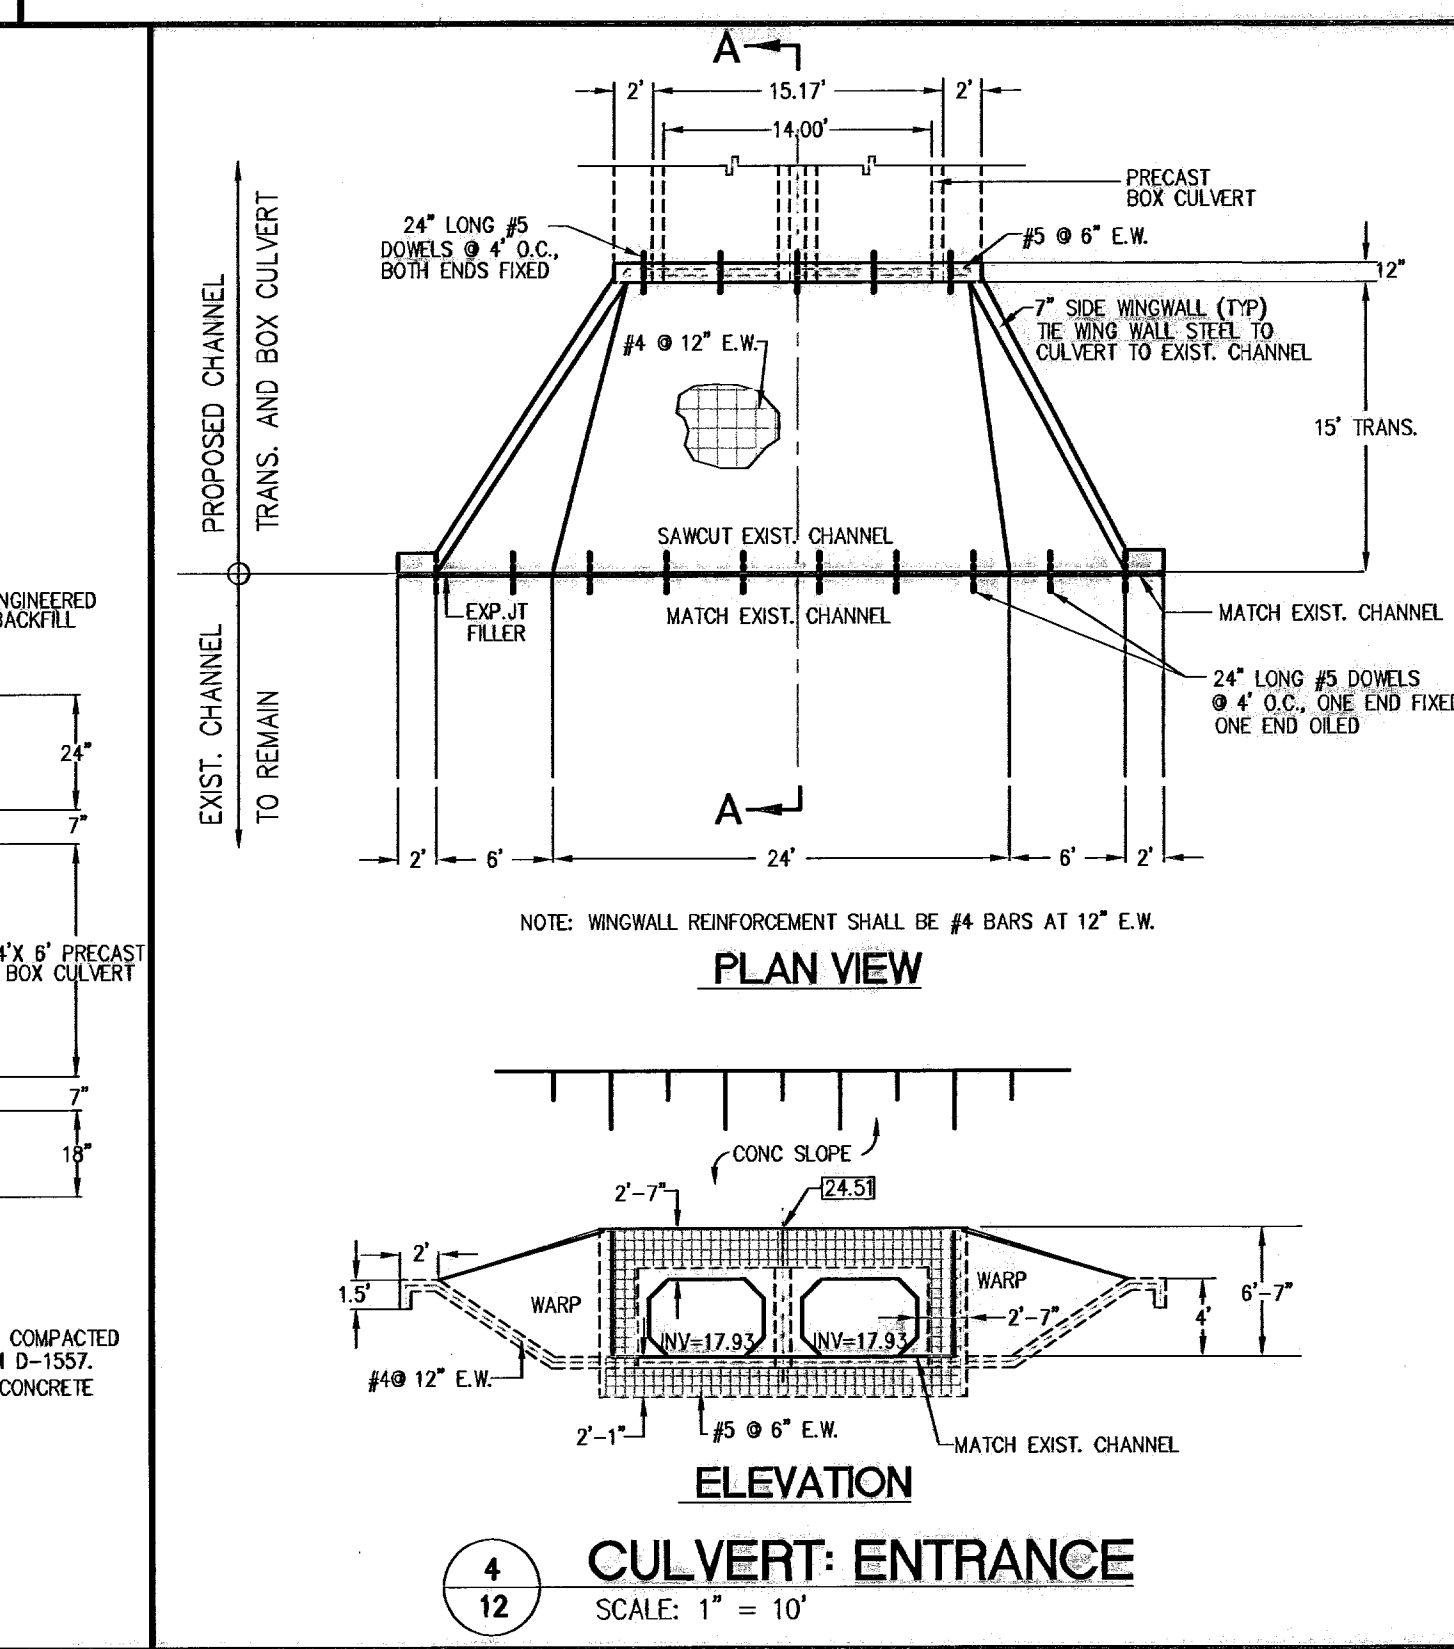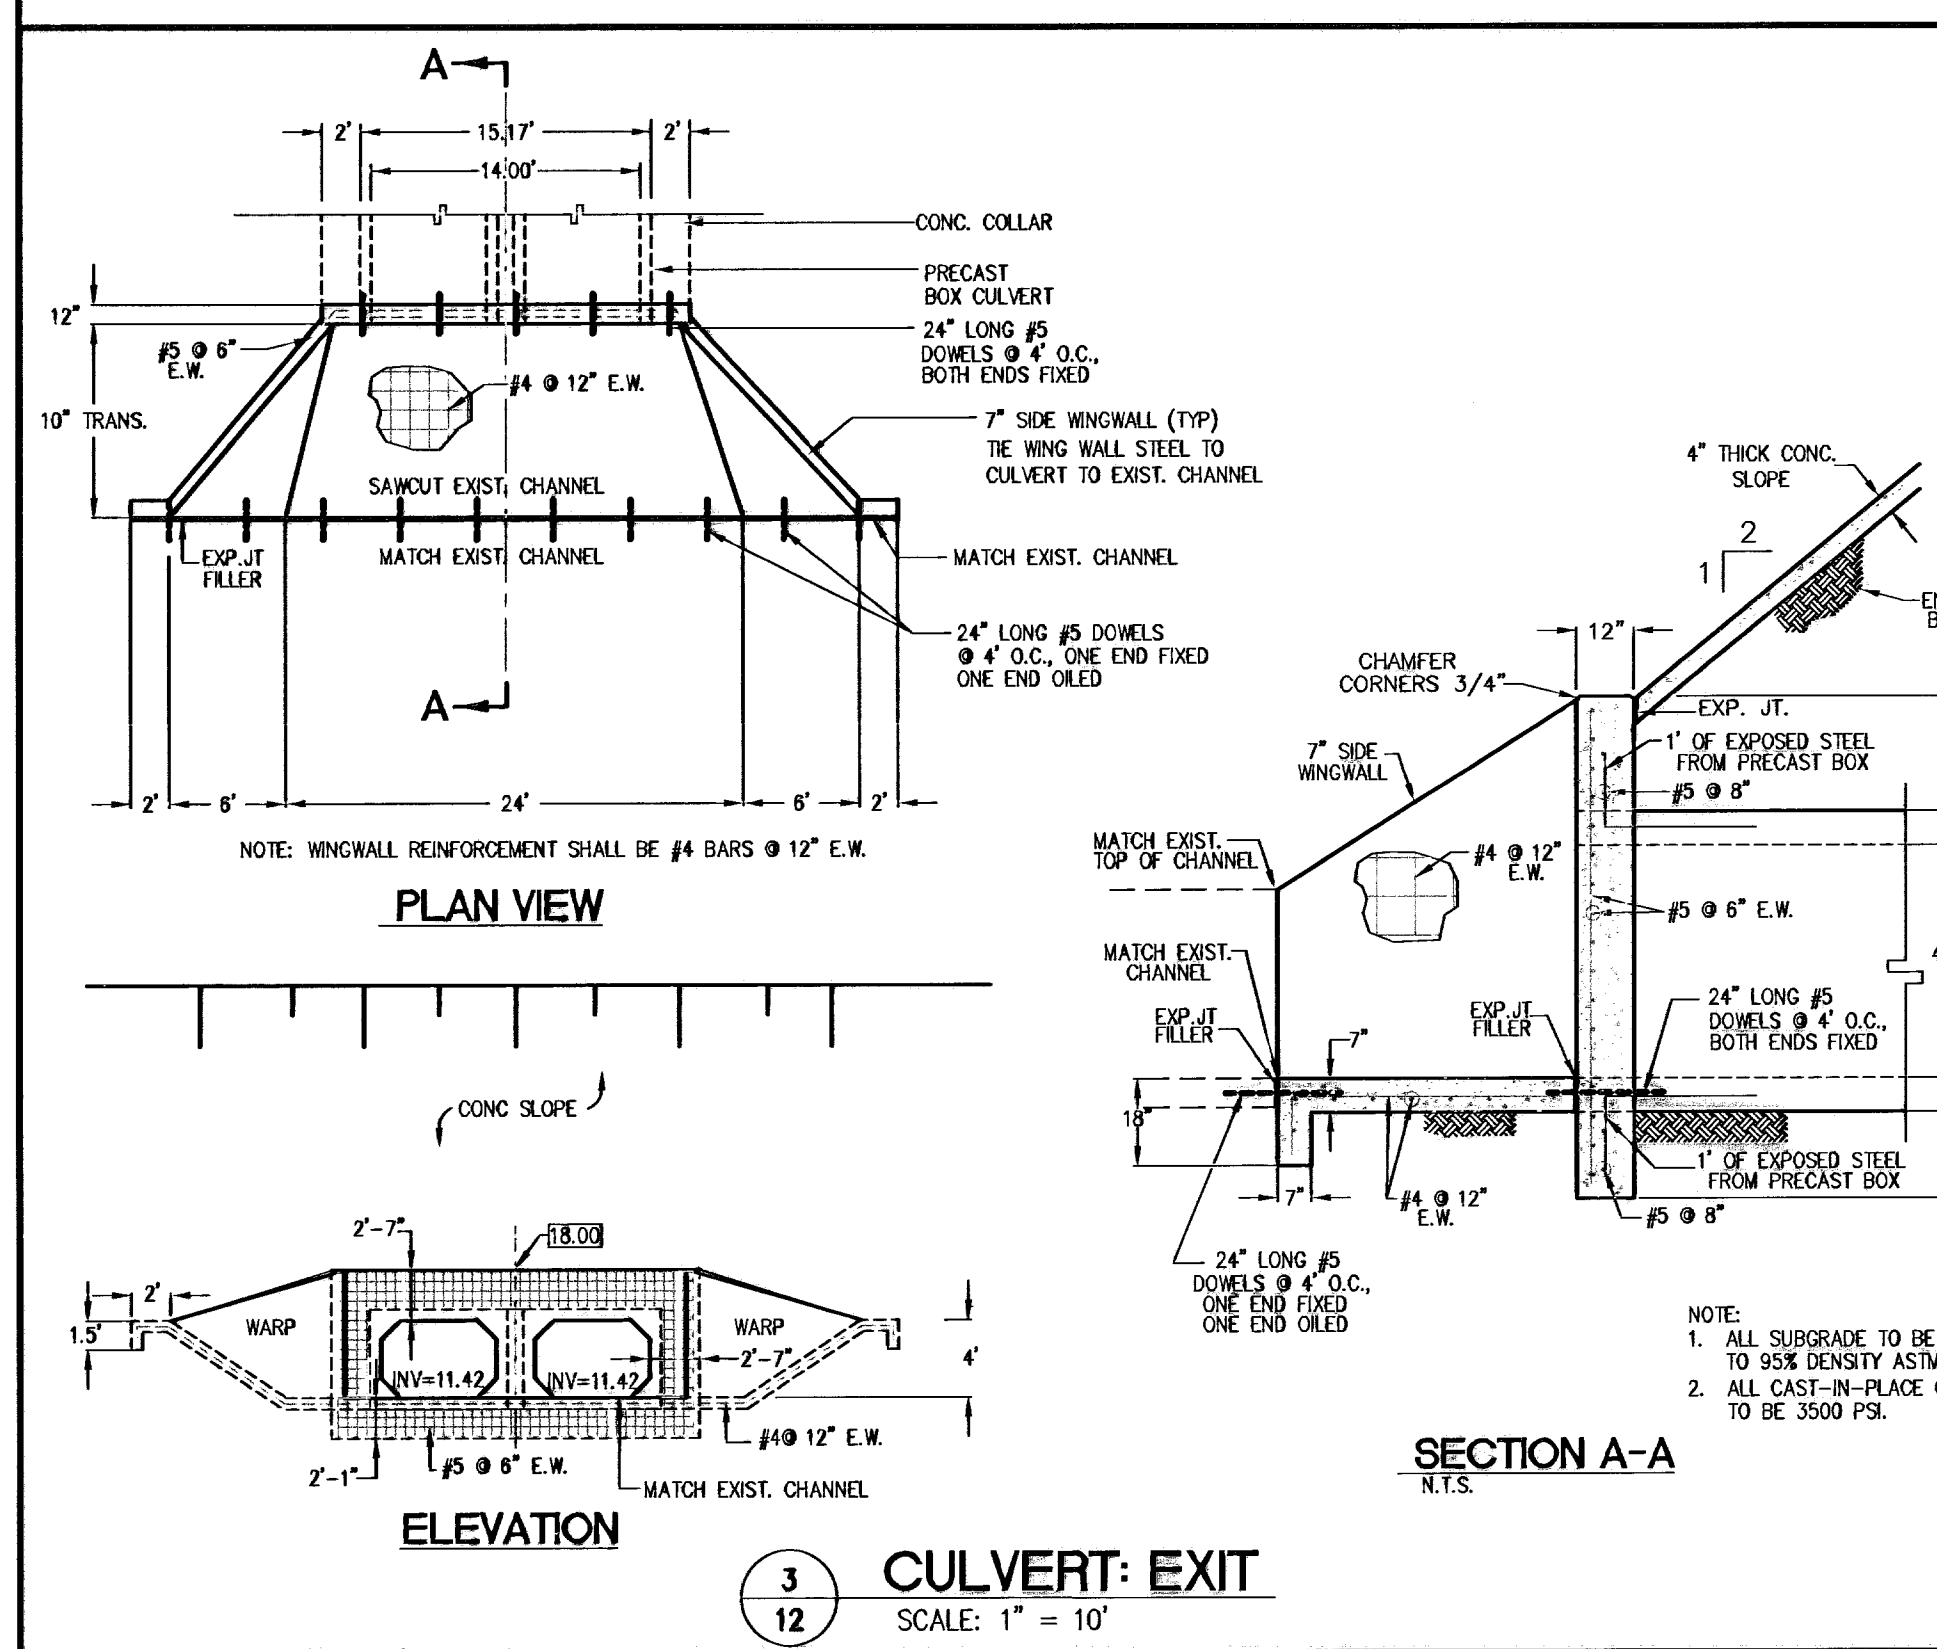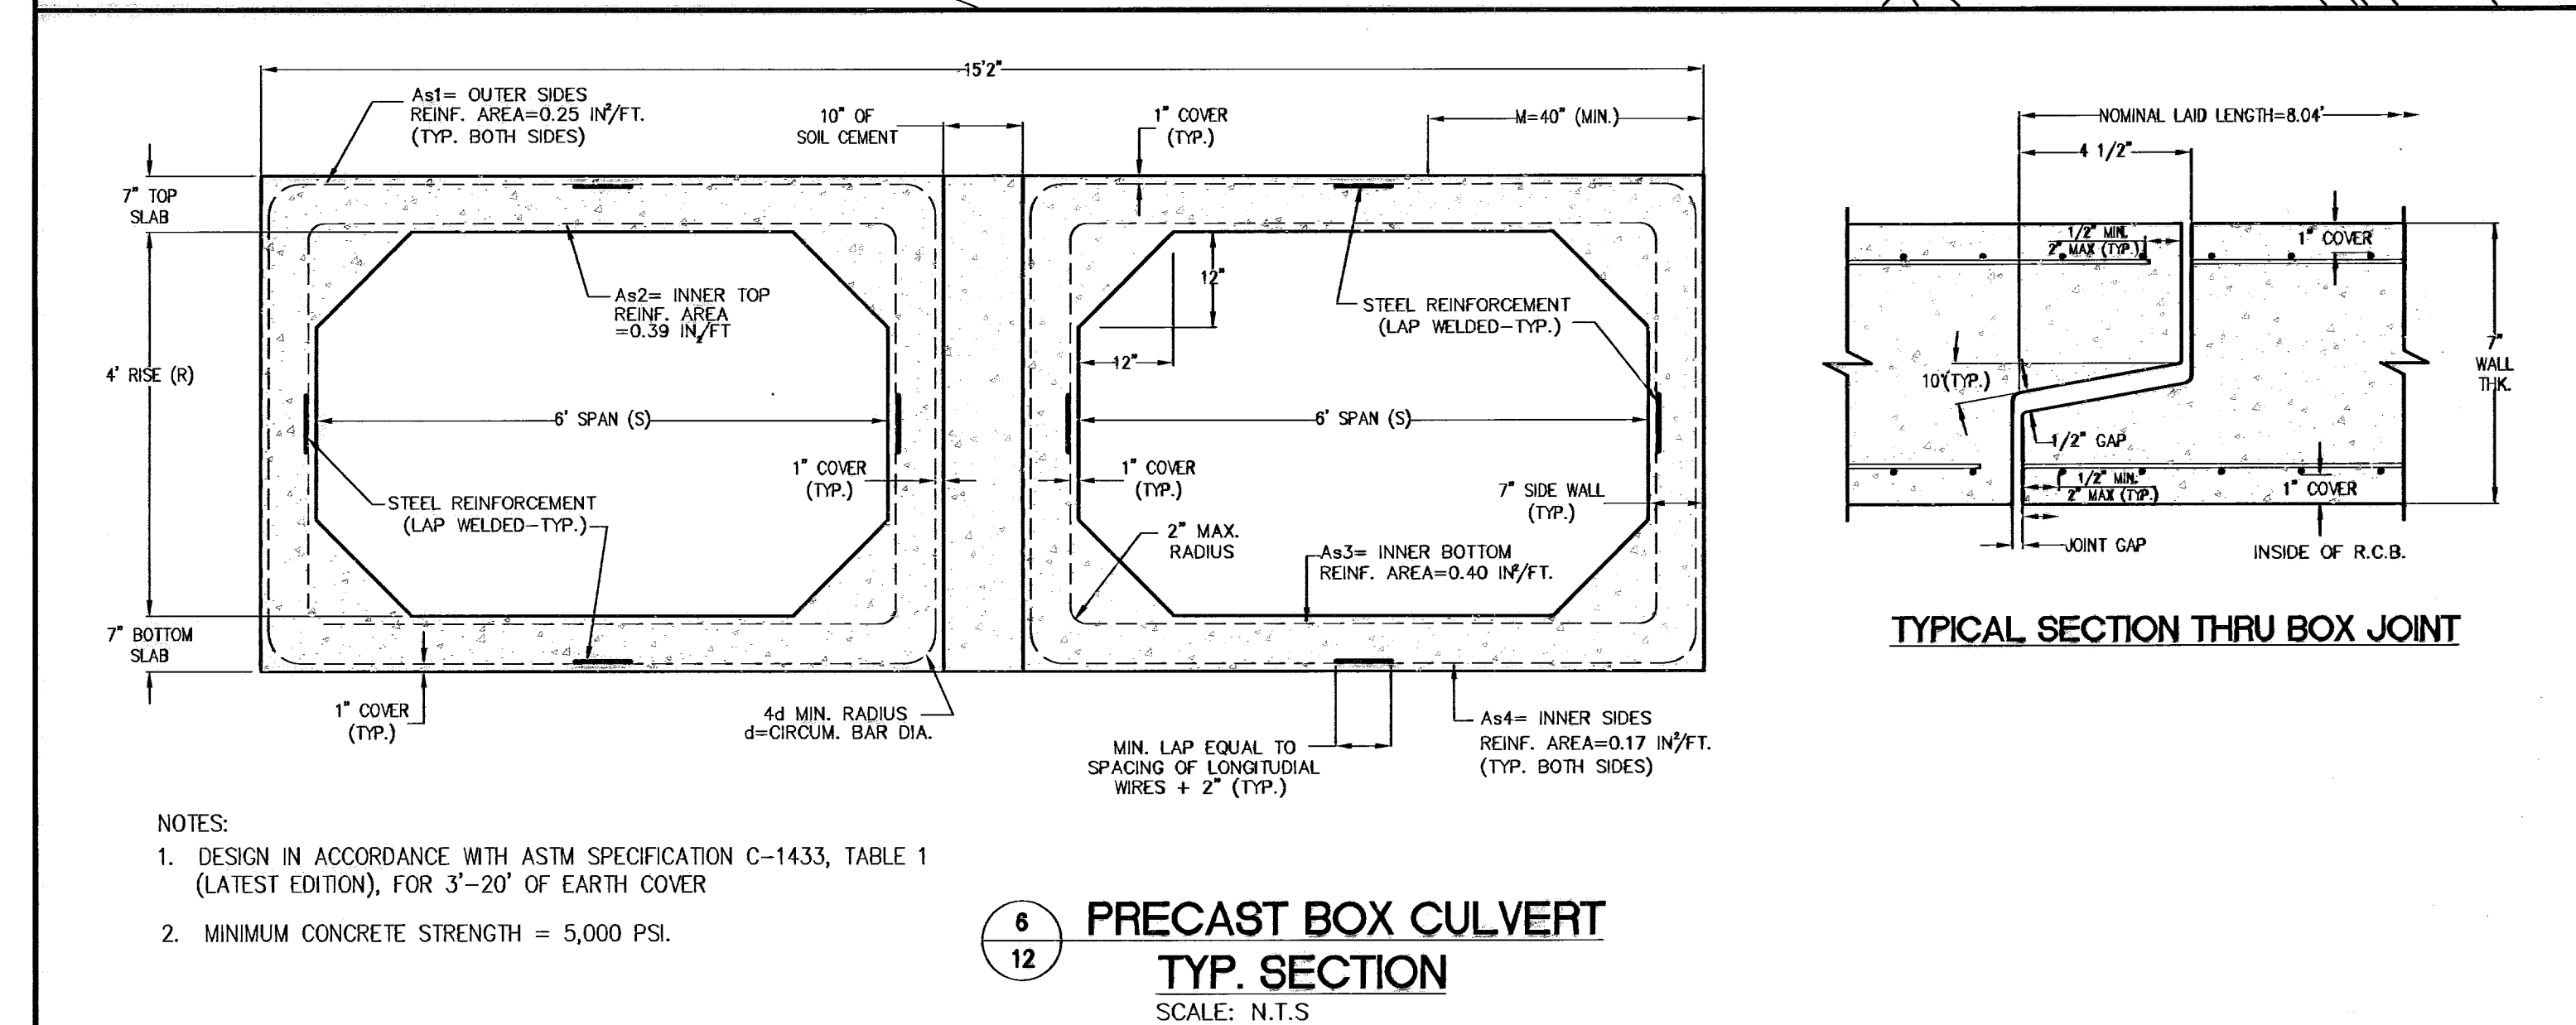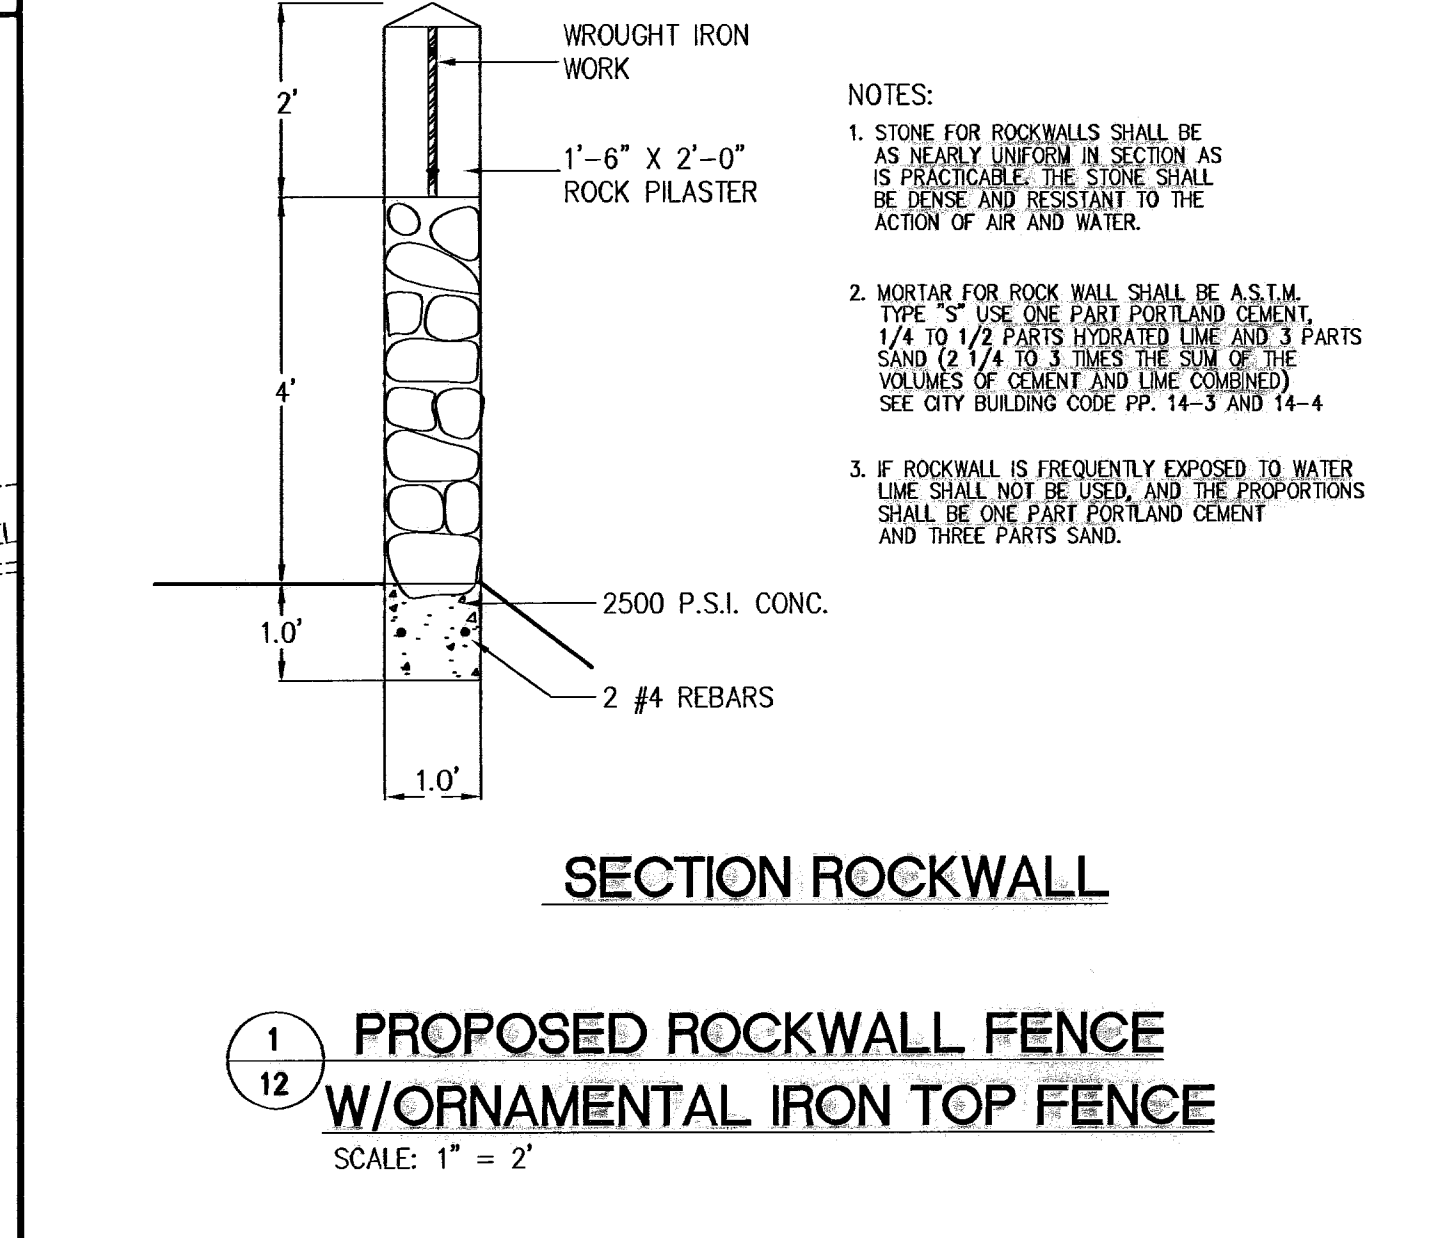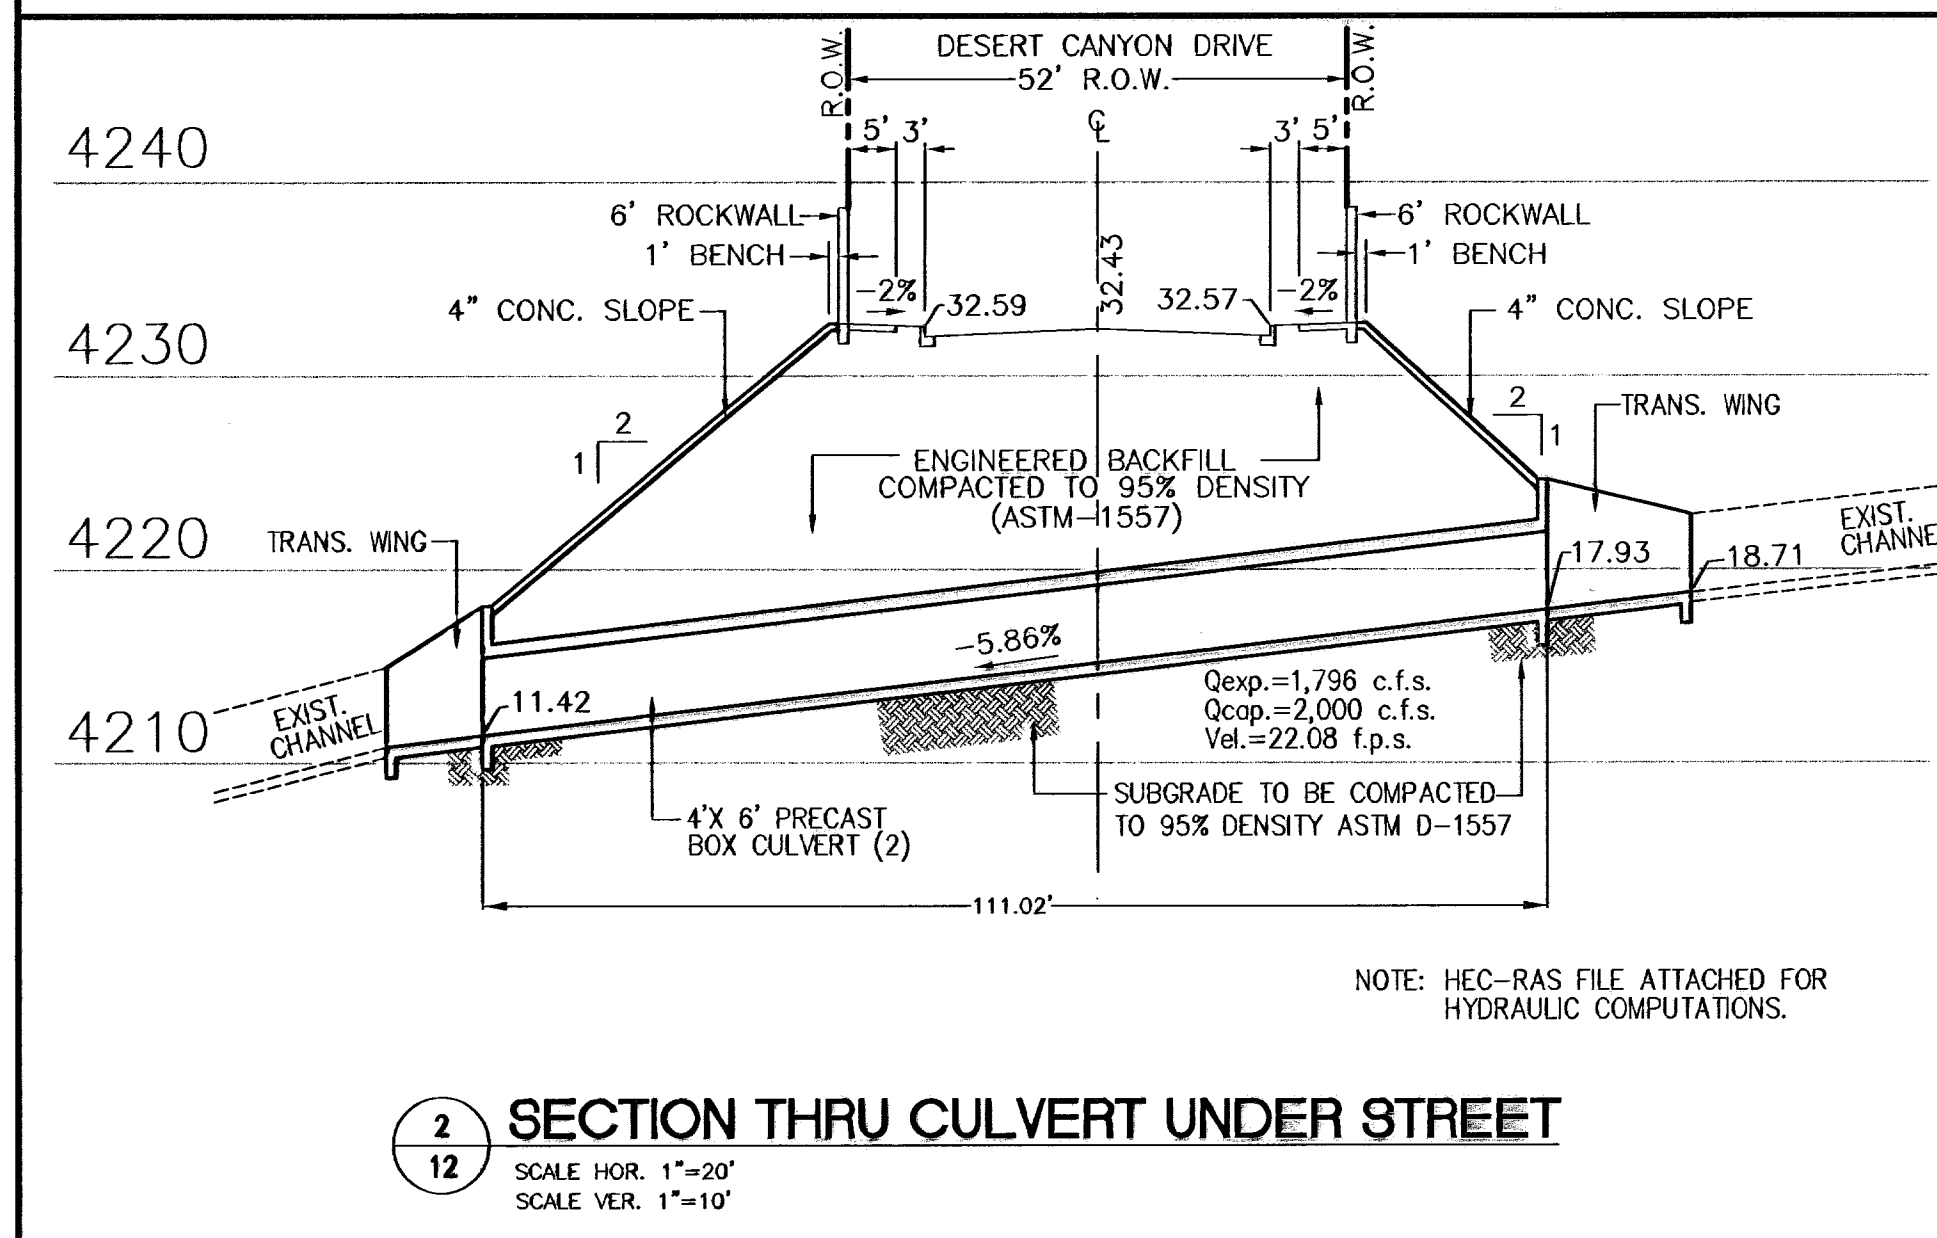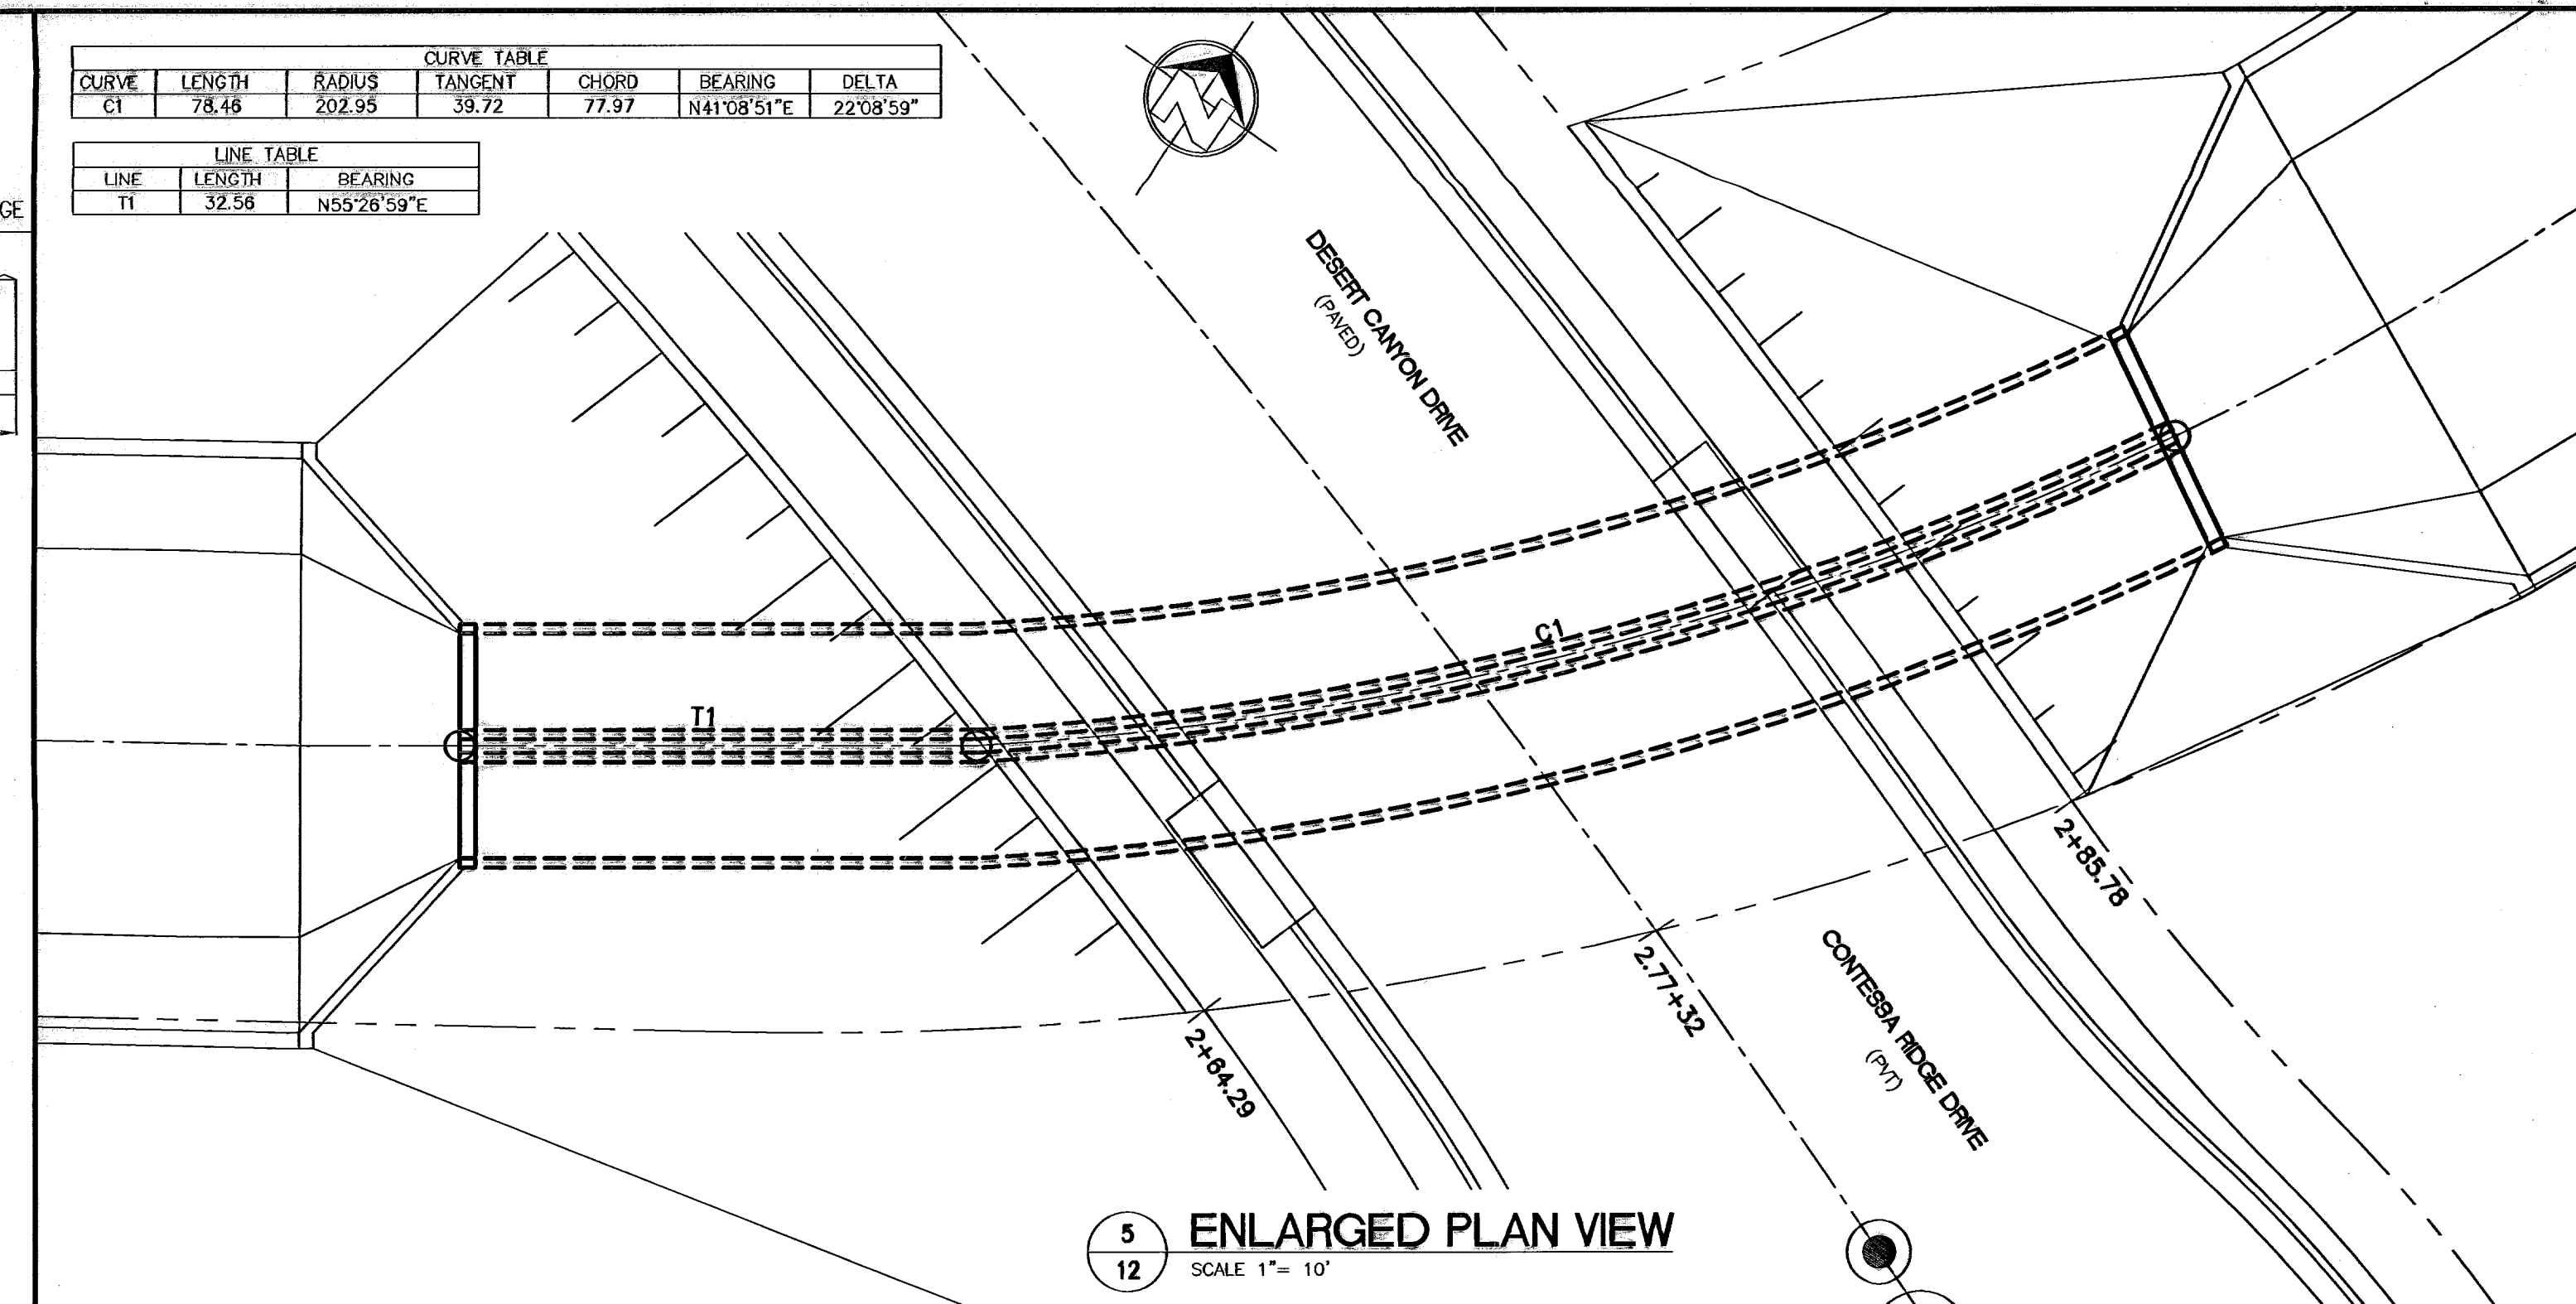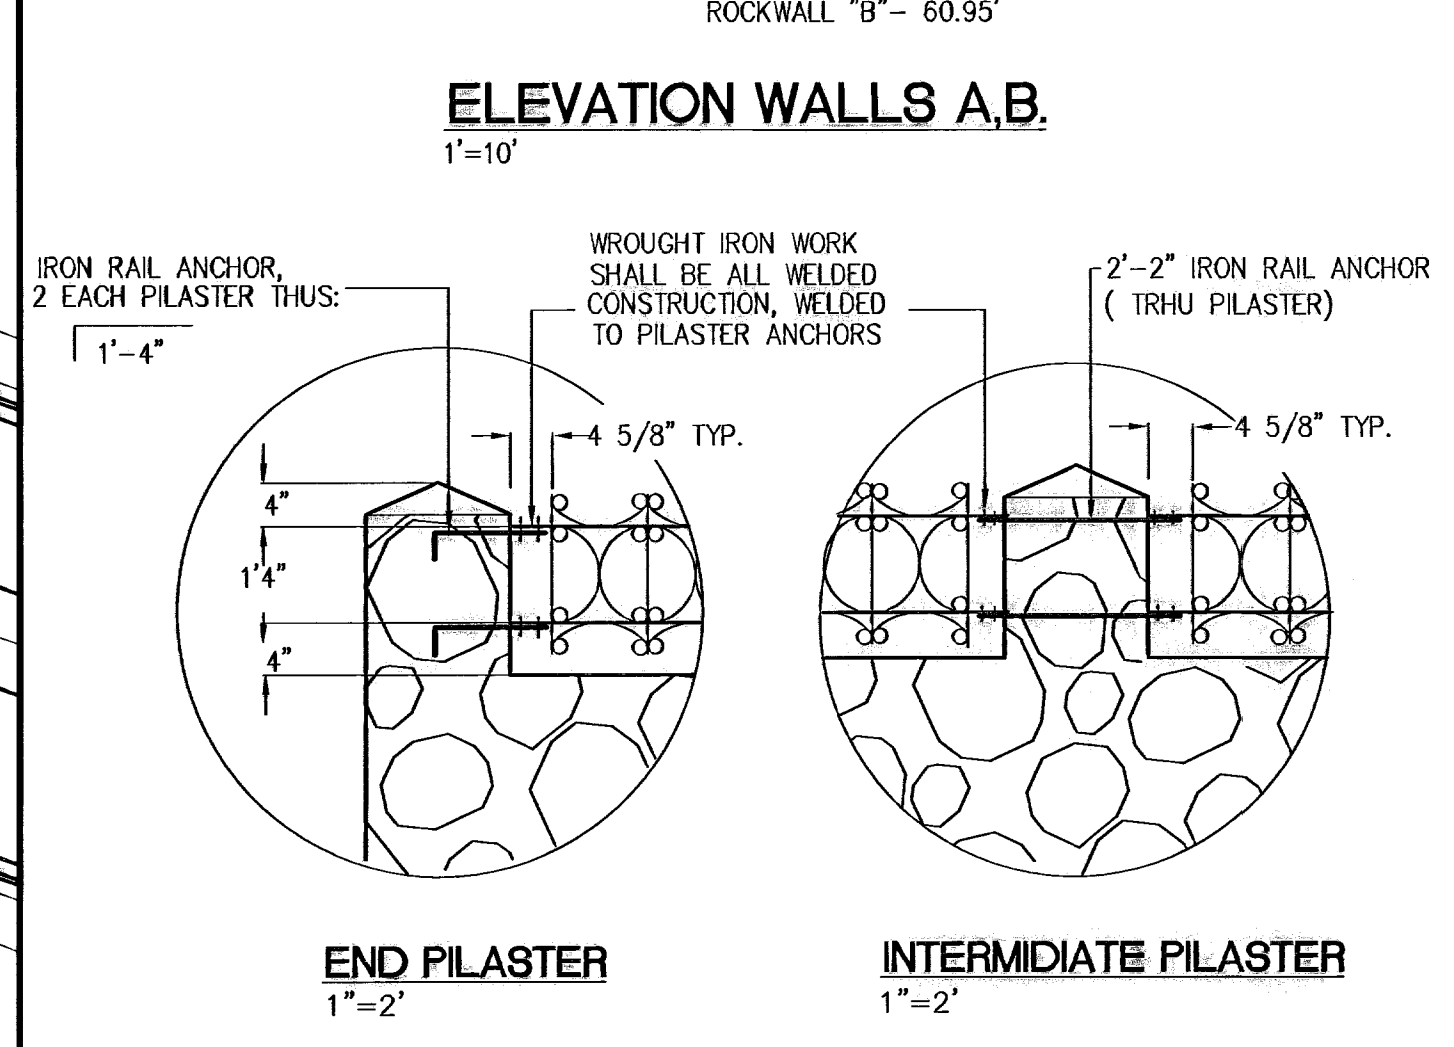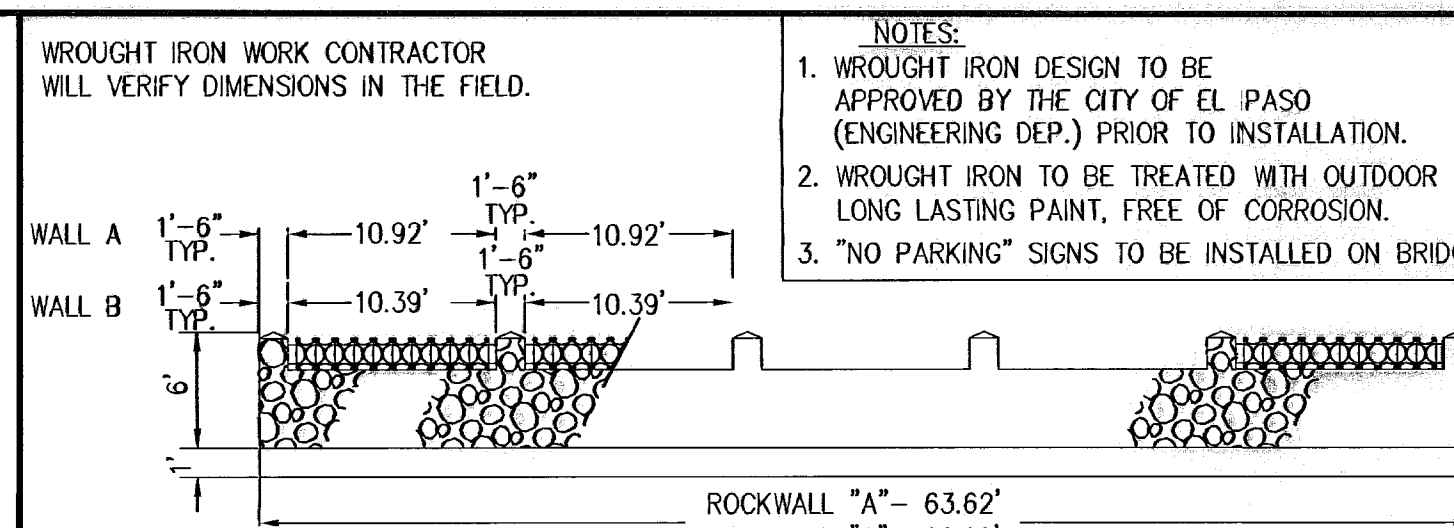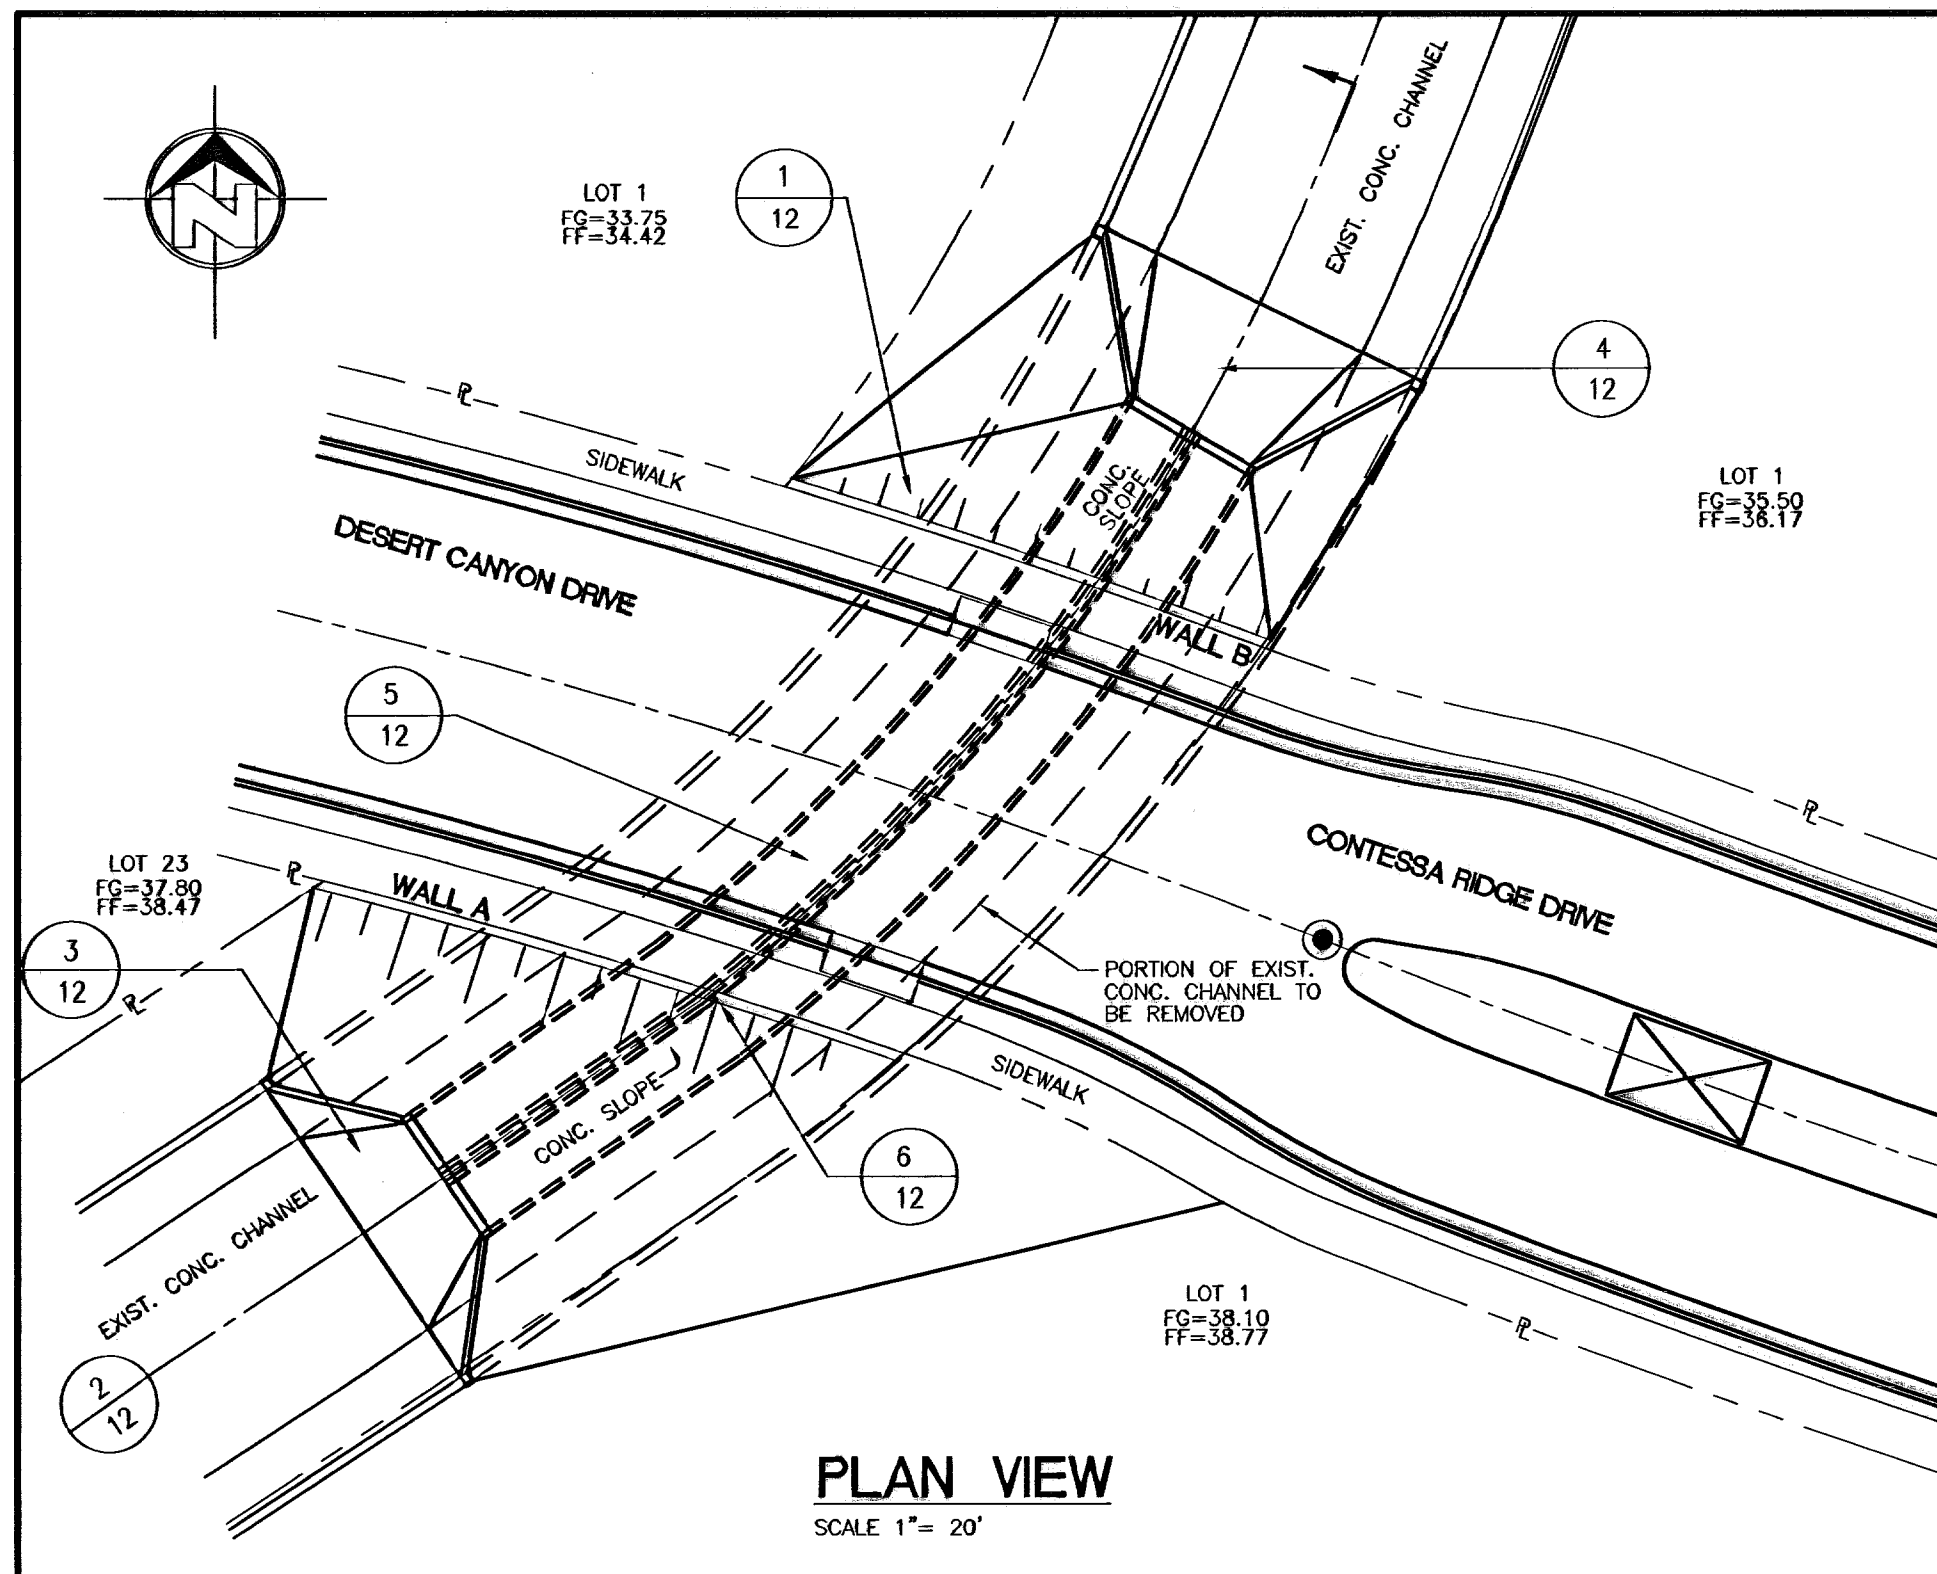

BENCHMARK: EXISTING CITY MONUMENT AT CENTERLINE INTERSECTION OF MAJESTIC RIDGE DR. AND EAGLE RIDGE DR. ELEVATION = 4213.08 (CITY DATUM)		DATE	REVISION	DESCRIPTION	BY



SCALE:	AS SHOWN
JOB No.	09-04-2170
FIELD BOOK	
DESIGNED BY:	E.T.
COMPUTED BY:	XXX
DRAWN BY:	SRJ
CHECKED BY:	E.T.
DATE:	08/17/05

TUSCANY AT RIDGEVIEW	
EL PASO, EL PASO COUNTY, TEXAS.	
BOX CULVERT DETAILS AS-BUILT	
SLI ENGINEERING, INC.	
CIVIL ENGINEERS • LAND SURVEYORS • LAND PLANNERS	
6600 WESTWIND DR. - EL PASO, TEXAS - 79912 - (915) 584-4457	

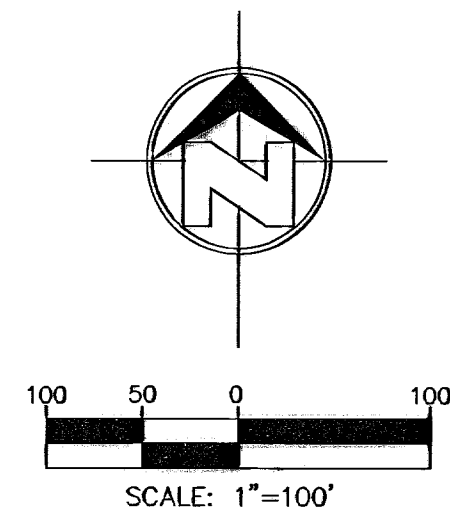


**RIDGE VIEW ESTATES
UNIT TWENTY TWO**

(MARY TIPPIN SCHOOL)

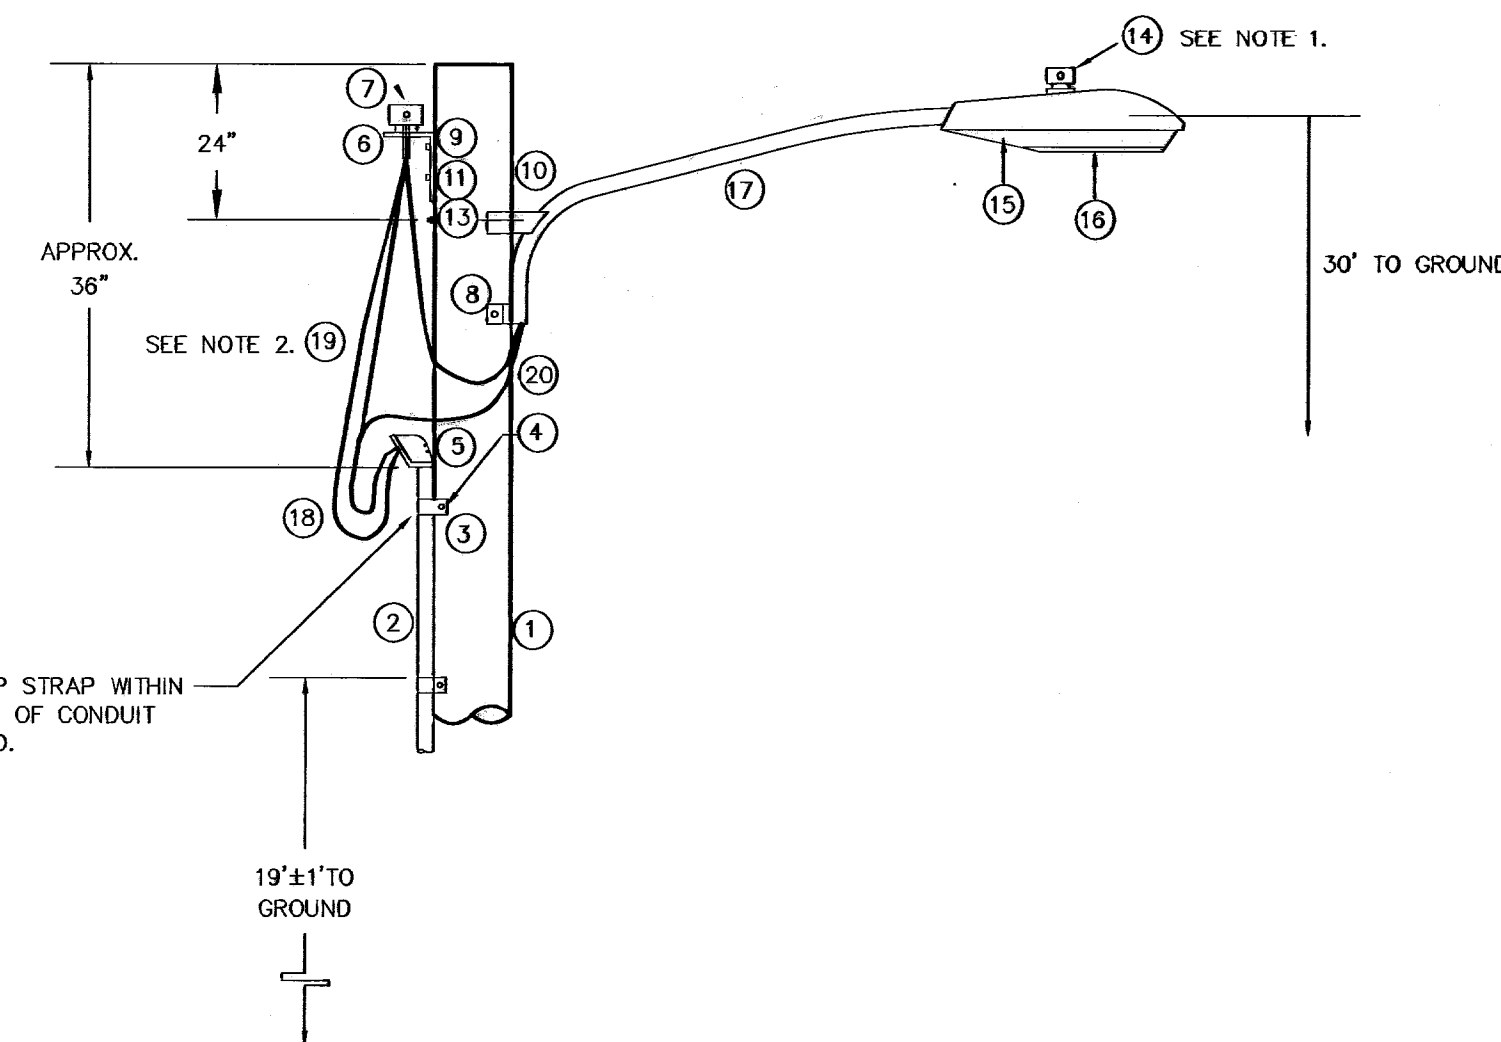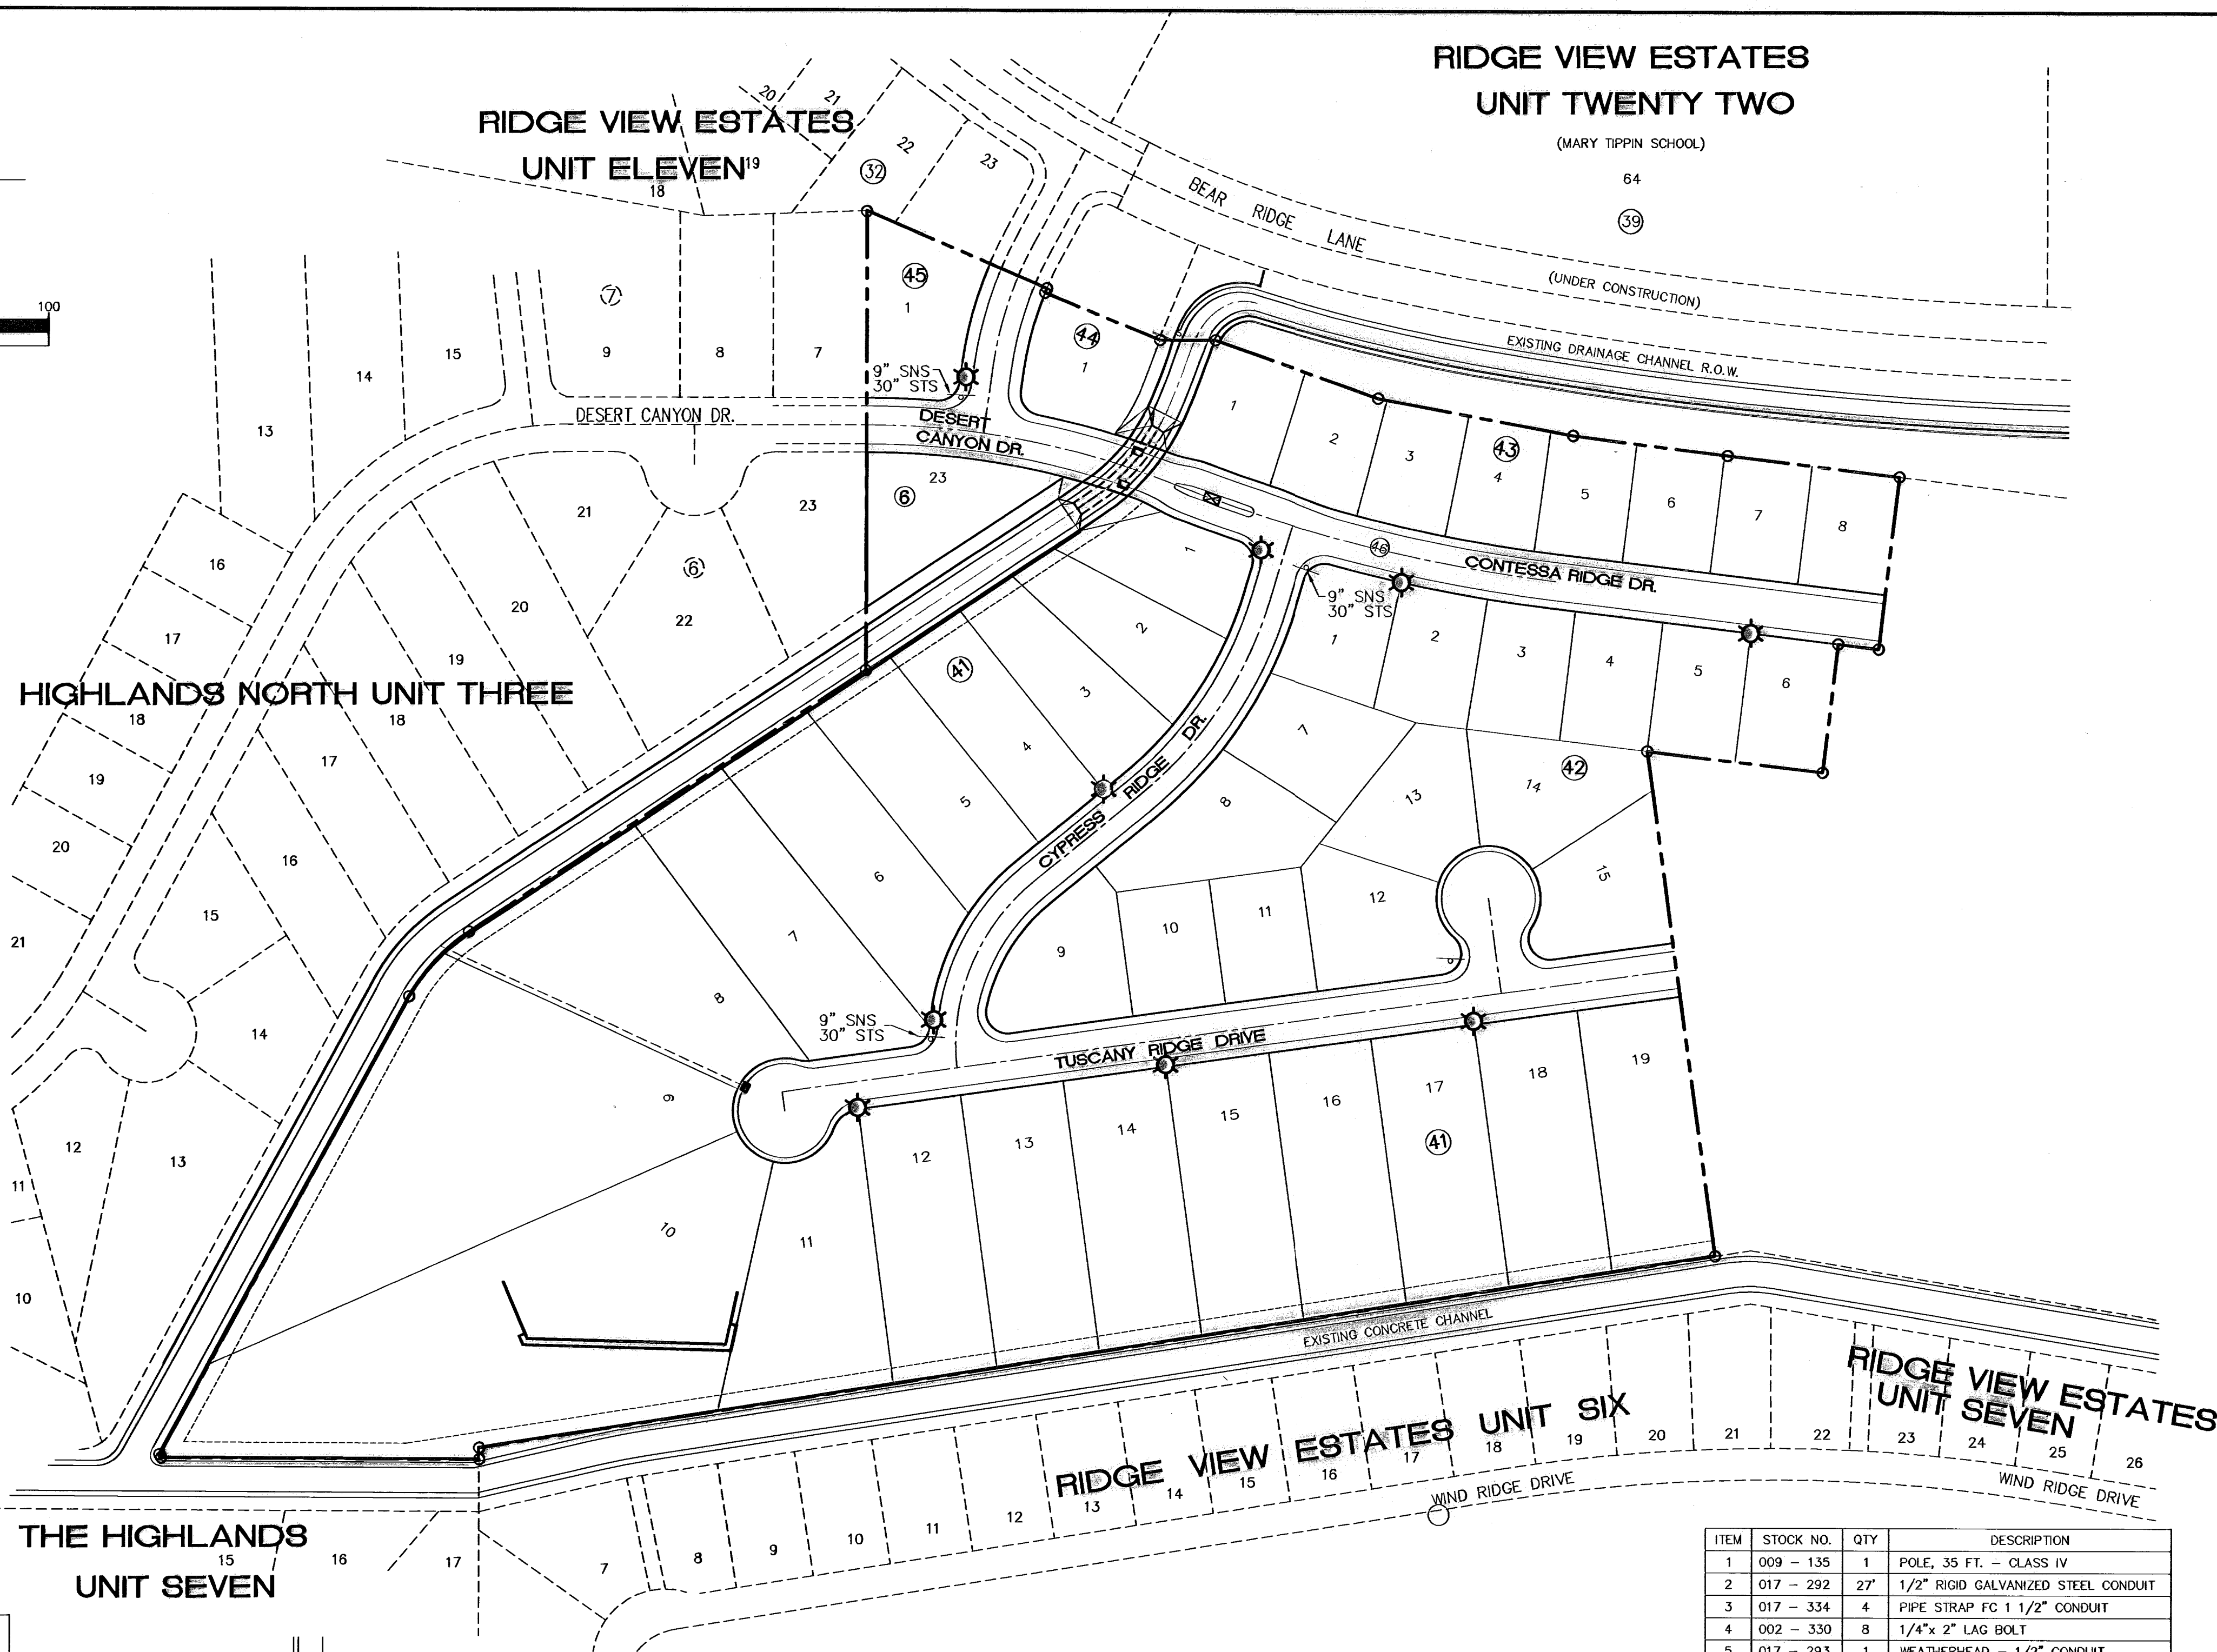


RESIDENTIAL STREET LIGHT
N.T.S.

- PROPOSED RESIDENTIAL STREET LIGHT
- PROPOSED STOP / STREET NAME SIGN

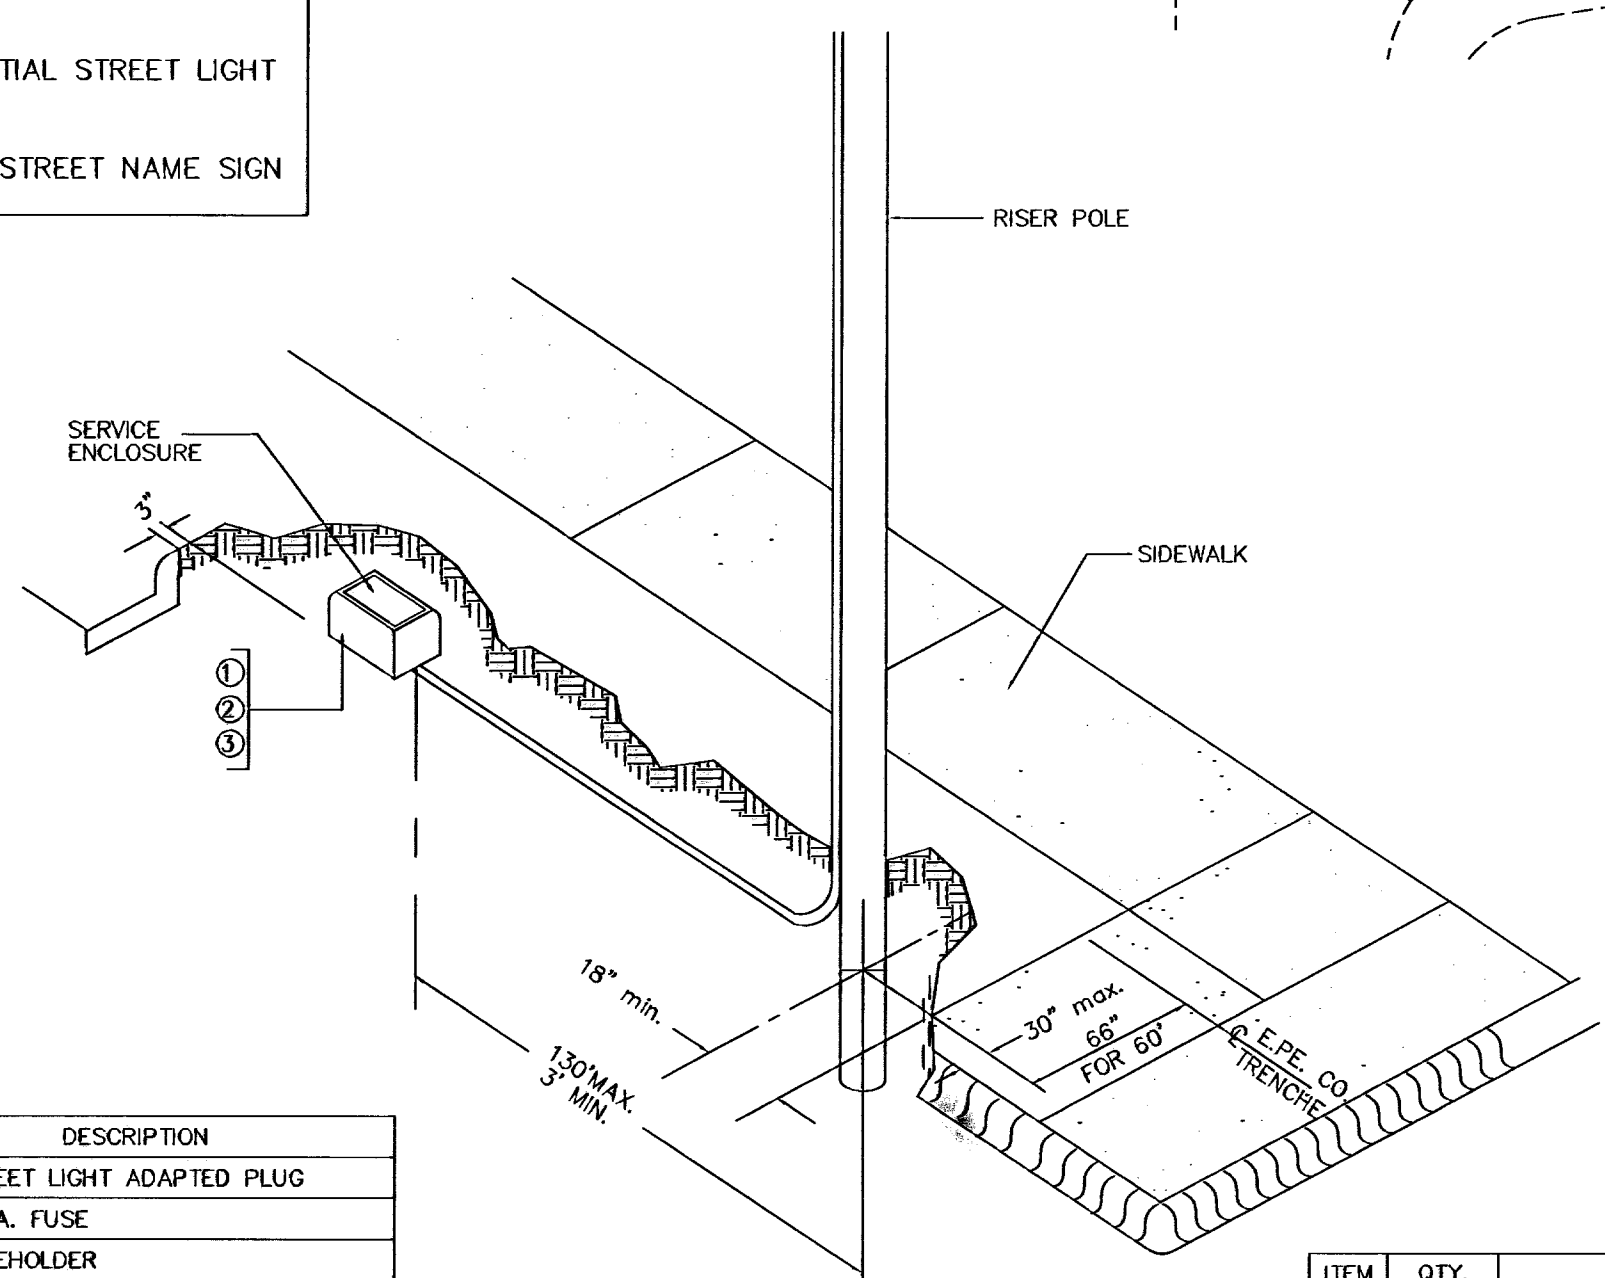

STREET LIGHT POLE LOCATION
N.T.S.

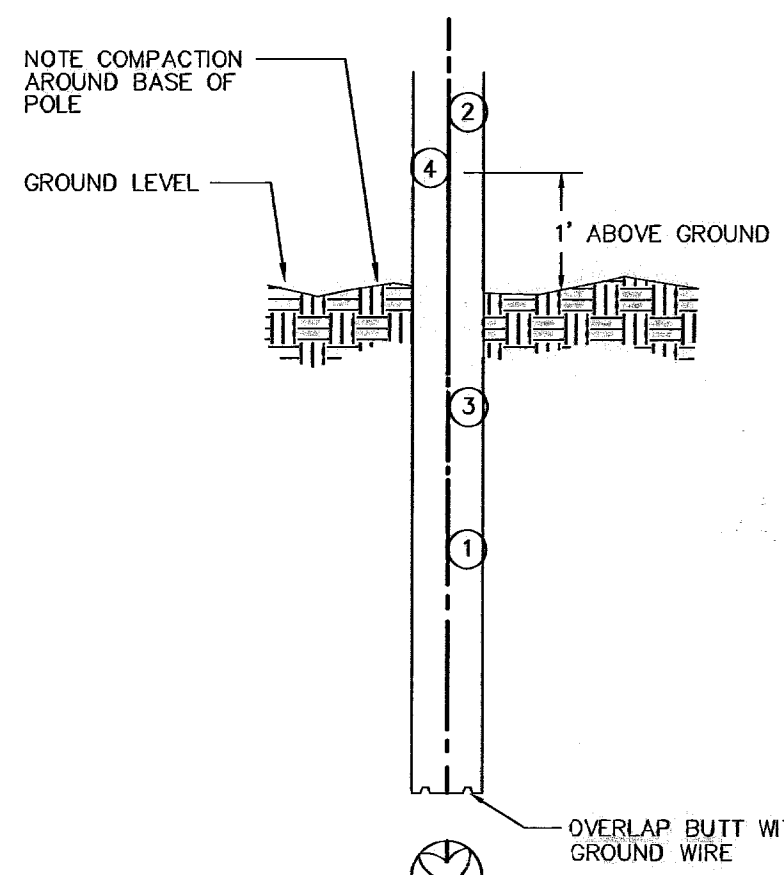


BUTT GROUNDING DETAIL
N.T.S.

ITEM	STOCK NO.	QTY	DESCRIPTION
1	017 - 004	2	STREET LIGHT ADAPTED PLUG
2	021 - 215	2	30 A. FUSE
3	021 - 245	2	FUSEHOLDER

ITEM	QTY.	DESCRIPTION
1		COPPER WIRE, #6 BARE SOLID HARD DRAWN
2		ALUMINUM WIRE, #4 BARE SOLID HARD DRAWN
3	1/2#	STAPLE, GALV. 1-1/2" NO.9
4	1	SPLICE, #4 SOLID ALUM. 10 #6 SOLID CU.

ITEM	STOCK NO.	QTY	DESCRIPTION
1	009 - 135	1	POLE, 35 FT. - CLASS IV
2	017 - 292	27'	1/2" RIGID GALVANIZED STEEL CONDUIT
3	017 - 334	4	PIPE STRAP FC 1 1/2" CONDUIT
4	002 - 330	8	1/4"x 2" LAG BOLT
5	017 - 293	1	WEATHERHEAD - 1/2" CONDUIT
6	021 - 210	1	PHOTO CELL RECEPTACLE AND BRACKET
7	021 - 225	1	240 V PHOTO CELL
8	002 - 370	4	1/2"x 4" LAG BOLT
9	002 - 330	2	1/4"x 2" LAG BOLT
10	002 - 450	1	5/8"x 8" MACHINE BOLT
11	002 - 760	1	21/4"x 21/4" SQ. GALV. WASHER
12	002 - 786	1	5/8" COL - SPRING WASHER
13	002 - 705	1	5/8" LOCKNUT
14	021 - 225	1	PHOTOCONTROL-240V
15	021 - 400	1	LAMP-HPS, 100W-9,500 LUMEN OR 150W-16,000 LUMEN
16	021 - 085	1	100 W HPS LAMP
17	021 - 200	1	6'x 11/2" MAST ALARM
18	013 - 665		#12,19 STR. 600 V. COPPER CABLE
19	005 - 140	3	#12,10 SLEEVES
20	003 - 600	8'	#10,2 COND. 600 V. CABLE

ITEM	STOCK NO.	QTY	DESCRIPTION
1	017 - 292	27'	1/2" RIGID GALVANIZED CONDUIT
2	021 - 215	1	GROUND CLAMP
3	017 - 294	1	1" TO 1/2" REDUCER
4	017 - 295	1	1" FEMEL ADAPTER
5	017 - 297	1	1",90 DEG,SCH. 40 PVC ELBOW
6	017 - 299	1	1", SCH. 40 PVC CONDUIT
7	017 - 298	1	1",45 DEG,SCH. 40 PVC ELBOW
8	017 - 296	1	1" SCH. 49 PVC COUPLING
9	026 - 830	1	ROLL 2" PLASTIC ELECTRICAL TAPE

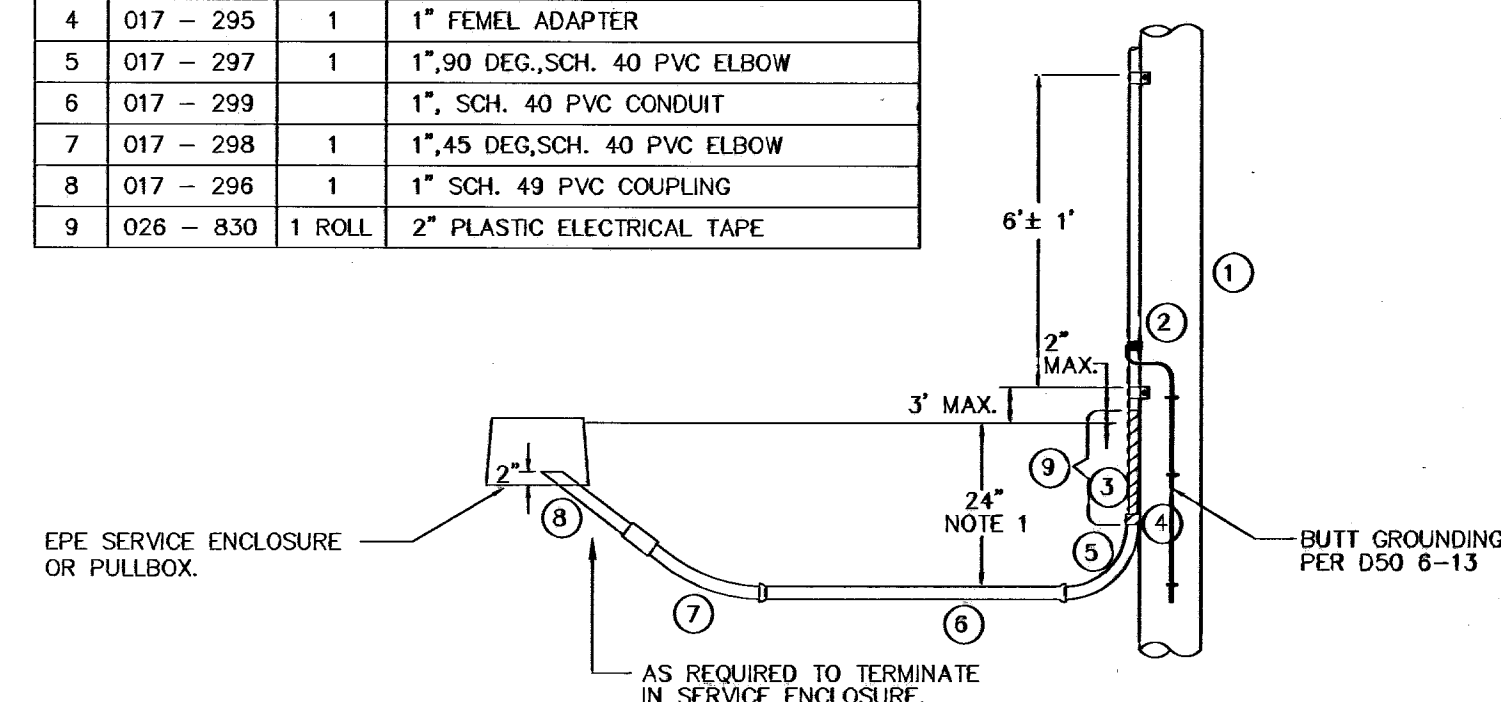


POLE RISER DETAIL
N.T.S. **AS-BUILT**

- 1.) MOUNT CONTROL FACING NORTH.
- 2.) CONNECTORS SHOULD BE ON THE OUTSIDE OF THE LUMINAIRE SUPPORT.
- 3.) FOR ANY CLARIFICATION, EXCEPTIONS OR QUESTIONS REGARDING THIS STANDARD, CALL THE EL PASO ELECTRIC COMPANY DISTRIBUTION DESIGN DEPARTMENT.

1. THIS DEPTH MAY BE REDUCED TO 18" WITHIN THE EL PASO CITY LIMITS.
2. ILLUMINATION PLAN TO BE COORDINATED WITH THE TRAFFIC DEPARTMENT.

BENCHMARK:

EXISTING CITY MONUMENT AT CENTERLINE INTERSECTION OF MAJESTIC RIDGE DR. AND EAGLE RIDGE DR. ELEVATION = 4213.08 (CITY DATUM)

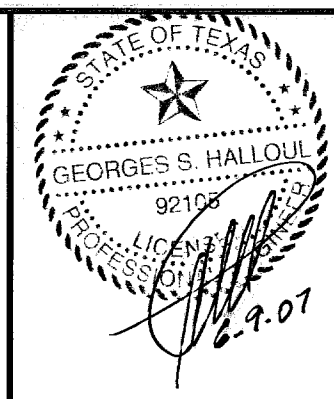

DATE	REVISION	DESCRIPTION	BY

SCALE: 1" = 100'
JOB No. 09-04-2179
FIELD BOOK
DESIGNED BY: ET
COMP. BY: ET
DRAWN BY: SRJ
CHECKED BY: ET
DATE: 08/02/05

TUSCANY AT RIDGEVIEW
EL PASO, EL PASO COUNTY, TEXAS
ILLUMINATION LAYOUT AND DETAILS
SLI ENGINEERING, INC.
CIVIL ENGINEERS • LAND SURVEYORS • LAND PLANNERS
6600 WESTWIND DR. - EL PASO, TEXAS - 79912 - (915) 584-4457

